

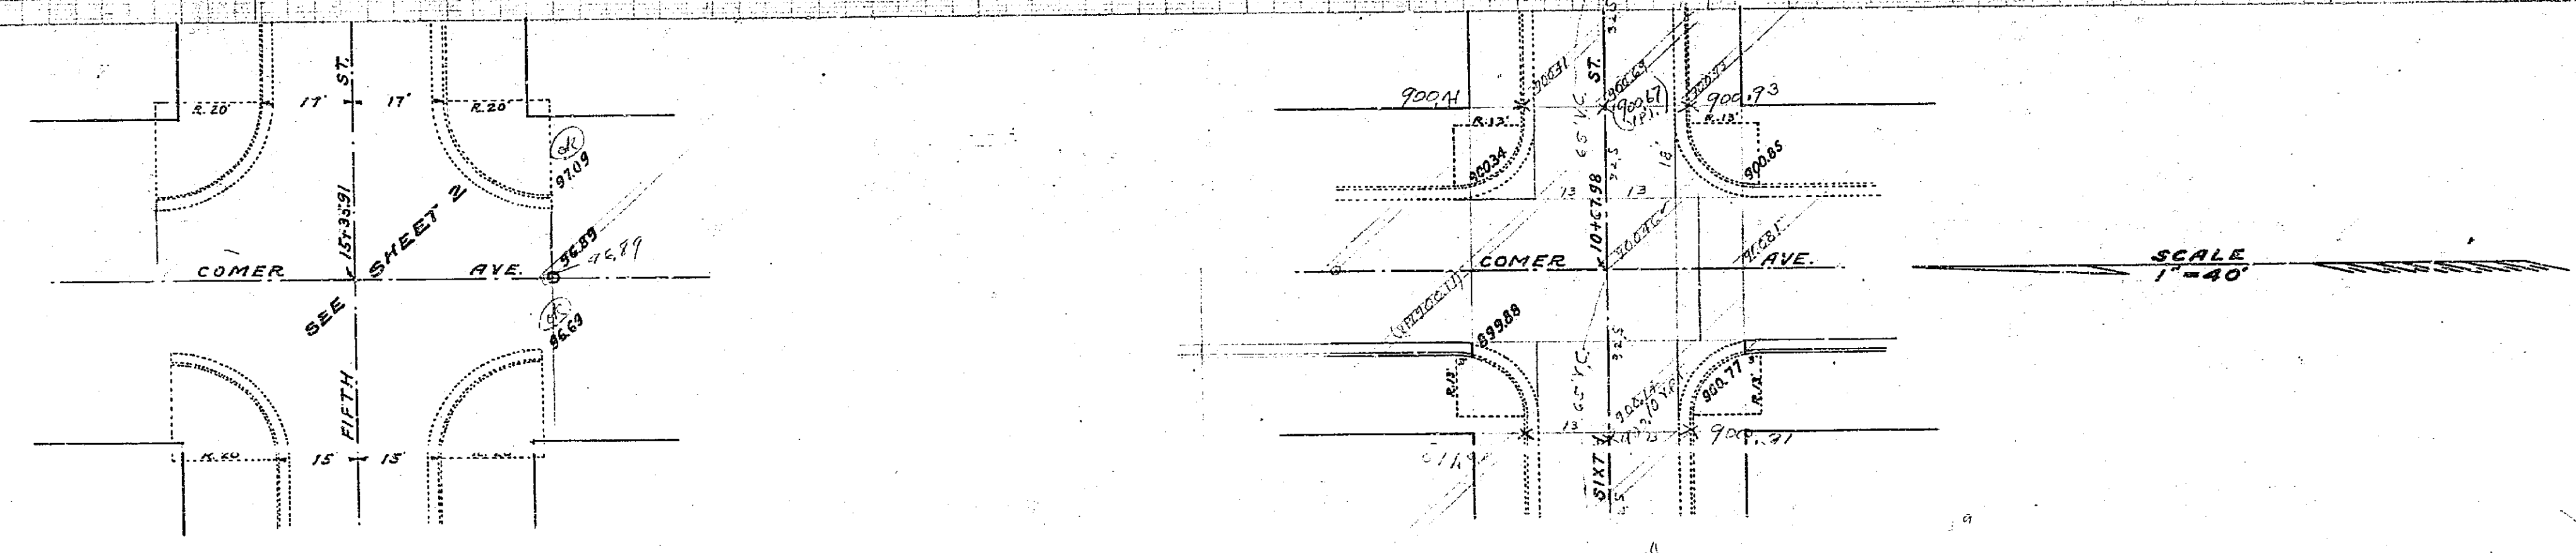


COMER AVENUE BLAINE ST. TO SEVENTH ST.			
Drawing Number	Sheet Number	Total Sheets	Field Book
135-A	1	2	369
Drawn by	Checked	Approved	

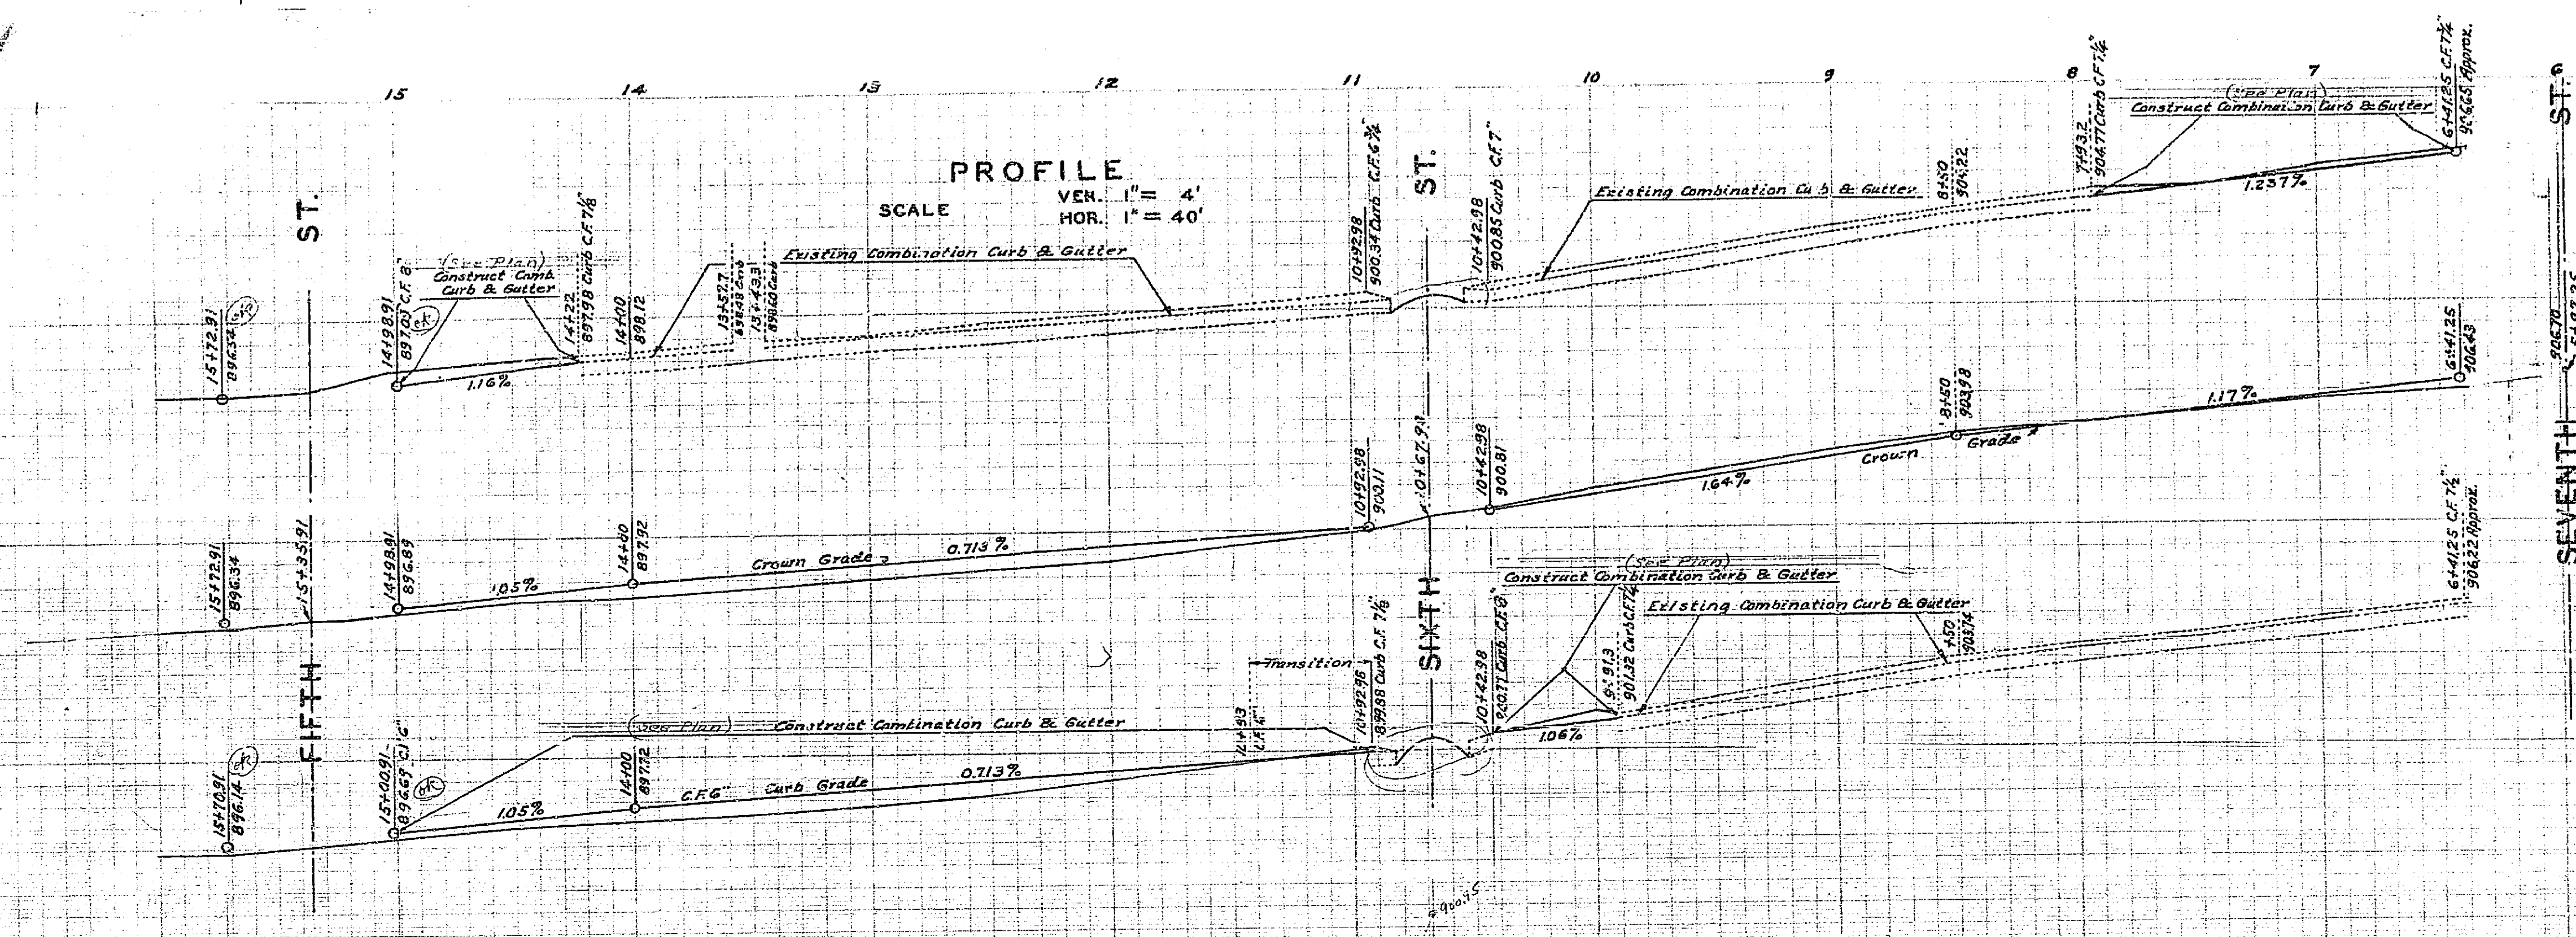

APPROVED _____ CITY ENGINEER.
REG. ENG. 1312

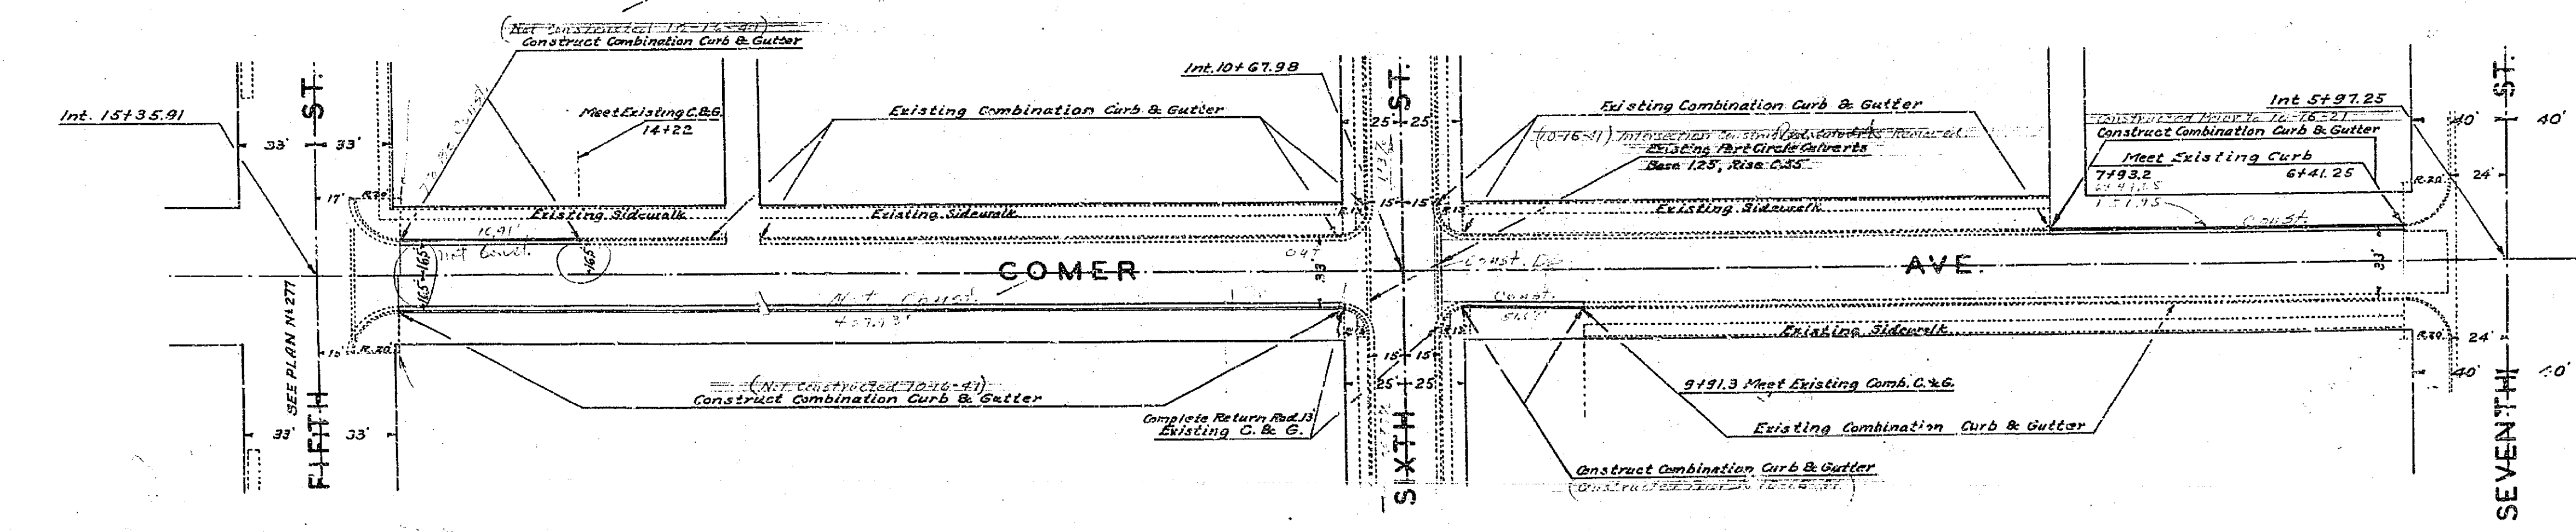

APPROVED AND ADOPTED BY THE MAYOR AND COUNCIL OF THE CITY OF RIVERSIDE THIS DAY OF 1940.

CITY CLERK, CITY OF RIVERSIDE.

155-A

