


RY. Co.

C. PHILLIPS,
ENGINEER.

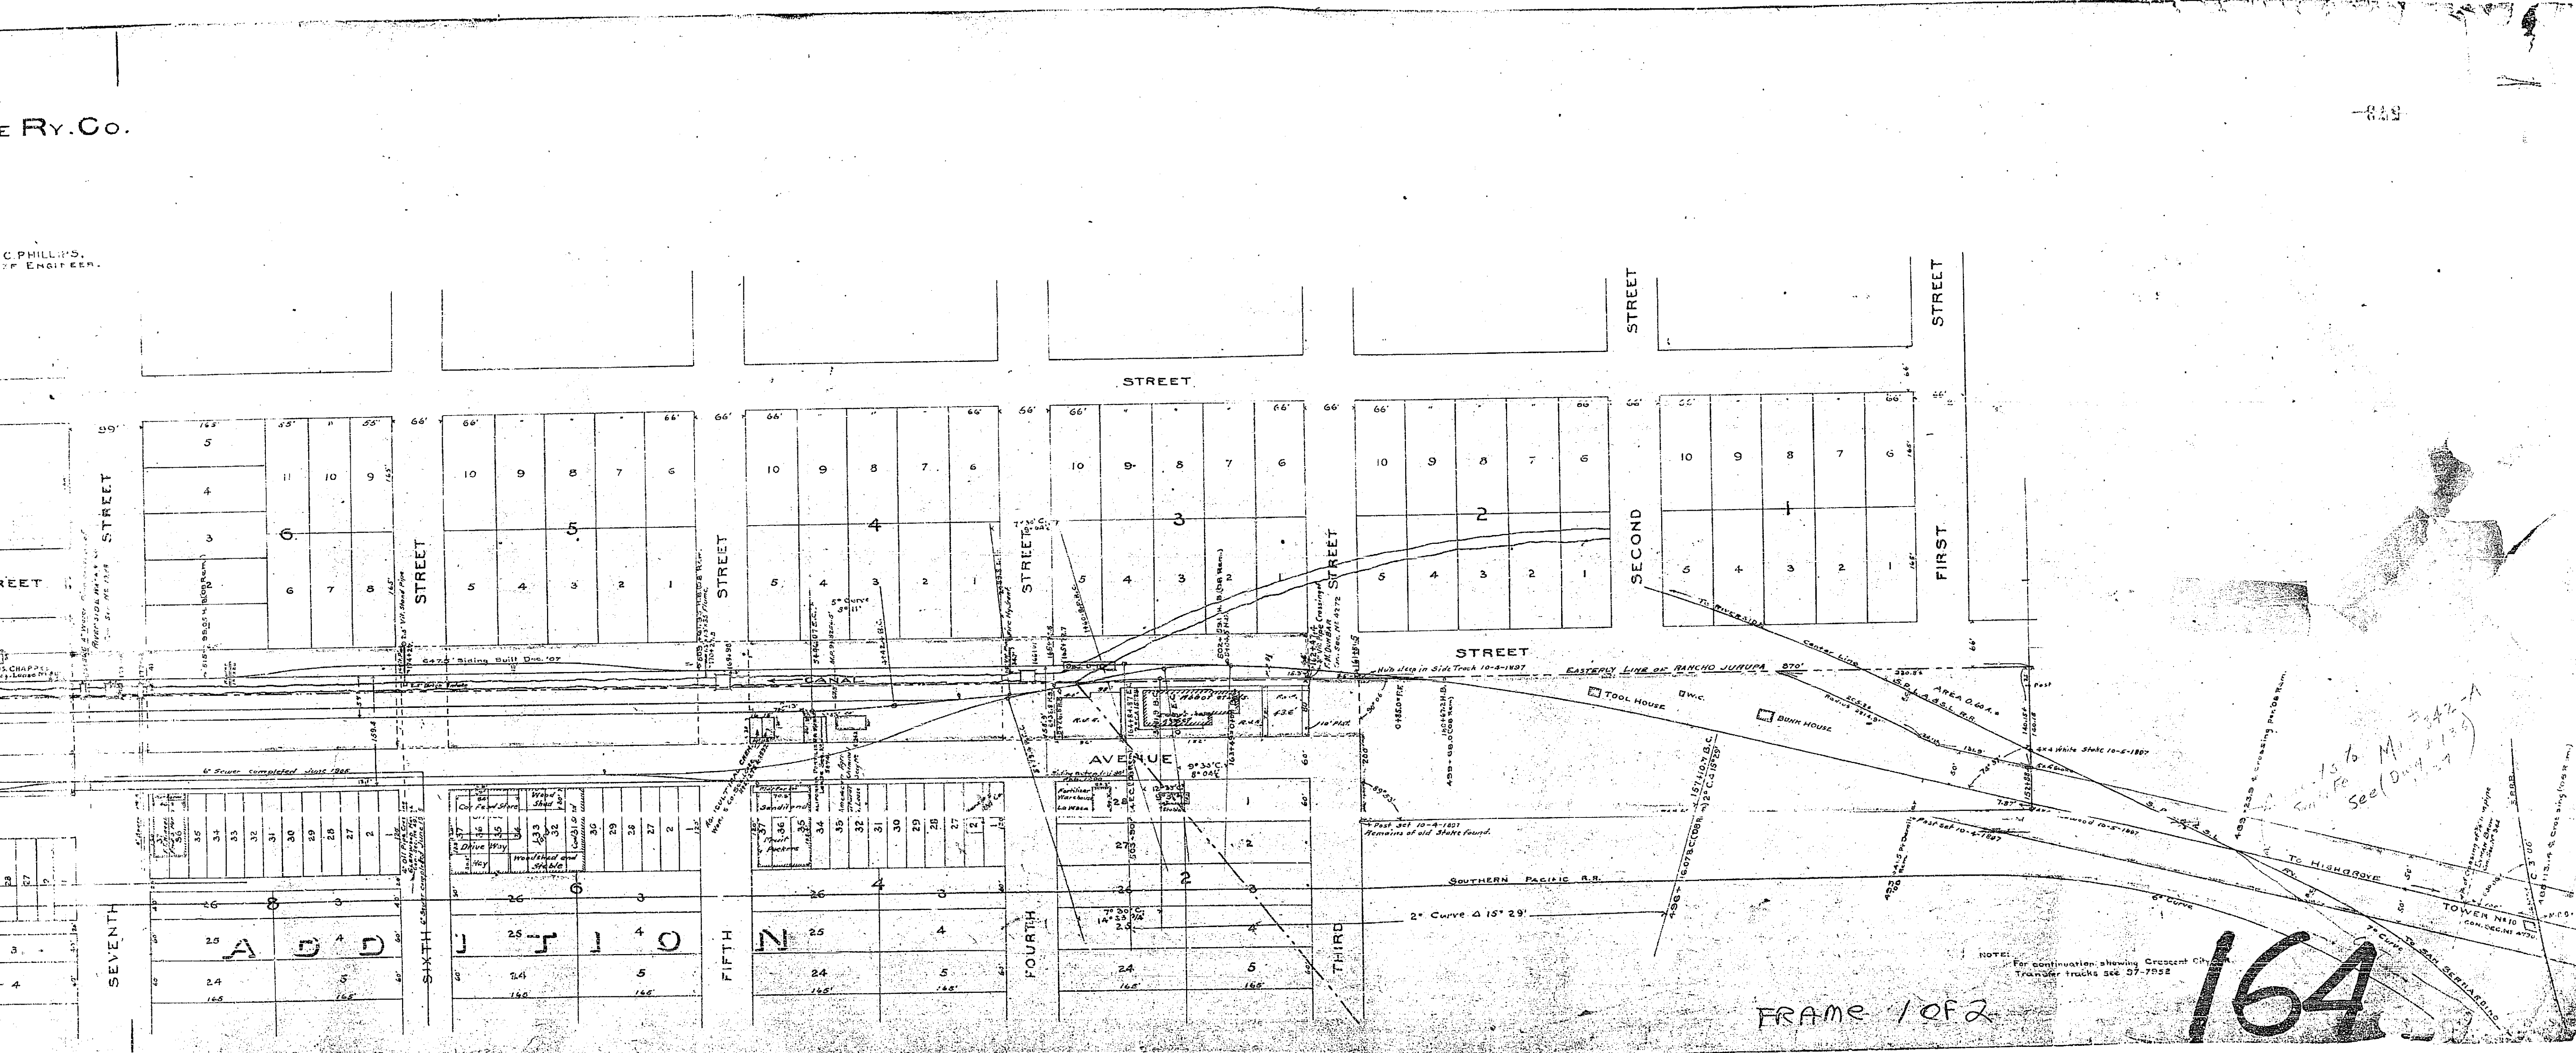

164

FRAME 1 OF 2

NOTE: For continuation showing Crescent City
Tramway tracks see 07-7908

15 to M...
see (D...)

TOWER N 10
100' SEC. 47 1/2

7' Curve 15' 29"

15' Curve 15' 29"

15' Curve 15' 29"

