


PIERCE PLACE
 PLAN OF
 SIDEWALKS & CURBS N. SIDE
 A.C. Keith County Surveyor
 Riverside County
 SCALE: 1"=50' MARCH 1948

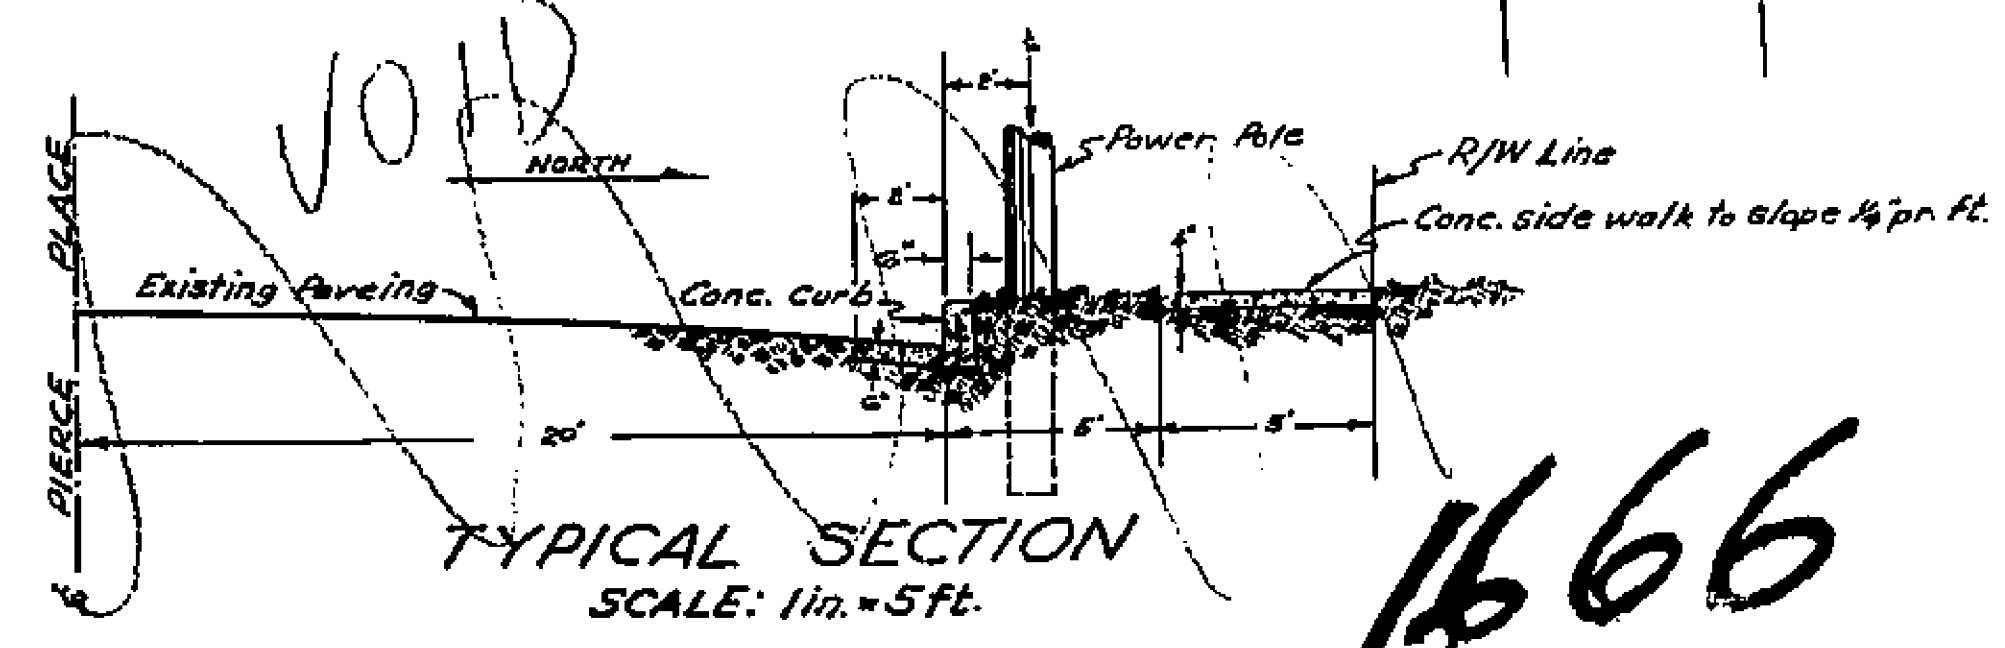

1666