
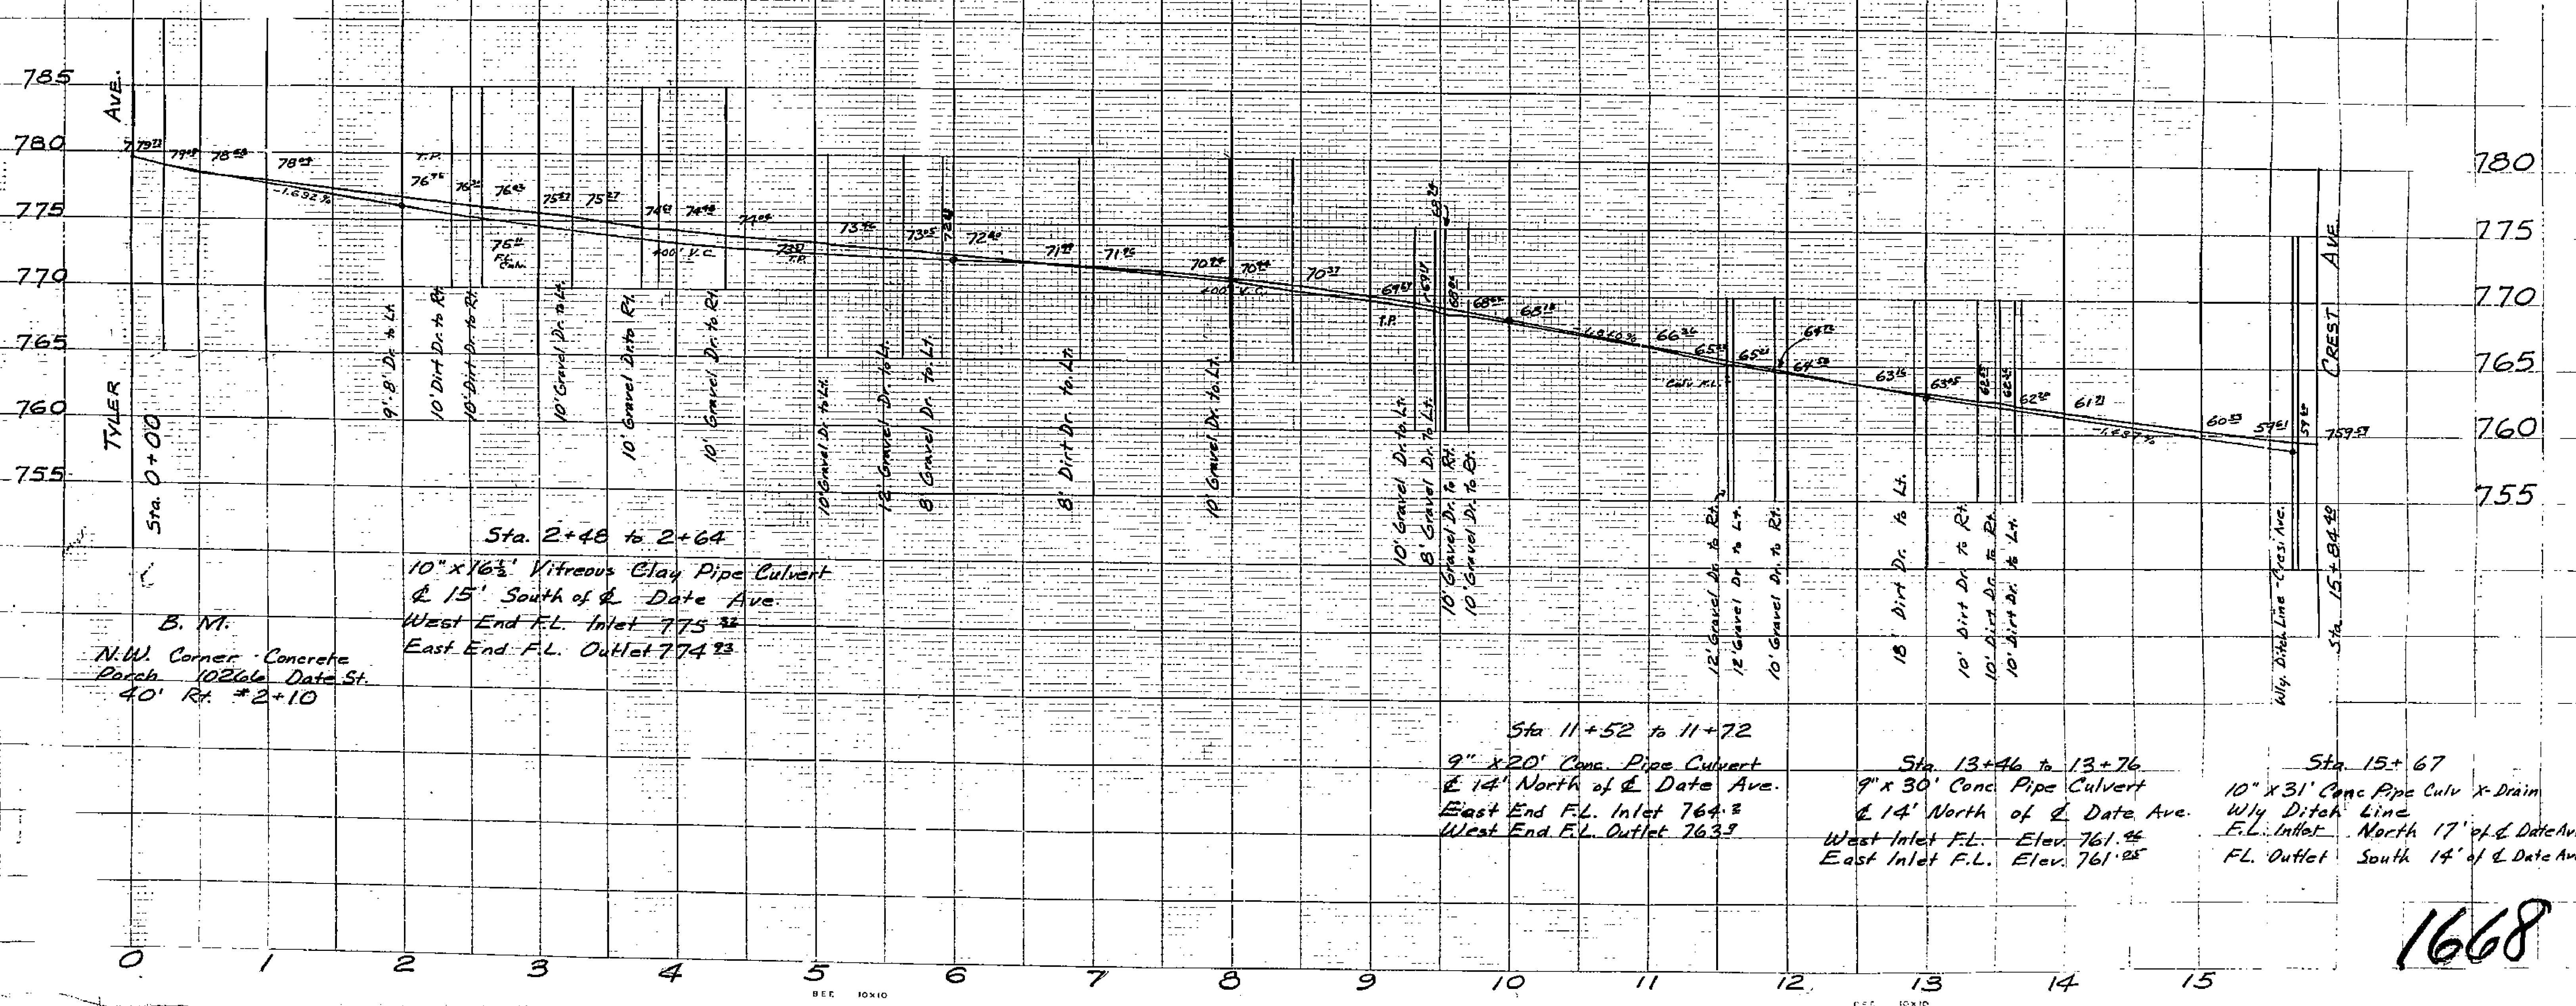


DATE AVE
Between Tyler Ave & Crest Ave.
Field Book 750 Survey No 2659

Scale
Horiz. 1" = 50'
Vert. 1" = 5'

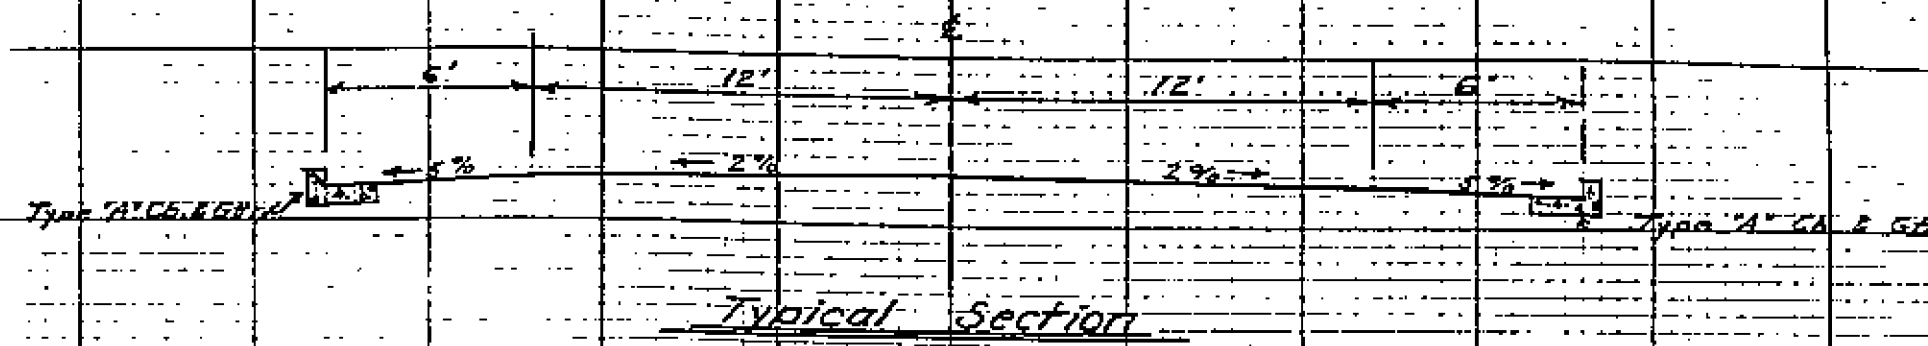

B. M.
N.W. Corner Concrete
Porch 10266 Date St.
40' R. #2+10

Sta. 2+48 to 2+64
10" x 16 1/2" Vitreous Clay Pipe Culvert
& 15' South of Date Ave.
West End F.L. Inlet 775.32
East End F.L. Outlet 774.93

Sta. 11+52 to 11+72
9" x 20" Conc. Pipe Culvert
& 14' North of Date Ave.
East End F.L. Inlet 764.3
West End F.L. Outlet 763.9

Sta. 13+46 to 13+76
9" x 30" Conc. Pipe Culvert
& 14' North of Date Ave.
West Inlet F.L. Elev. 761.44
East Inlet F.L. Elev. 761.25

Sta. 15+67
10" x 31" Conc. Pipe Culv x-Drain
Wly. Ditch Line - Crest Ave.
F.L. Inlet North 17' of Date Ave.
F.L. Outlet South 14' of Date Ave.

1668