


Orange St. - First St to Fourteenth St.			
Drawing Number	Sheet Number	Total Sheets	Field Books
214	1	2	
Drawn	Checked	Approved	
Arthur R. Rolan July 1, 1942	N		

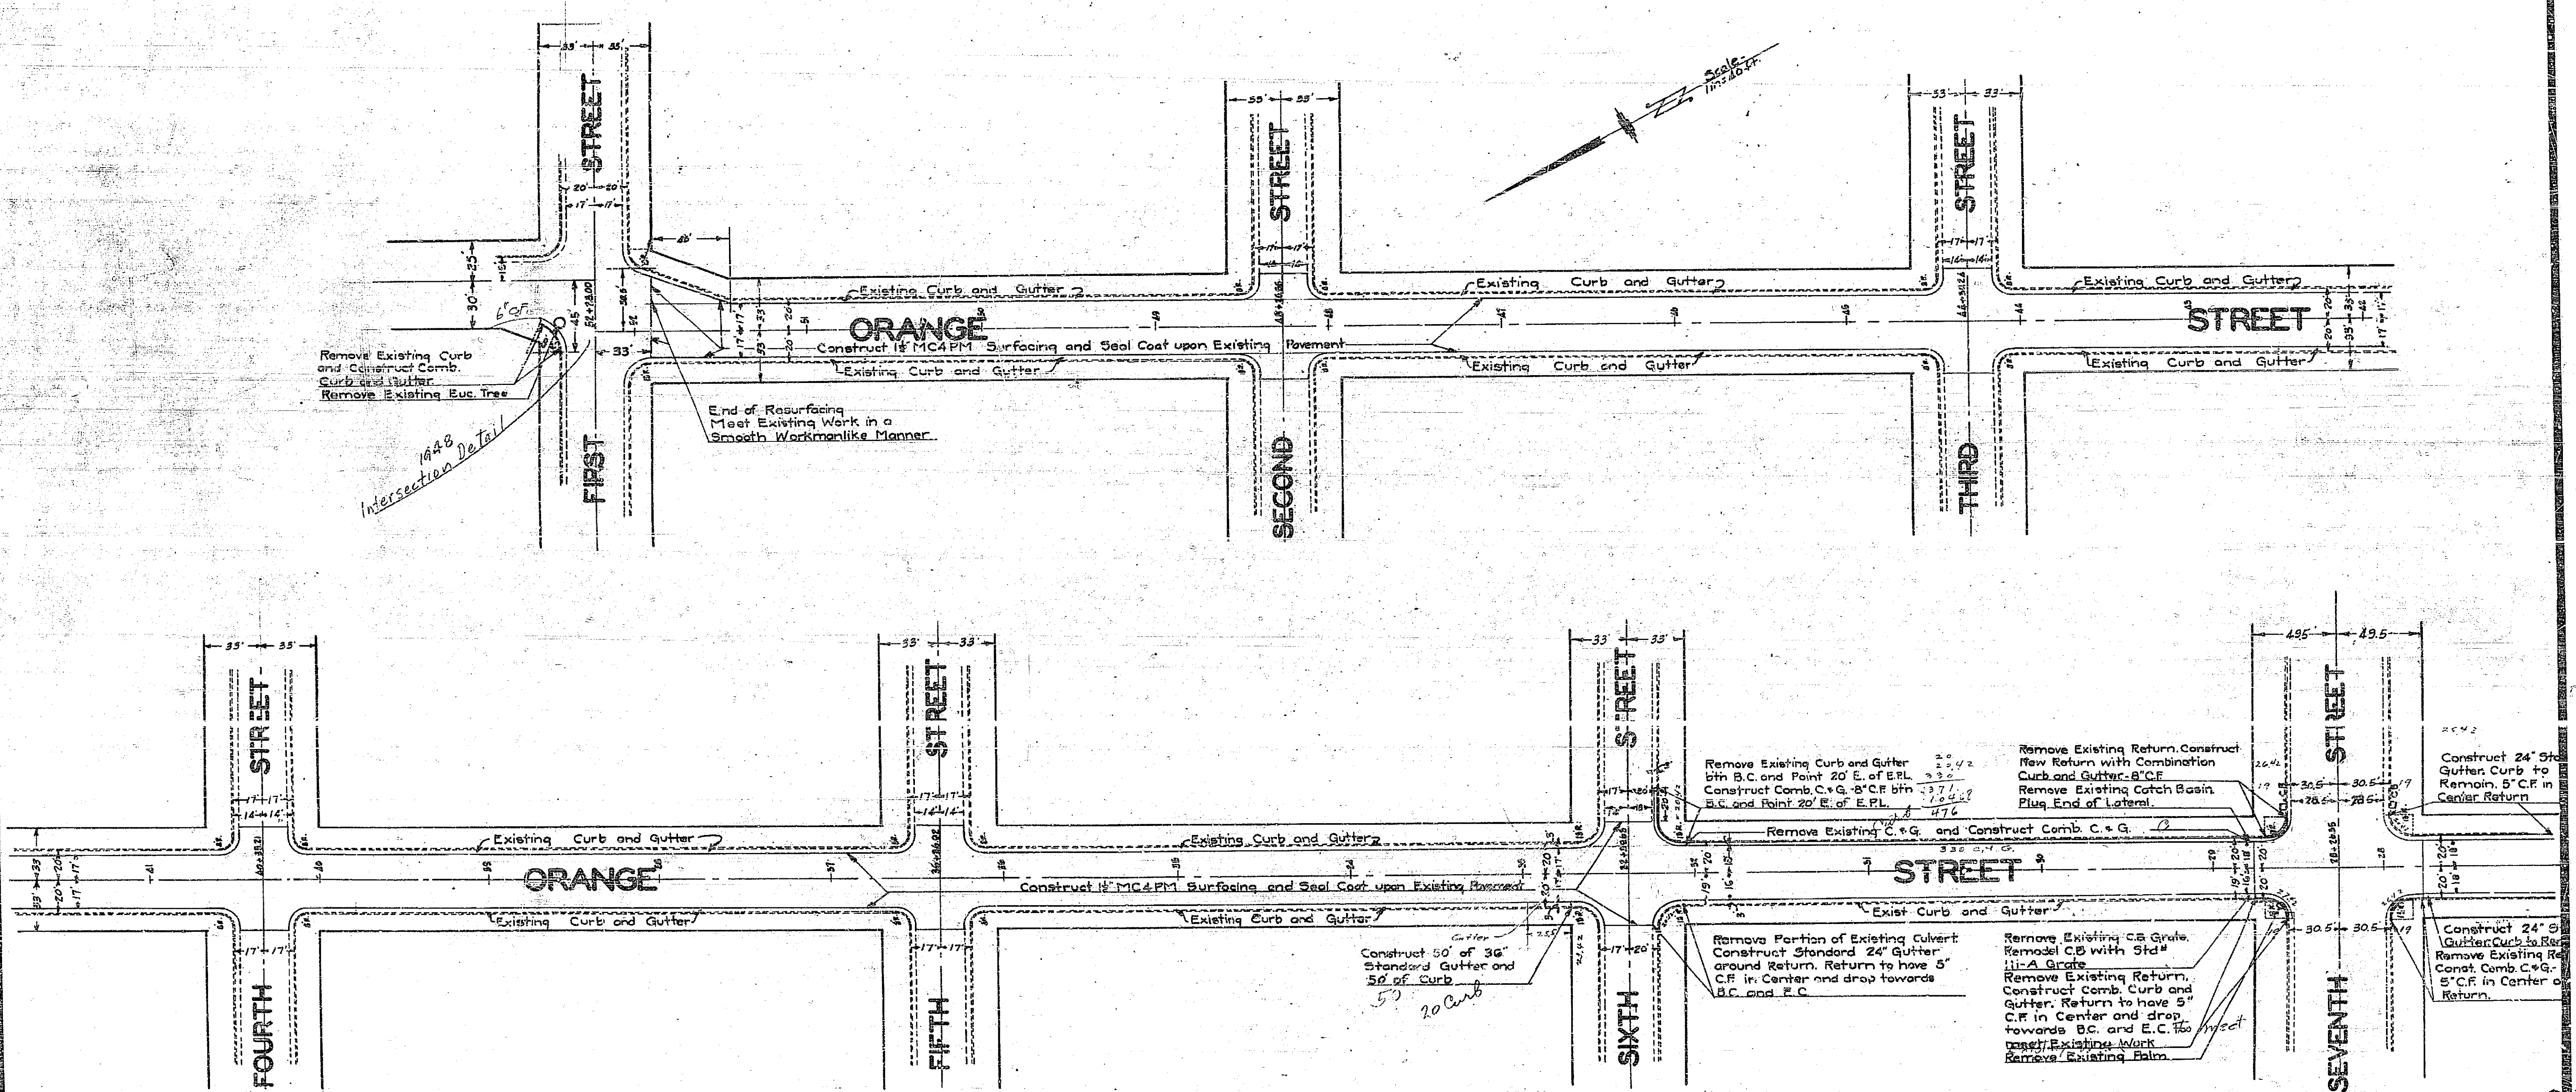

Remove Existing Curb and Construct Comb. Curb and Gutter.
Remove Existing Euc. Tree

1948
Intersection Detail

End of Resurfacing Meet Existing Work in a Smooth Workmanlike Manner.

Remove Existing Curb and Gutter b/n B.C. and Point 20' E. of E.P.L.
Construct Comb. C+G. 8" C.F. b/n B.C. and Point 20' E. of E.P.L.

Remove Existing Return. Construct New Return with Combination Curb and Gutter. 5" C.F.
Remove Existing Catch Basin. Plug End of Lateral.

Construct 24" Std. Gutter. Curb to Remain. 5" C.F. in Center Return

Construct 50' of 36" Standard Gutter and 50' of Curb

Remove Portion of Existing Culvert. Construct Standard 24" Gutter around Return. Return to have 5" C.F. in Center and drop towards B.C. and E.C.



Remove Existing C.S. Grate. Remodel C.B. with Std. 11-A Grate.
Remove Existing Return. Construct Comb. Curb and Gutter. Return to have 5" C.F. in Center and drop towards B.C. and E.C. 150' ahead Existing Work.
Remove Existing Palm

Construct 24" Std. Gutter. Curb to Remain. 5" C.F. in Center of Return

Orange St. - First St. to Fourteenth St.			
Drawing Number 214	Sheet Number 1	Total Sheets 2	Field Books
Drawn Arthur H. Ridley July 1, 1940	Checked	Approved	

PROPOSED IMPROVEMENT OF ORANGE STREET FROM FOURTEENTH STREET TO FIRST STREET

ENGINEERING DEPT. CITY OF RIVERSIDE
JANUARY 1940
APPROVED *W. H. ...*
CITY ENGINEER
R.E. 1312

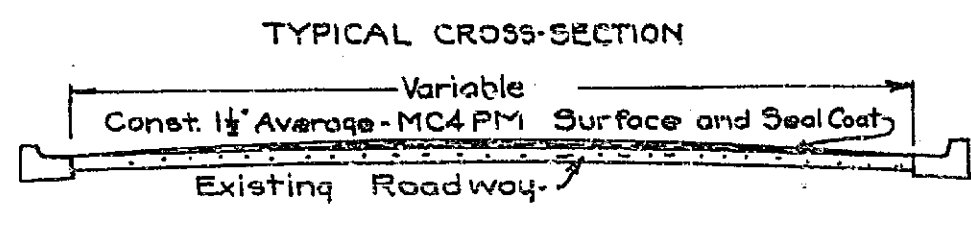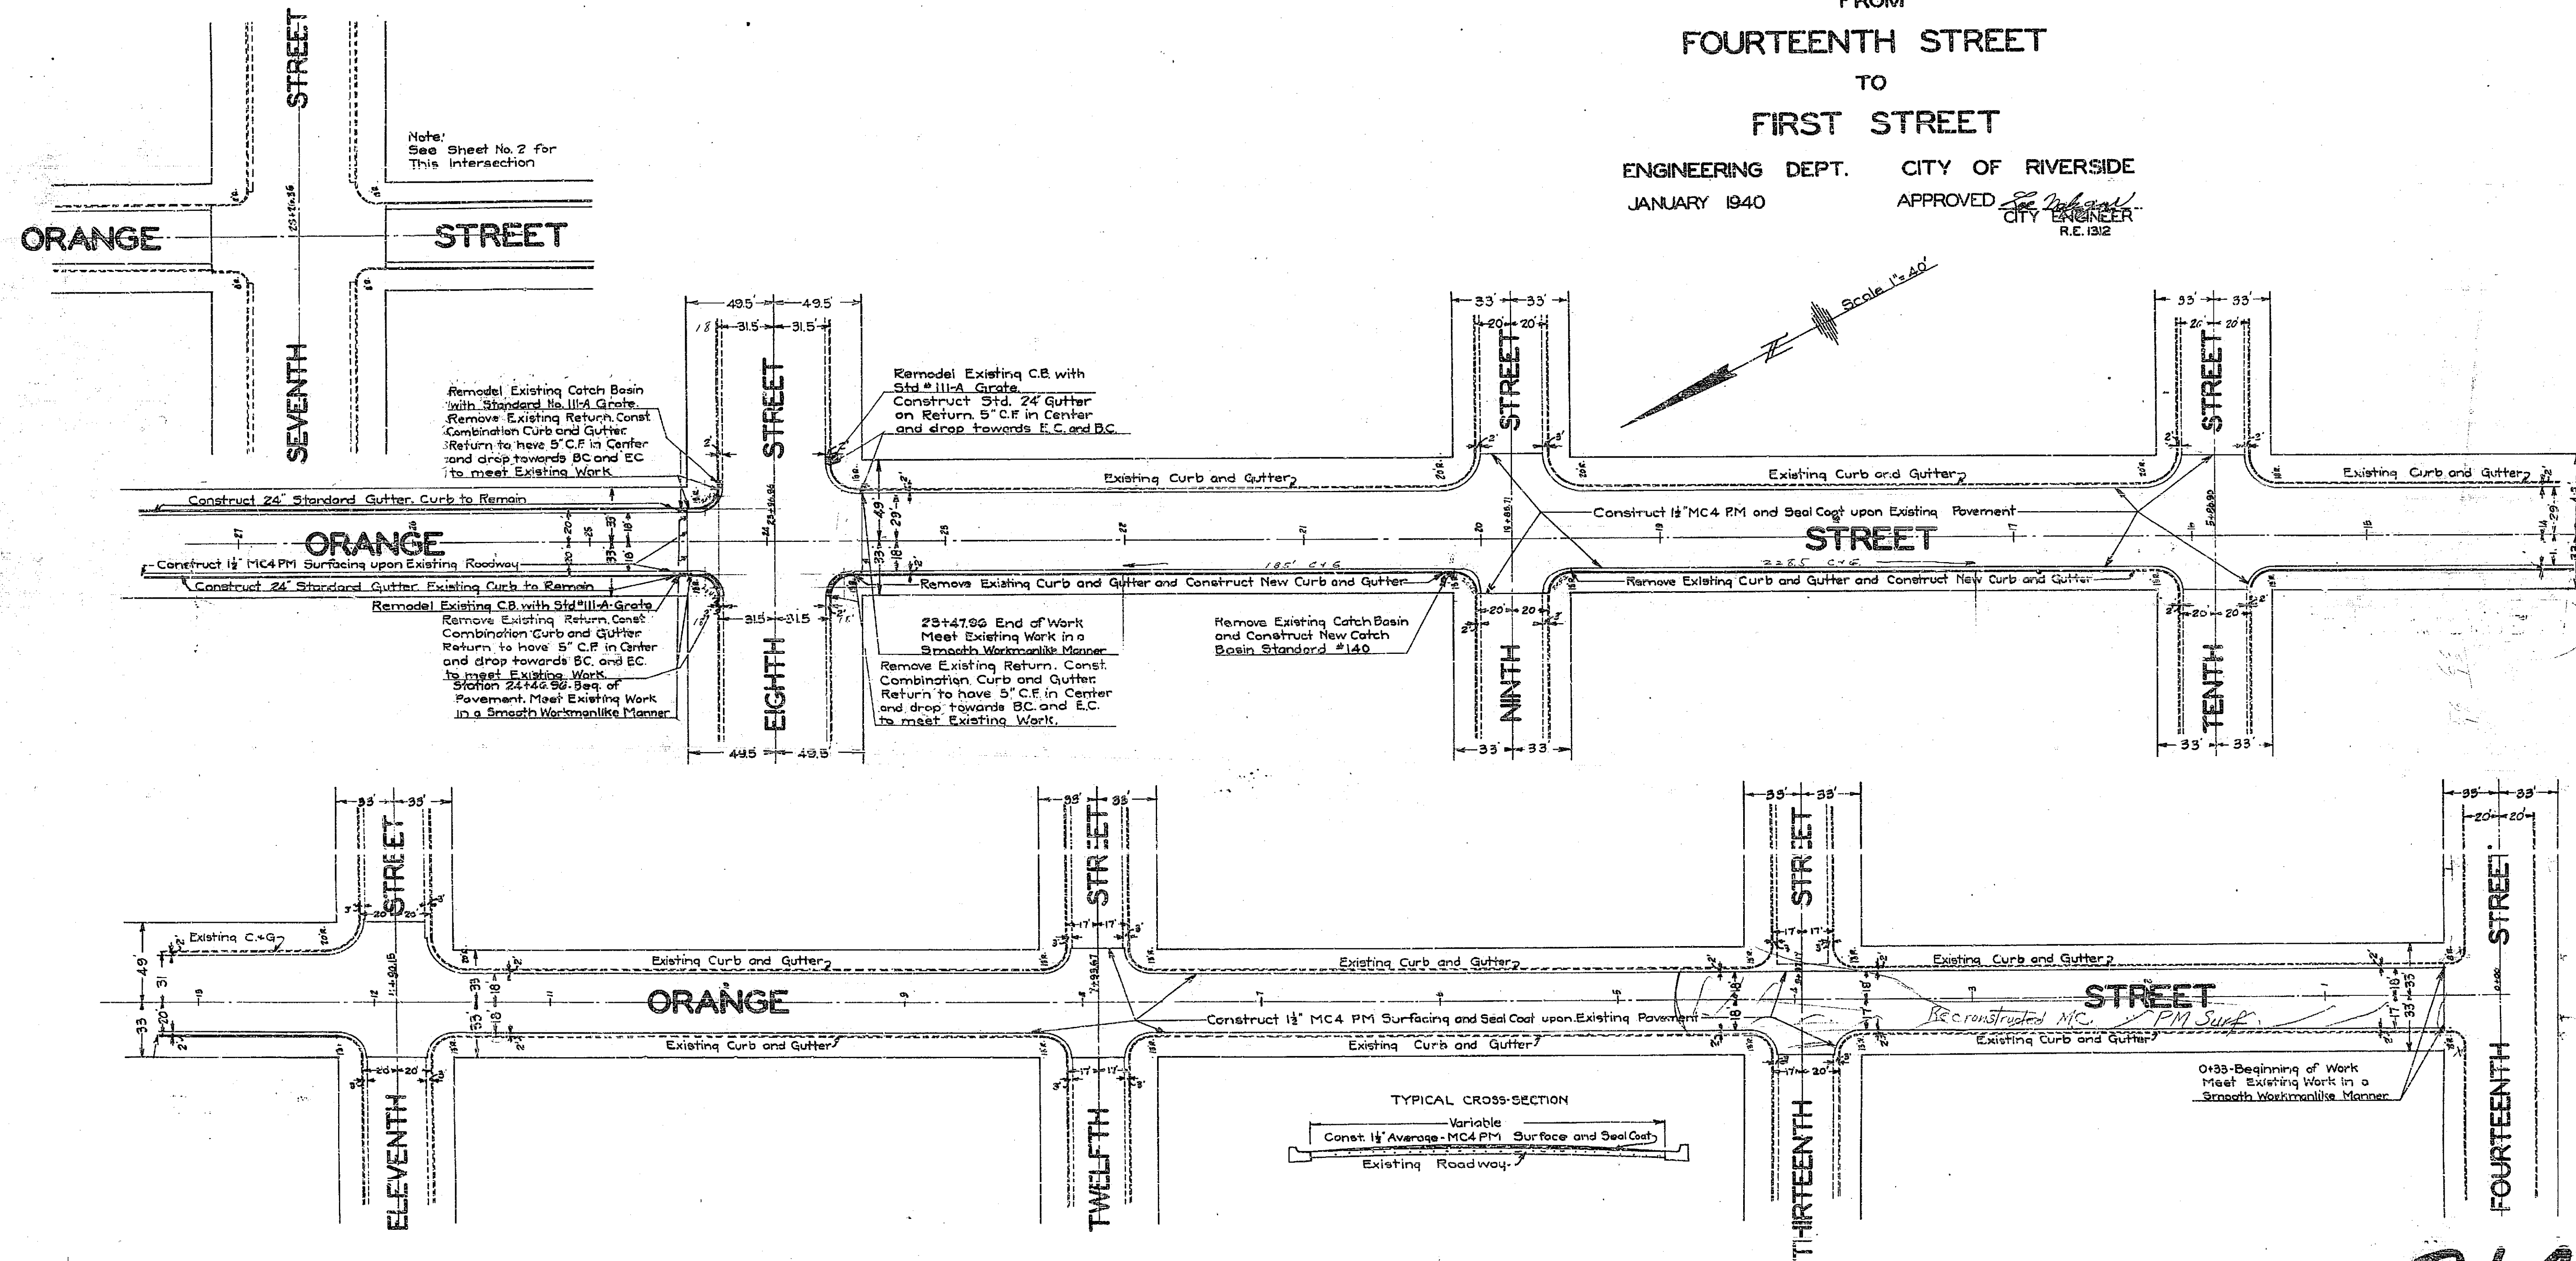

0+33-Beginning of Work Meet Existing Work in a Smooth Workmanlike Manner