


PROFILE OF LINCOLN AVE  
MONROE TO IRVING  
JUNE 26 1957  
FB. 321-72

Plotted - DSM

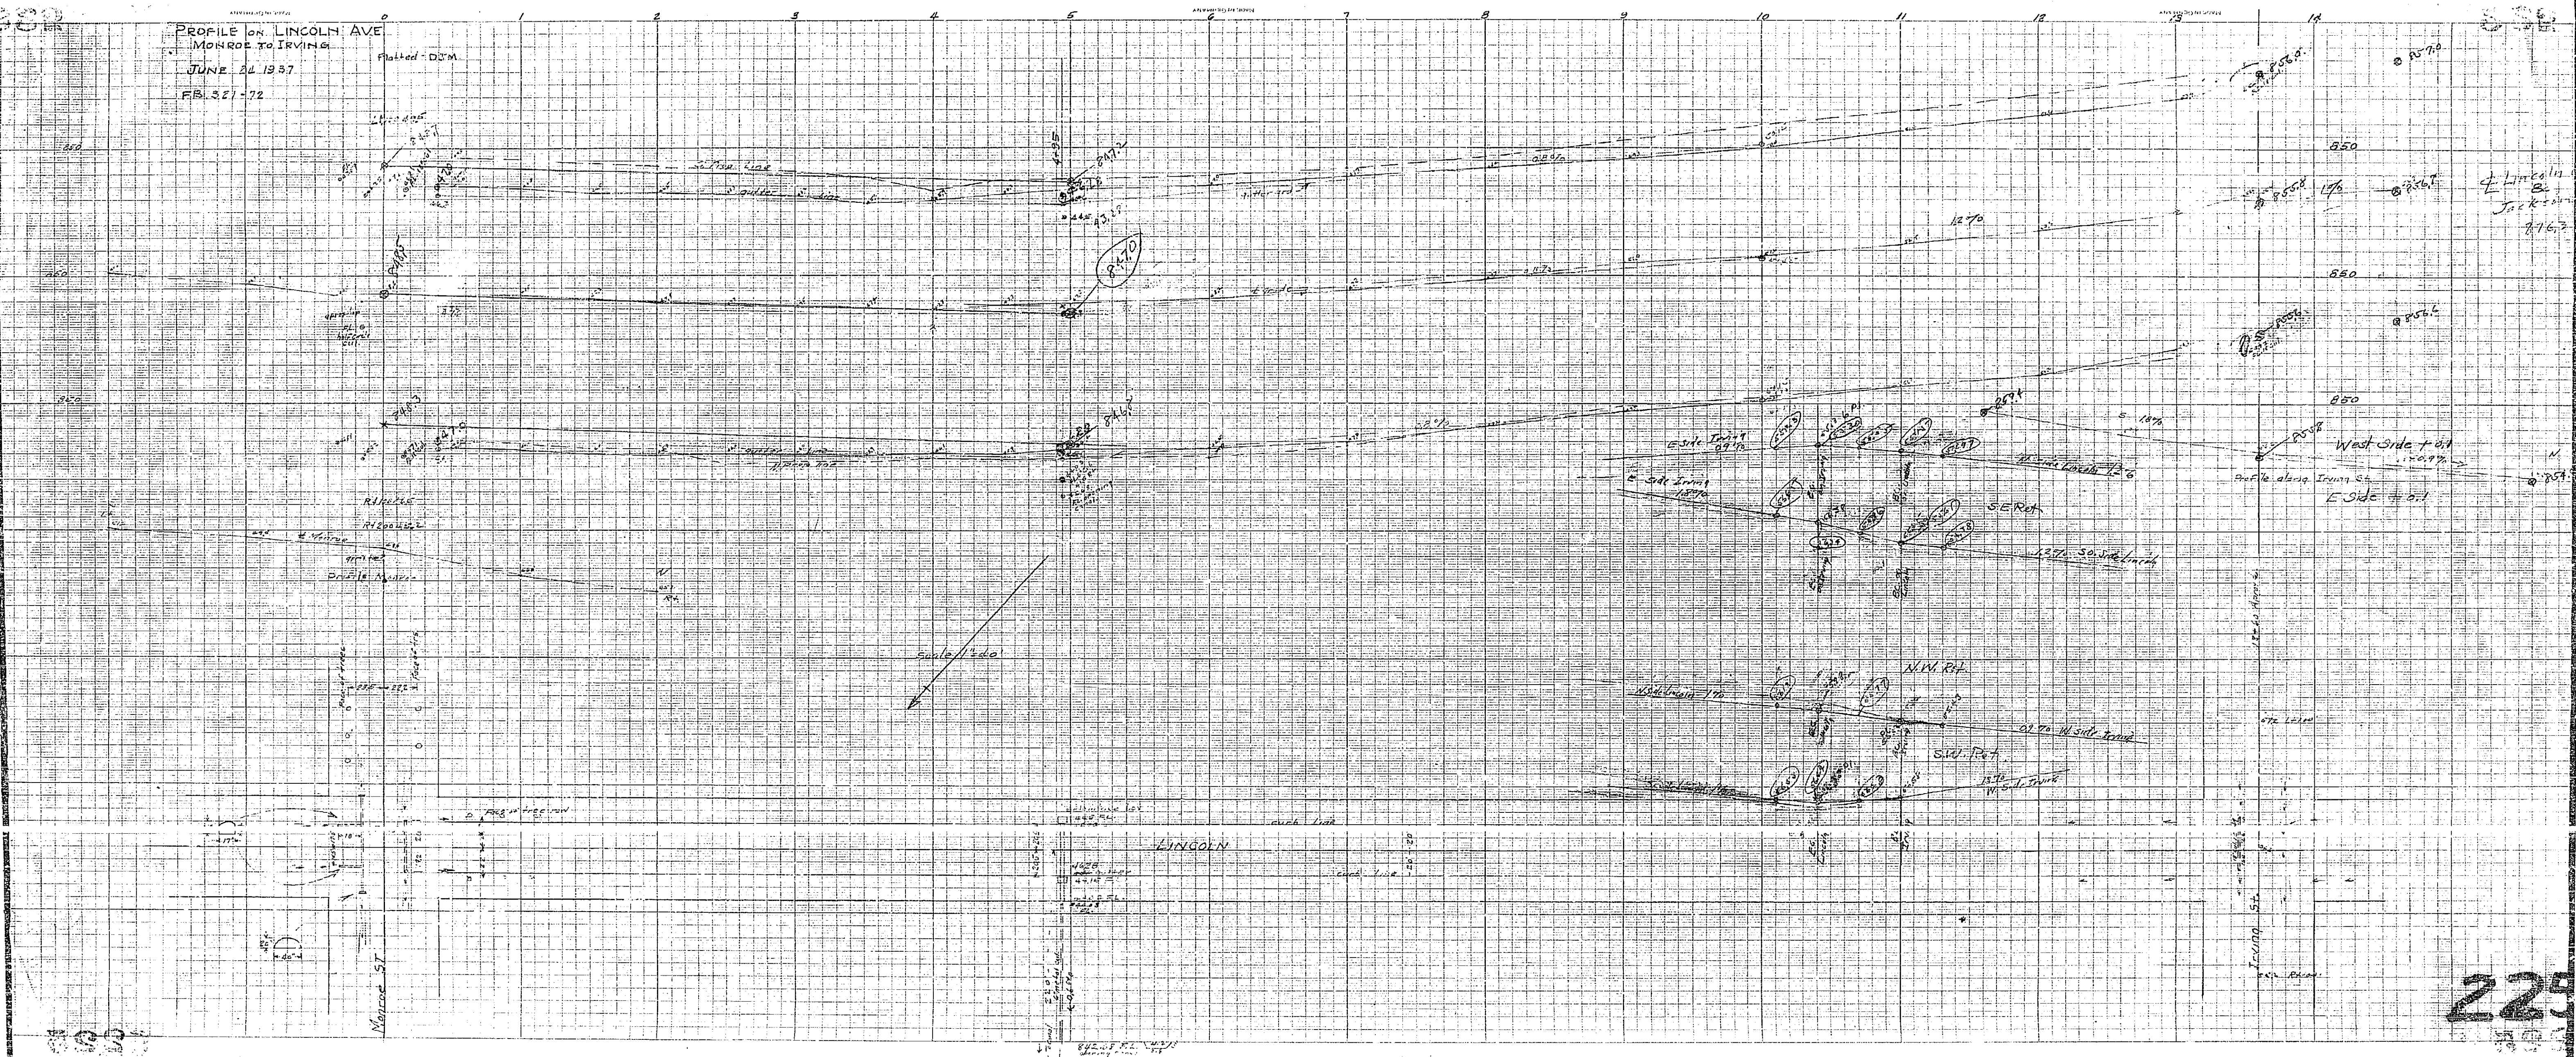

225