

875.56
2.67
878.23

8.47
5.23
3.24

7.85
4.75
3.10

7.87
3.10
4.77

7.847
2.67
5.177


7.85
0.1
7.75

7.85
0.1
7.75

PROFILE EVERGREEN AVE

Sections Sec Map 560-A 373/67475 Dec. 1940
" " 133-A

Scale - 1" = 40' Hor
1" = 4' Vert

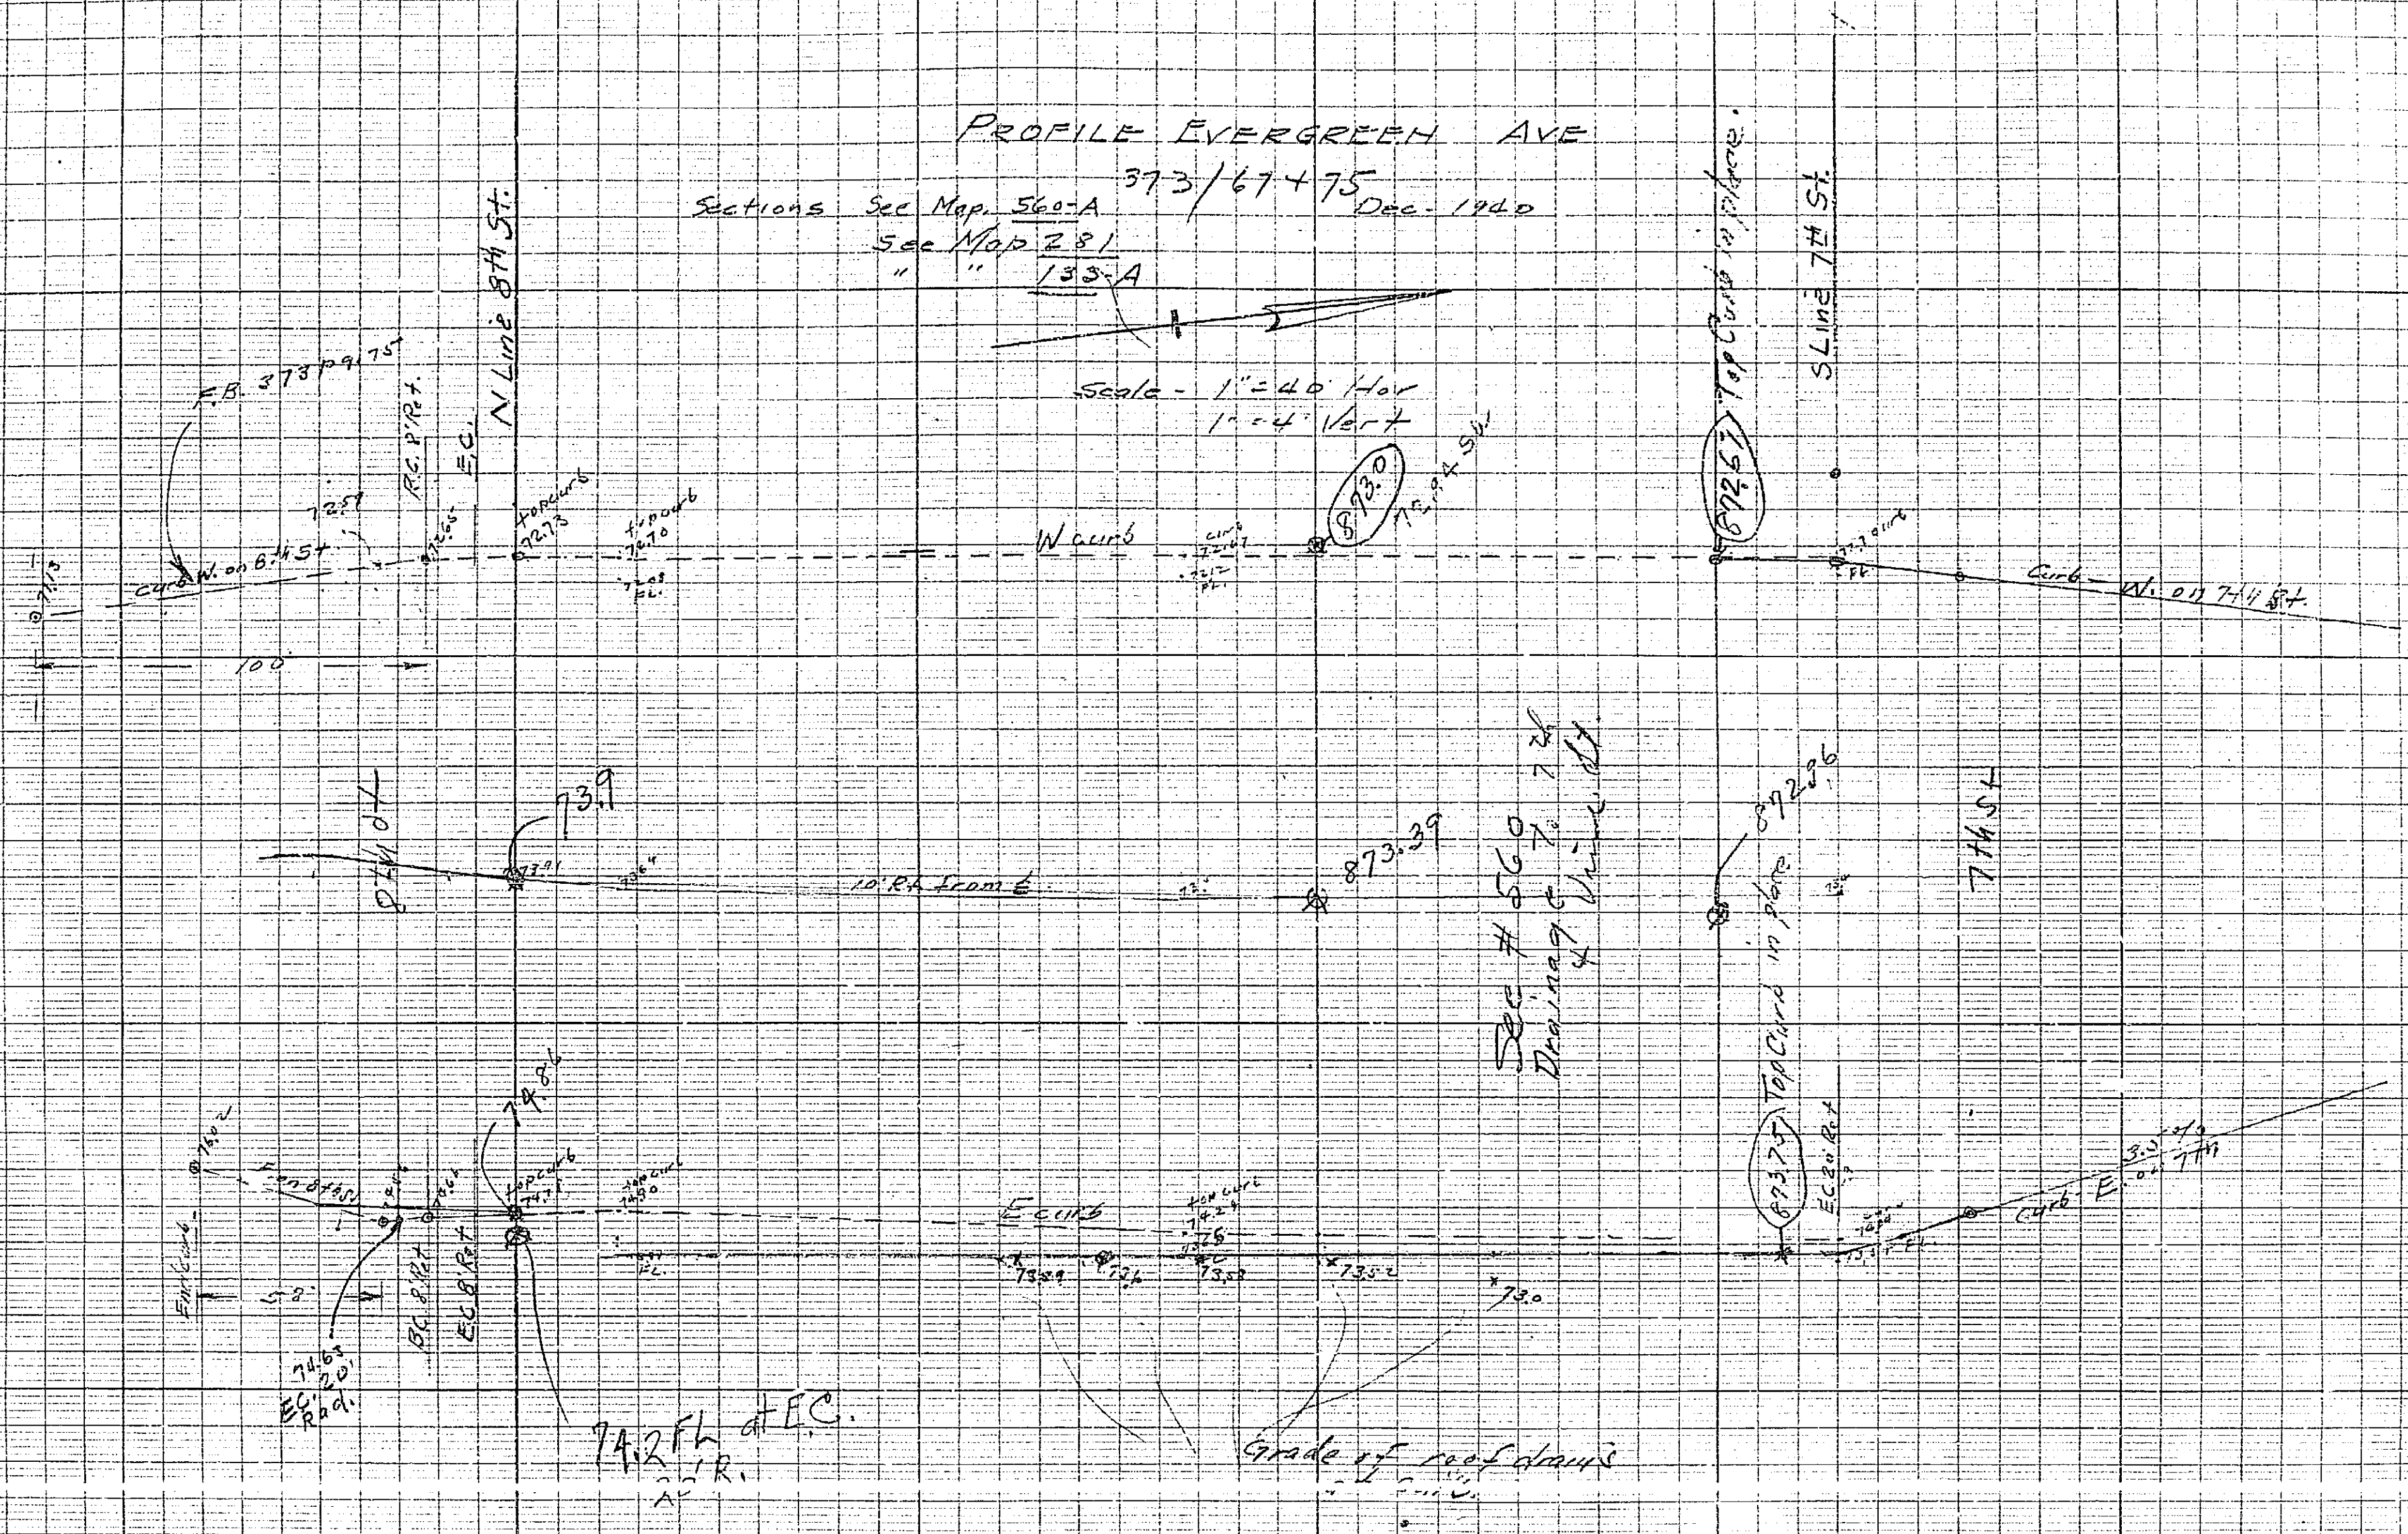

SEC # 560
Drainage
4' Vertical

7A2FH & EC.
W.R.

Grade of roof drain