


STORM DRAIN Lateral  
North Side Storm Drain To Poplar St & Main St  
38/21-22 Dec 9 1940.

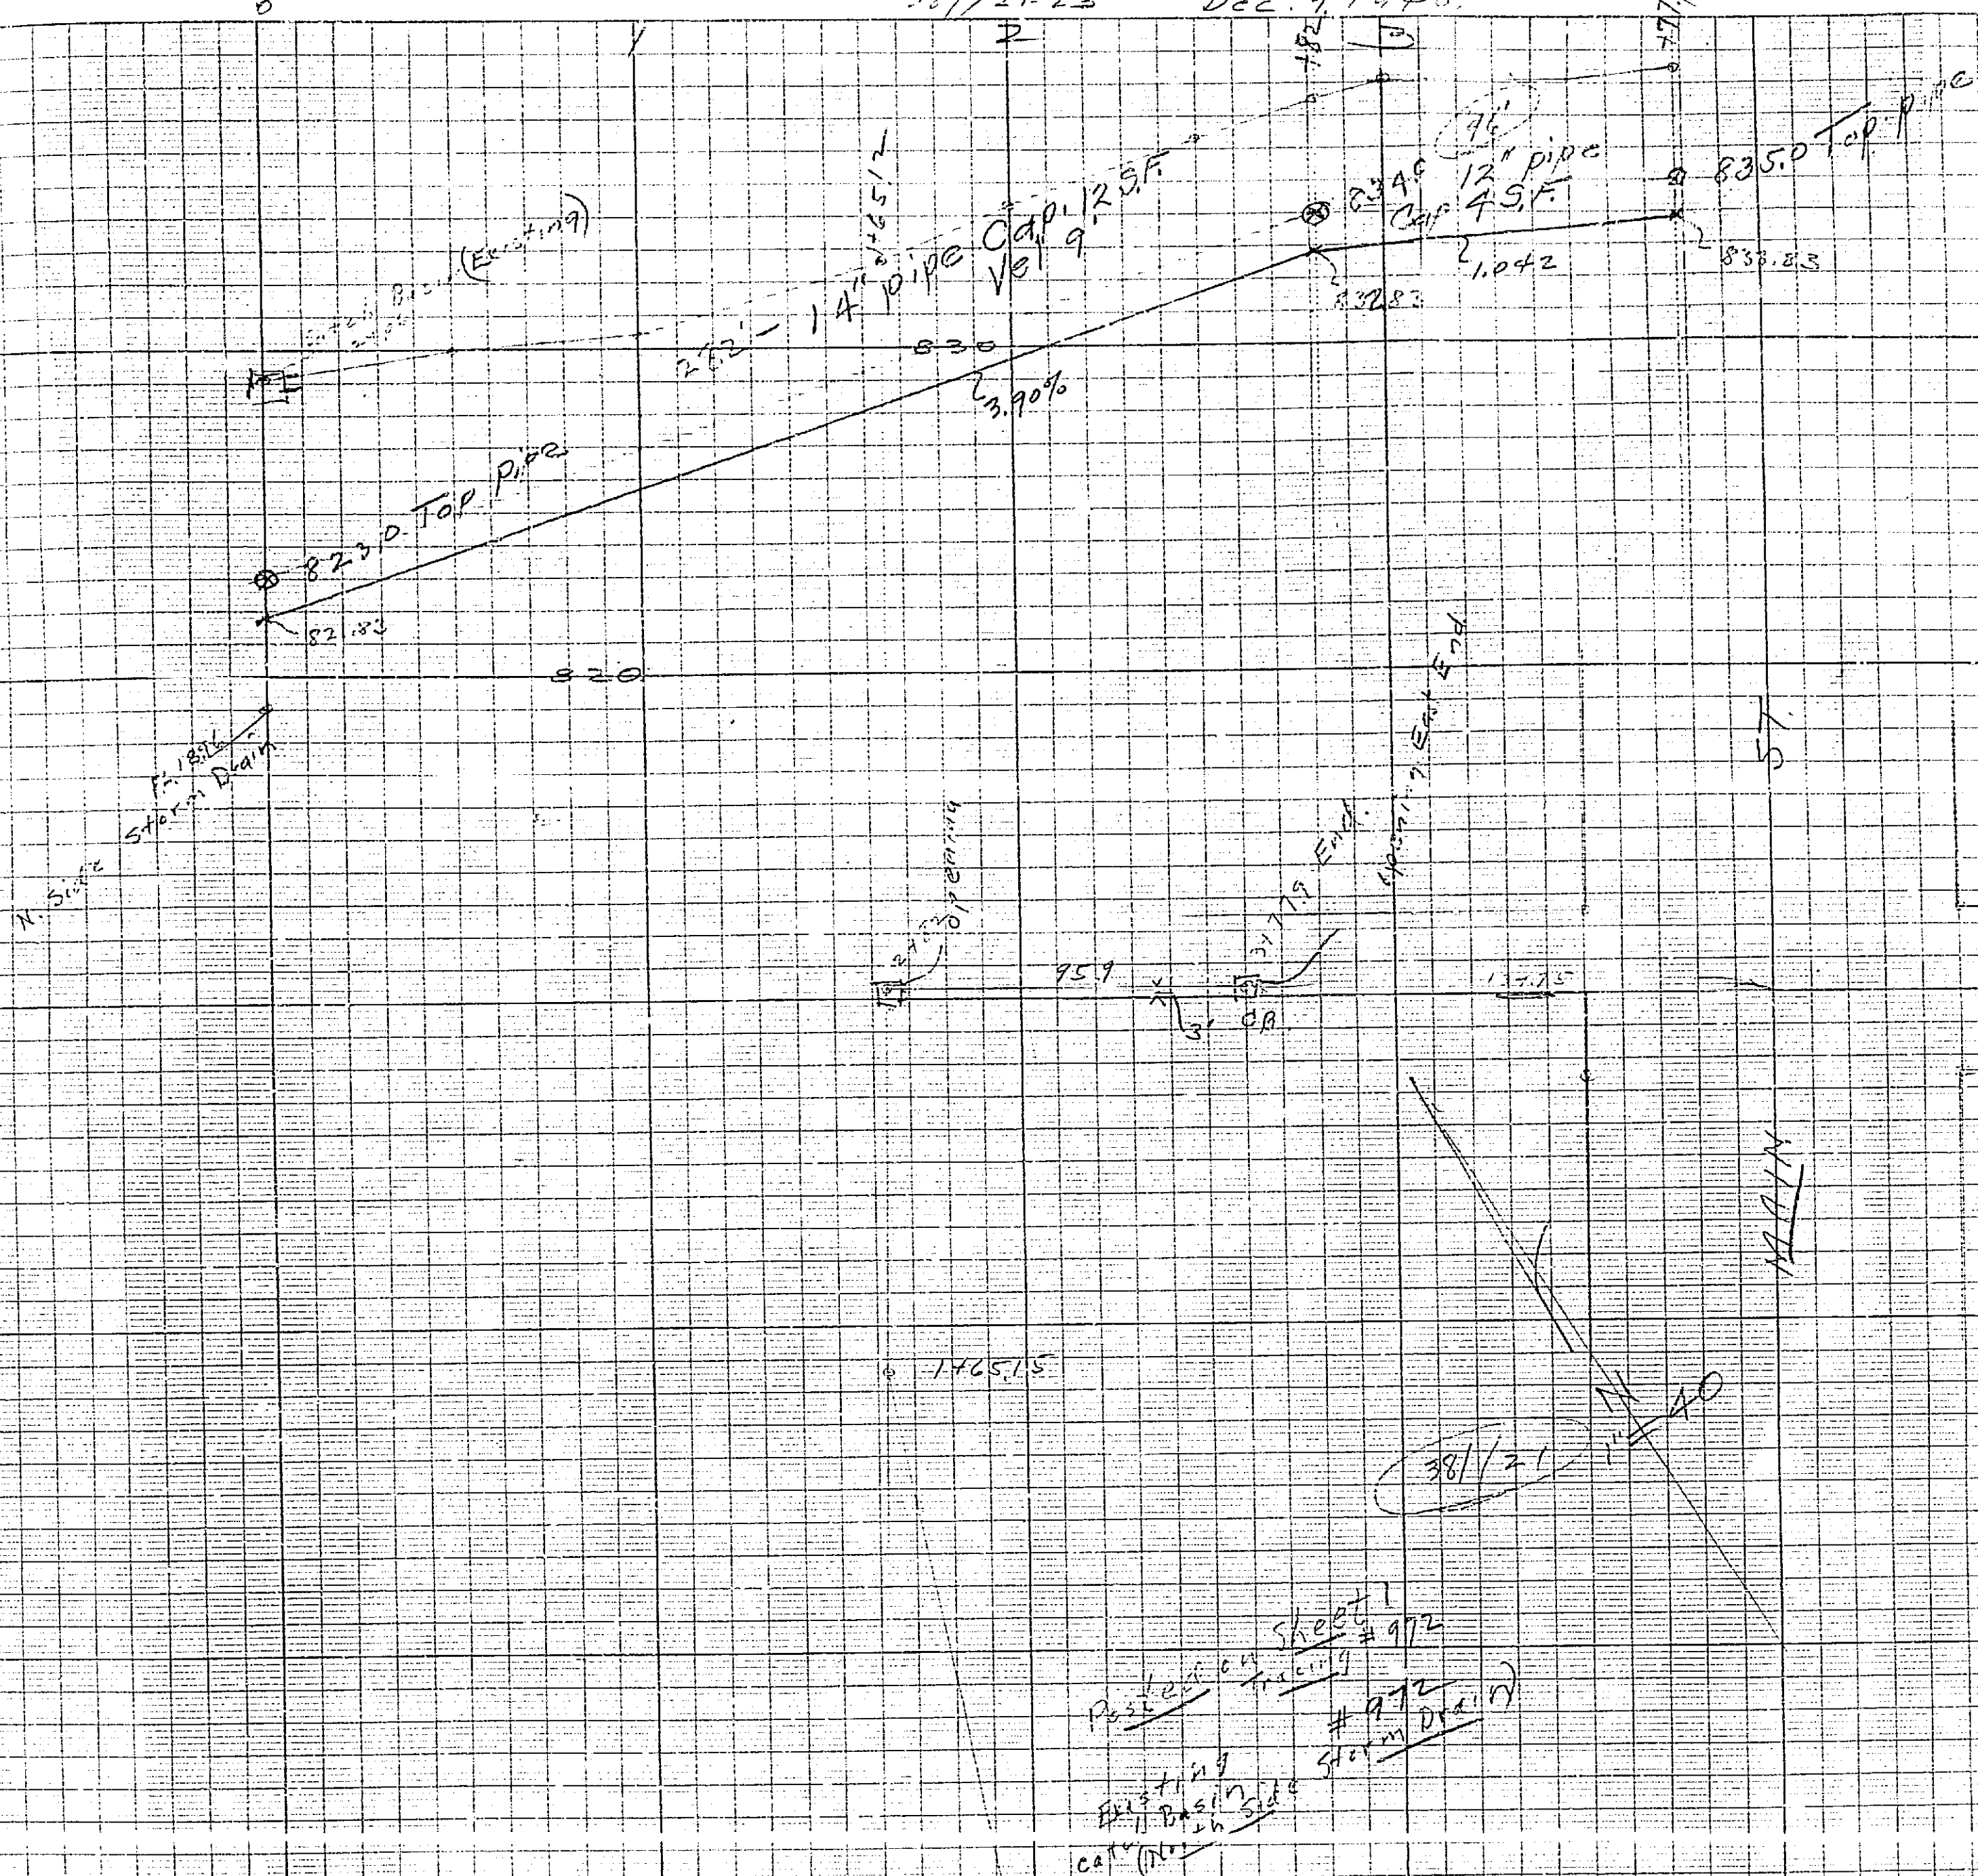

139.75  
959  
2357

# 288