


Note: Error 1/2" Bars Ordered for Deck. Spacing Changed to 2" C-C



CENTRAL AVE. TYPICAL REINFORCED CONCRETE BRIDGE

SCALE 1/2"=1' JUNE 1939
ENGINEERING DEPARTMENT

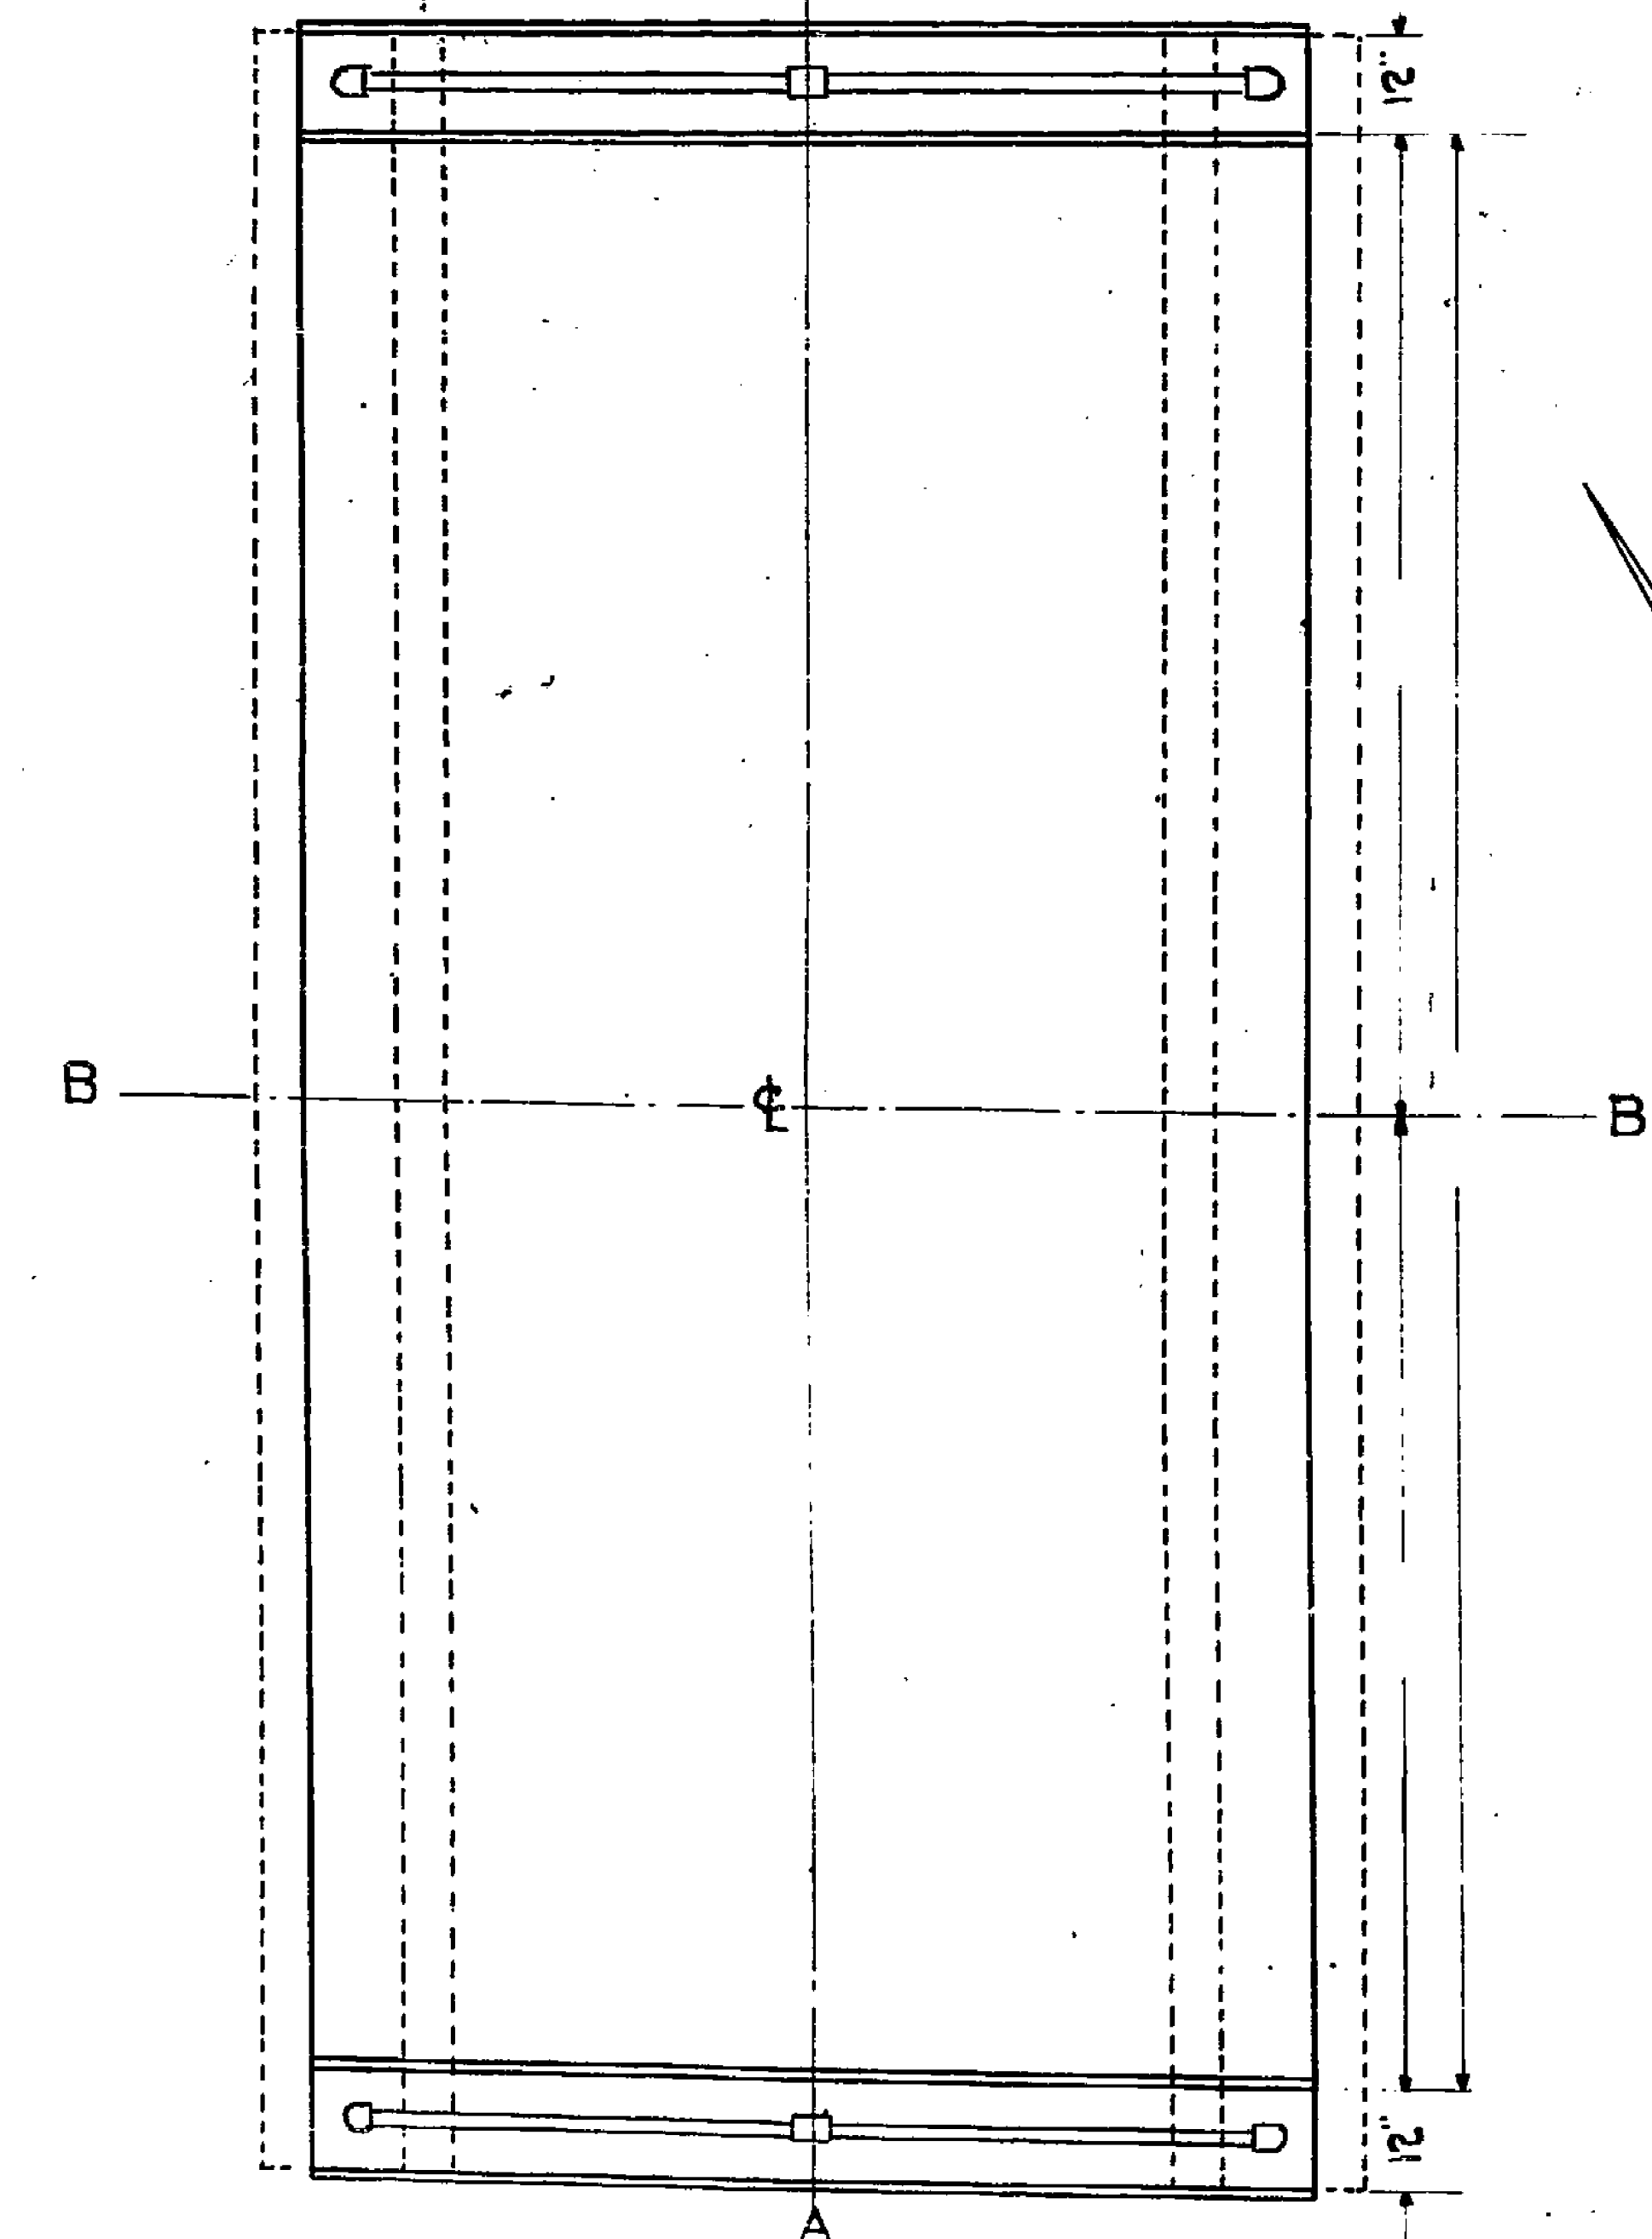