


DENTON ST
8.2
8.09

CRIDGE ST

DATE ST

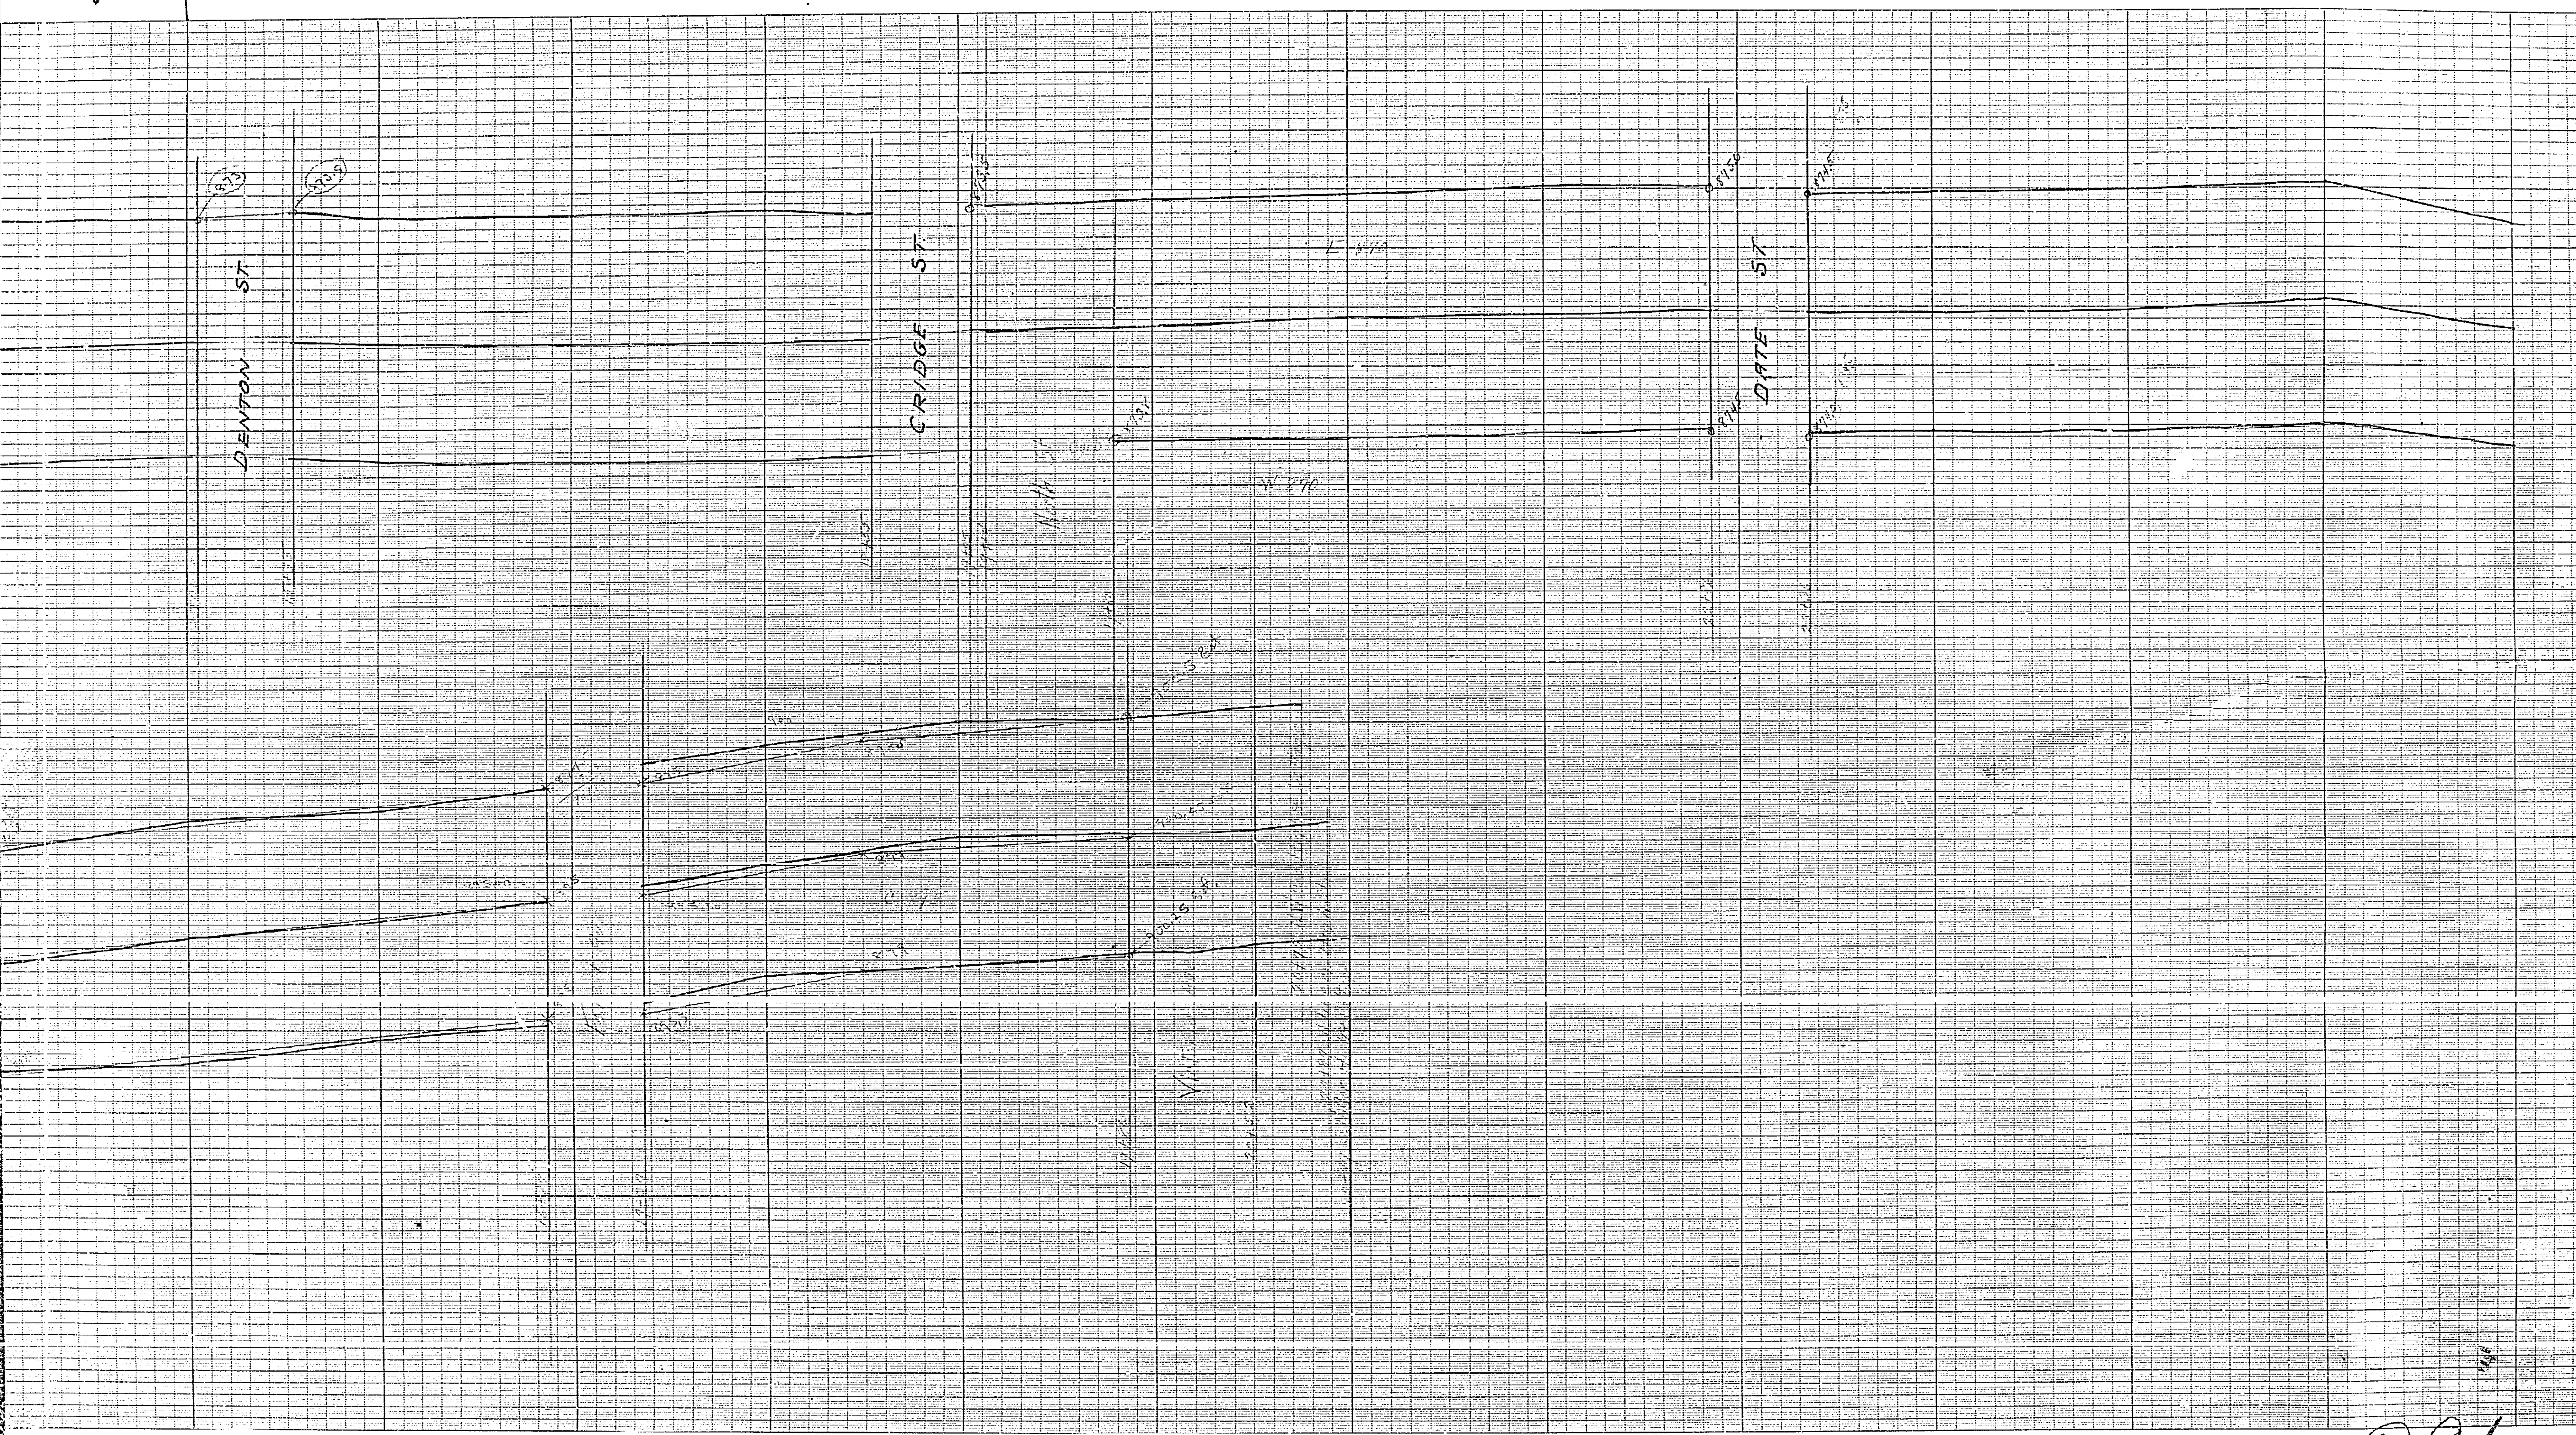

291

162

PACHAPPA AVE. 14th to ARROYO

Field Notes by
E. J. [unclear]

ST

COTTAGE

PLEASANT

ST

COTTAGE ST. PACHAPPA TO HIGH ST.

Field Notes by
E. J. [unclear]

HOWARD

AVE.

PARK

AVE.

North

South