


DATE	
BY	
PLAN	DESIGNED
	DRAWN
	CHECKED
	IN CHARGE
	BY CITY ENGINEER

DATE	
BY	
PROFILE	DESIGNED
	DRAWN
	CHECKED
	IN CHARGE
	BY CITY ENGINEER

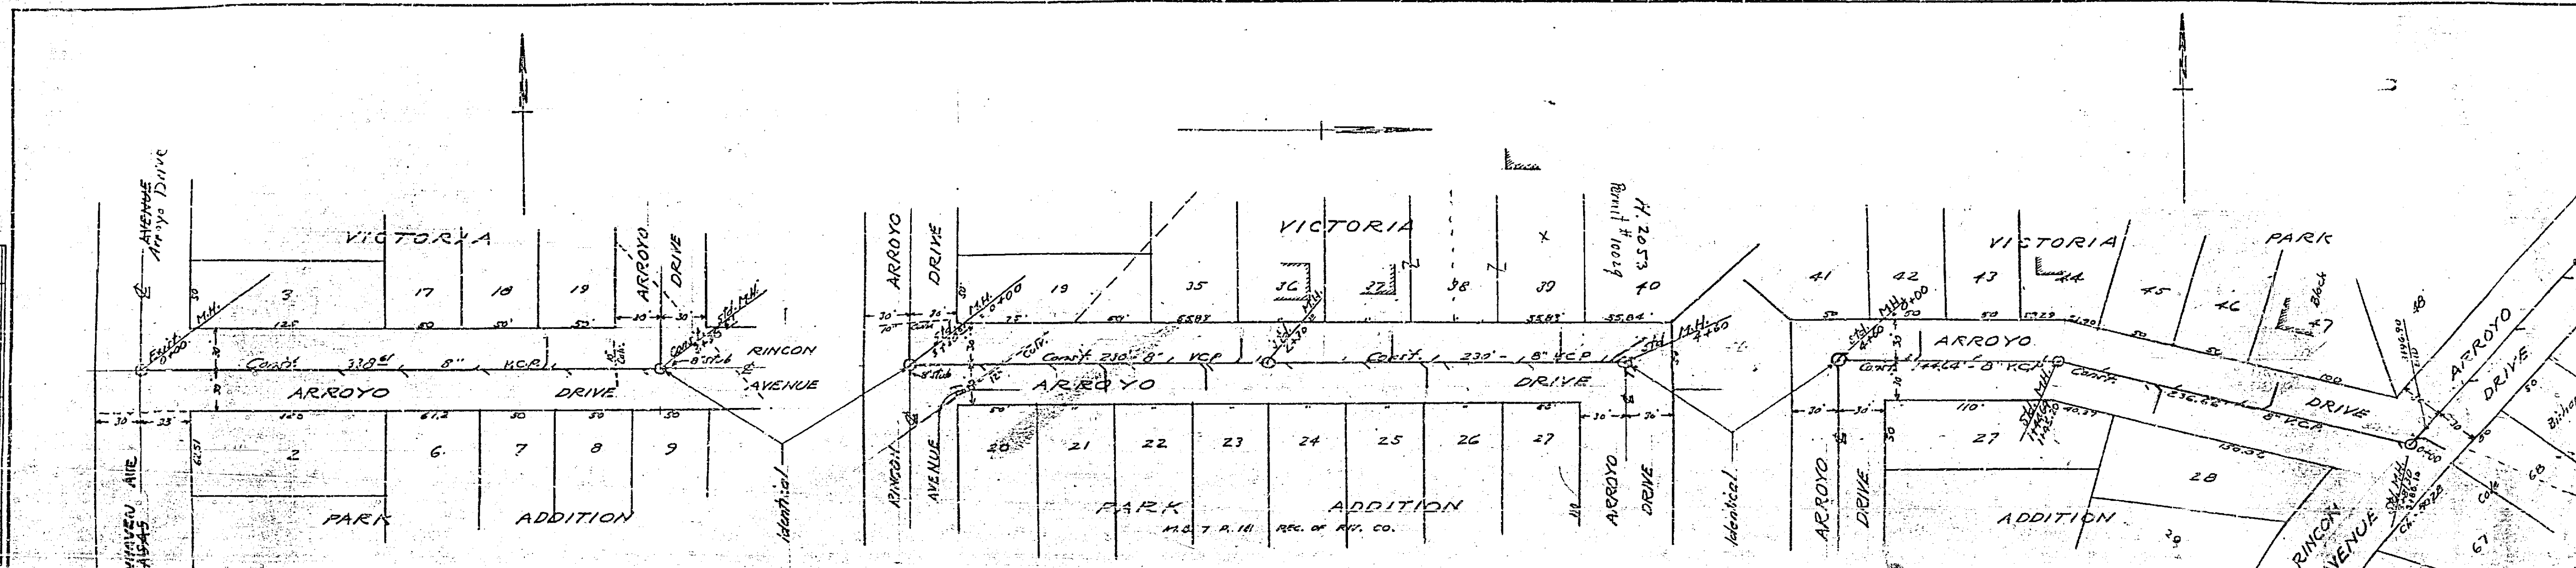

PLAN & PROFILE NO. 359
 FOR THE CONSTRUCTION OF A SANITARY SEWER IN
 ARROYO DRIVE
 FROM KANSAS AVENUE EASTERLY & NORTHERLY
 CITY OF RIVERSIDE
 P.D. 300-302-422-420 FEB. 1951 REF. PLAN 513
 APPROVED: *M.H. [Signature]* SCALES: HOR. 1"=40' VERT. 1"=5' FT.
 REG. C.E. #1307 - CITY ENGINEER

N.B. See Letter & Map

RED. AS CONSTRUCTED 10.512/53

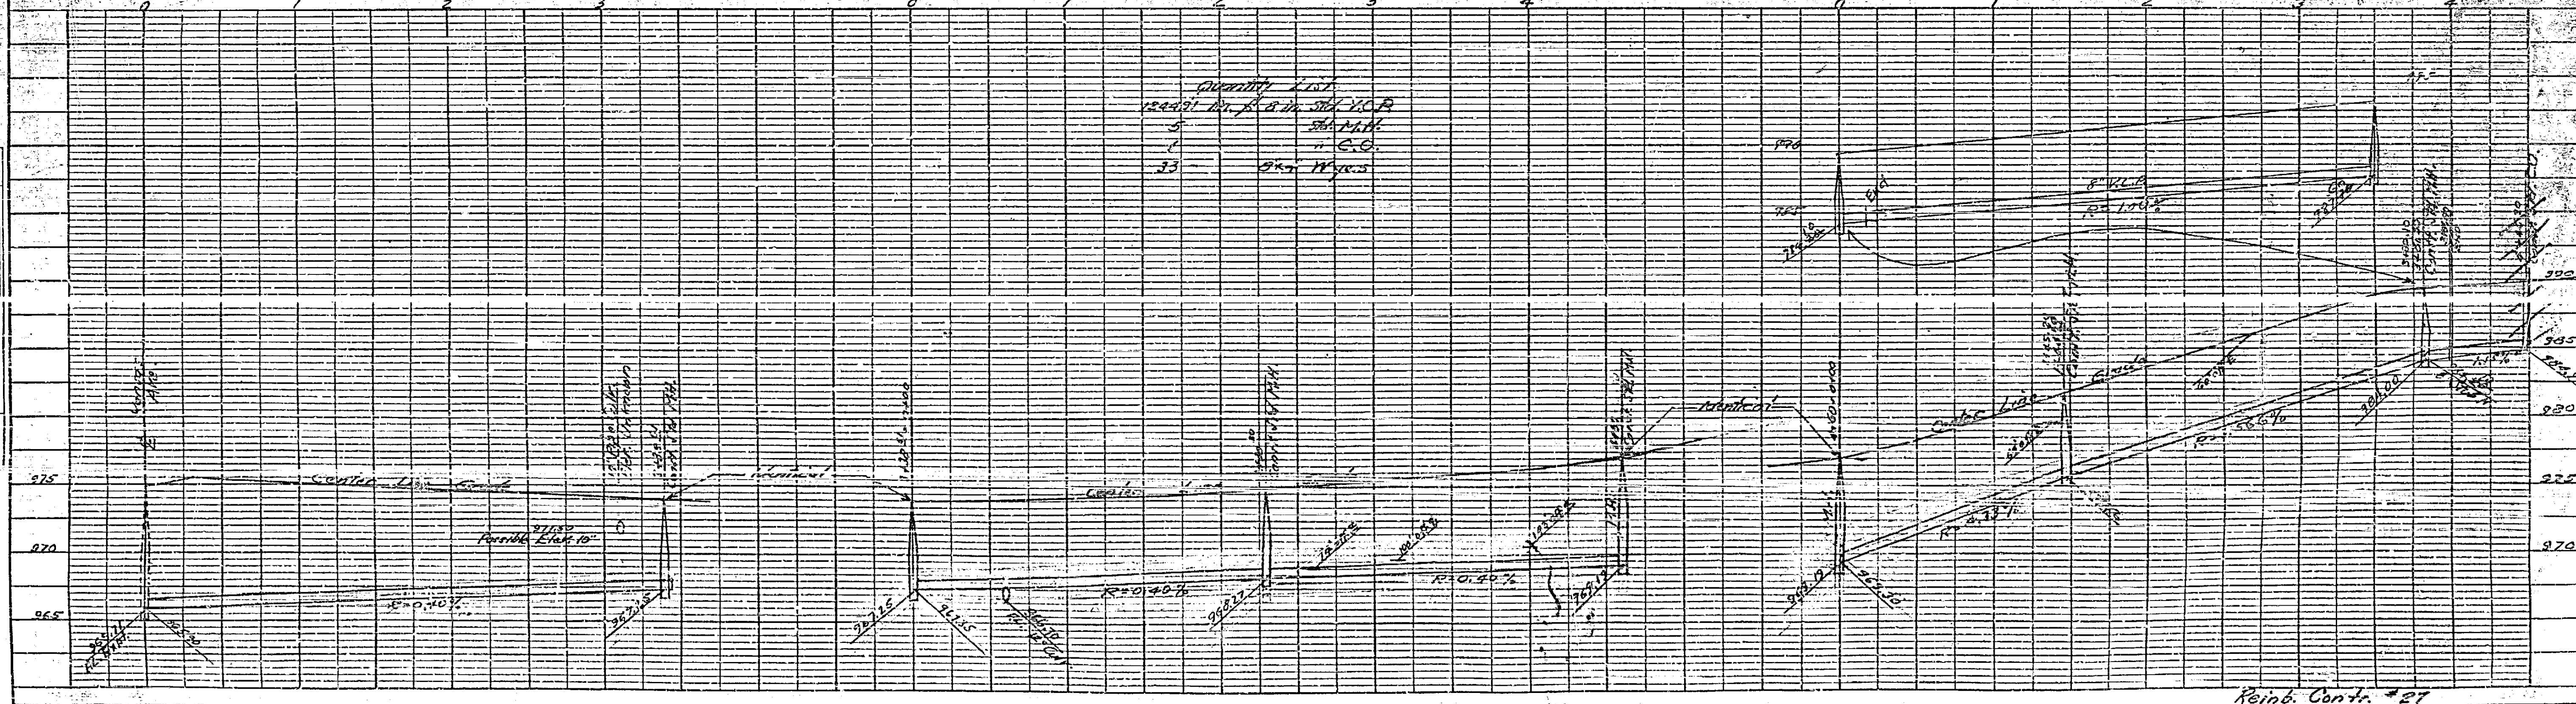


PLATE 1 - PLAN - PROFILE, D. P. R. & E.
 CLEARPRINT PAPER COMPANY, S. F. CAL.
 No. 3009-1

Reinb. Contr. #27

359