

Map No. 365

305 B

Scale 1/4" = 1' HORIZ
Mix of Concrete Pipe 1 part Cement
3 parts aggregate


Book 1741 Page 15
Constructed Aug 18-23, 1927

See Map No. 3
Drains 13
Ma

THIRTEENTH STREET

Grant School Drainage Sewer

TRACED FROM
PROFILE 302
Aug 2, 1927
Scale 1" = 40' HOR
1" = 4' VERT

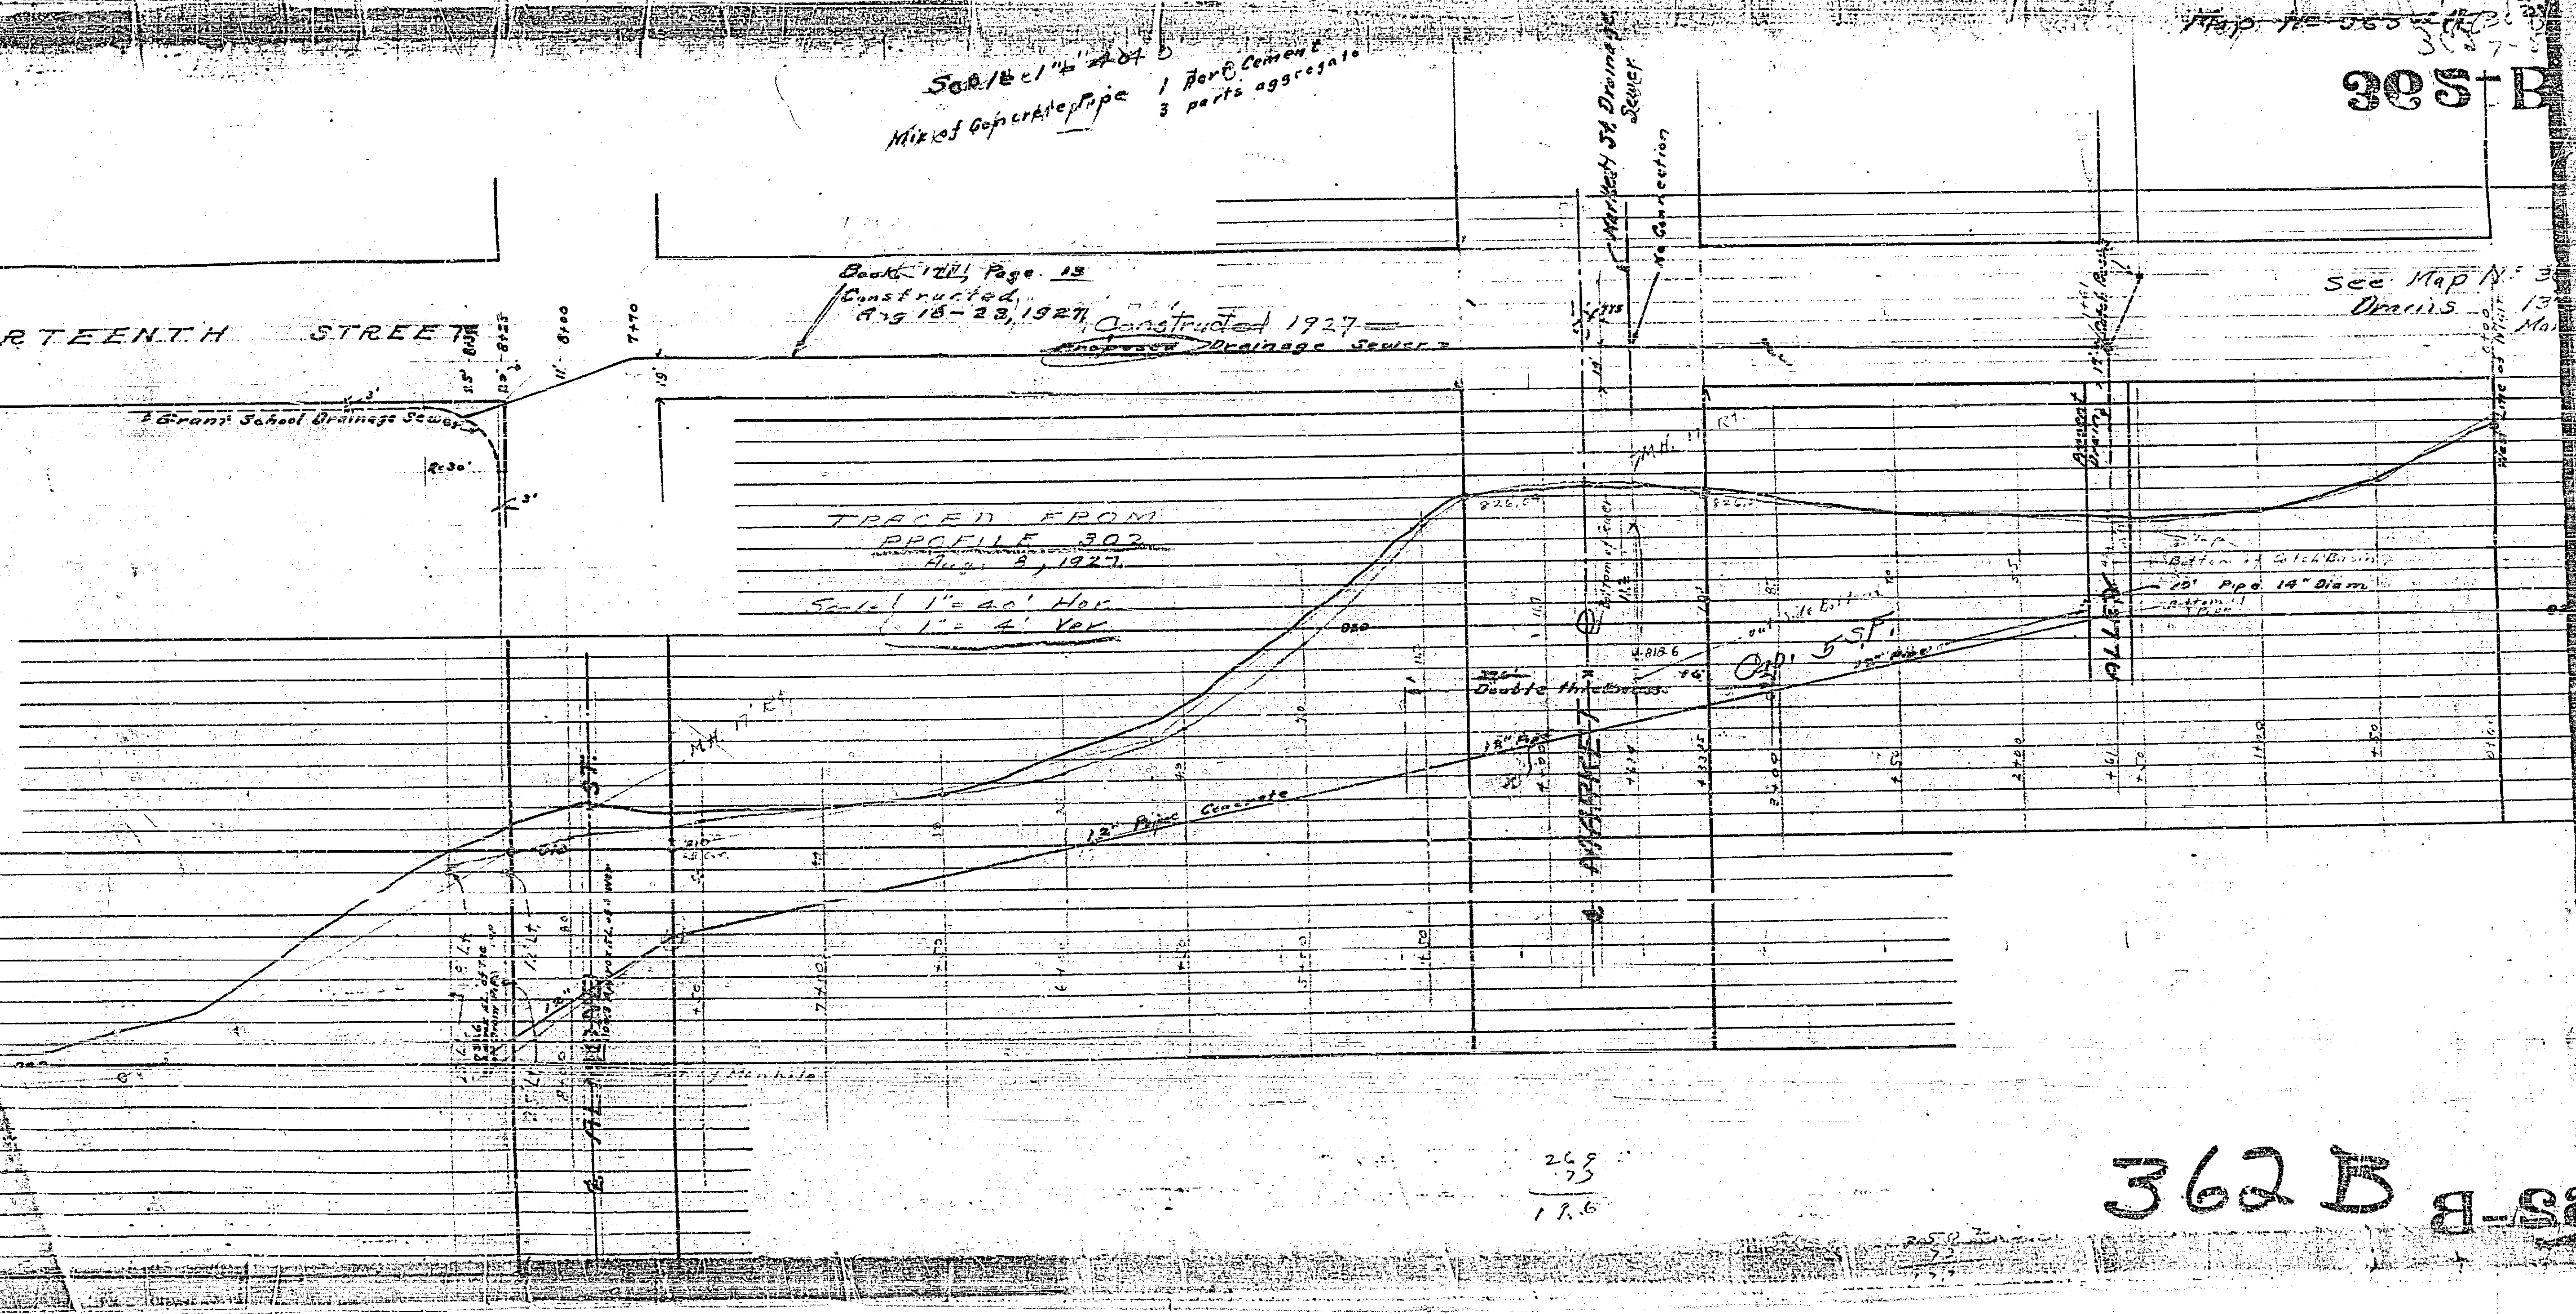

268
75
19.6

362 B