


10  
11

REVISIONS
NO.
DATE
DESCRIPTION
BY
CHECKED

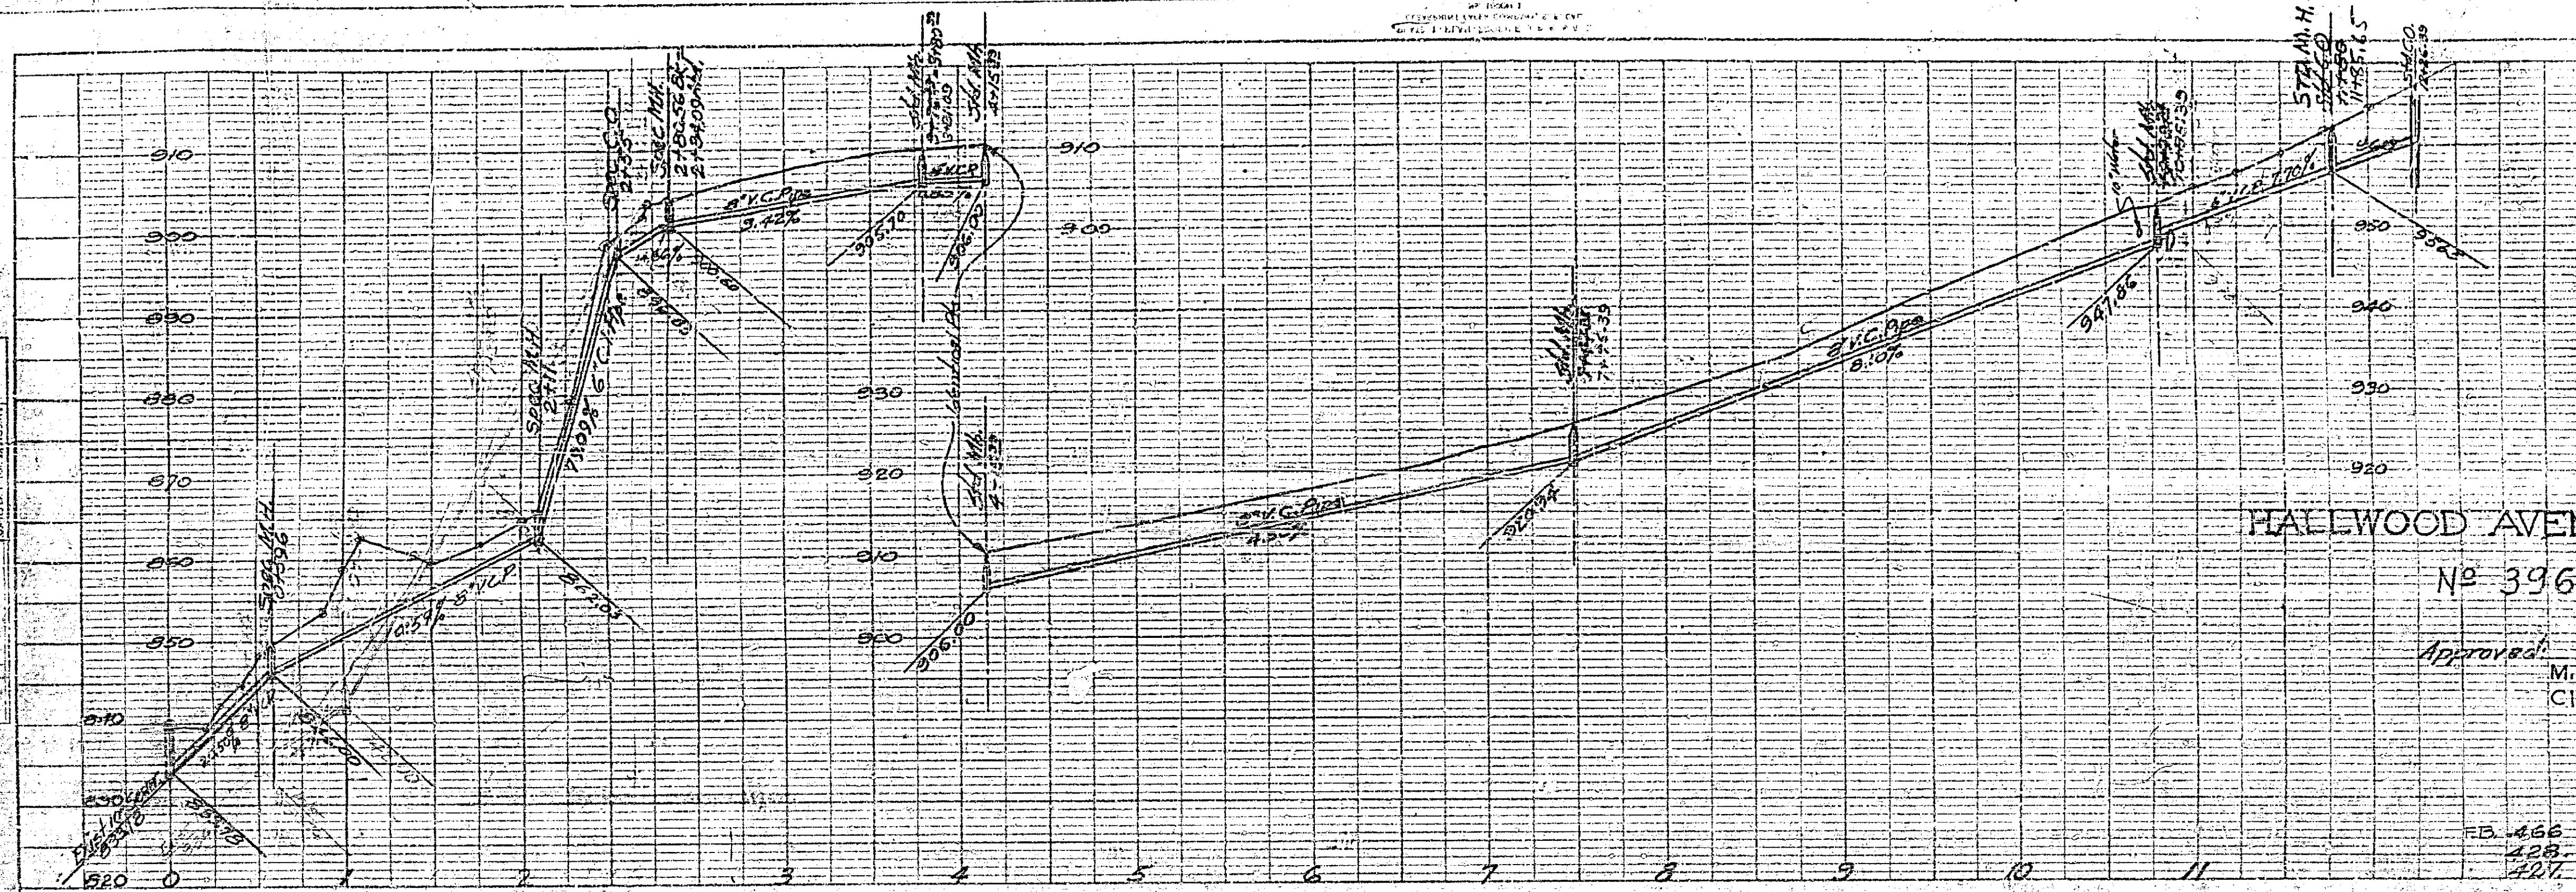

### HALLWOOD AVENUE SEWER


No 396

Approved: M. H. Irvine  
M. H. IRVINE, REG. CE 3301  
CITY ENGINEER

PROFILE  
H.B. 466  
228  
427  
HOR. 1" = 50'  
SCALE VER. 1" = 10'

NOTE: RED LINE SHOWS AS CONSTRUCTED.

REVISIONS
NO.
DATE
DESCRIPTION
BY
CHECKED

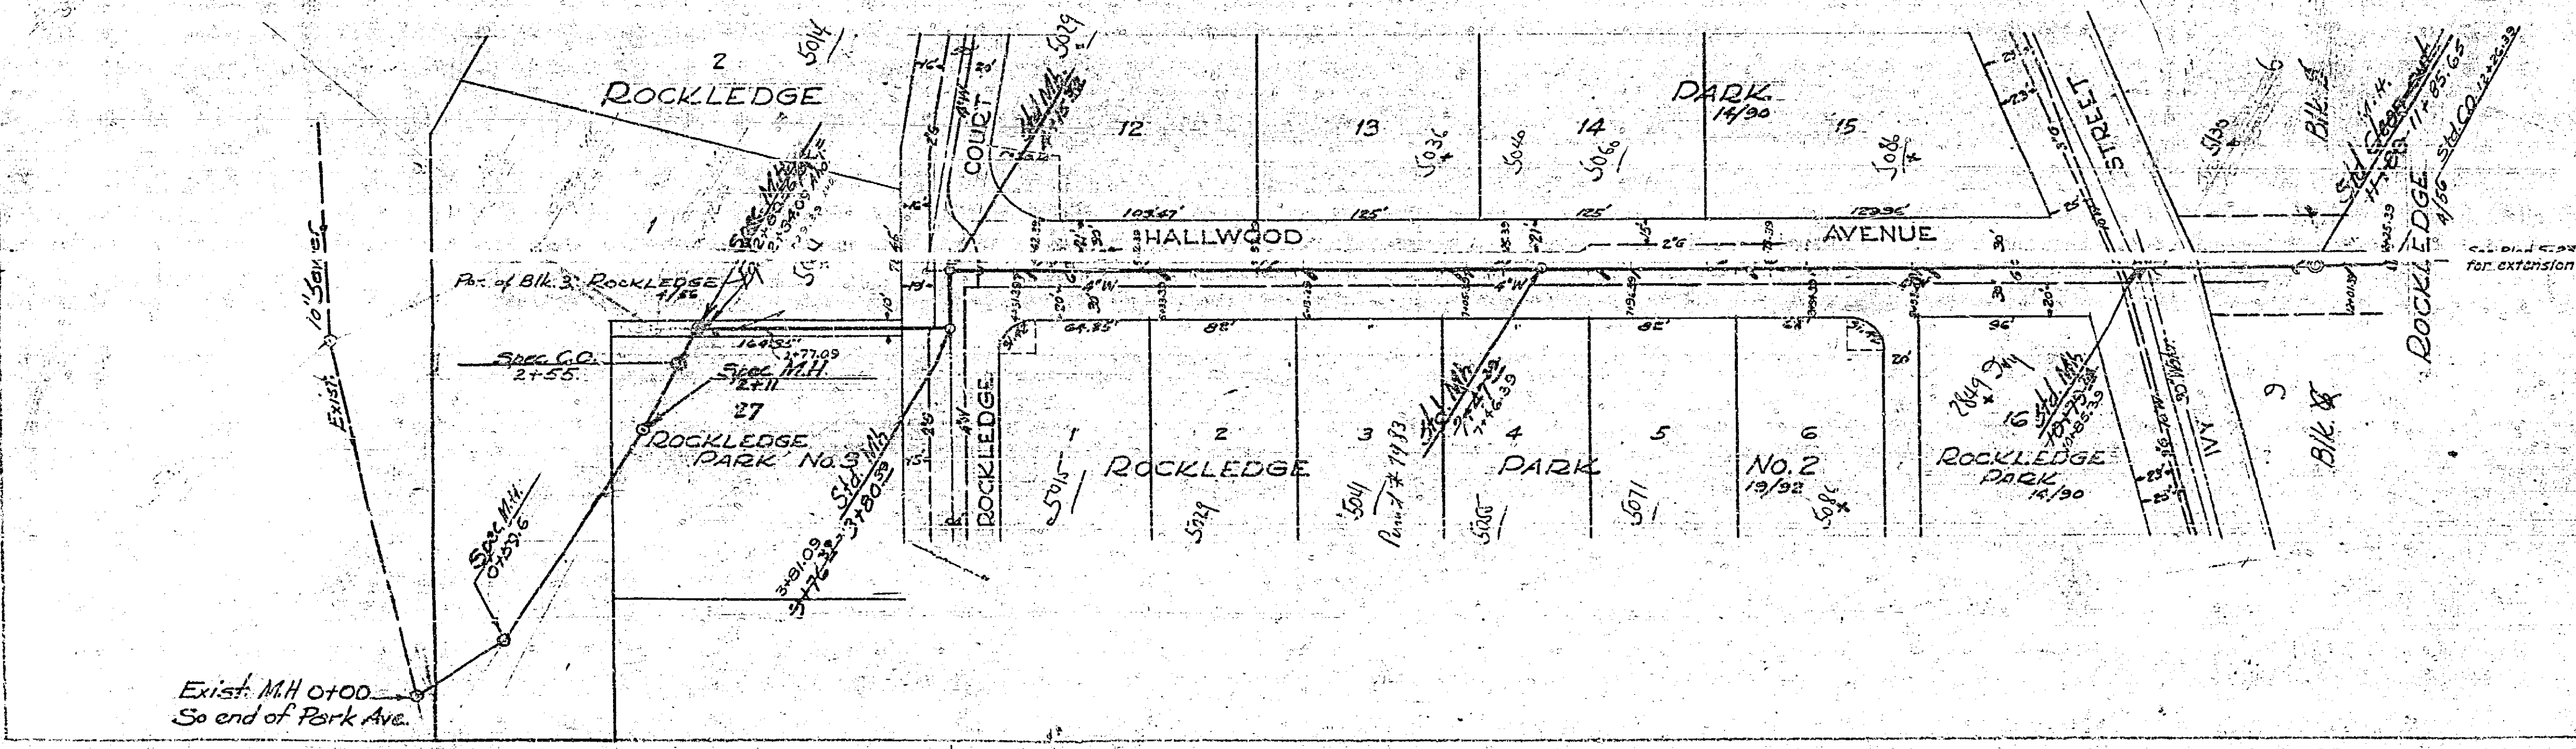

396