


Pleasant St.  
 Sewer Profile  
 Notes in Book 37 Page 11.  
 Scale, 6" and 60' per.  
 Made Aug. 26, 1910  
 Levels taken Aug 19.

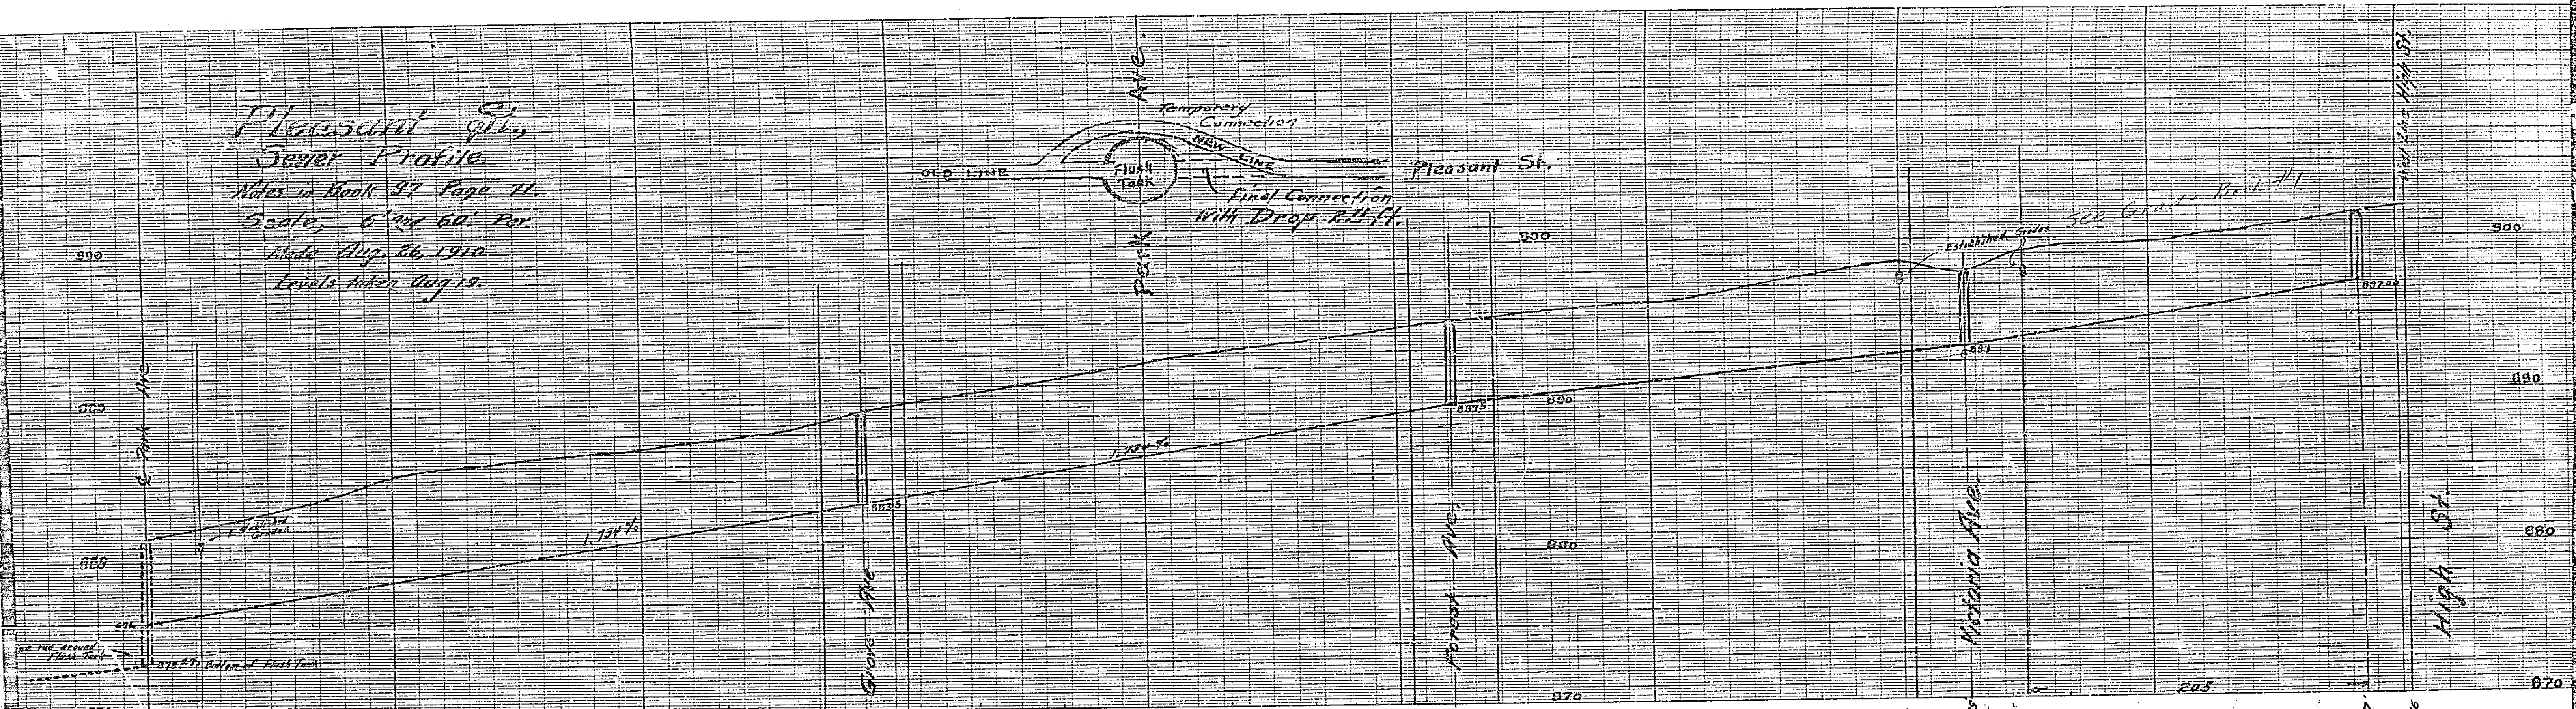

"Perfect" PROFILE PAPER.  
 PLATE. B.

477A  
 "Perfect" PROFILE PAPER  
 PLATE. B.