



NORTH

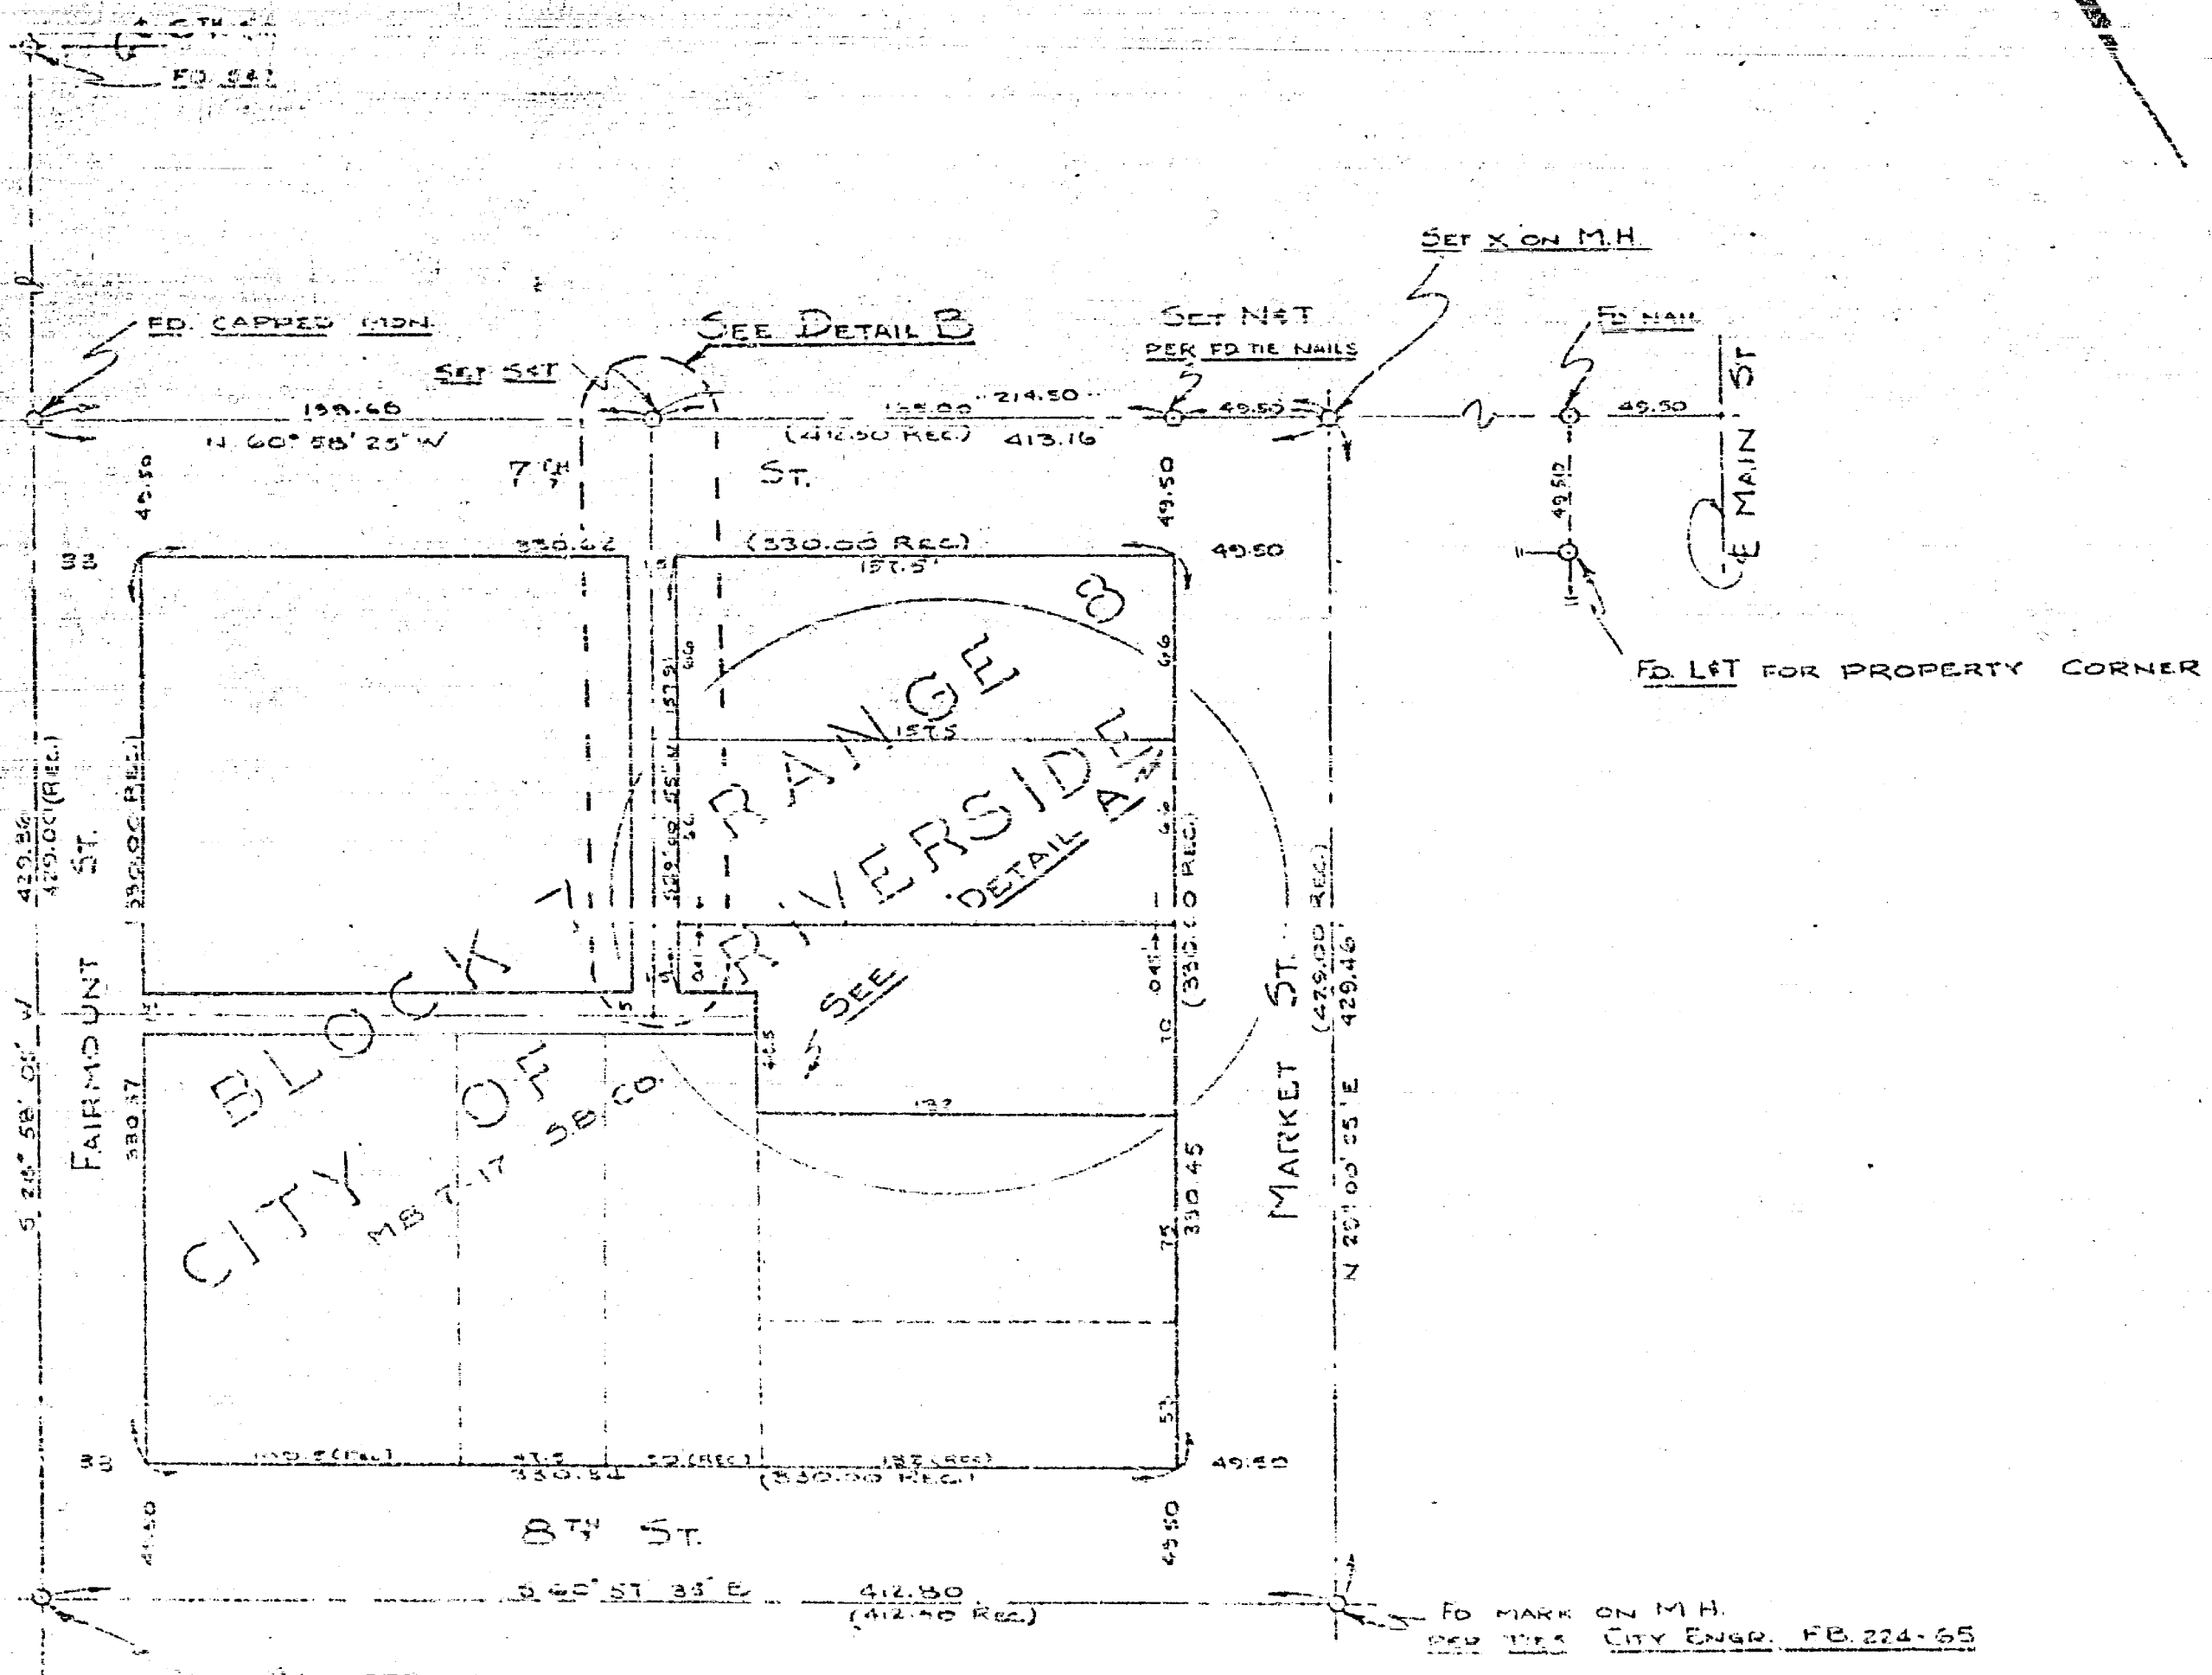

SCALE 1"=50'

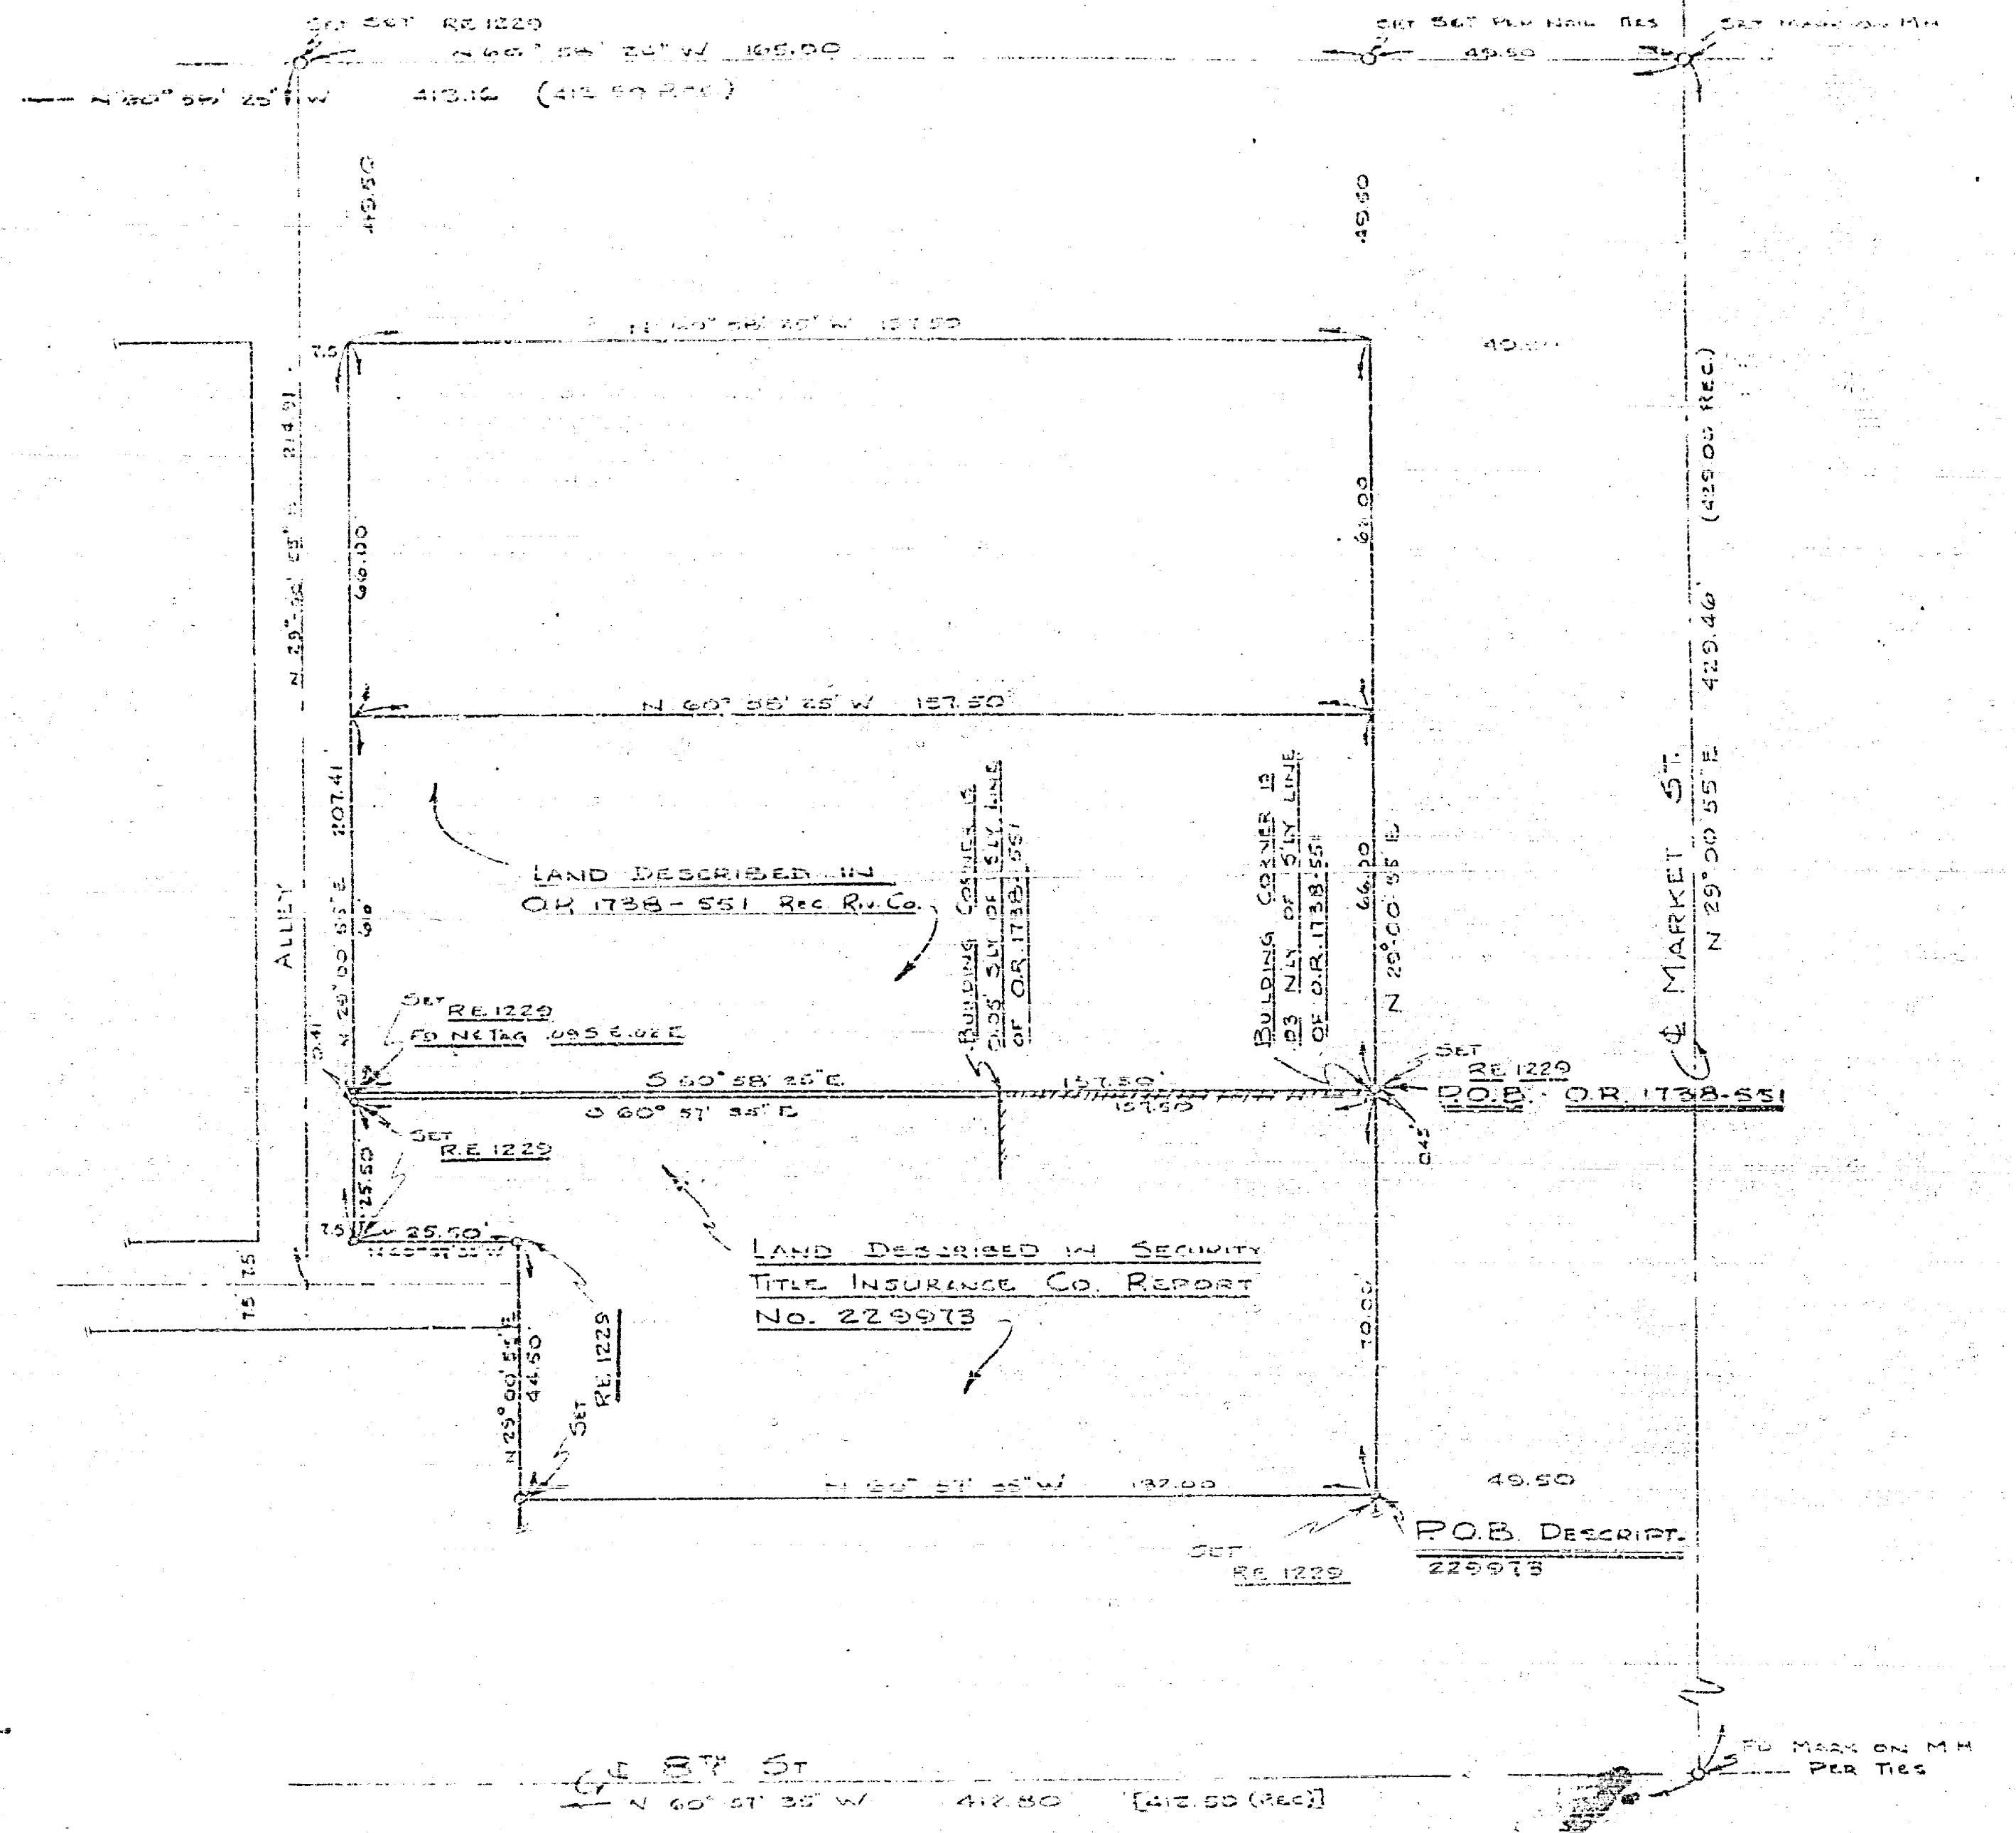

SCALE 1"=20'

REVISIONS	DATE	BY

CITY OF RIVERSIDE
SURVEY PLAN
PORTION OF BLOCK 7 RANGE 8
OF THE CITY OF RIVERSIDE AS
RECORDED IN MAP 17 SB COUNTY

SCALE 1"=50'	DATE 8-12-55	DWG. NO.
DRAWN BY T. T.	CHECKED - NW	DATE 11-1-55
TRACED	BY 109	BY 110

ALBERT A. WEBB ASSOCIATES
CIVIL ENGINEERS
RIVERSIDE CALIFORNIA

438D