


# SEWER IN CASTLE REAGH SUBD


LOT 187 SIOGA LANDS

NOTES IN BOOK 131 pages 32 to 38

OCT 7-1922  
L.T.D.V.

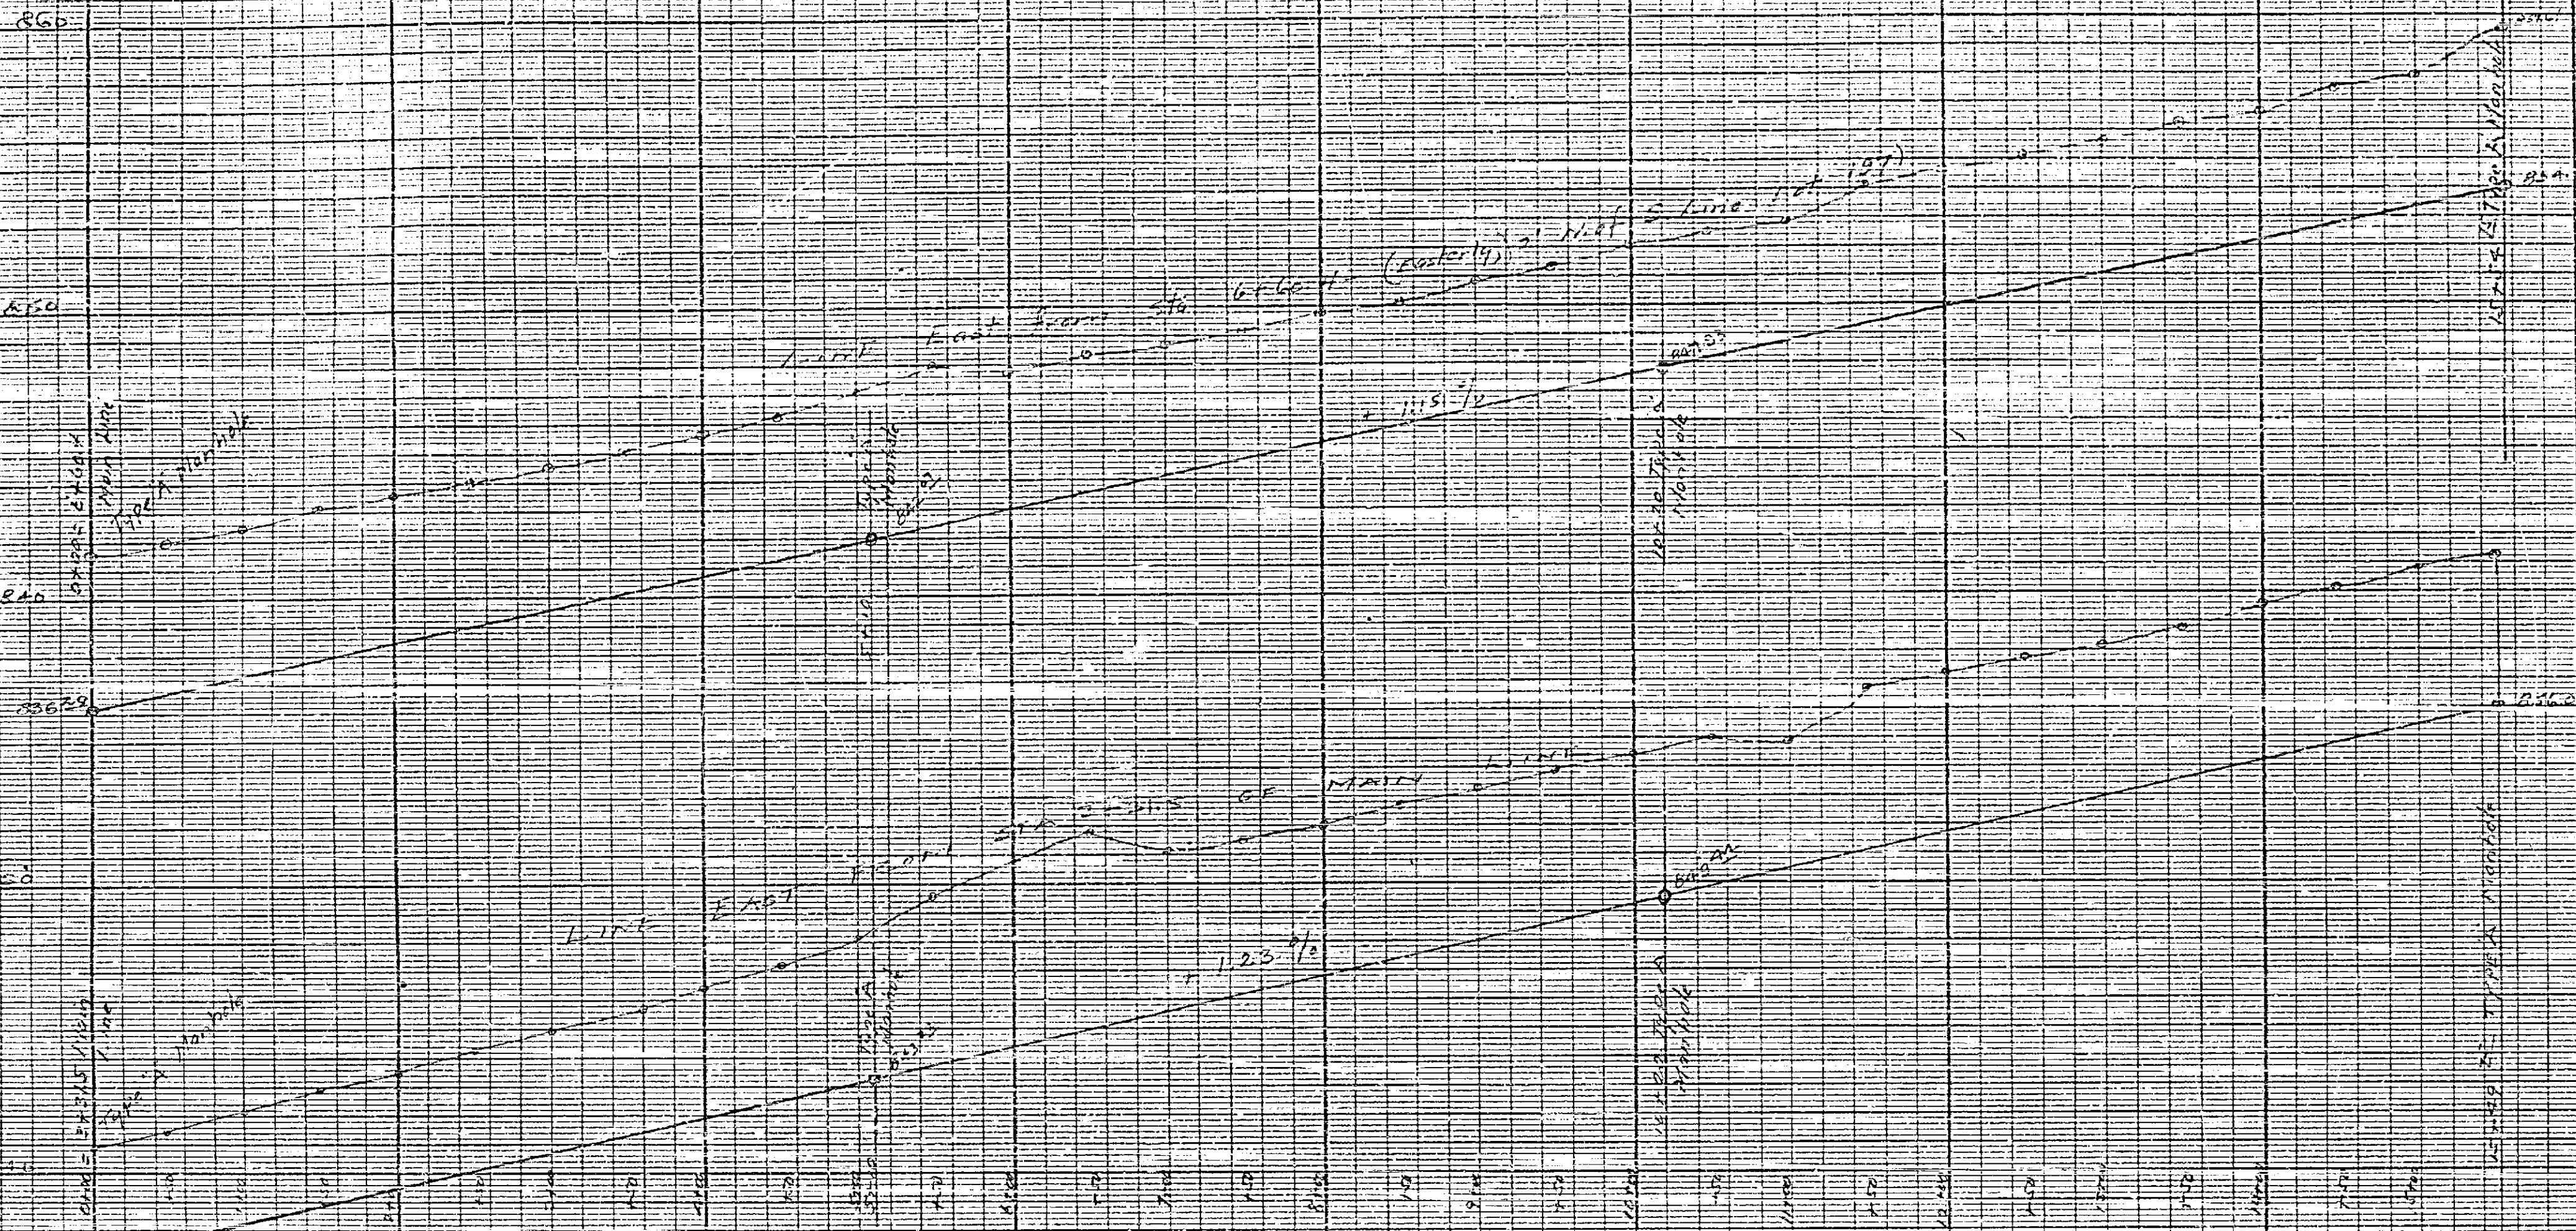

SEWER IN CASTLE REAGH SUBD  
 From Manhole 1 at E. Line of Lot 187 S. to Manhole 3 at S. Line of Lot 187 S.  
 No. 12 Pipe 12" Dia. 100' Length

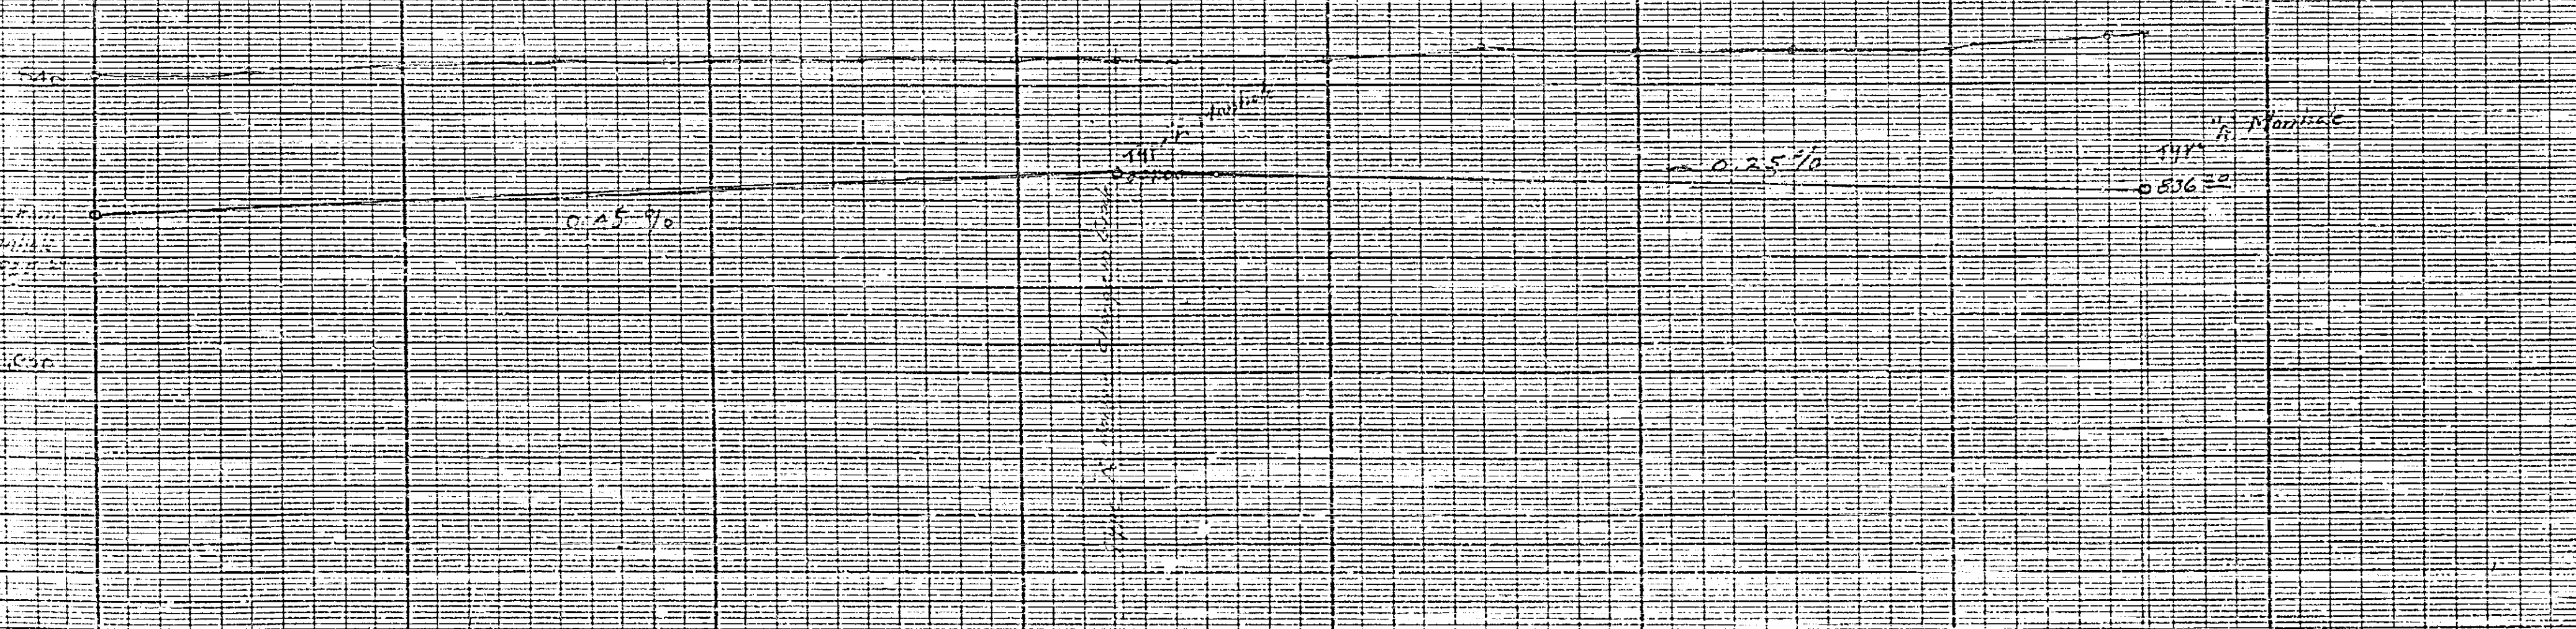

440