


Survey of part of lots 142
River View Tract

Feb 1-1911

Scale 1"=100'

But see Hufnagar old survey of
portion of said lots, by Geo. H. Hufnagar
surveyed and used

100-21
100-31

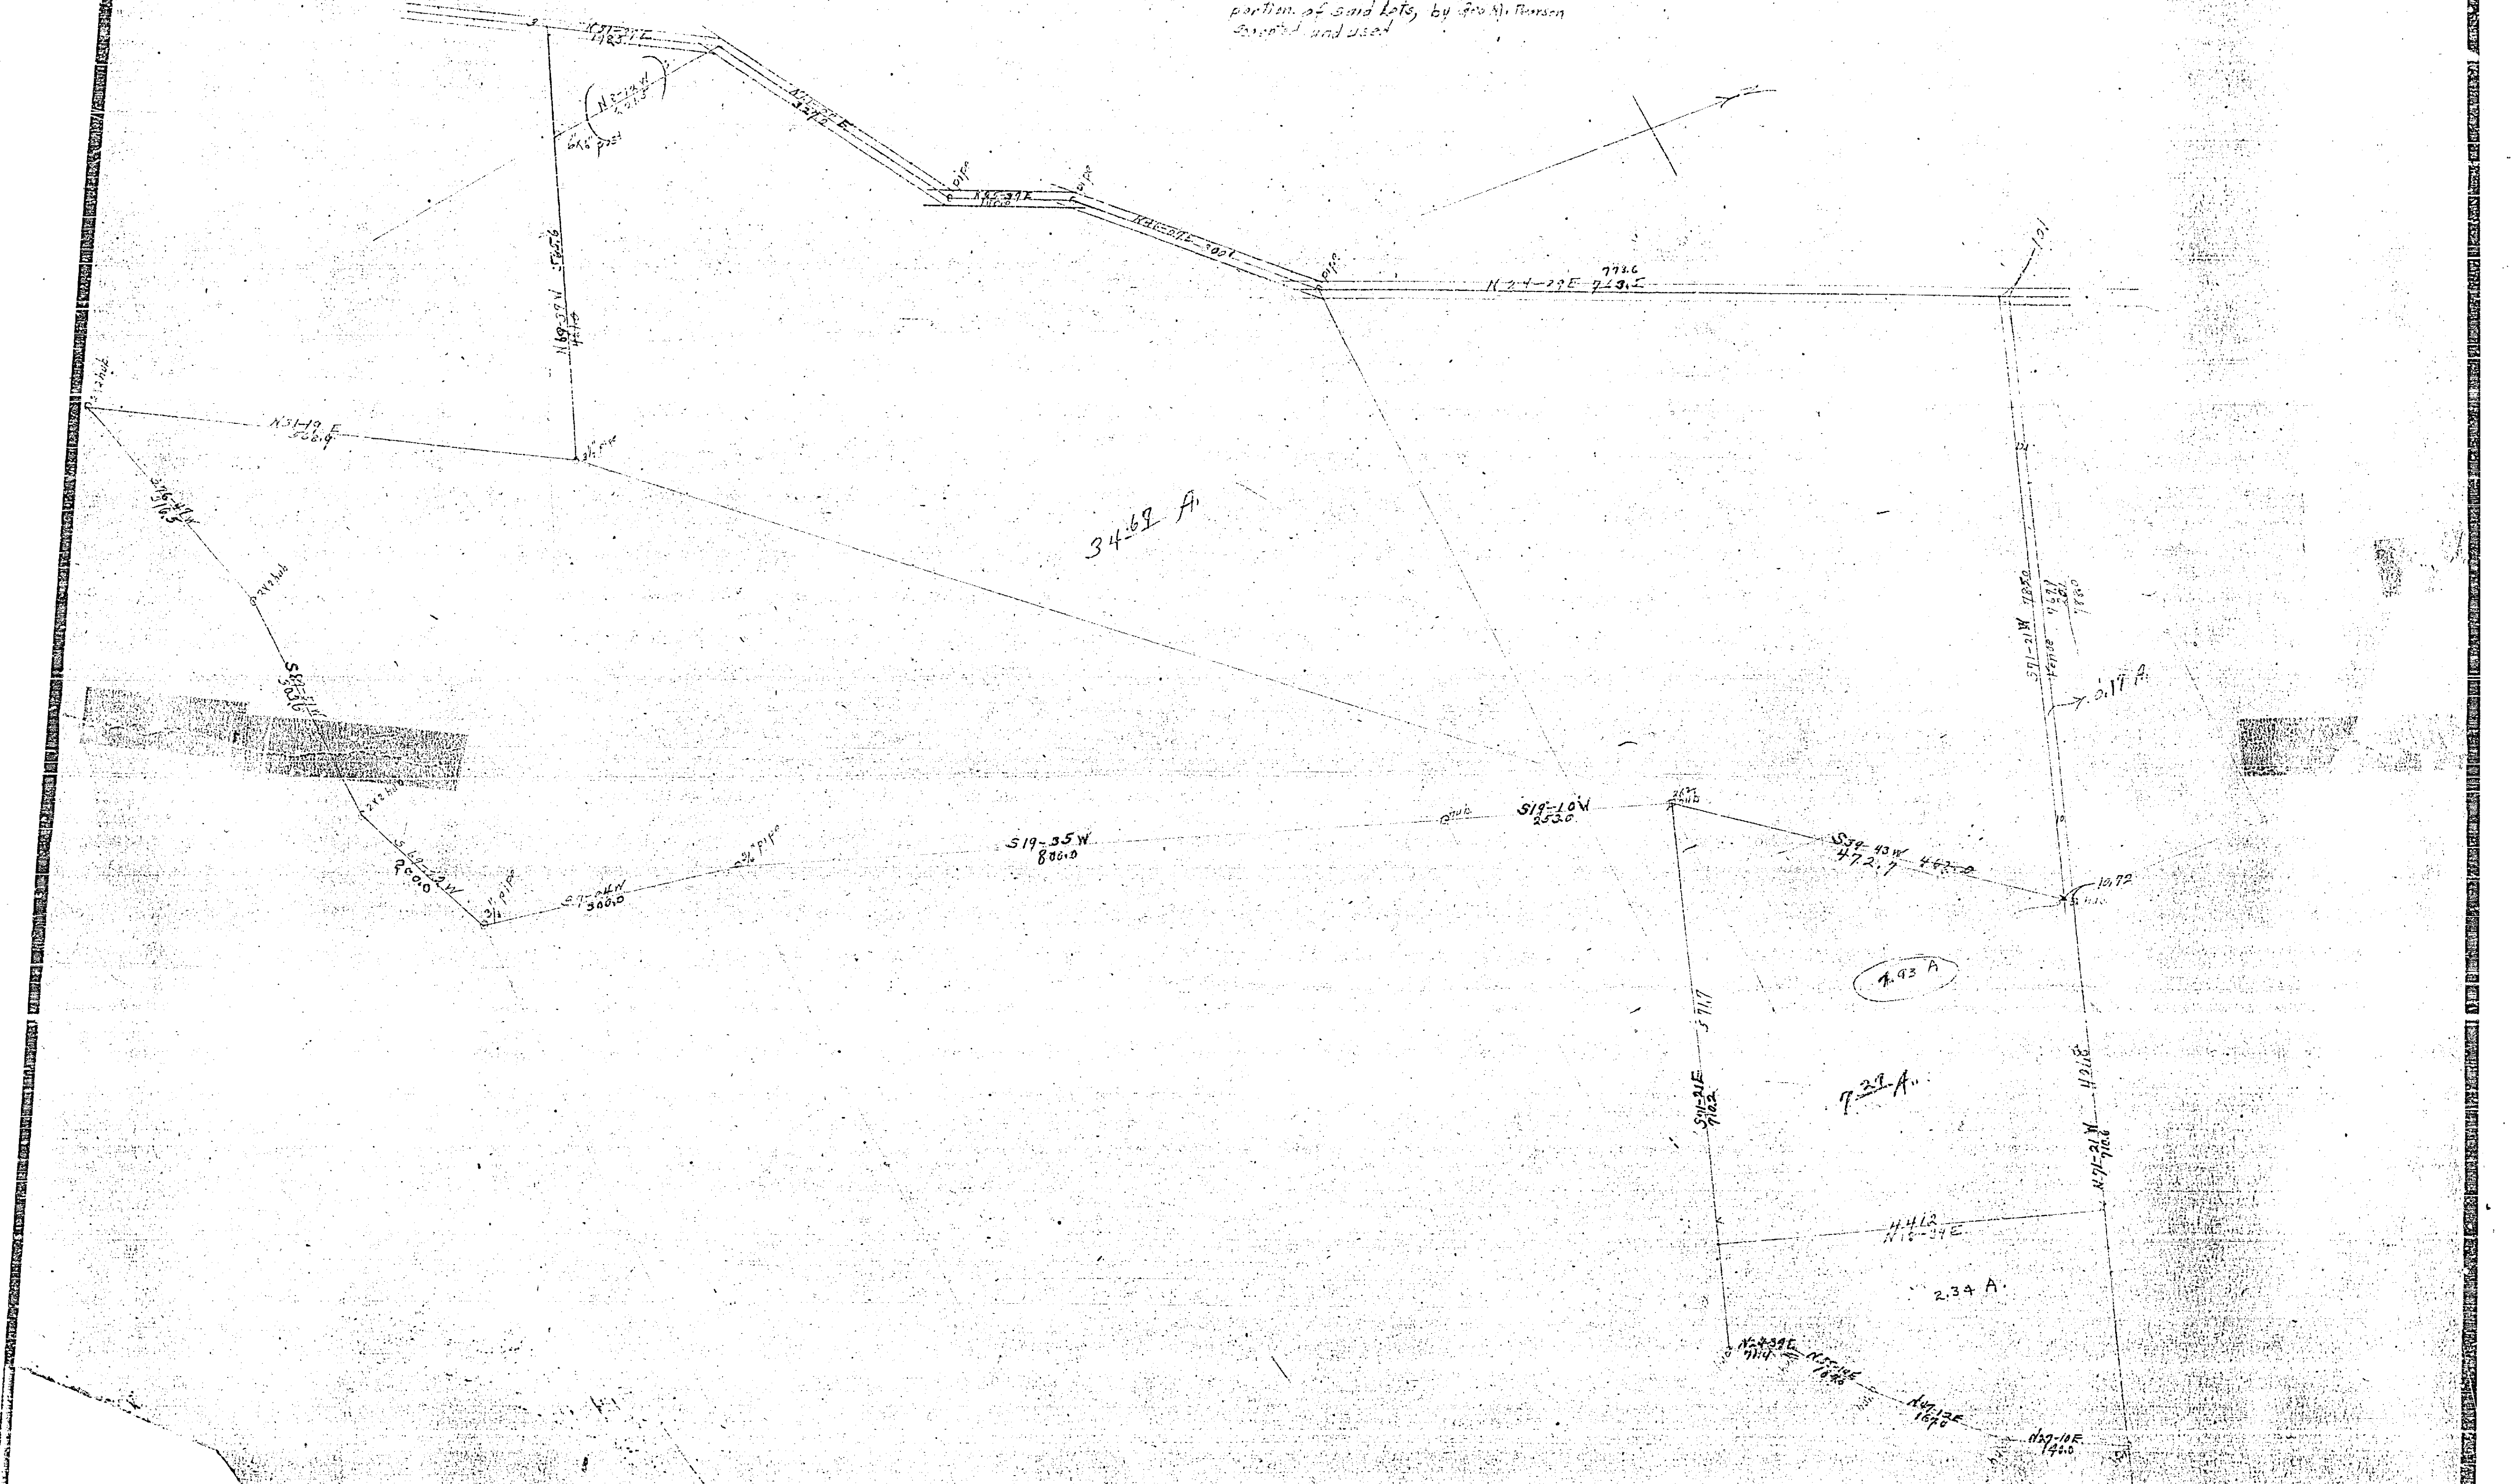

451B