

PLANS AND PROFILES

OF THE PROPOSED STREET IMPROVEMENT OF

KANSAS AVE. AND LINDEN ST.

ENGINEERING DEPT. - CITY OF RIVERSIDE - - - JULY 1933



FIELD BOOKS
BK 268 PG. 1-30

ELEVATIONS SHOWN HEREON ARE U.S.G.S. DATUM WHICH IS THE OFFICIAL CITY DATUM PLANE AS ESTABLISHED BY ORD. NO. 551 N5.

Constructed by Street Dept. ~~1933~~ ^{Mar 1934}

APPROVED AND ADOPTED BY THE MAYOR AND COUNCIL OF THE CITY OF RIVERSIDE THIS 19TH DAY OF JUNE 1934.

Edward Jones
CITY CLERK, CITY OF RIVERSIDE.

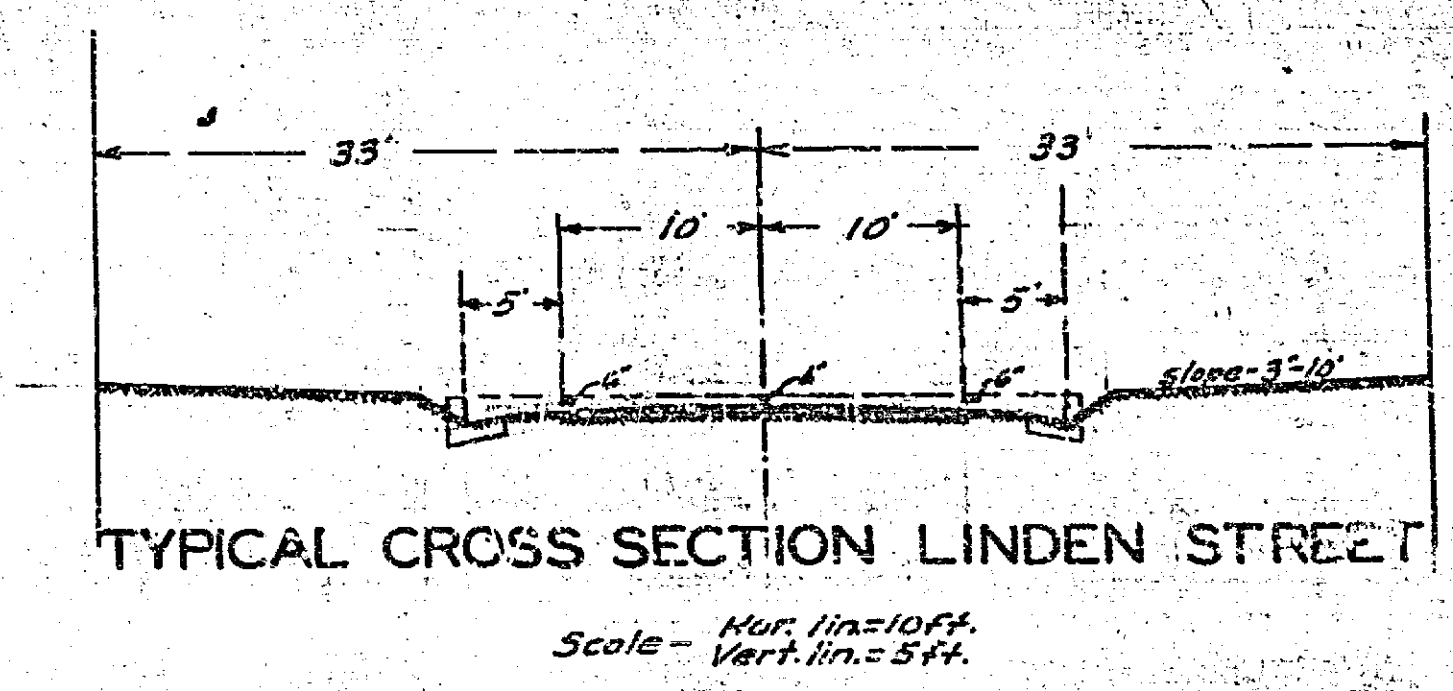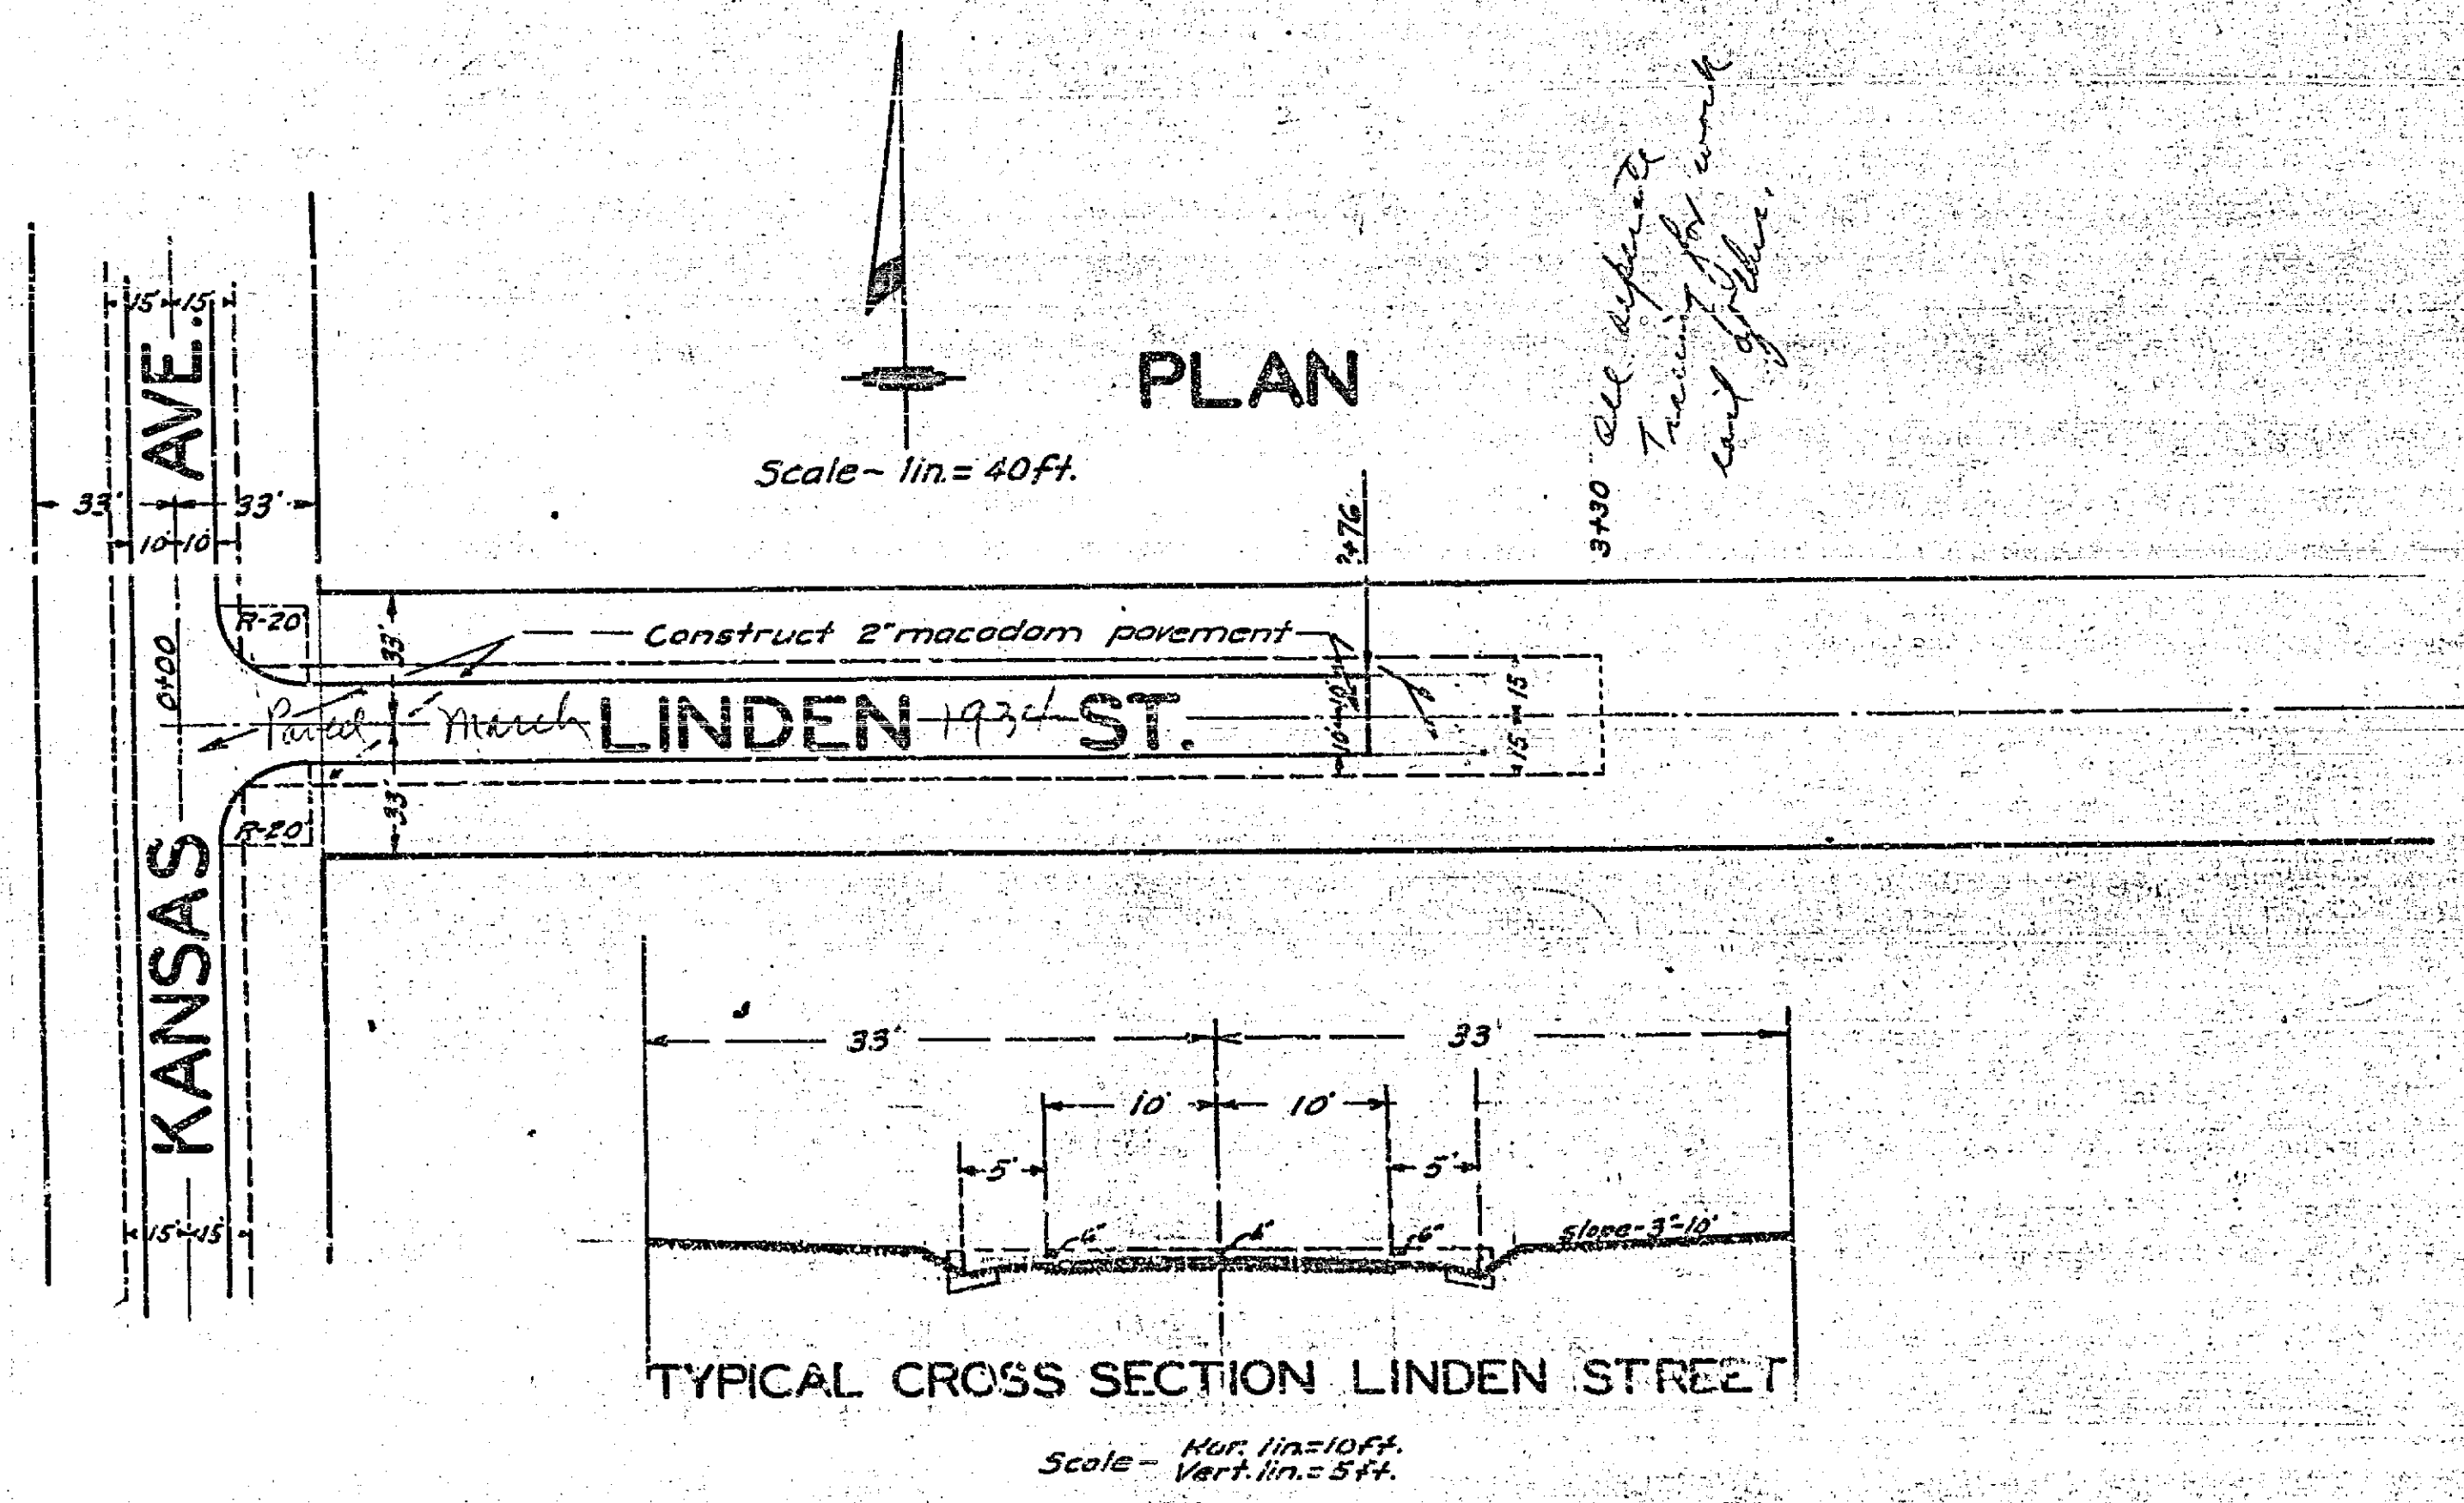

474

