

DRAWING NUMBER	SHEET NUMBER	TOTAL SHEETS	FIELD BOOK
488			411
DRAWN BY	CHECKED BY	APPROVED BY	
WLT.	RED.		


BIRCH STREET

JURUPA AVE. TO MAPLEWOOD PL.

ENGINEERING DEP'T. RIVERSIDE, CALIF. JUNE, 1945.

CITY (U.S.G.S) DATUM PLANE


F.B. 411 PG. 74

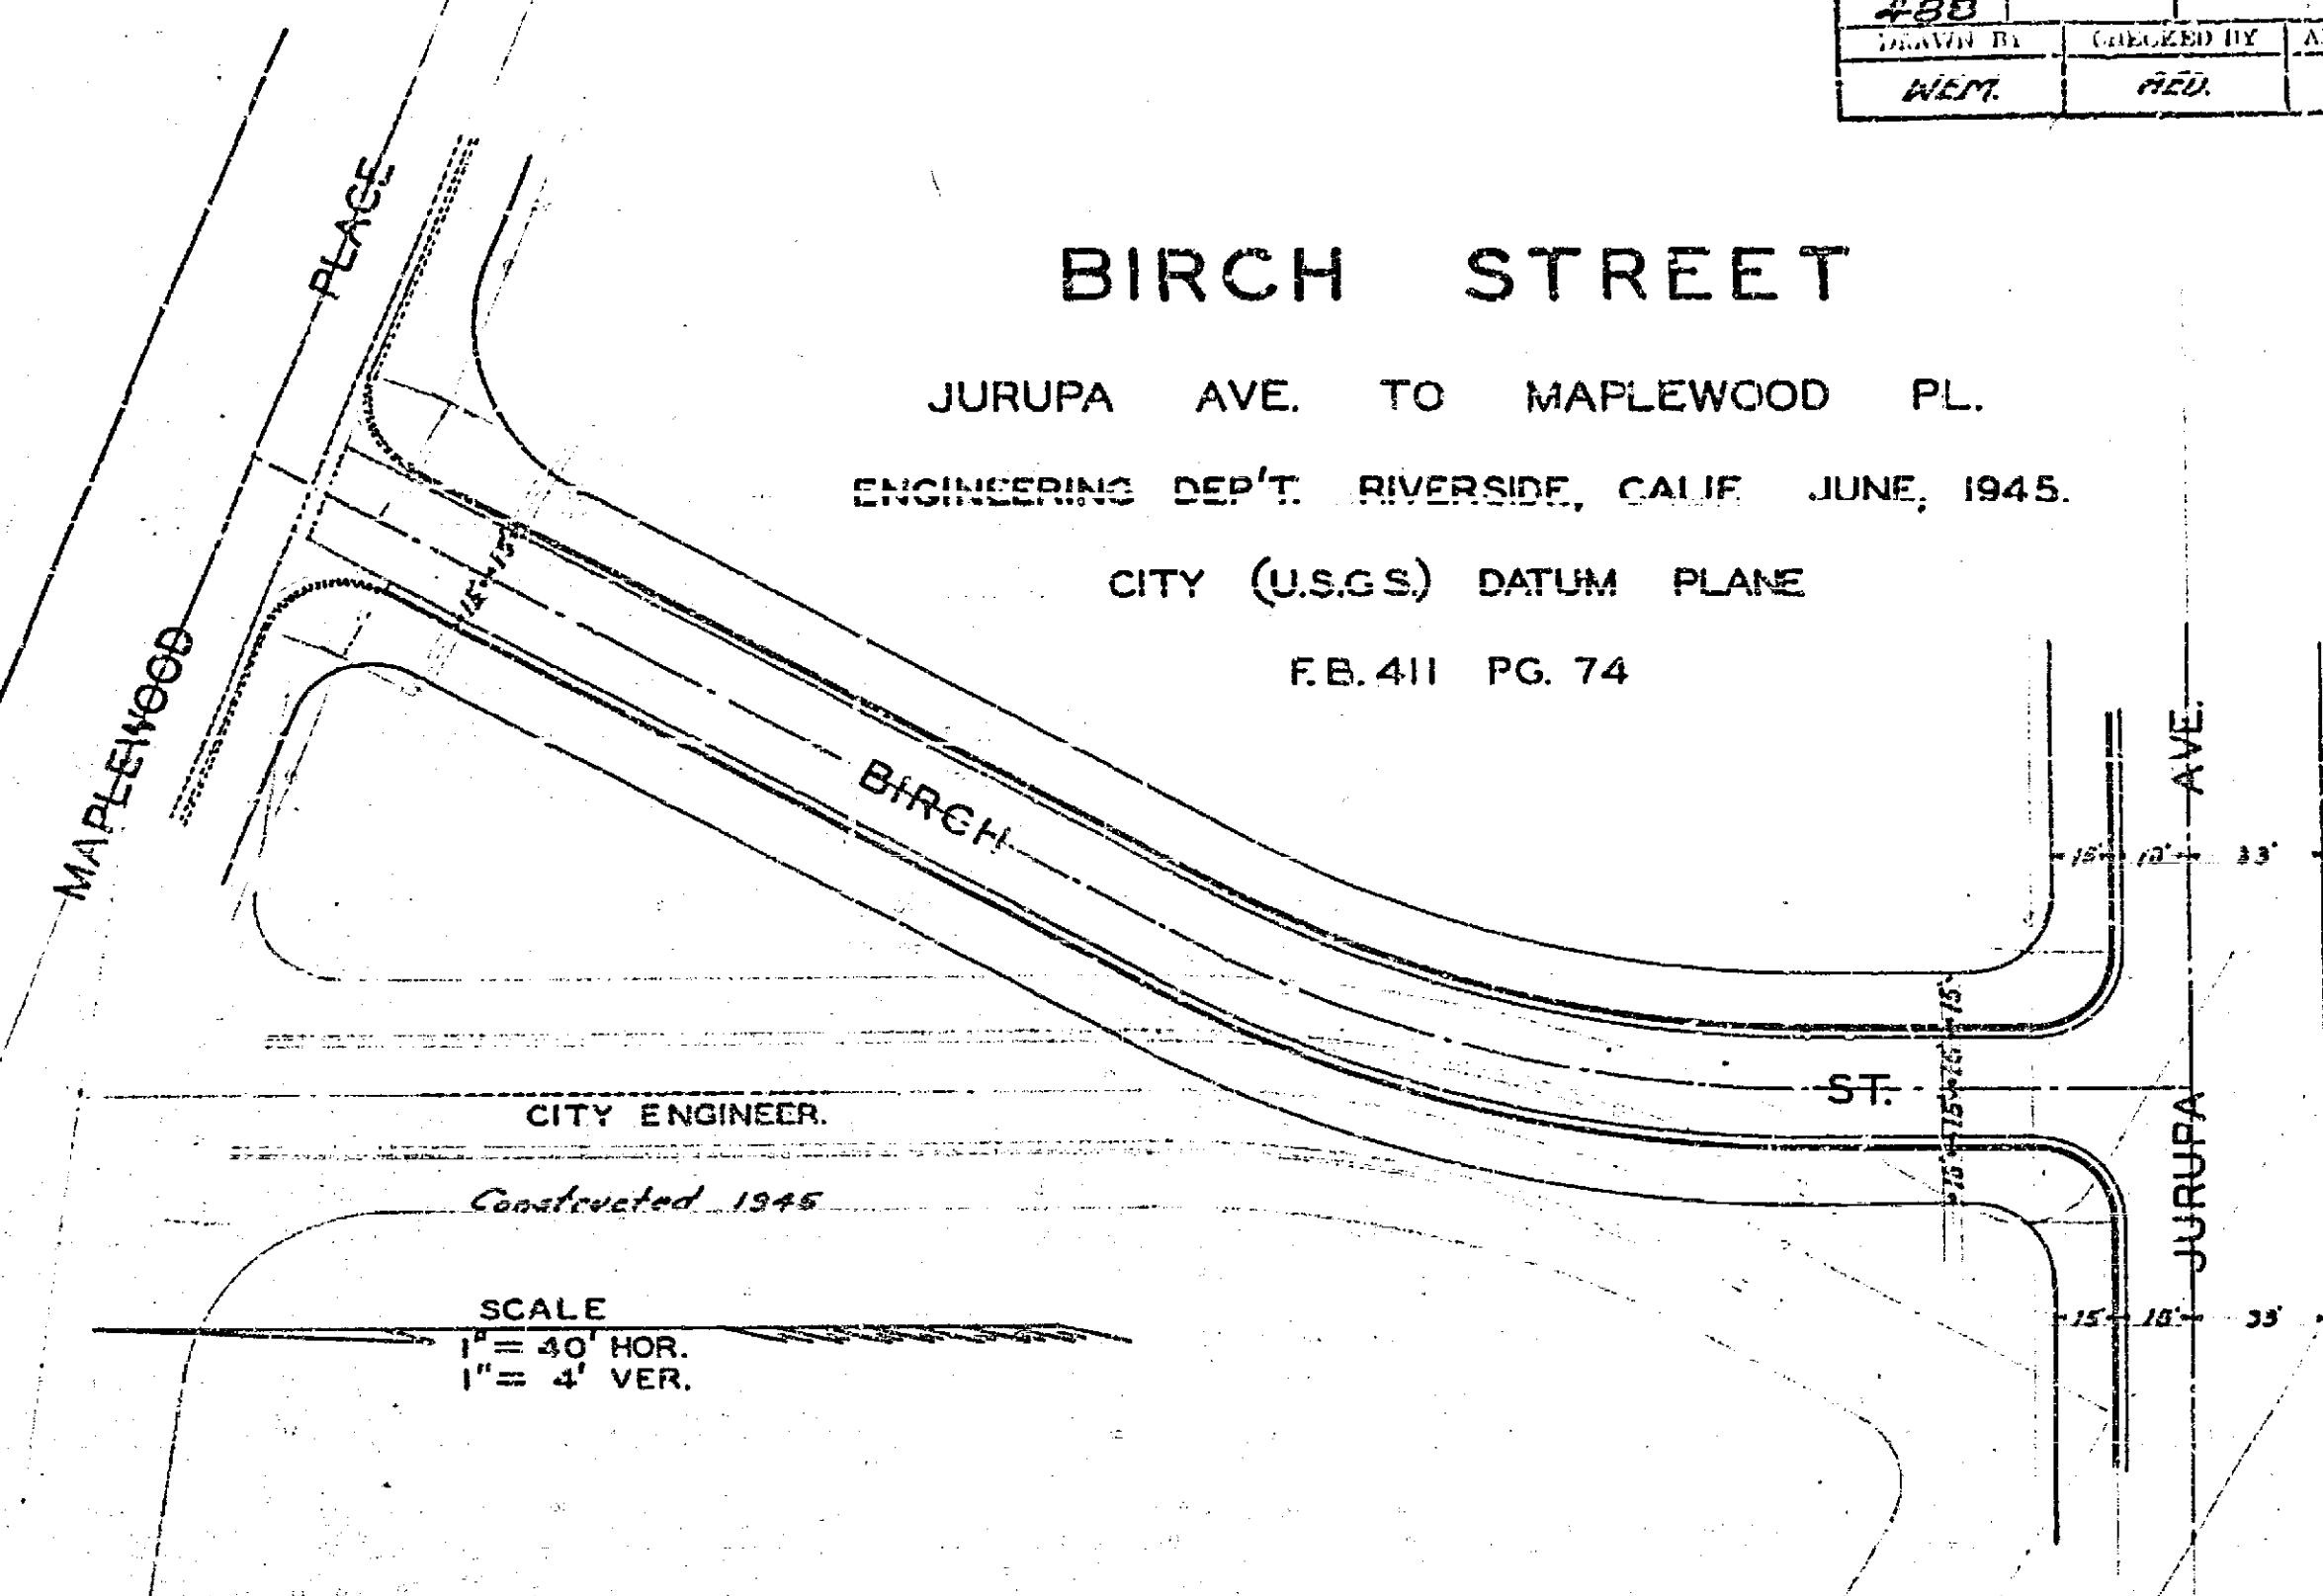

CITY ENGINEER.

Constructed 1945

SCALE
1" = 40' HOR.
1" = 4' VER.

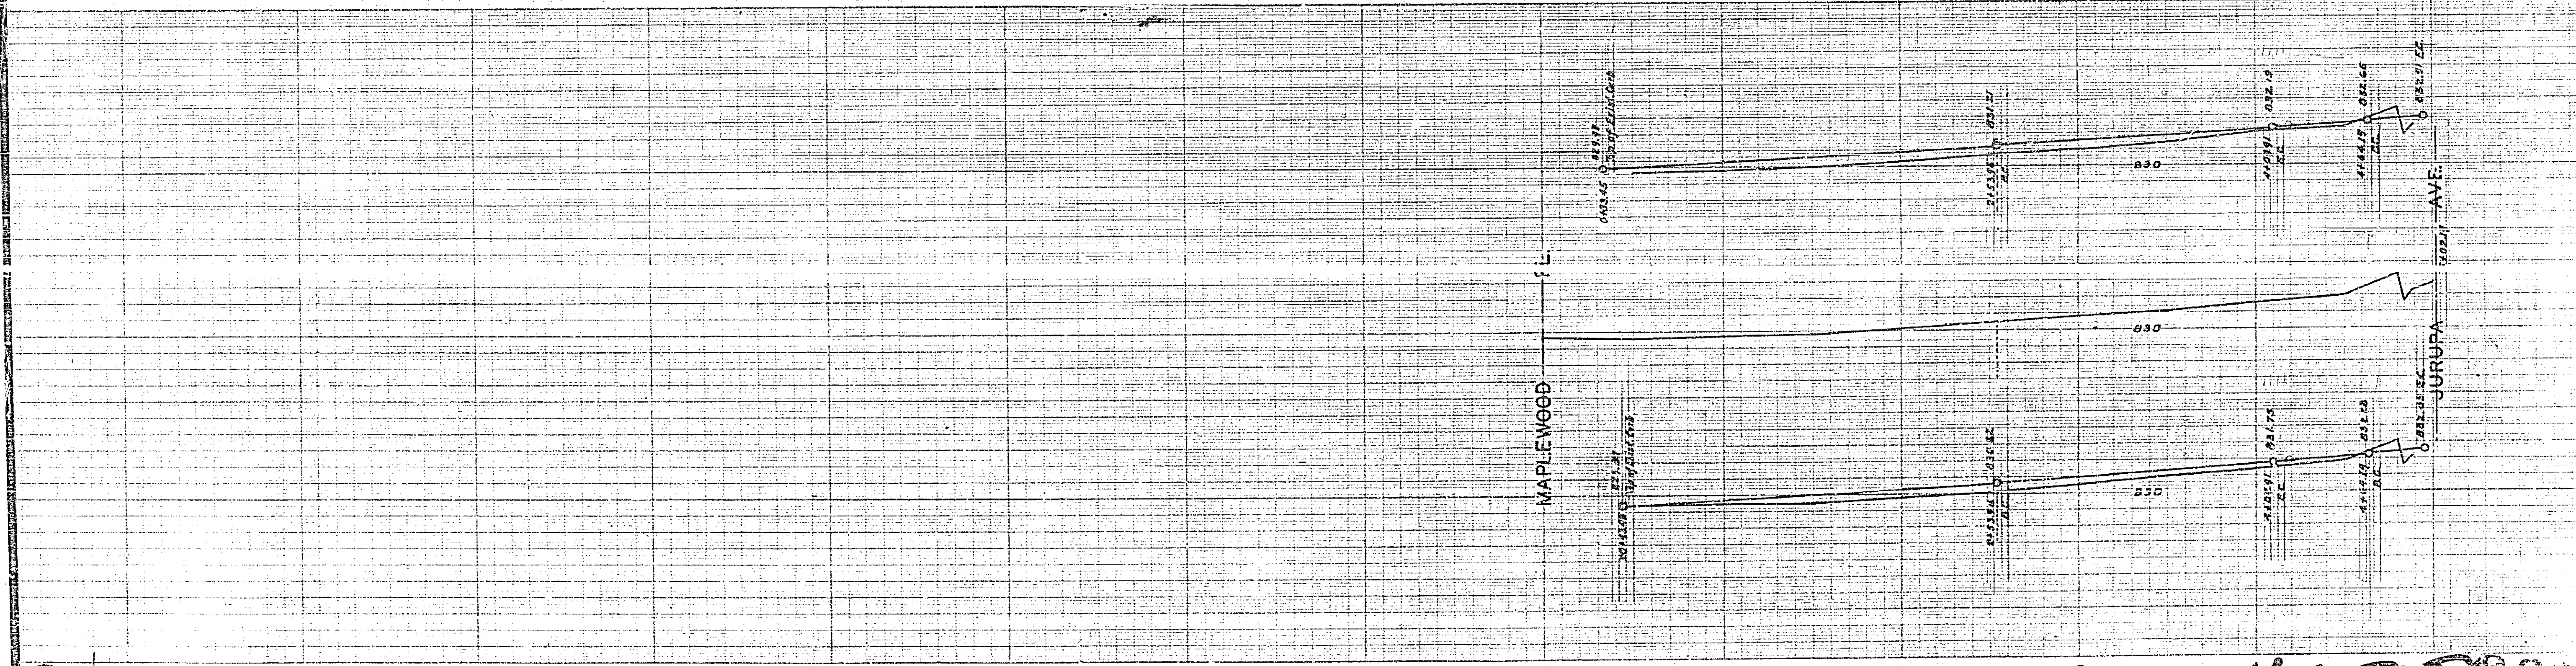

48888

84

84