


RIVERSIDE

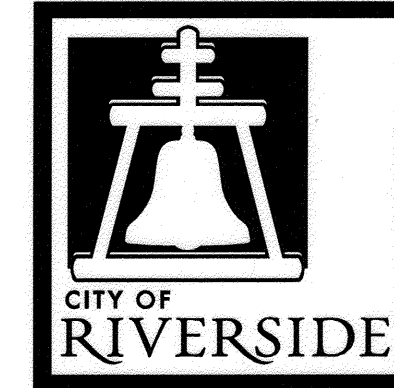


CALIFORNIA

PUBLIC WORKS DEPARTMENT

2017/2018 CDBG ADA FOOTPATH IMPROVEMENTS AT VARIOUS LOCATIONS A HUD FUNDED PROJECT

GENERAL CONSTRUCTION NOTES:

- CONSTRUCTION SHALL BE IN ACCORDANCE WITH THE CITY OF RIVERSIDE STANDARD DRAWINGS AND STANDARD SPECIFICATIONS FOR PUBLIC WORKS CONSTRUCTION, 2012 EDITION.
- THE CONTRACTOR IS REQUIRED TO TAKE DUE PRECAUTIONARY MEASURES TO LOCATE AND PROTECT ALL UTILITIES.
- PRIME CONTRACTOR BIDDING THIS WORK SHALL HAVE A CLASS "A" LICENSE.
- CONTRACTOR SHALL GRIND AND OVERLAY EXISTING PAVEMENT AS REQUIRED ADJACENT TO 5% MAX. WHEELCHAIR RAMP BOTTOM LANDING INDICATED ON STANDARD DRAWING NO 304. CONTRACTOR SHALL GRIND AND OVERLAY AS NECESSARY BEYOND LANDING TO JOIN EXISTING PAVEMENT TO PROVIDE A FINISHED JOIN GRADE OF 16% MAXIMUM.
- CONTRACTOR SHALL RECONSTRUCT EXISTING SIDEWALK OR ADD NEW SIDEWALK PER CITY STANDARD 325 AS NECESSARY TO ADEQUATELY JOIN NEW RAMP TO BE CONSTRUCTED PER CITY STD 304, WHETHER INDICATED OR NOT.
- EXISTING IRRIGATION SHALL BE PROTECTED OR MODIFIED AS NECESSARY TO CONSTRUCT NEW CONCRETE IMPROVEMENTS.
- ALL STREET PULL BOXES AND WATER METER BOXES, AFFECTED BY CONSTRUCTION, SHALL BE ADJUSTED TO THE PROPOSED GRADE.

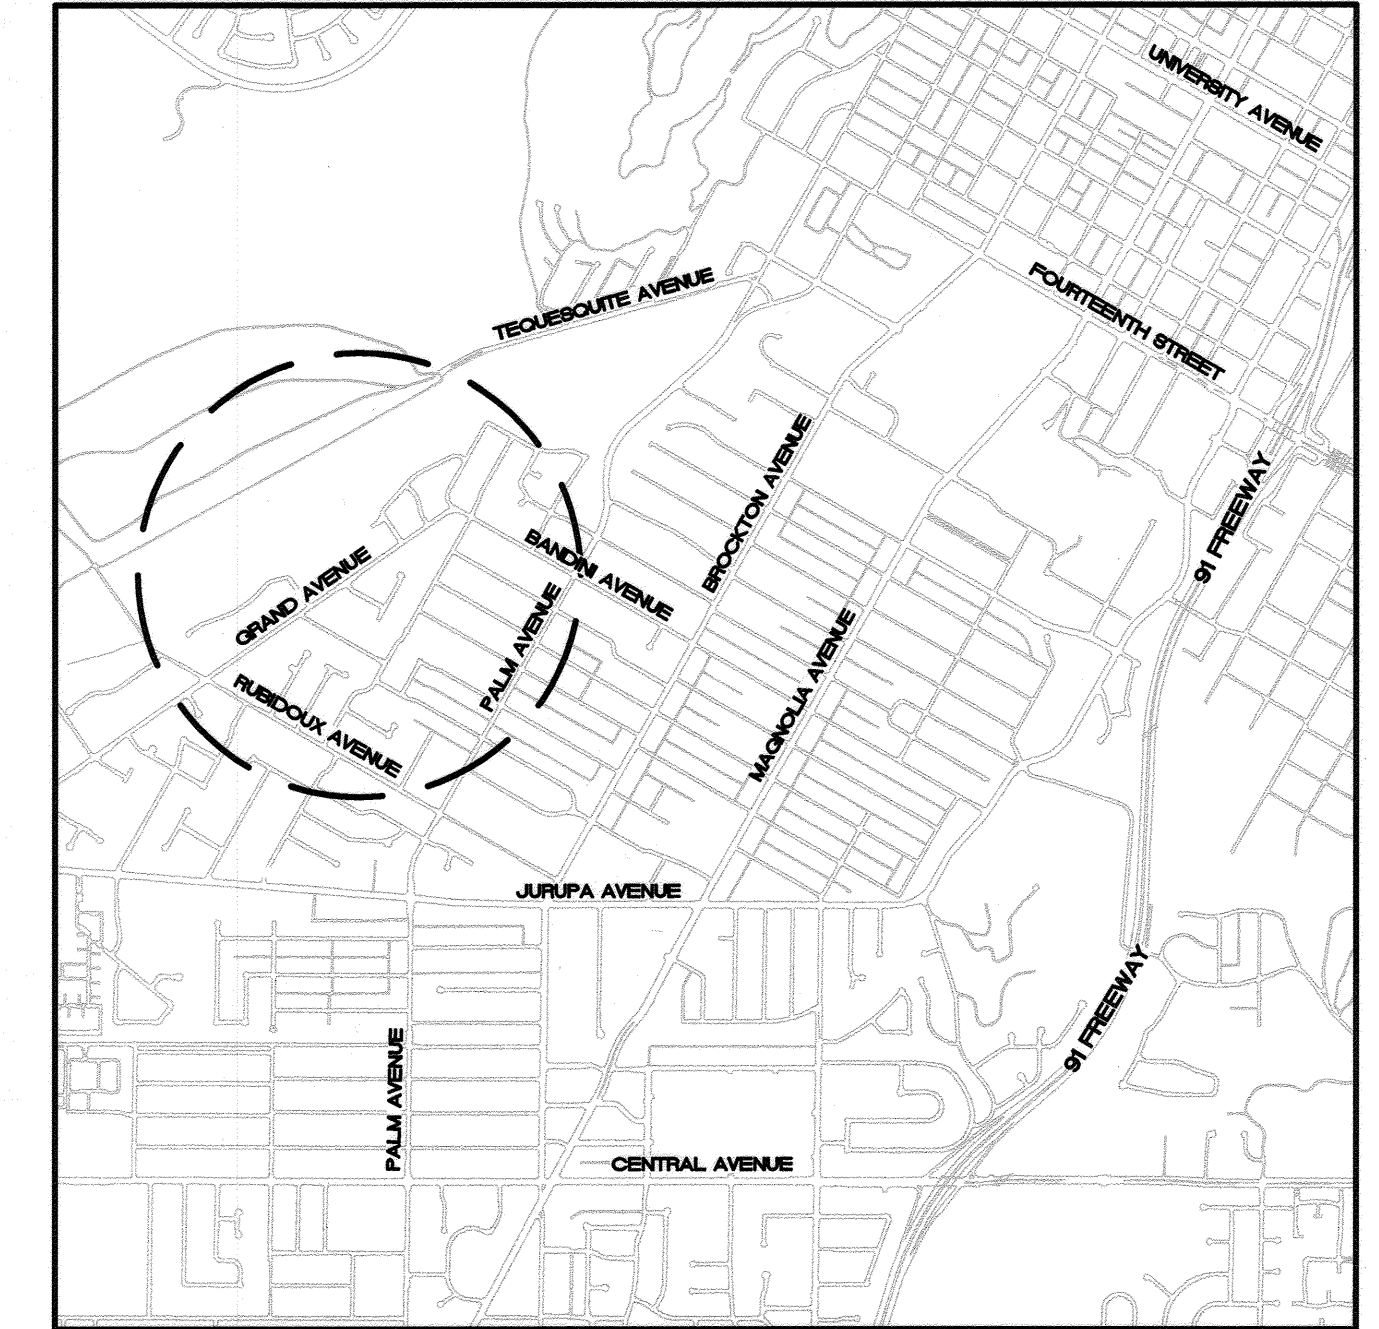

AREA MAP
NTS




LOCATION MAP
NTS

PEDESTRIAN RAMP CONSTRUCTION DATA				
NO.	LOCATION	QUAD.	RAMP TYPE	REMARKS
1	BRIGHTON & PINEHURST	NE	I MOD	TYPE I MODIFIED WITH RETAINING CURB ON BOTH SIDES
2	ELMWOOD & BARRINGTON	NW SW	I MOD	TYPE I MODIFIED WITH RETAINING CURB ON BOTH SIDES - TYPE VII MID BLOCK AT 4760 ELMWOOD
3		NE	I MOD	TYPE I MODIFIED WITH RETAINING CURB ON BOTH SIDES
4	BANDINI & BRIGHTON	SW	II-A	TYPE II-A MODIFIED WITH ONLY ONE WING WITH RETAINING CURB ON THE OTHER *
5		NW	VI	R&R EXISTING RAMP
6		NW	VI	R&R EXISTING RAMP
7	GRAND & RODEO	SW	II-A	PIP MAILBOX AND TRAFFIC SIGN
8		NE	I	R&R EXISTING RAMP
9	GRAND & MILFORD	SE	II-A	MODIFIED TO TIE INTO PROPERTY LINE SIDEWALK, ADD RETAINING CURB AS NECESSARY, REMOVE EXISTING SIDEWALK ON ONE SIDE TO INSTALL SOD AND MODIFY EXISTING IRRIGATION AS NECESSARY, PIP PARKWAY DRAIN
10	GRAND & AINSWORTH	NW	I	MODIFIED WITH RETAINING CURB ON BOTH SIDES AND RAMP SIDEWALK UP IN EACH DIRECTION
11	HARDWICKE & AINSWORTH	NW	I	MODIFY EXISTING SOD
12		SW	I	MODIFY EXISTING SOD
13	GRAND & CHARLOTTE	NW	I MOD	MODIFIED WITH RETAINING CURB ON BOTH SIDES - TYPE VII MODIFIED WITH RETAINING CURB
14		SW	I MOD	CONSTRUCT A DIRECTIONAL RAMP WITH RETAINING CURB ON BOTH SIDES IN LINE WITH THE EXISTING SIDEWALK
15	GRAND & NEWPORT	NW	I MOD	TYPE I MODIFIED WITH RETAINING CURB ON BOTH SIDES BETWEEN THE ADJACENT PROPERTIES
16	RUBIDOUX & VIA DOS CAMINOS	NW	IV	
17	TOWER (EAST) & BRENTWOOD	SW	I MOD	TYPE I MODIFIED WITH RETAINING CURB ON BOTH SIDES, PIP WATER METER, R&R 10' SIDEWALK
18	TOWER (EAST) & WHIPPLE	SW	I MOD	TYPE I MODIFIED WITH RETAINING CURB ON BOTH SIDES
19	BRENTWOOD & EDGEWOOD	SE	I MOD	TYPE I MODIFIED WITH RETAINING CURB ON BOTH SIDES
20		NW	I MOD	TYPE I MODIFIED WITH RETAINING CURB ON BOTH SIDES
21	RUBIDOUX & TOWER (WEST)	SW	II	MODIFY IRRIGATION AND LANDSCAPING, R&R 15' SIDEWALK, R&R BOTH SPANDRELS AND CROSS GUTTER, ADJUST GATE VALVE
22		SE	III	PIP POWER POLE, PIP TREE, MODIFY WIDTH AS NECESSARY TO AVOID DAMAGE TO EXISTING TREE


PIP = PROTECT IN PLACE
R&R = REMOVE AND REPLACE



* FOR LOCATION #4 THE CITY REMOVED ONE SIDEWALK PANEL N/A NEW PED RAMP, THE OWNER WILL NOT BE RESPONSIBLE TO REPLACE THE SIDEWALK PANEL AT ANY TIME IN THE FUTURE.

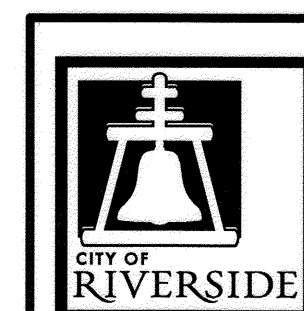

ENGINEER IN RESPONSIBLE CHARGE
Deborah V. Anderson
Deborah V. Anderson
R.C.E. No. 56408 EXPIRES: 6-30-19
DATE 5/14/18

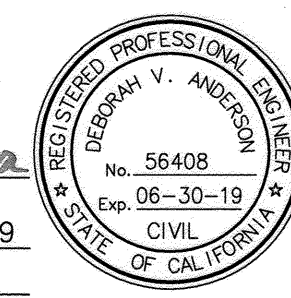

DESIGNED BY	DC	DRAWN BY	DC	CHECKED BY	DA
-------------	----	----------	----	------------	----

CITY OF RIVERSIDE, CALIFORNIA DEPARTMENT OF PUBLIC WORKS			
APPROVED BY	BY	DATE	APPROVED BY
ENGINEERING MANAGER	FA	5/14/18	CITY ENGINEER
CONSTRUCTION ADMIN.	DA	5/14/18	
TRAFFIC DIVISION	FA	5/14/18	
STREETS SERVICES			
SURVEYOR			

PEDESTRIAN RAMP IMPROVEMENTS
2017/2018 CDBG ADA FOOTPATH IMPROVEMENTS
TITLE SHEET
HORIZ. SCALE: N/A VERT. SCALE: N/A

DESIGN WORK ORDER NO.: 1820206 CONSTR. WORK ORDER NO.: 1820207
M-490
SHEET 1 OF 1
FILE NAME: M490-1.DWG

AS-BUILT 5-17-19