



PROPERTY OF
CITY OF RIVERSIDE
CITY ENGINEERING DEPT.

PROPERTY OF
CITY OF RIVERSIDE
CITY ENGINEERING DEPT.

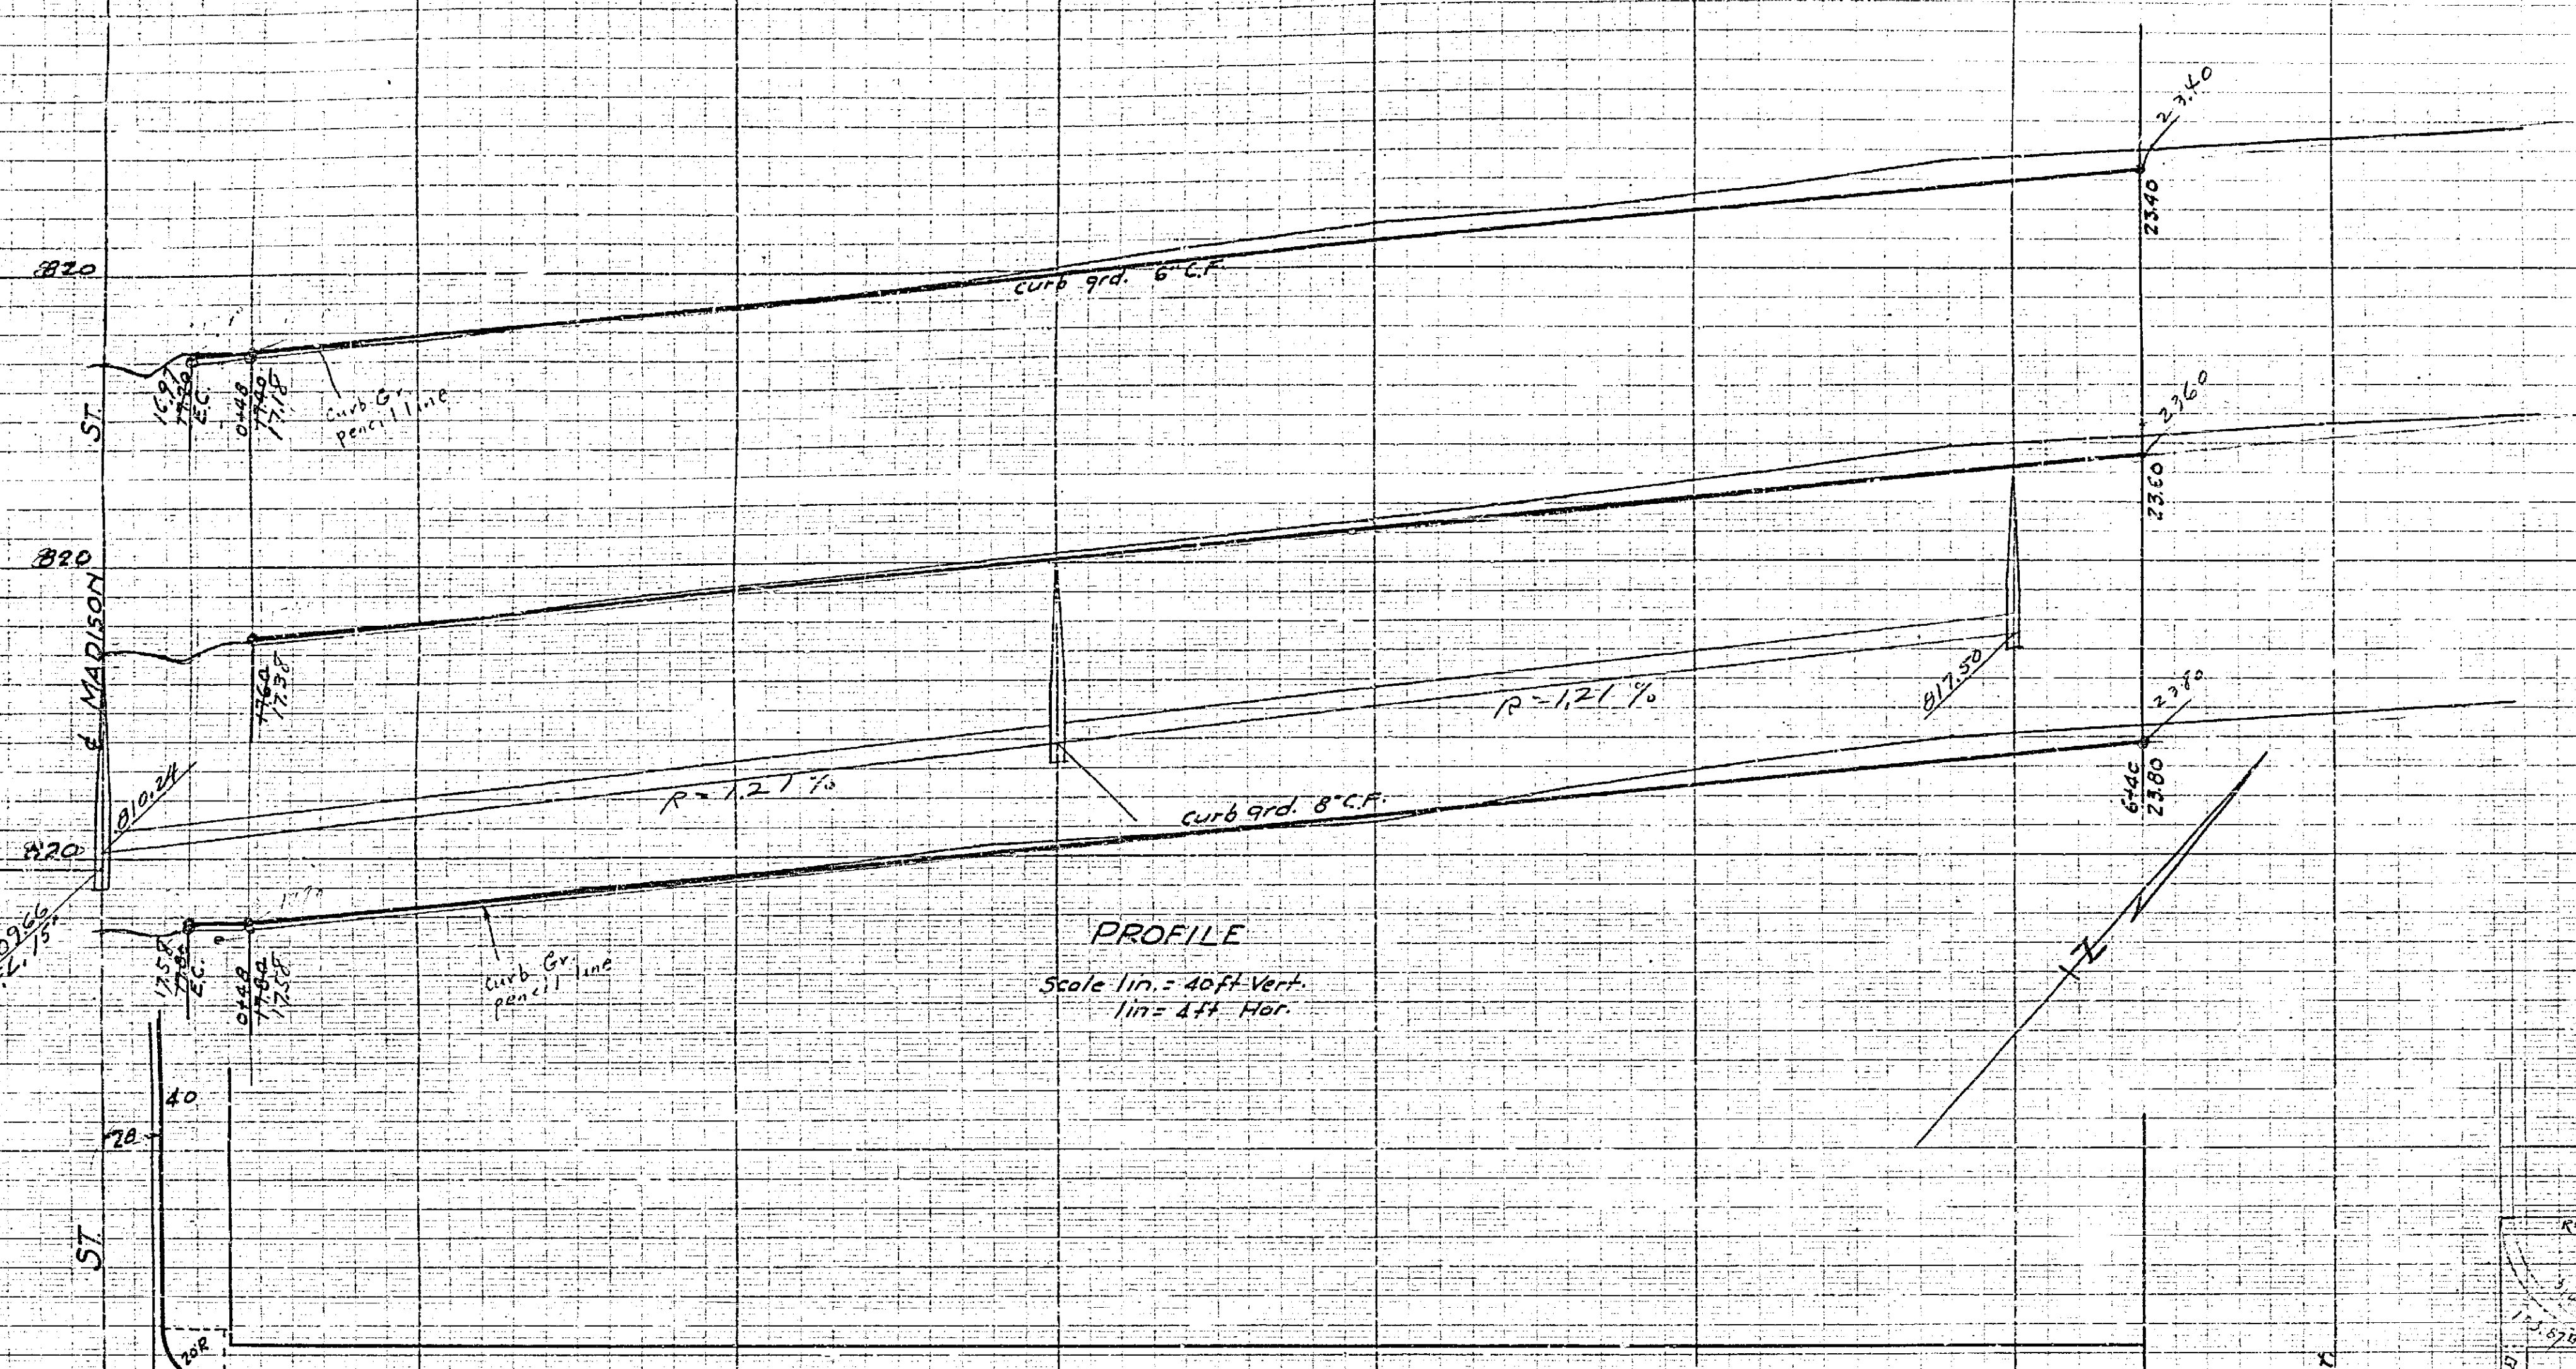

PROFILE
Scale 1 in. = 40 ft. Vert.
1 in. = 1 ft. Hor.

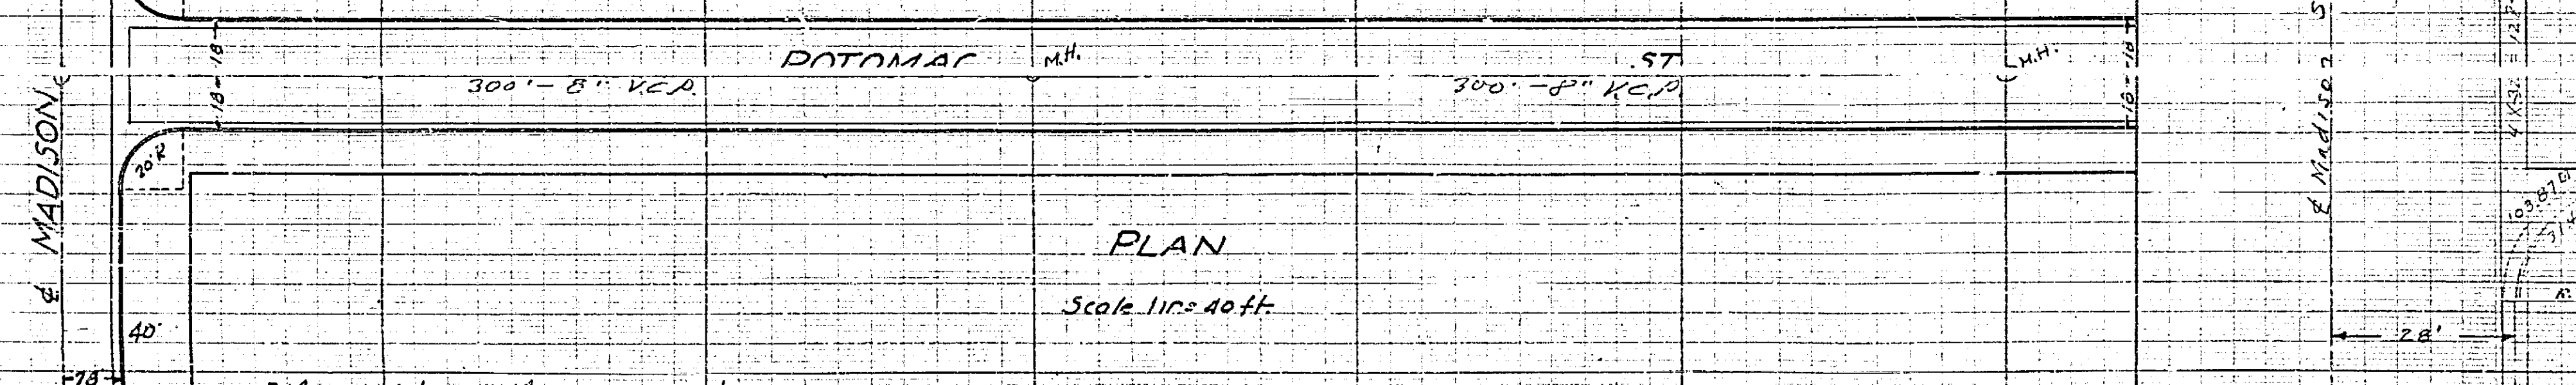

PLAN
Scale 1 in. = 40 ft.

B.M. Sph. Hd. and Mag. - Wood - Elev. 826.13
B.M. Top F.H. - Mag. + Madison - Elev. 816.15

PROPERTY OF
CITY OF RIVERSIDE
CITY ENGINEERING DEPT.


Approved:
3-2-50

M. H. Swaine
City Engineer

PROPERTY OF
CITY OF RIVERSIDE
CITY ENGINEERING DEPT.

MIDWAY SQUARE
Plans and Profiles
Feb. 1950 Donald J. McKee L.S.
Sheet 1 of 3 Sheets

500 A

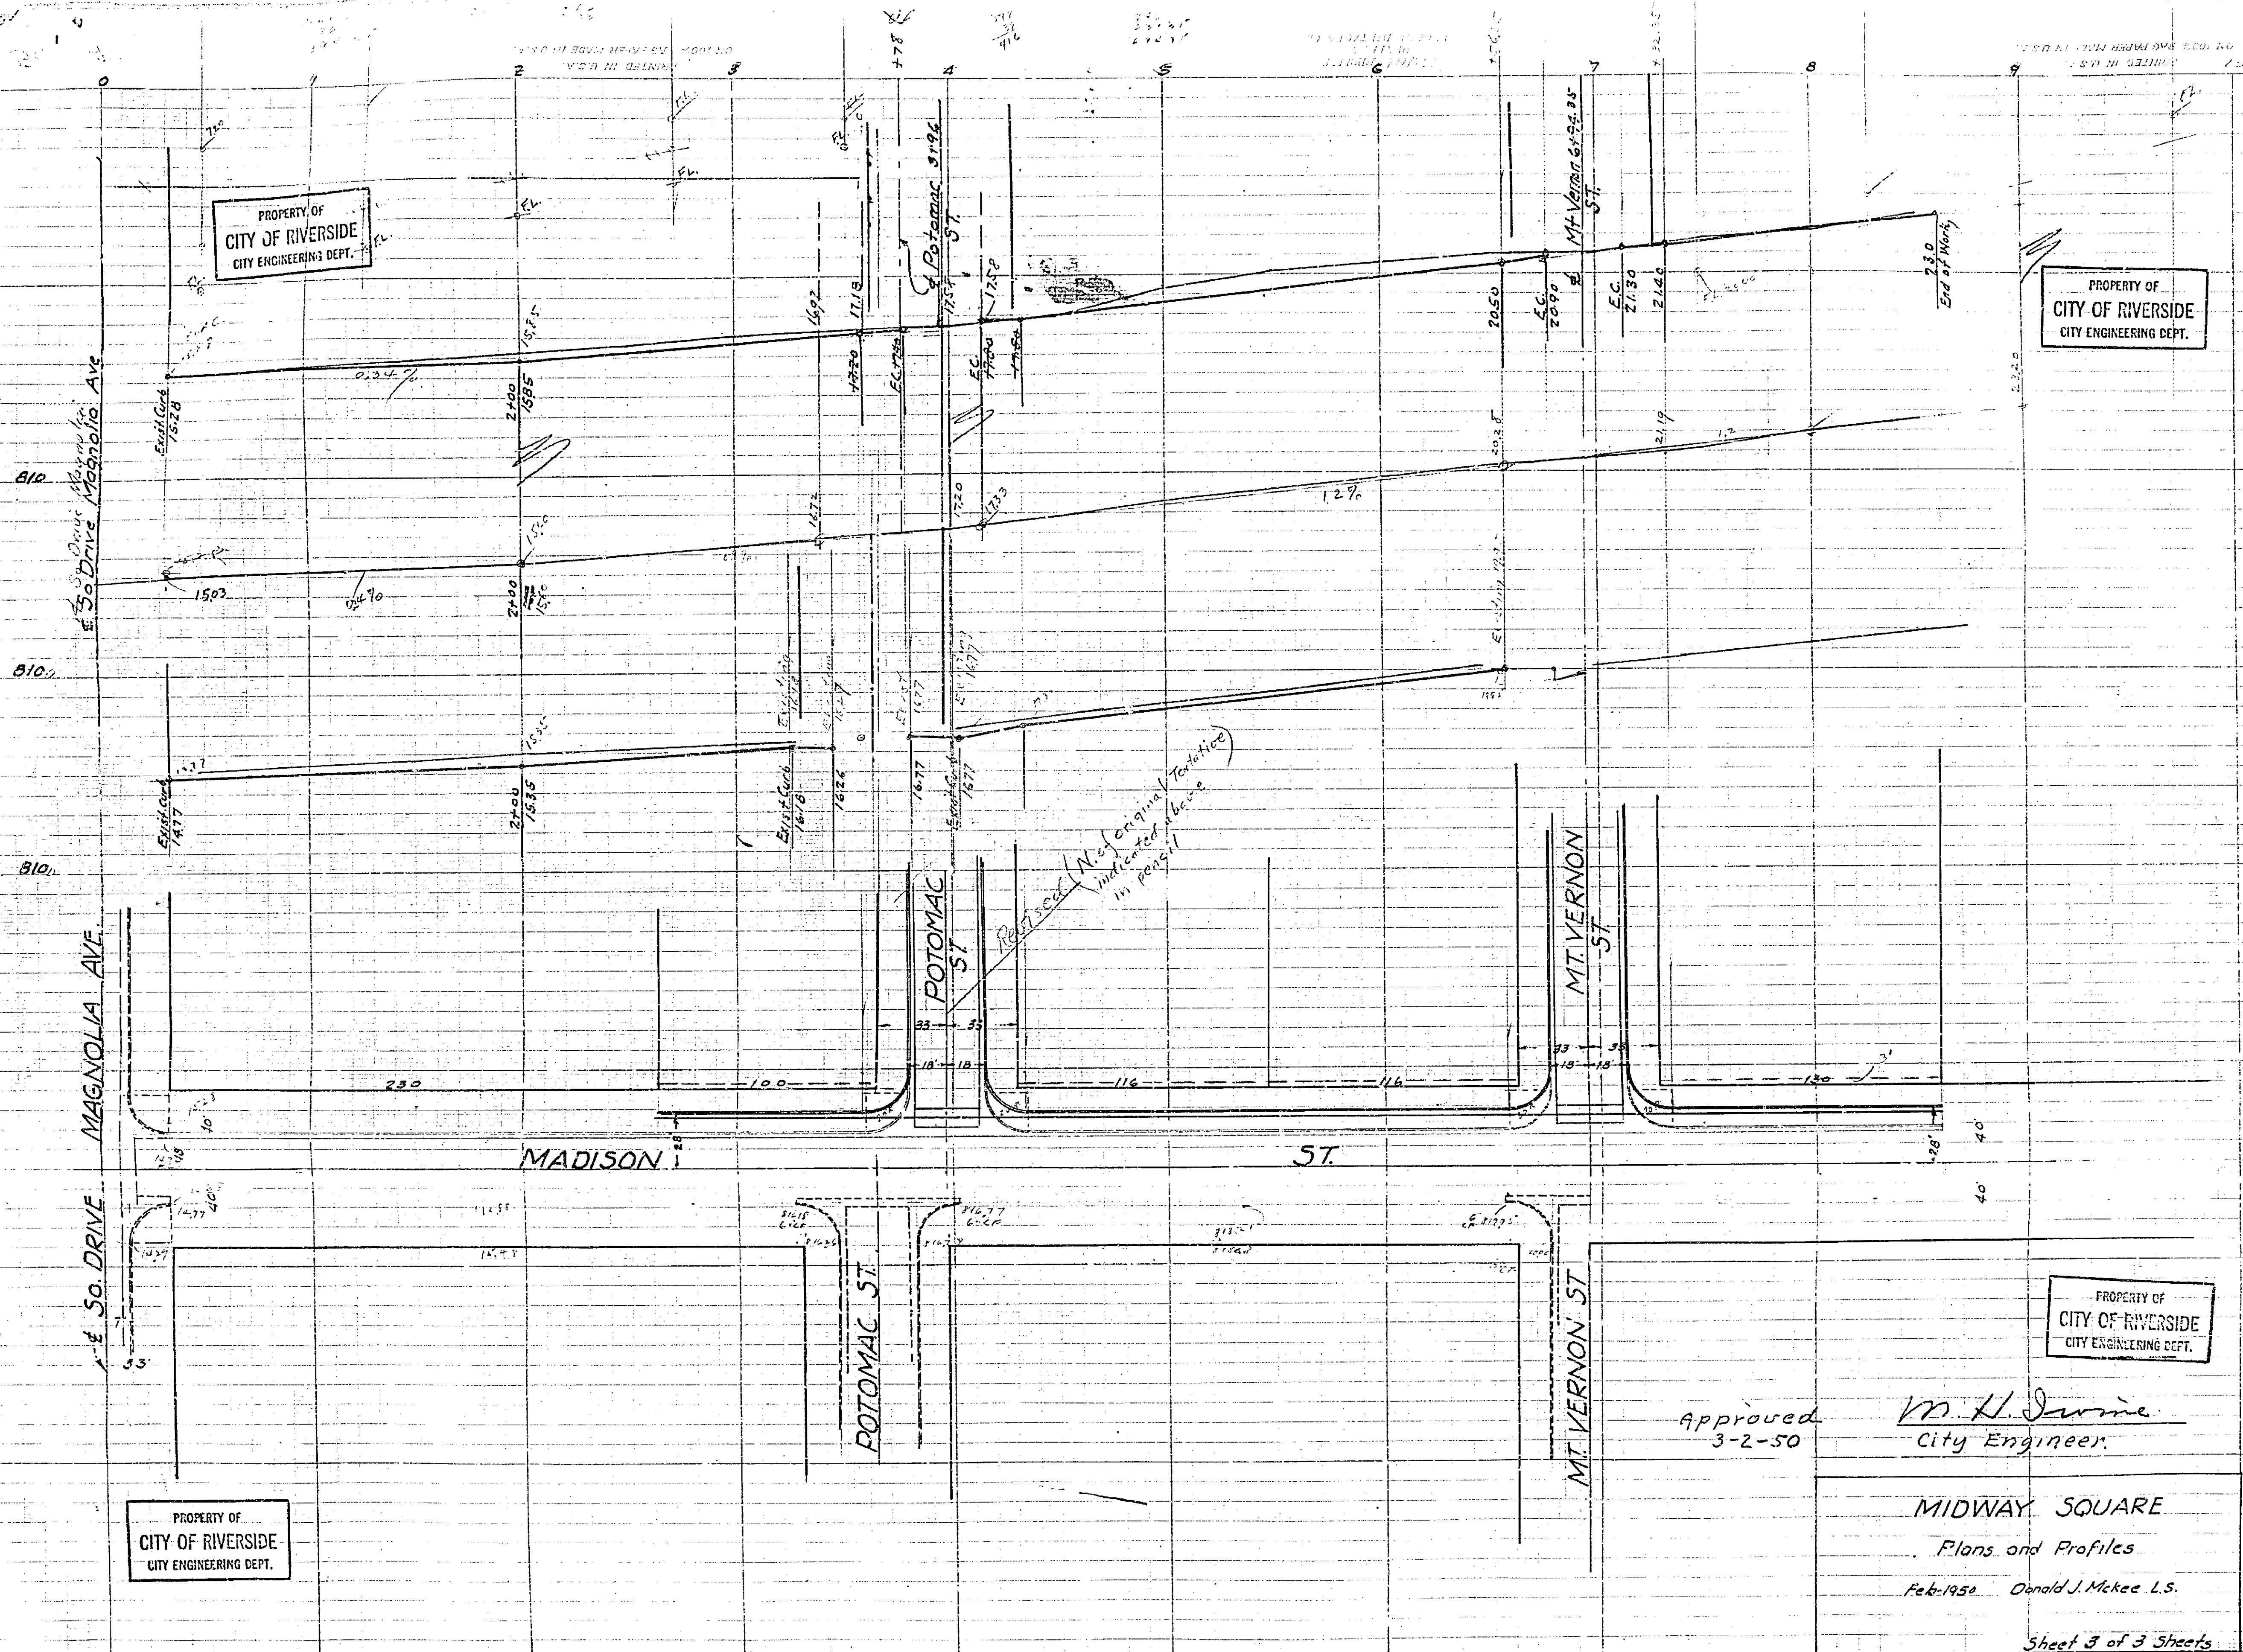

PROPERTY OF
CITY OF RIVERSIDE
CITY ENGINEERING DEPT.

PROPERTY OF
CITY OF RIVERSIDE
CITY ENGINEERING DEPT.

PROPERTY OF
CITY OF RIVERSIDE
CITY ENGINEERING DEPT.

PROPERTY OF
CITY OF RIVERSIDE
CITY ENGINEERING DEPT.

Approved
3-2-50

W. H. Irvine
City Engineer.

MIDWAY SQUARE

Plans and Profiles

Feb-1950 Donald J. McKee L.S.

Sheet 3 of 3 Sheets

500 A