

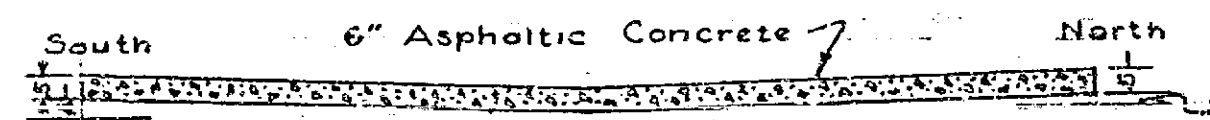


TYPICAL BERM SECTION
Scale: 1-in. = 1-foot

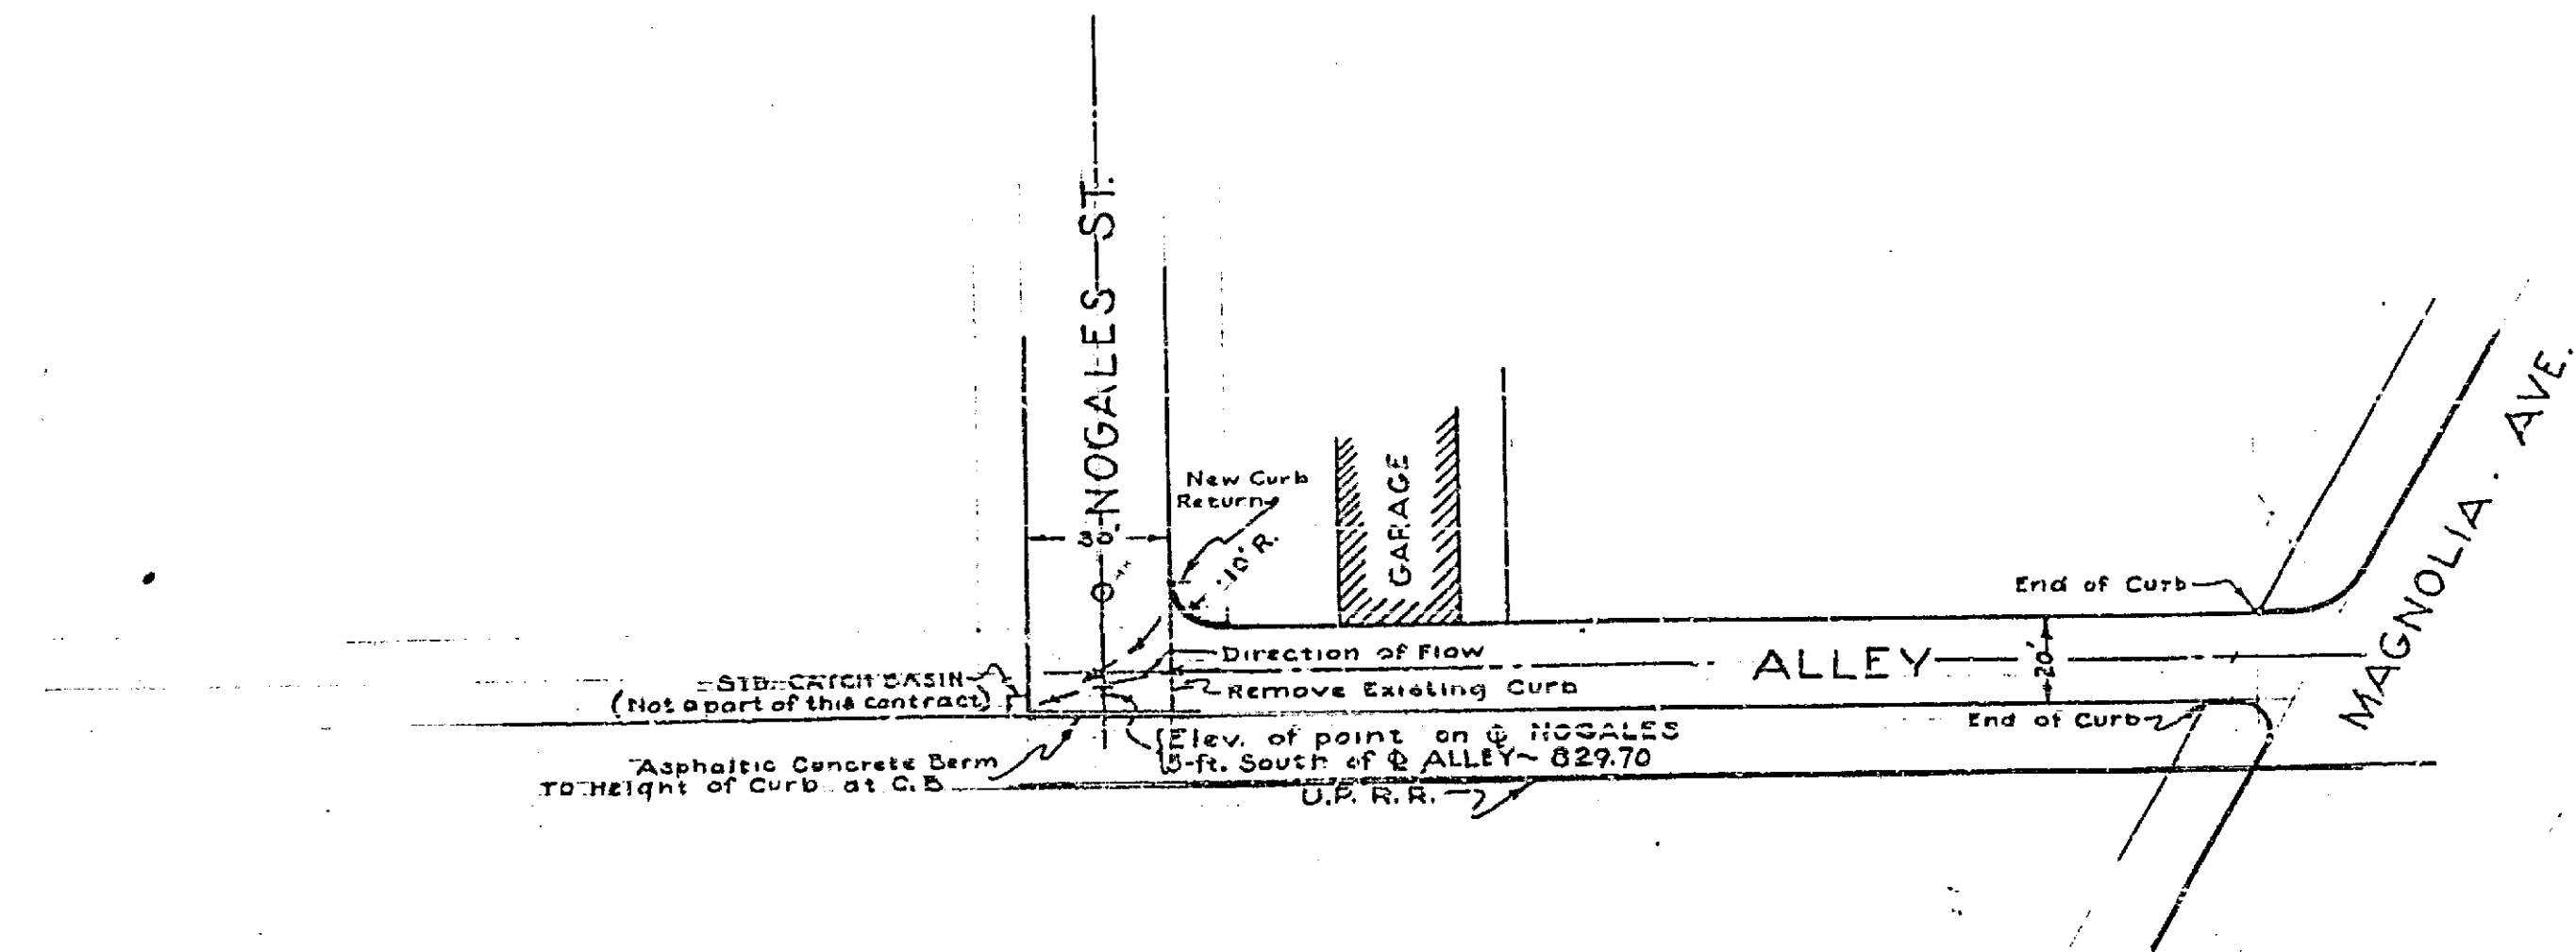

TYPICAL CROSS-SECTION
Scale: 1-in. = 4-feet

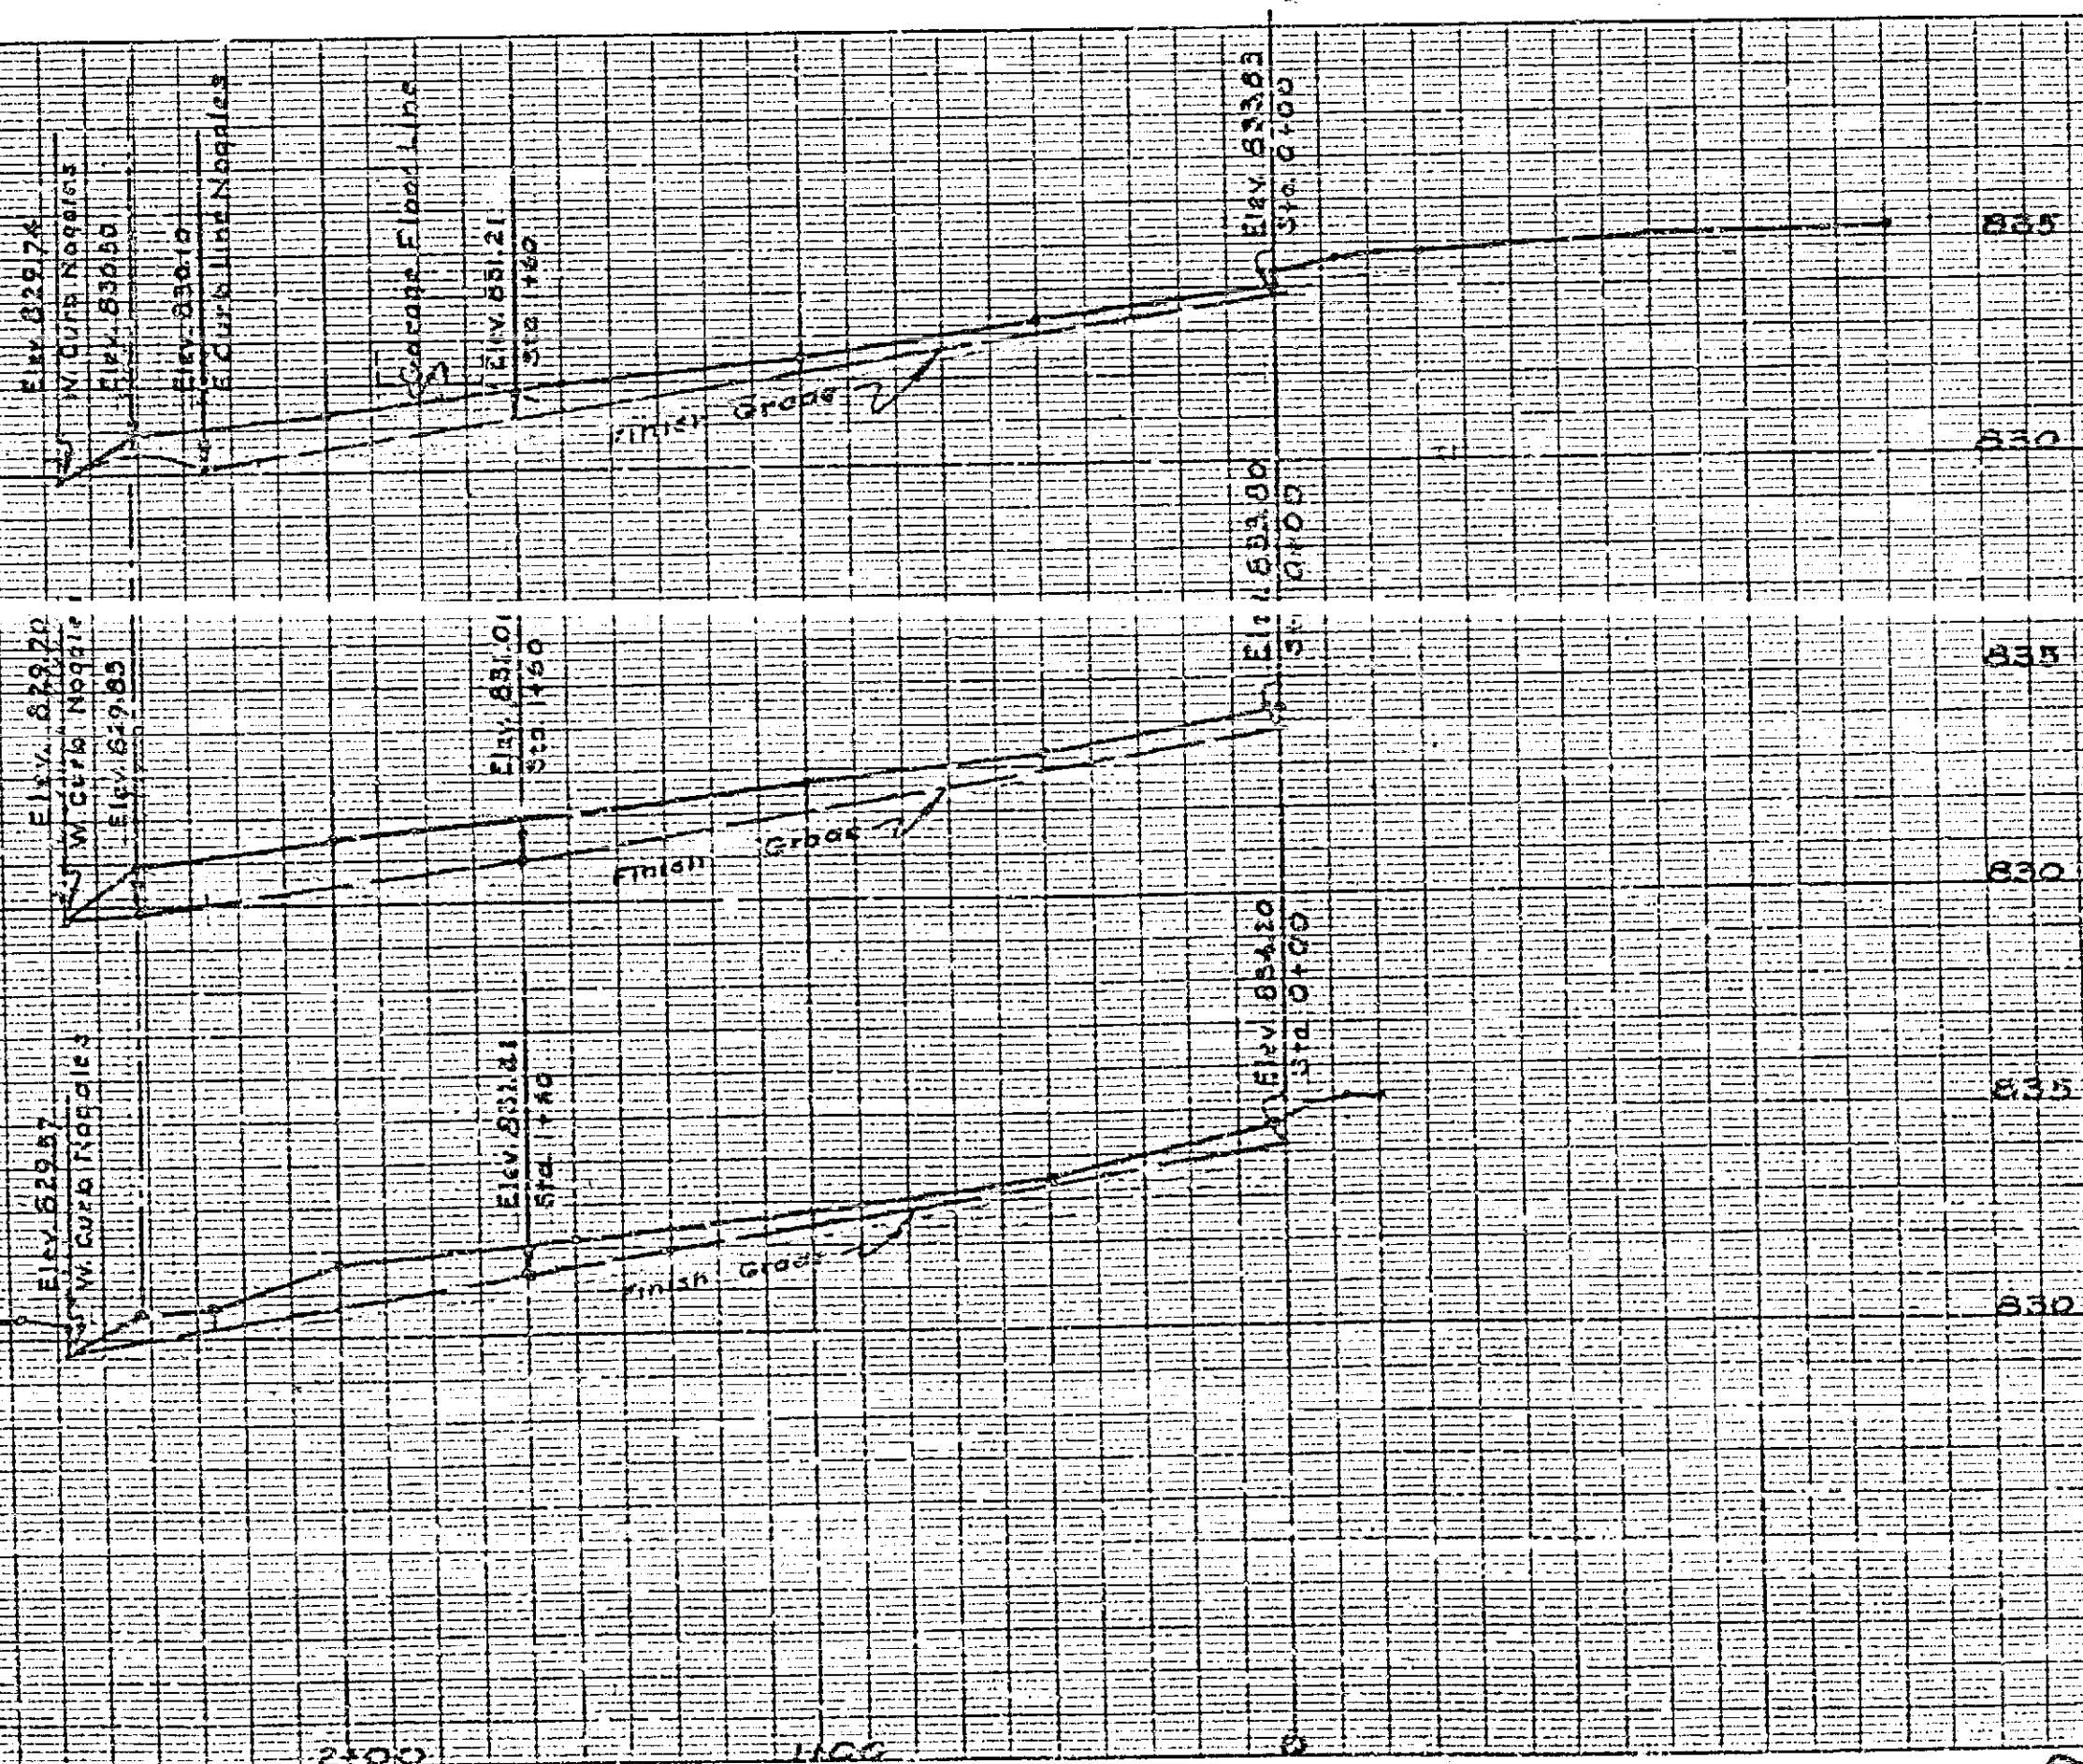

⊕ Grade Revised - Dec 16, 1946

PROJECT
PROPOSED PAVEMENT OF ALLEY
NORTH OF UNION PACIFIC R.R.
BETWEEN NOGALES & MAGNOLIA
DATE: DEC 6, 1946 Scale: Hor. 1-in. = 40-ft.
Vert. 1-in. = 4-ft.
OFFICE OF CITY ENGINEER
RIVERSIDE, CALIF.

29 B