


PLAN & PROFILE No 543-A  
FOR PROPOSED SEWER IN  
GROVE AVENUE  
BETWEEN PLEASANT & COTTAGE STREETS  
FEB. 1951  
R.E. 493

SCALES AS SHOWN  
PLAN No 412 - REF.

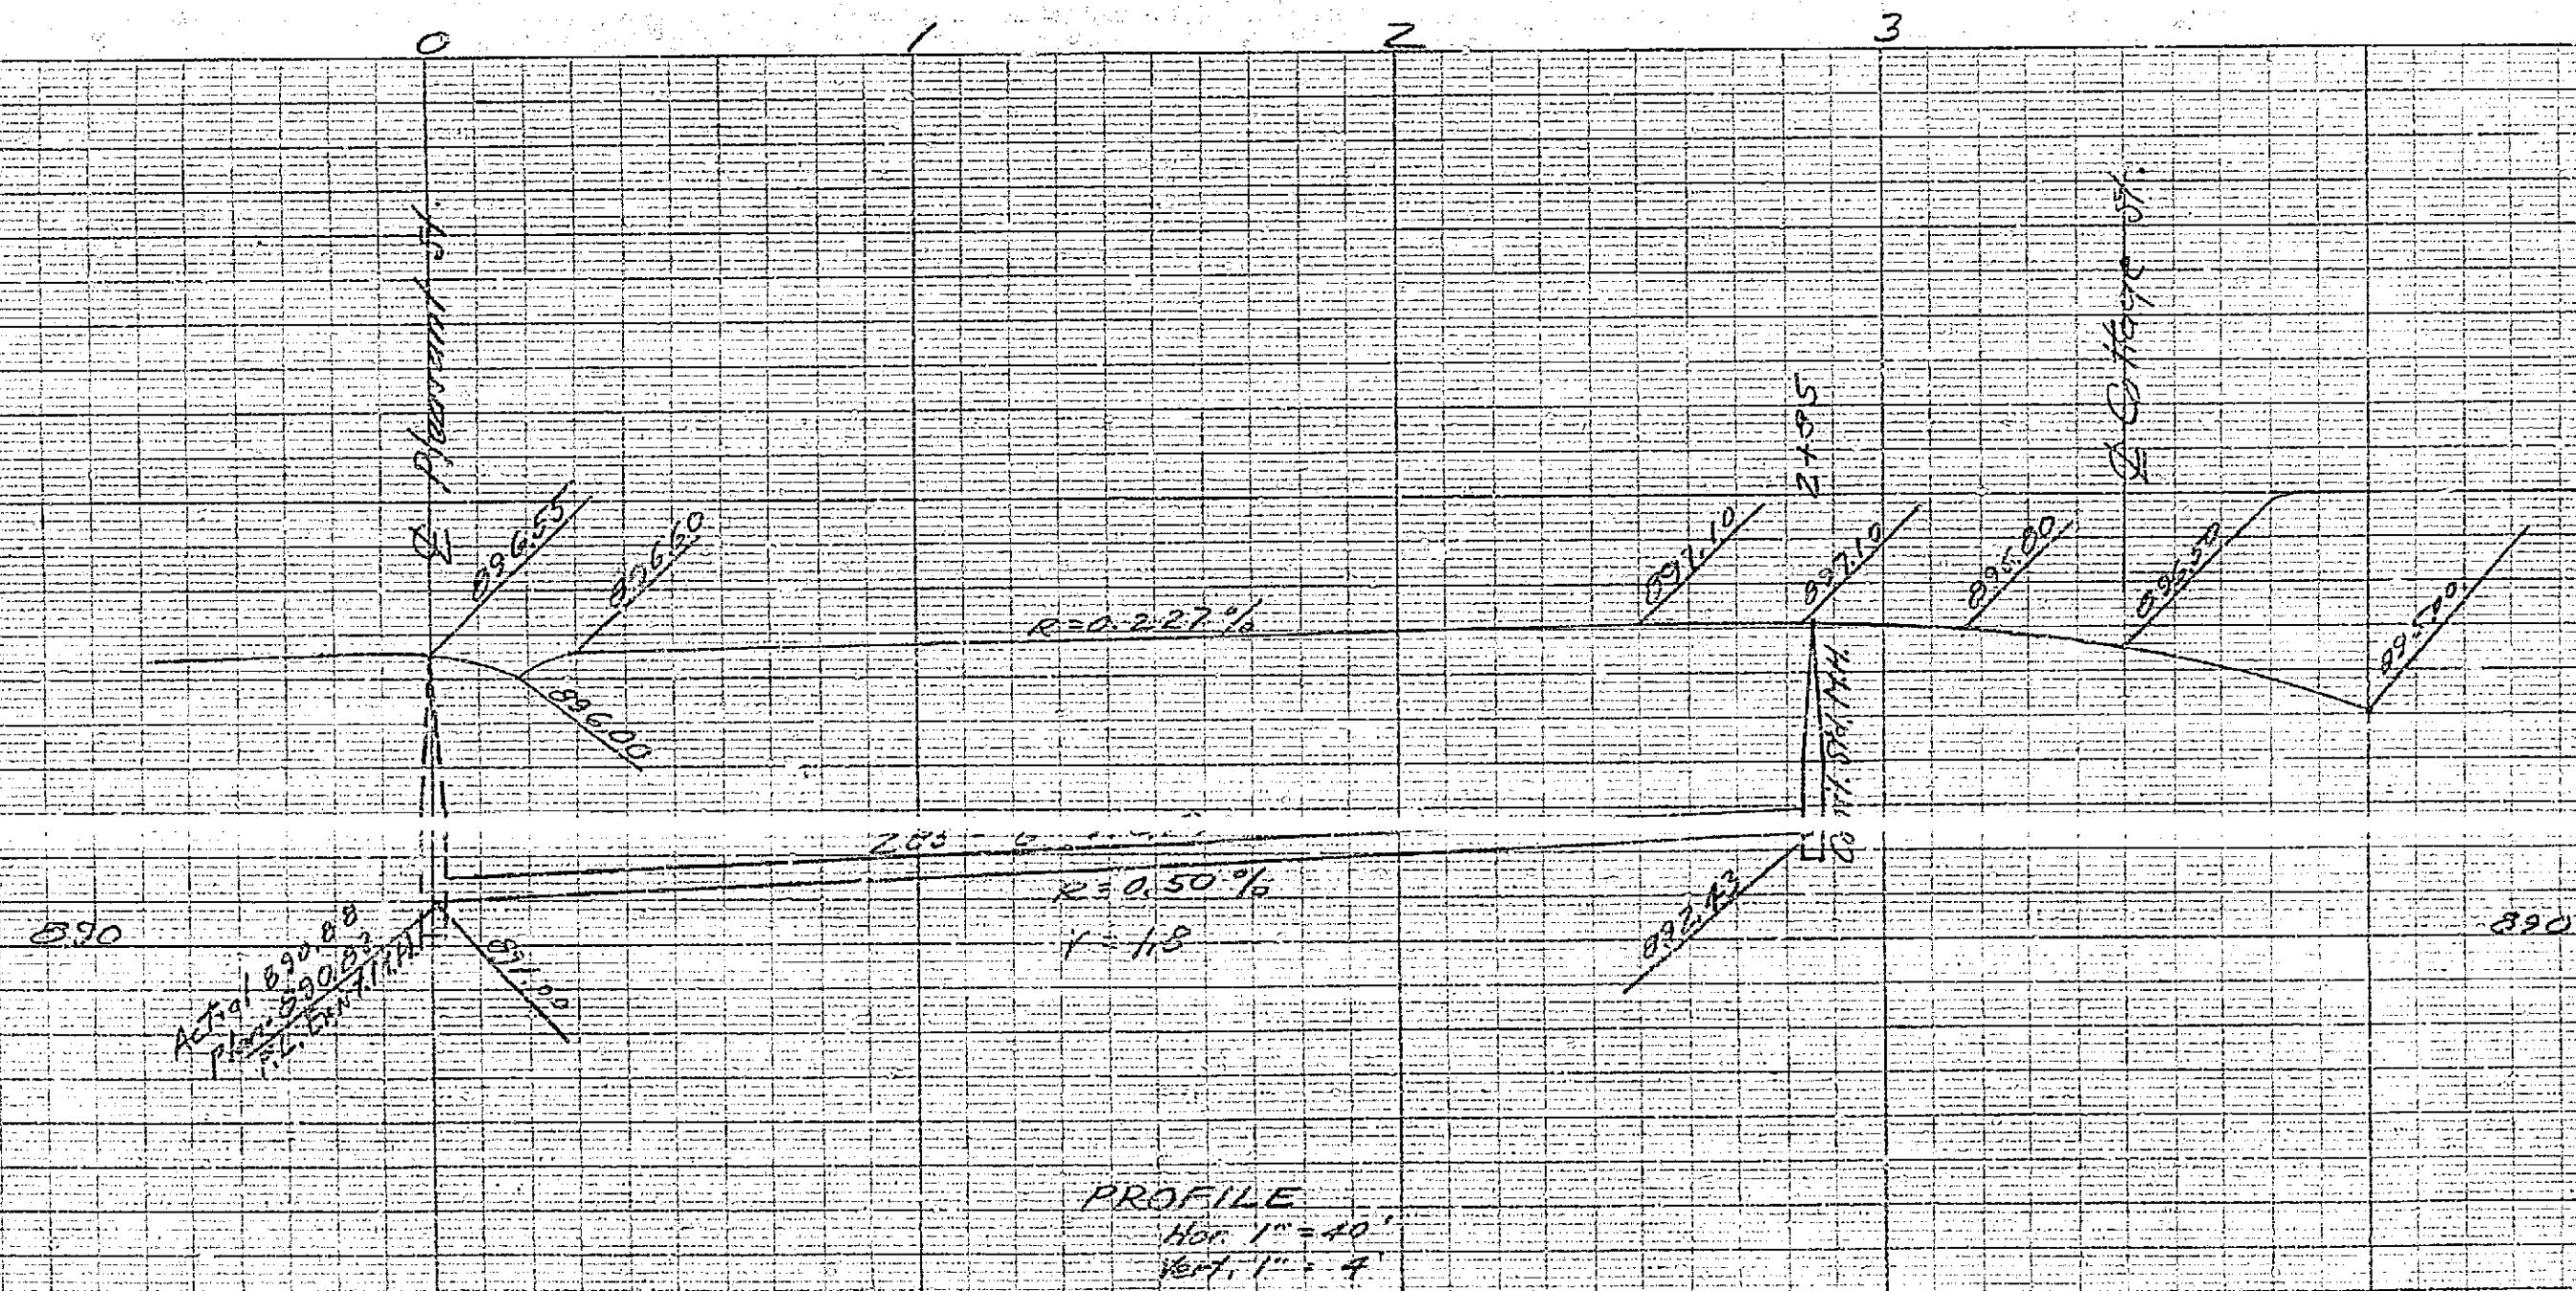

543A