



2+00 @ Blaine
 +71 Wye east
 2+21 Wye east
 2+32 Mb.

Jussant Hunter Douglas
 Sewer

554

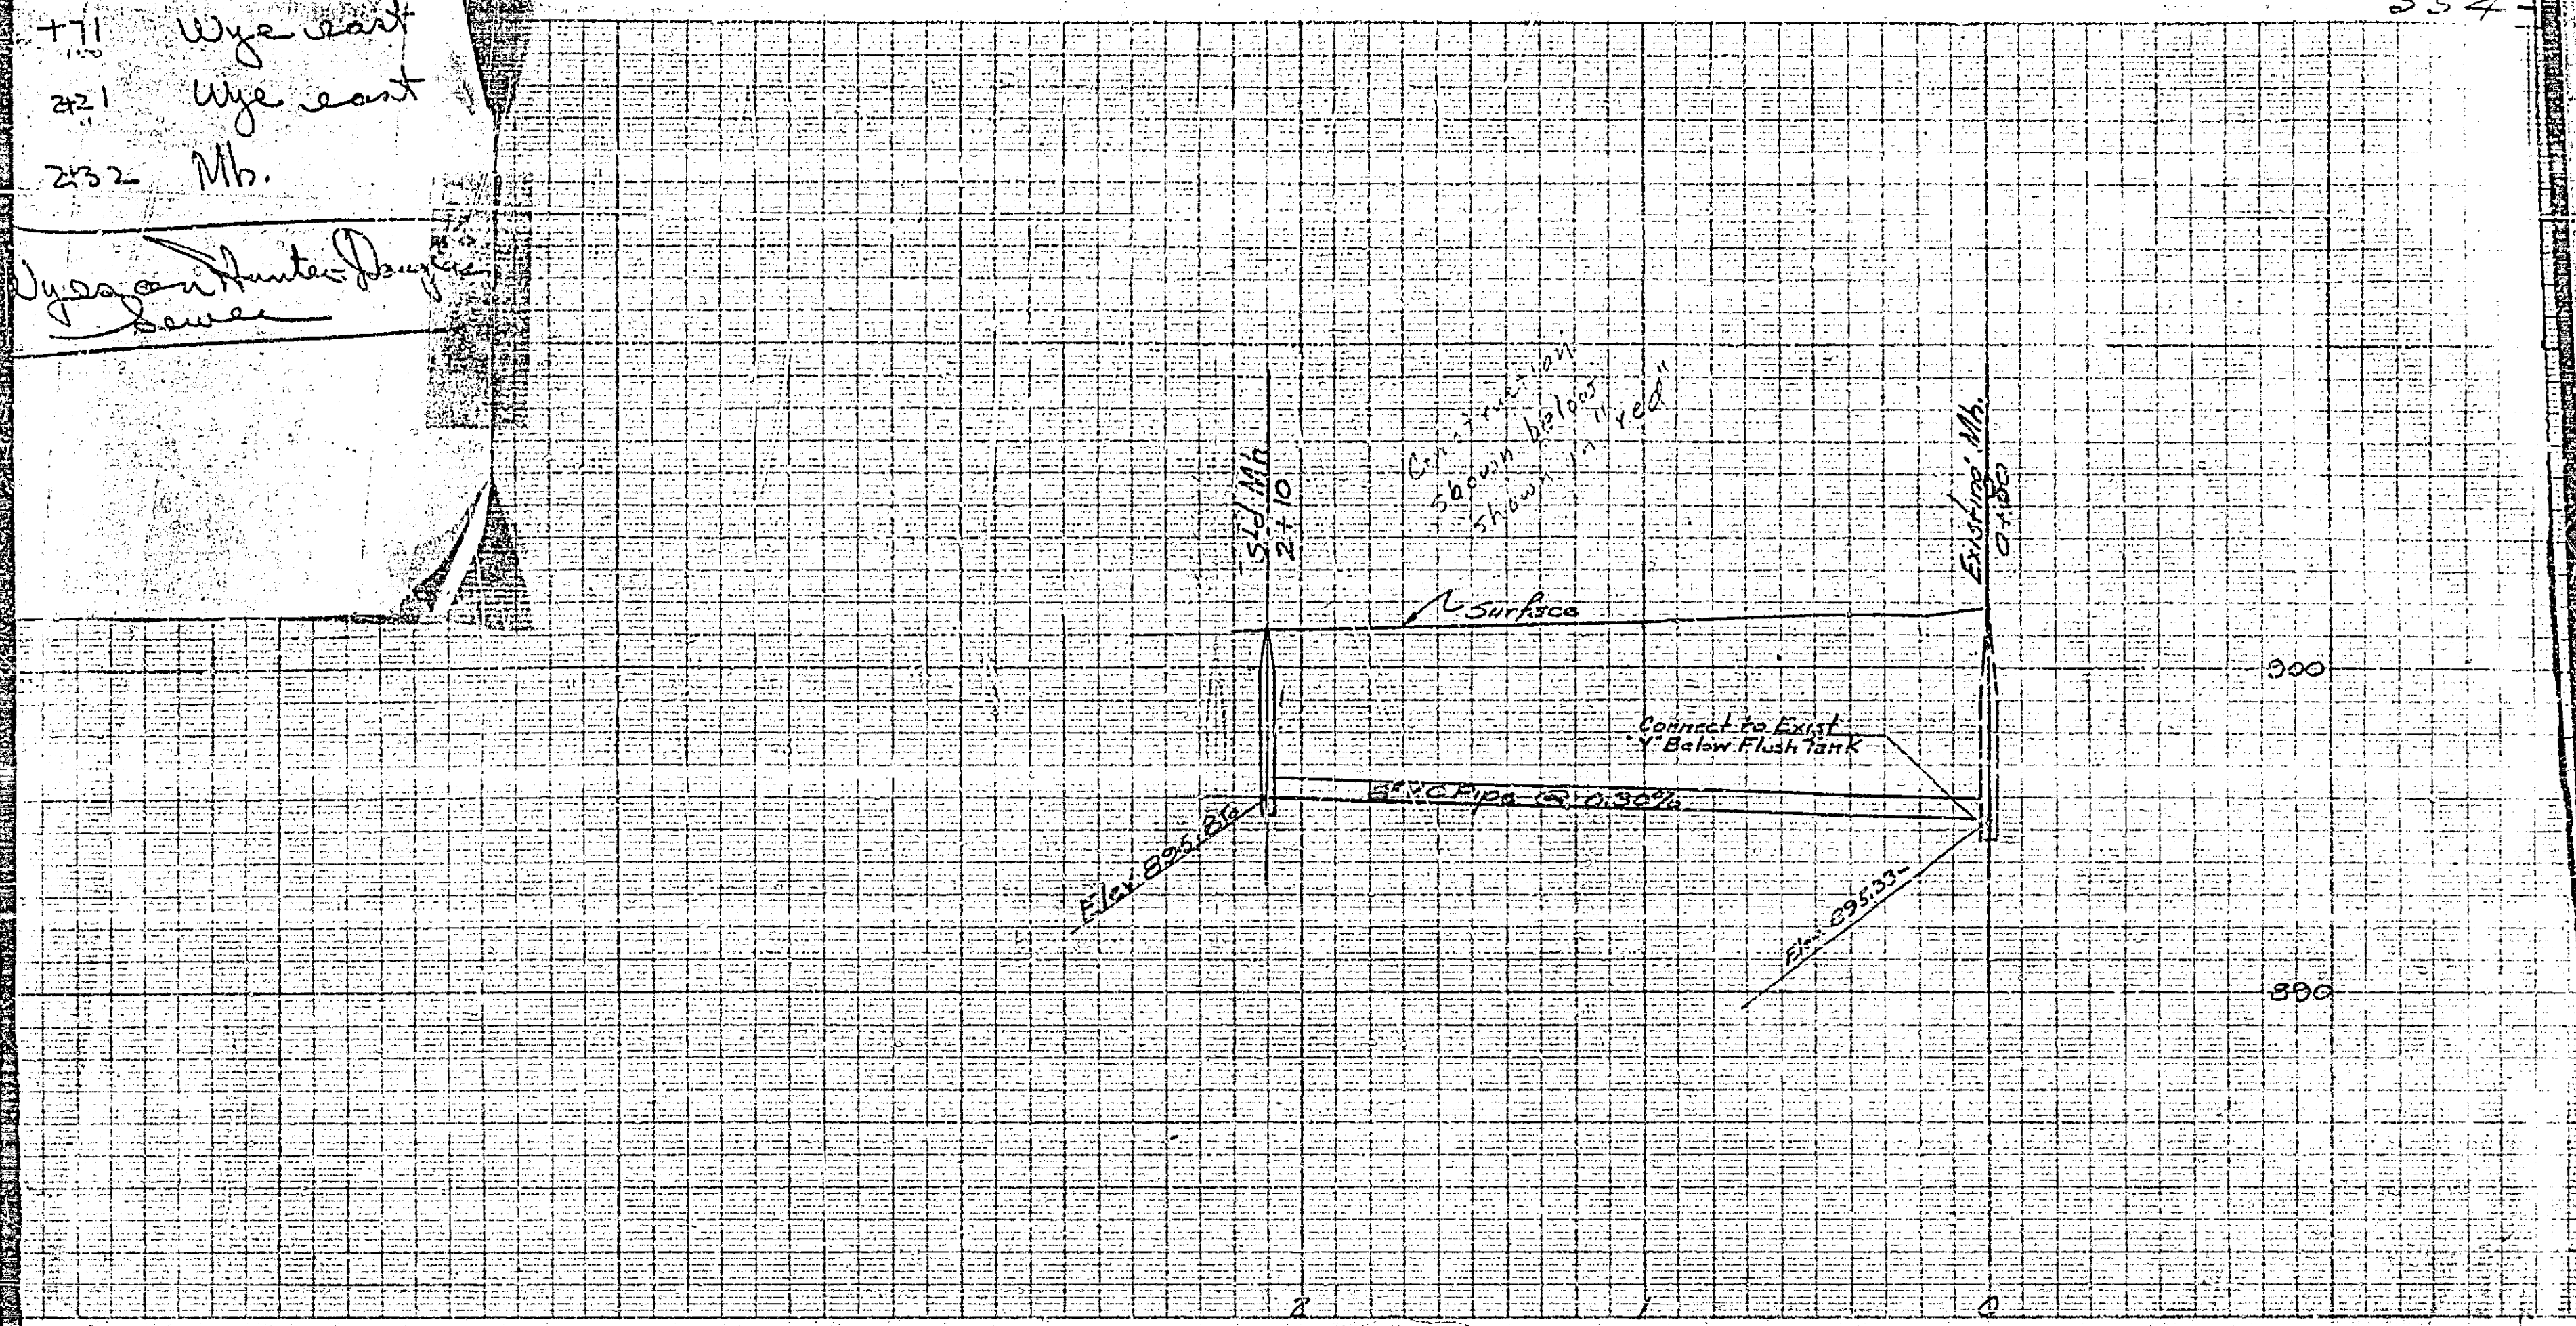

July 1949
 461/36
 Hunter-Douglas Corporation

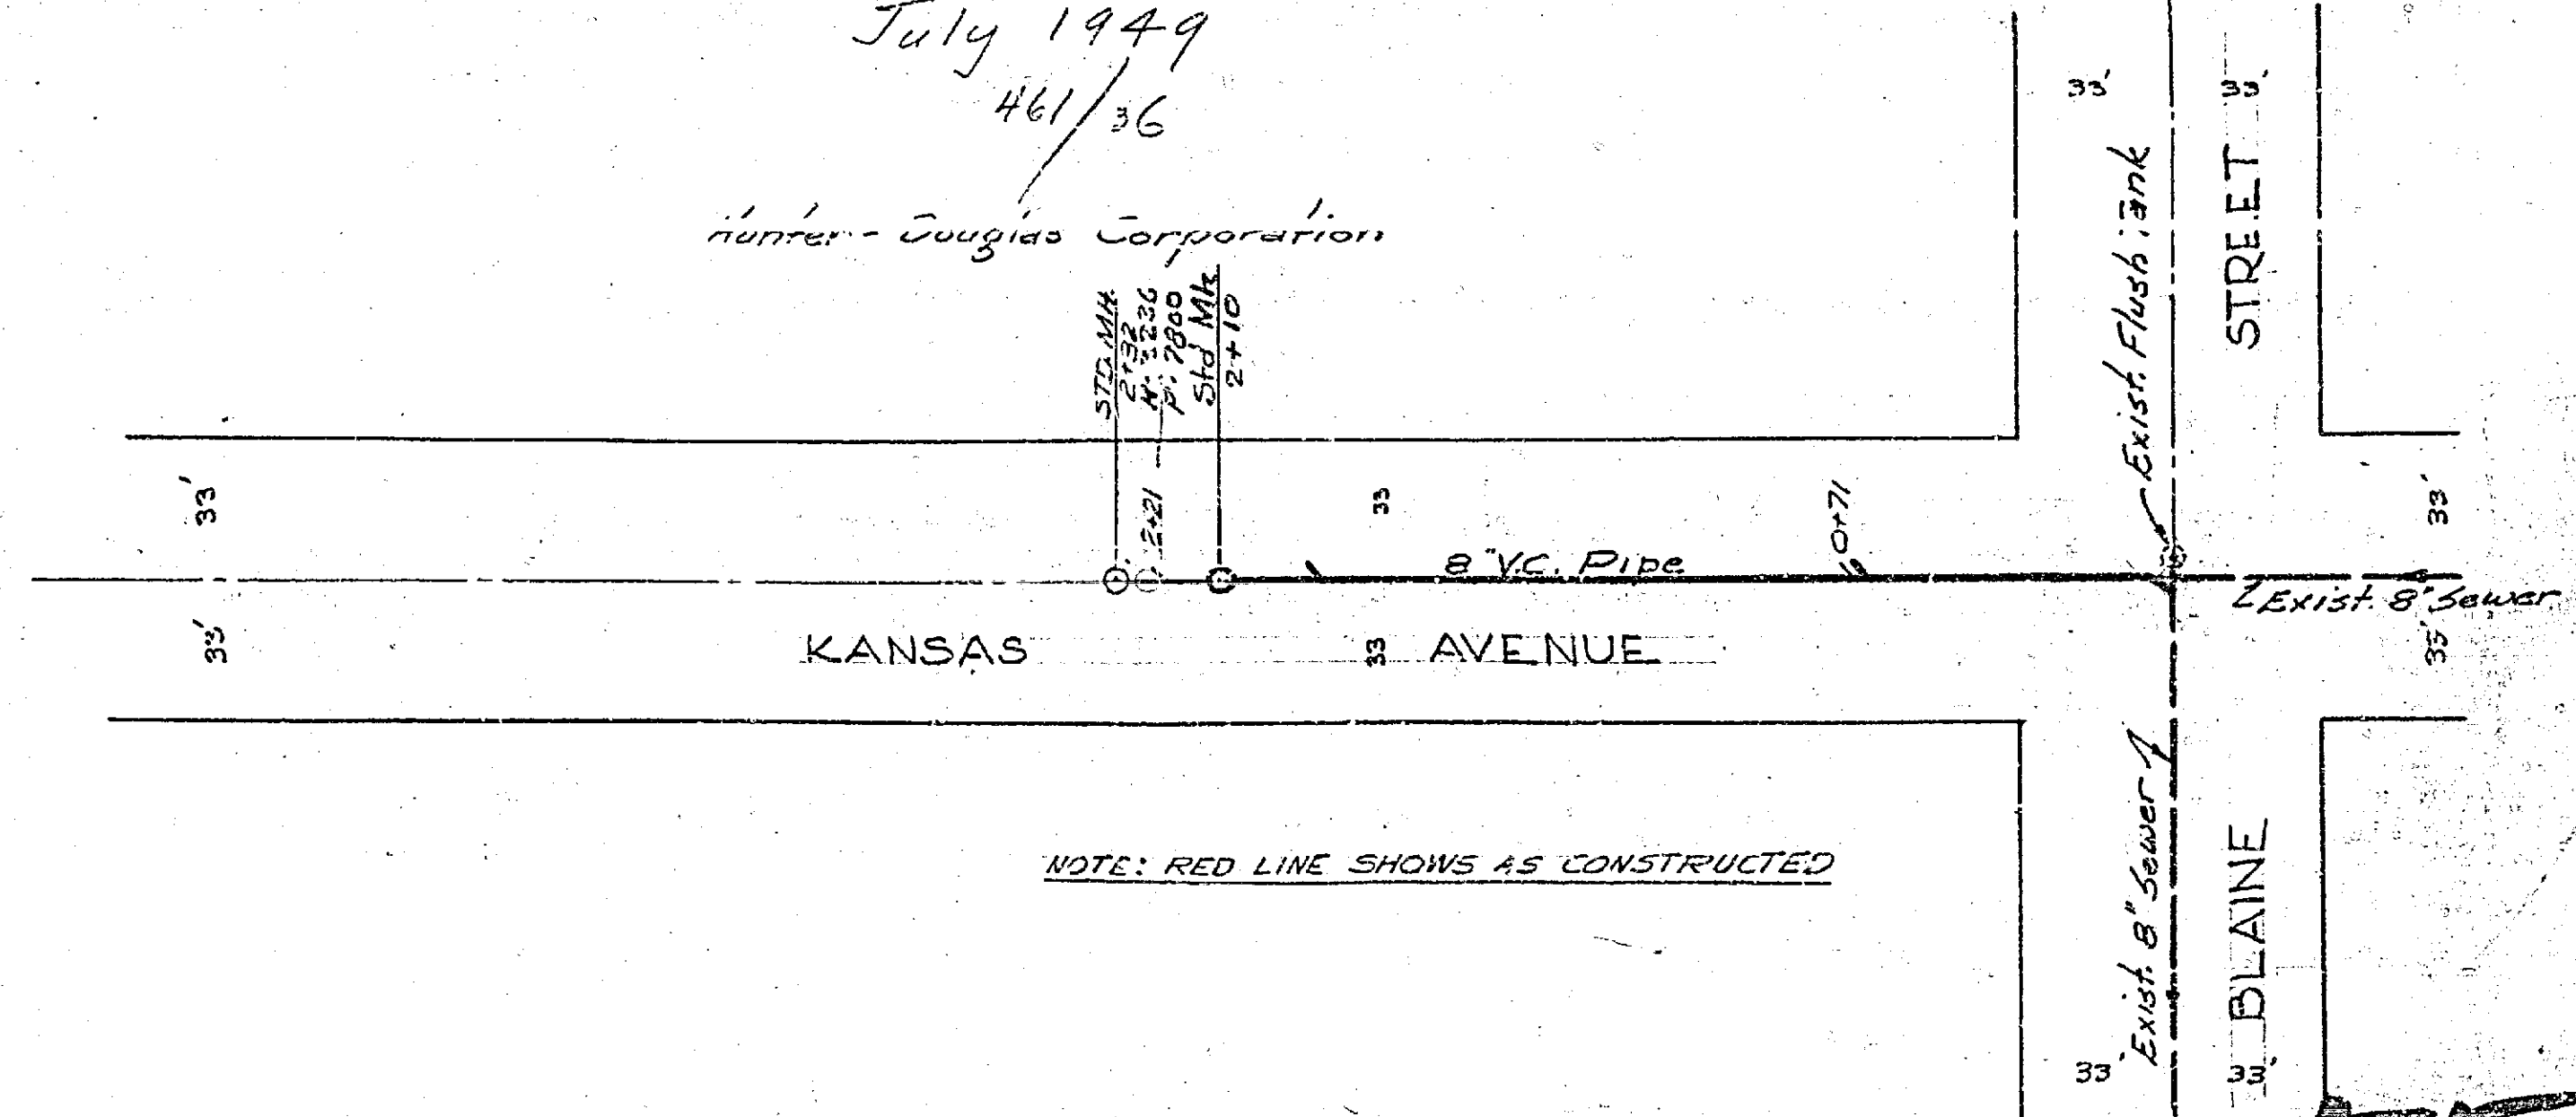

NOTE: RED LINE SHOWS AS CONSTRUCTED

554A