


PROPERTY OF  
CITY OF RIVERSIDE  
CITY ENGINEERING DEPT.

PROPERTY OF  
CITY OF RIVERSIDE  
CITY ENGINEERING DEPT.

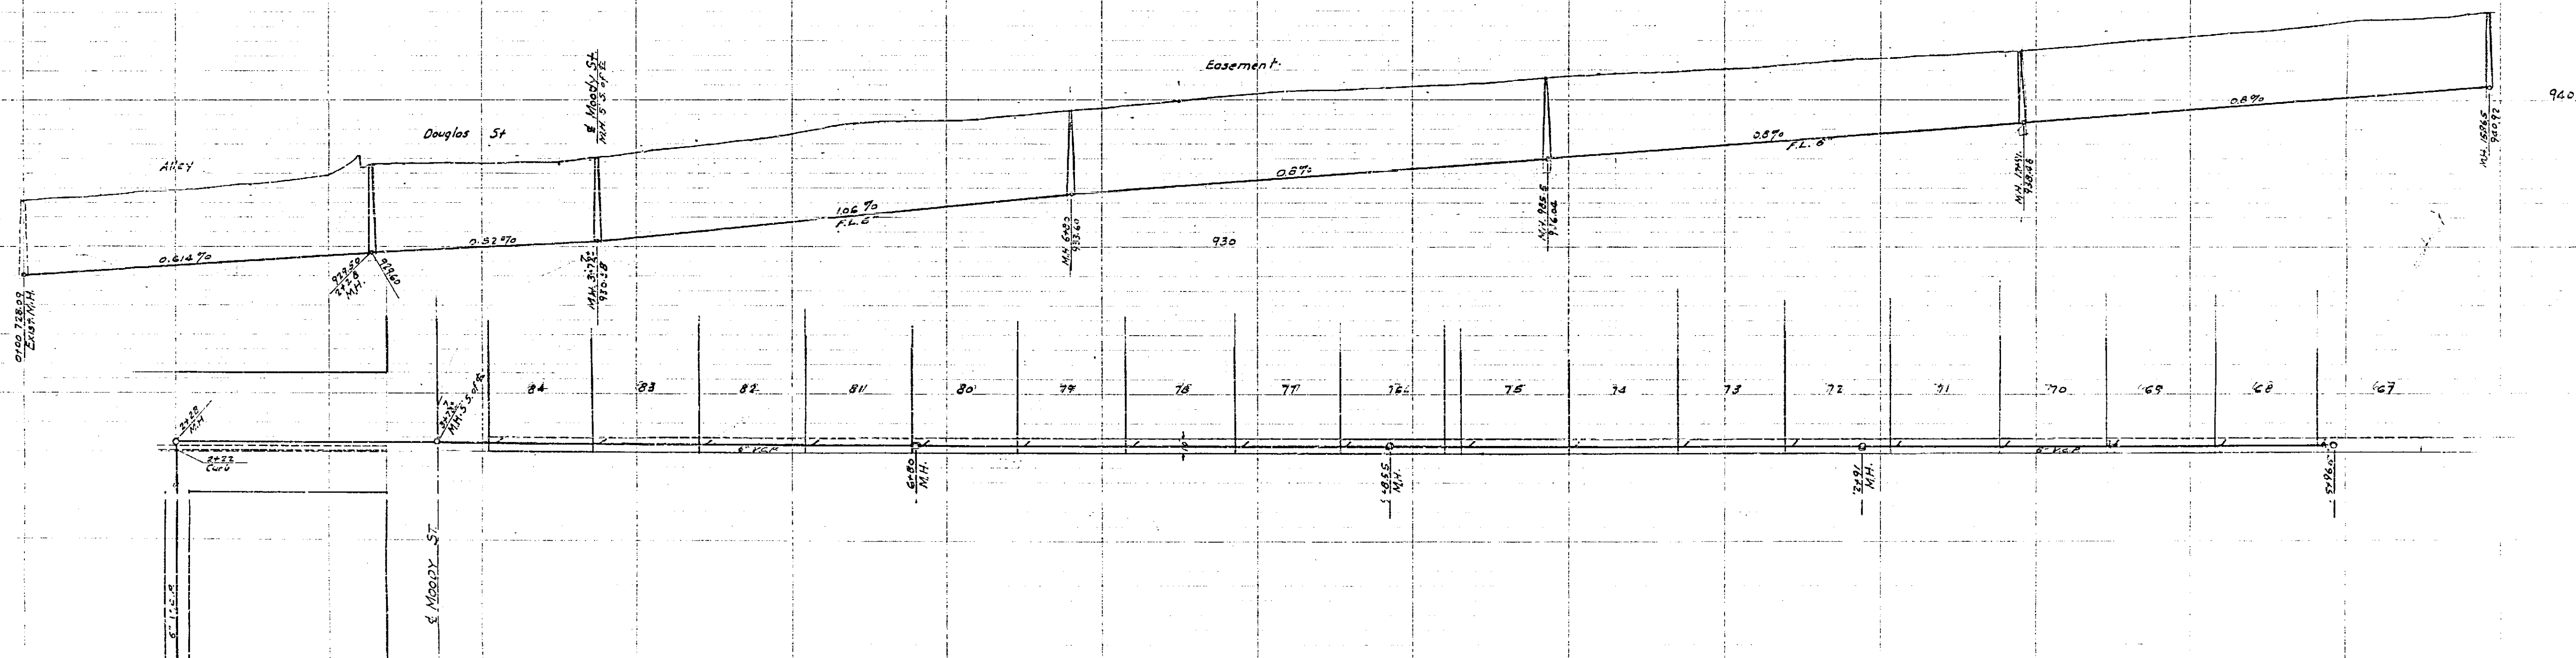

PROPERTY OF  
CITY OF RIVERSIDE  
CITY ENGINEERING DEPT.

UNIVERSITY MANOR  
SEWER PROFILES  
July 1950 Scale 1"=40'  
Date 7-13-1950 Approved in *[Signature]*  
Drawn by D.J.M. Sheet 1 of 3 sheets

PROPERTY OF  
CITY OF RIVERSIDE  
CITY ENGINEERING DEPT.

577

PROPERTY OF  
CITY OF RIVERSIDE  
CITY ENGINEERING DEPT.


PROPERTY OF  
CITY OF RIVERSIDE  
CITY ENGINEERING DEPT.

UNIVERSITY MANOR  
PLANS AND PROFILES  
For SAWERS  
Approved 7-13-1950 P.M.H. Irvine  
City Eng.  
Sheet 2 of 3 Sheets

PROPERTY OF  
CITY OF RIVERSIDE  
CITY ENGINEERING DEPT.


PROPERTY OF  
CITY OF RIVERSIDE  
CITY ENGINEERING DEPT.

577

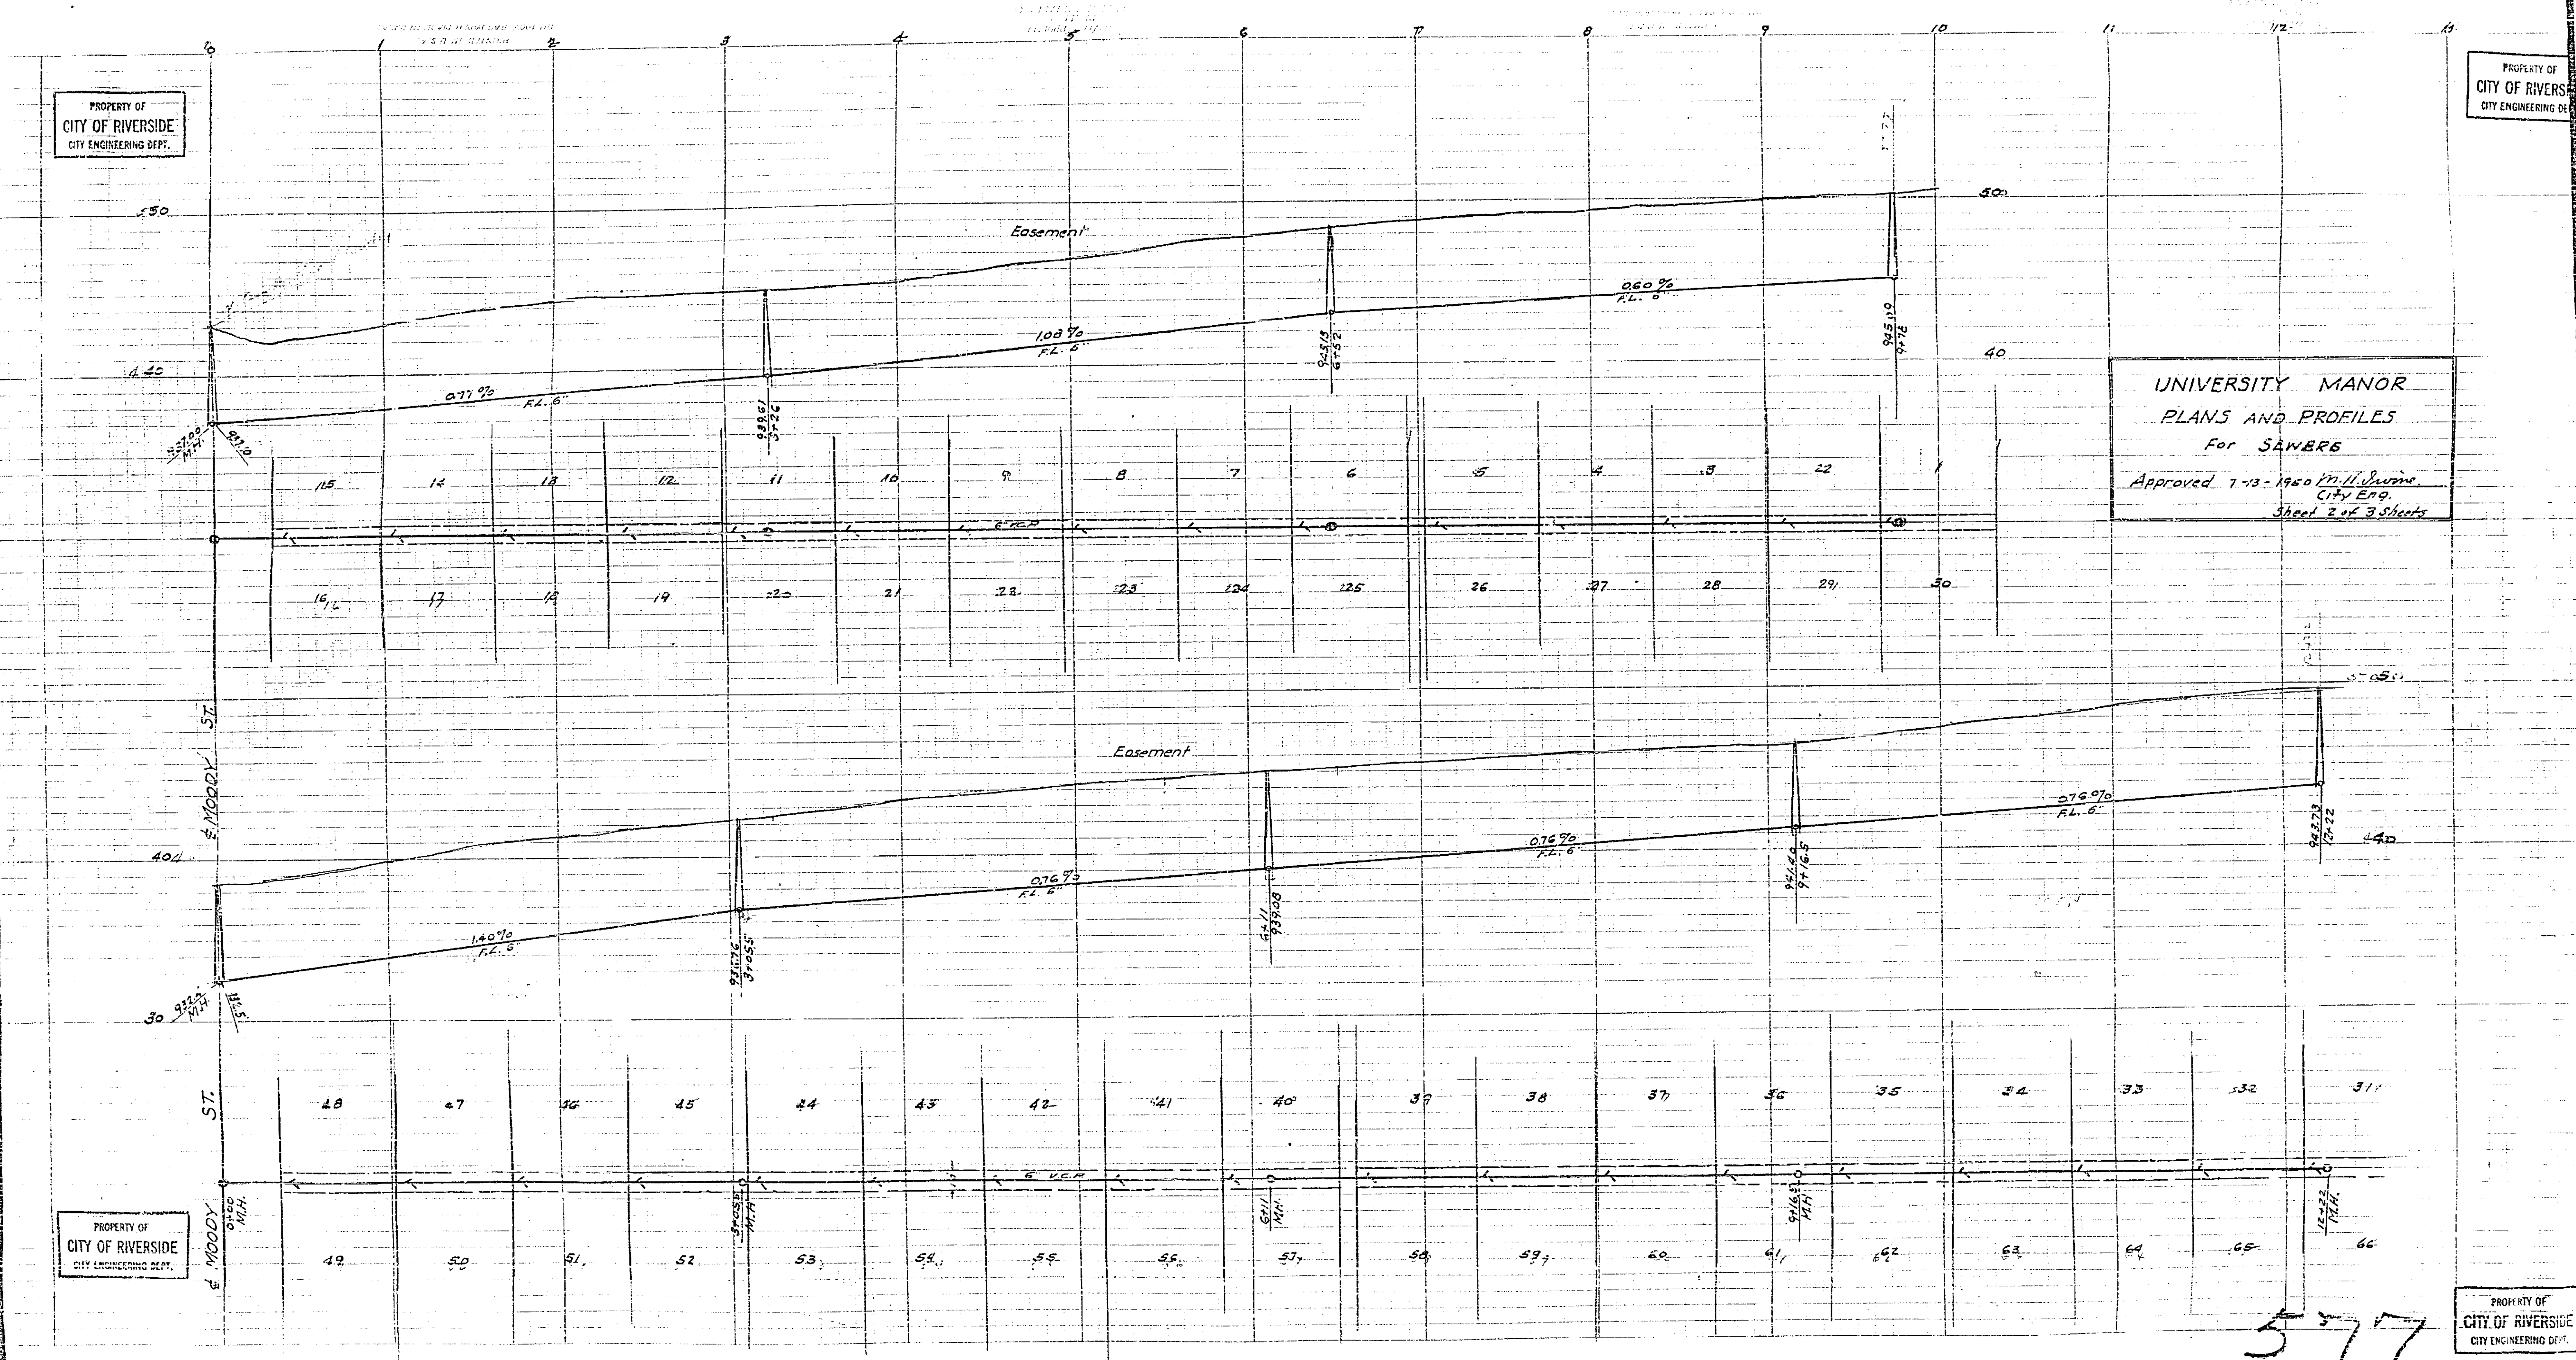


PROPERTY OF  
CITY OF RIVERSIDE  
CITY ENGINEERING DEPT.

PROPERTY OF  
CITY OF RIVERSIDE  
CITY ENGINEERING DEPT.

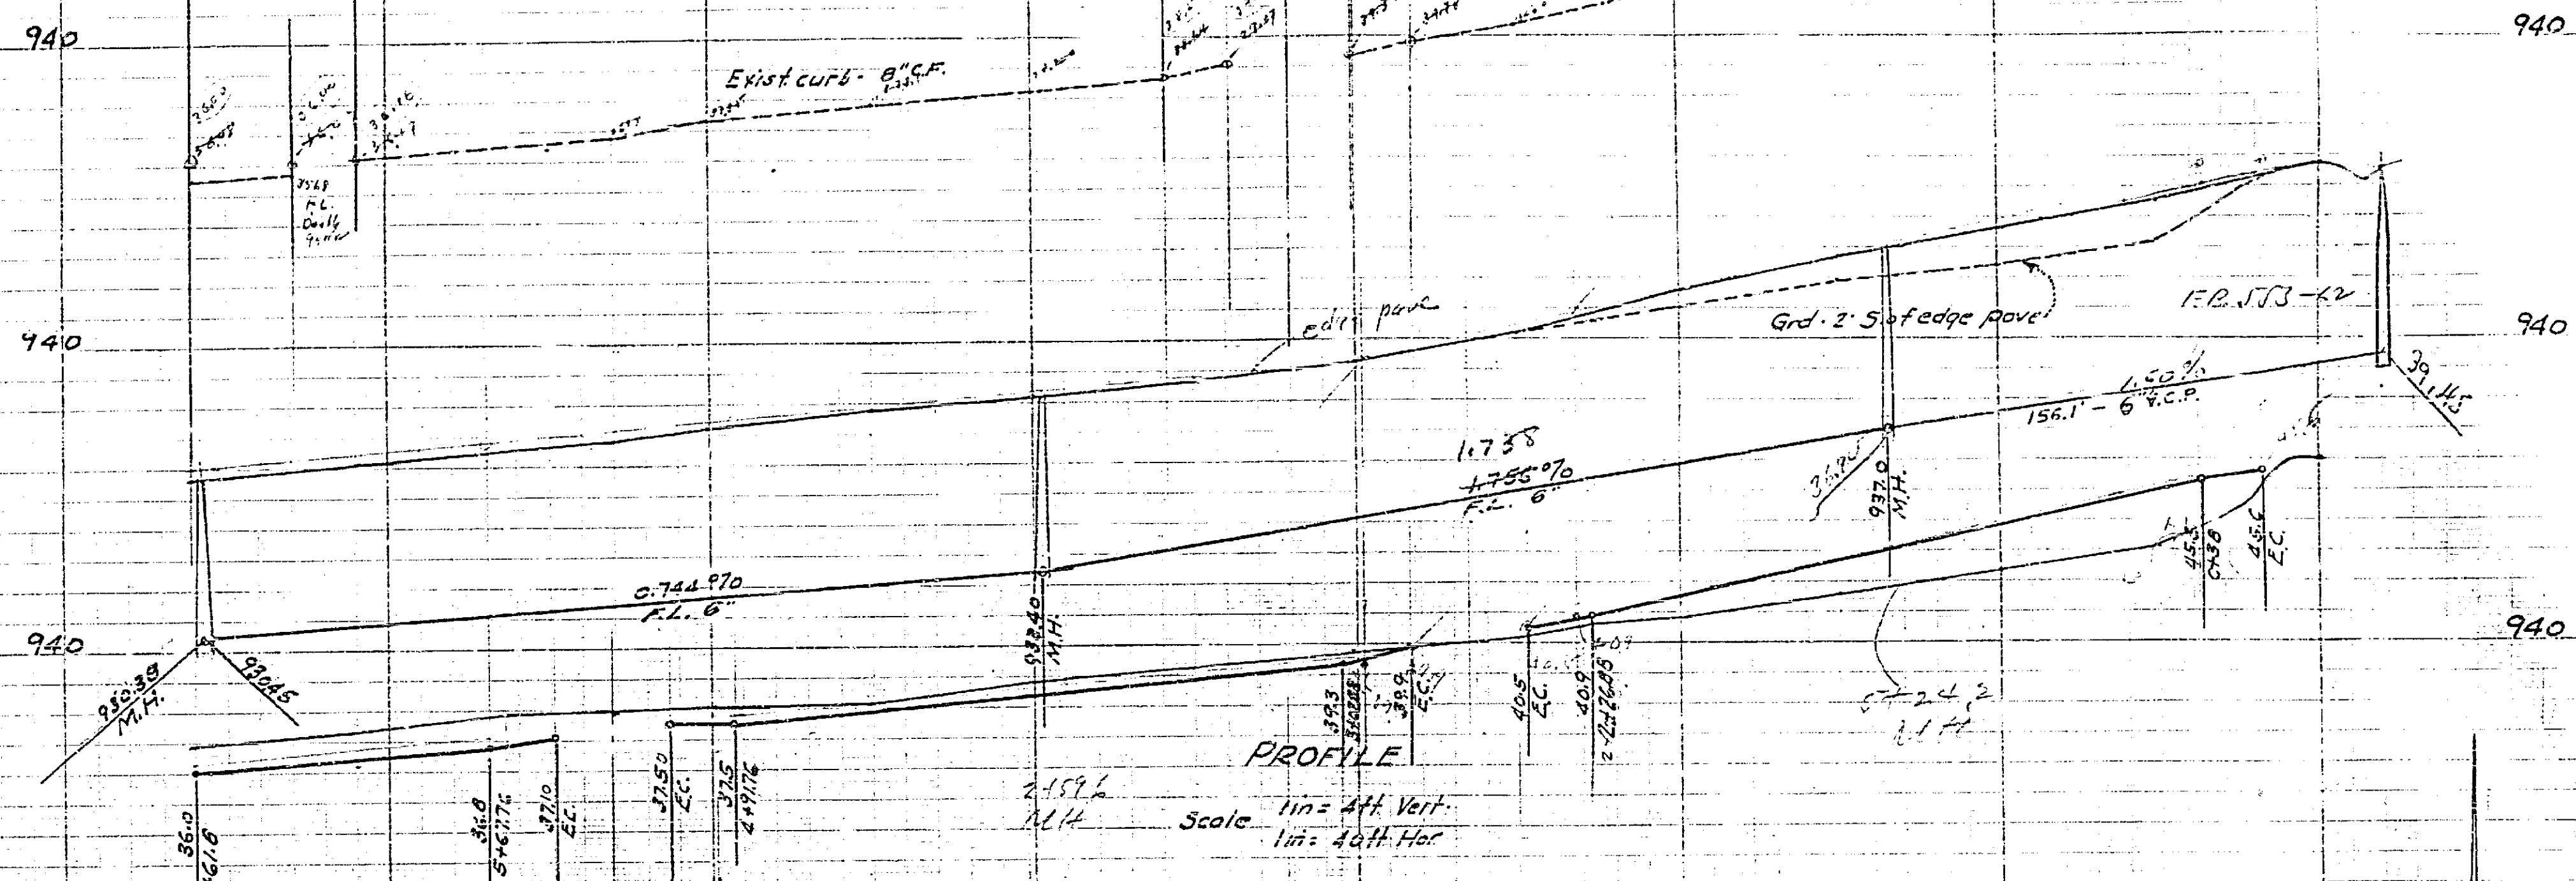

PROFILE  
Scale 1" = 4ft Vert  
1" = 40ft Hor

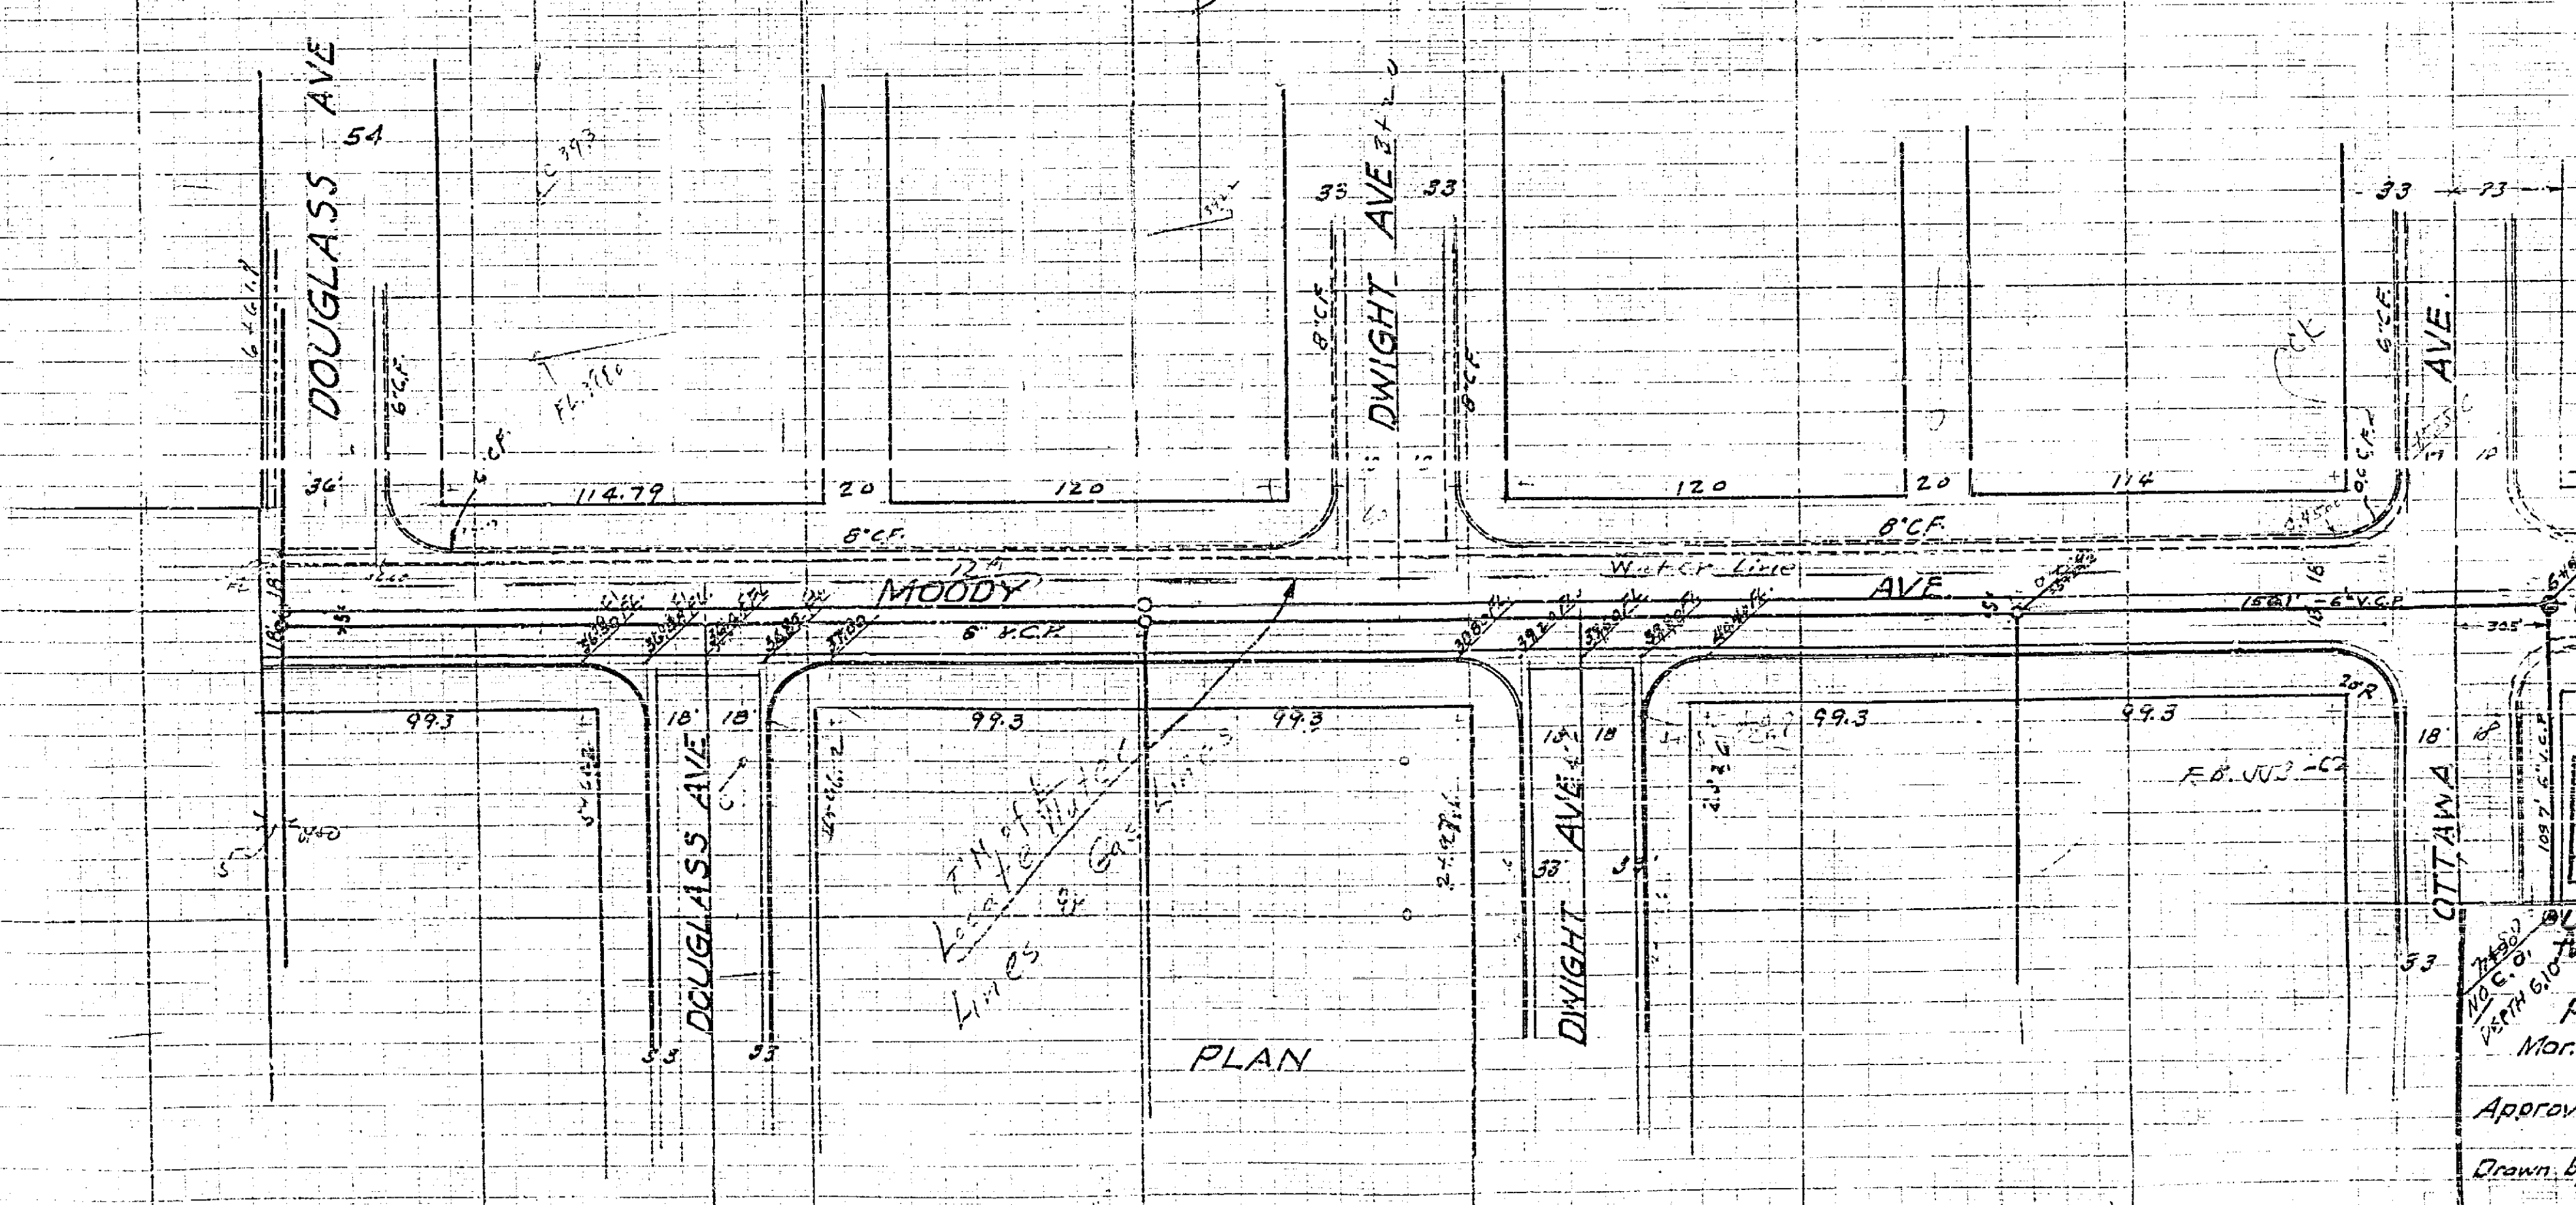

PLAN

PROPERTY OF  
CITY OF RIVERSIDE  
CITY ENGINEERING DEPT.

PROPERTY OF  
CITY OF RIVERSIDE  
CITY ENGINEERING DEPT.

UNIVERSITY MANOR  
TRACER  
SEWER  
PLANS AND PROFILES  
Mar. 1950 Scale 1" = 40ft

Approved 7-13-1950 J.M. [Signature]  
City Engineer

Drawn by D.J.M. Sheet 2 of 3

69.3  
32  
172.3

5577