
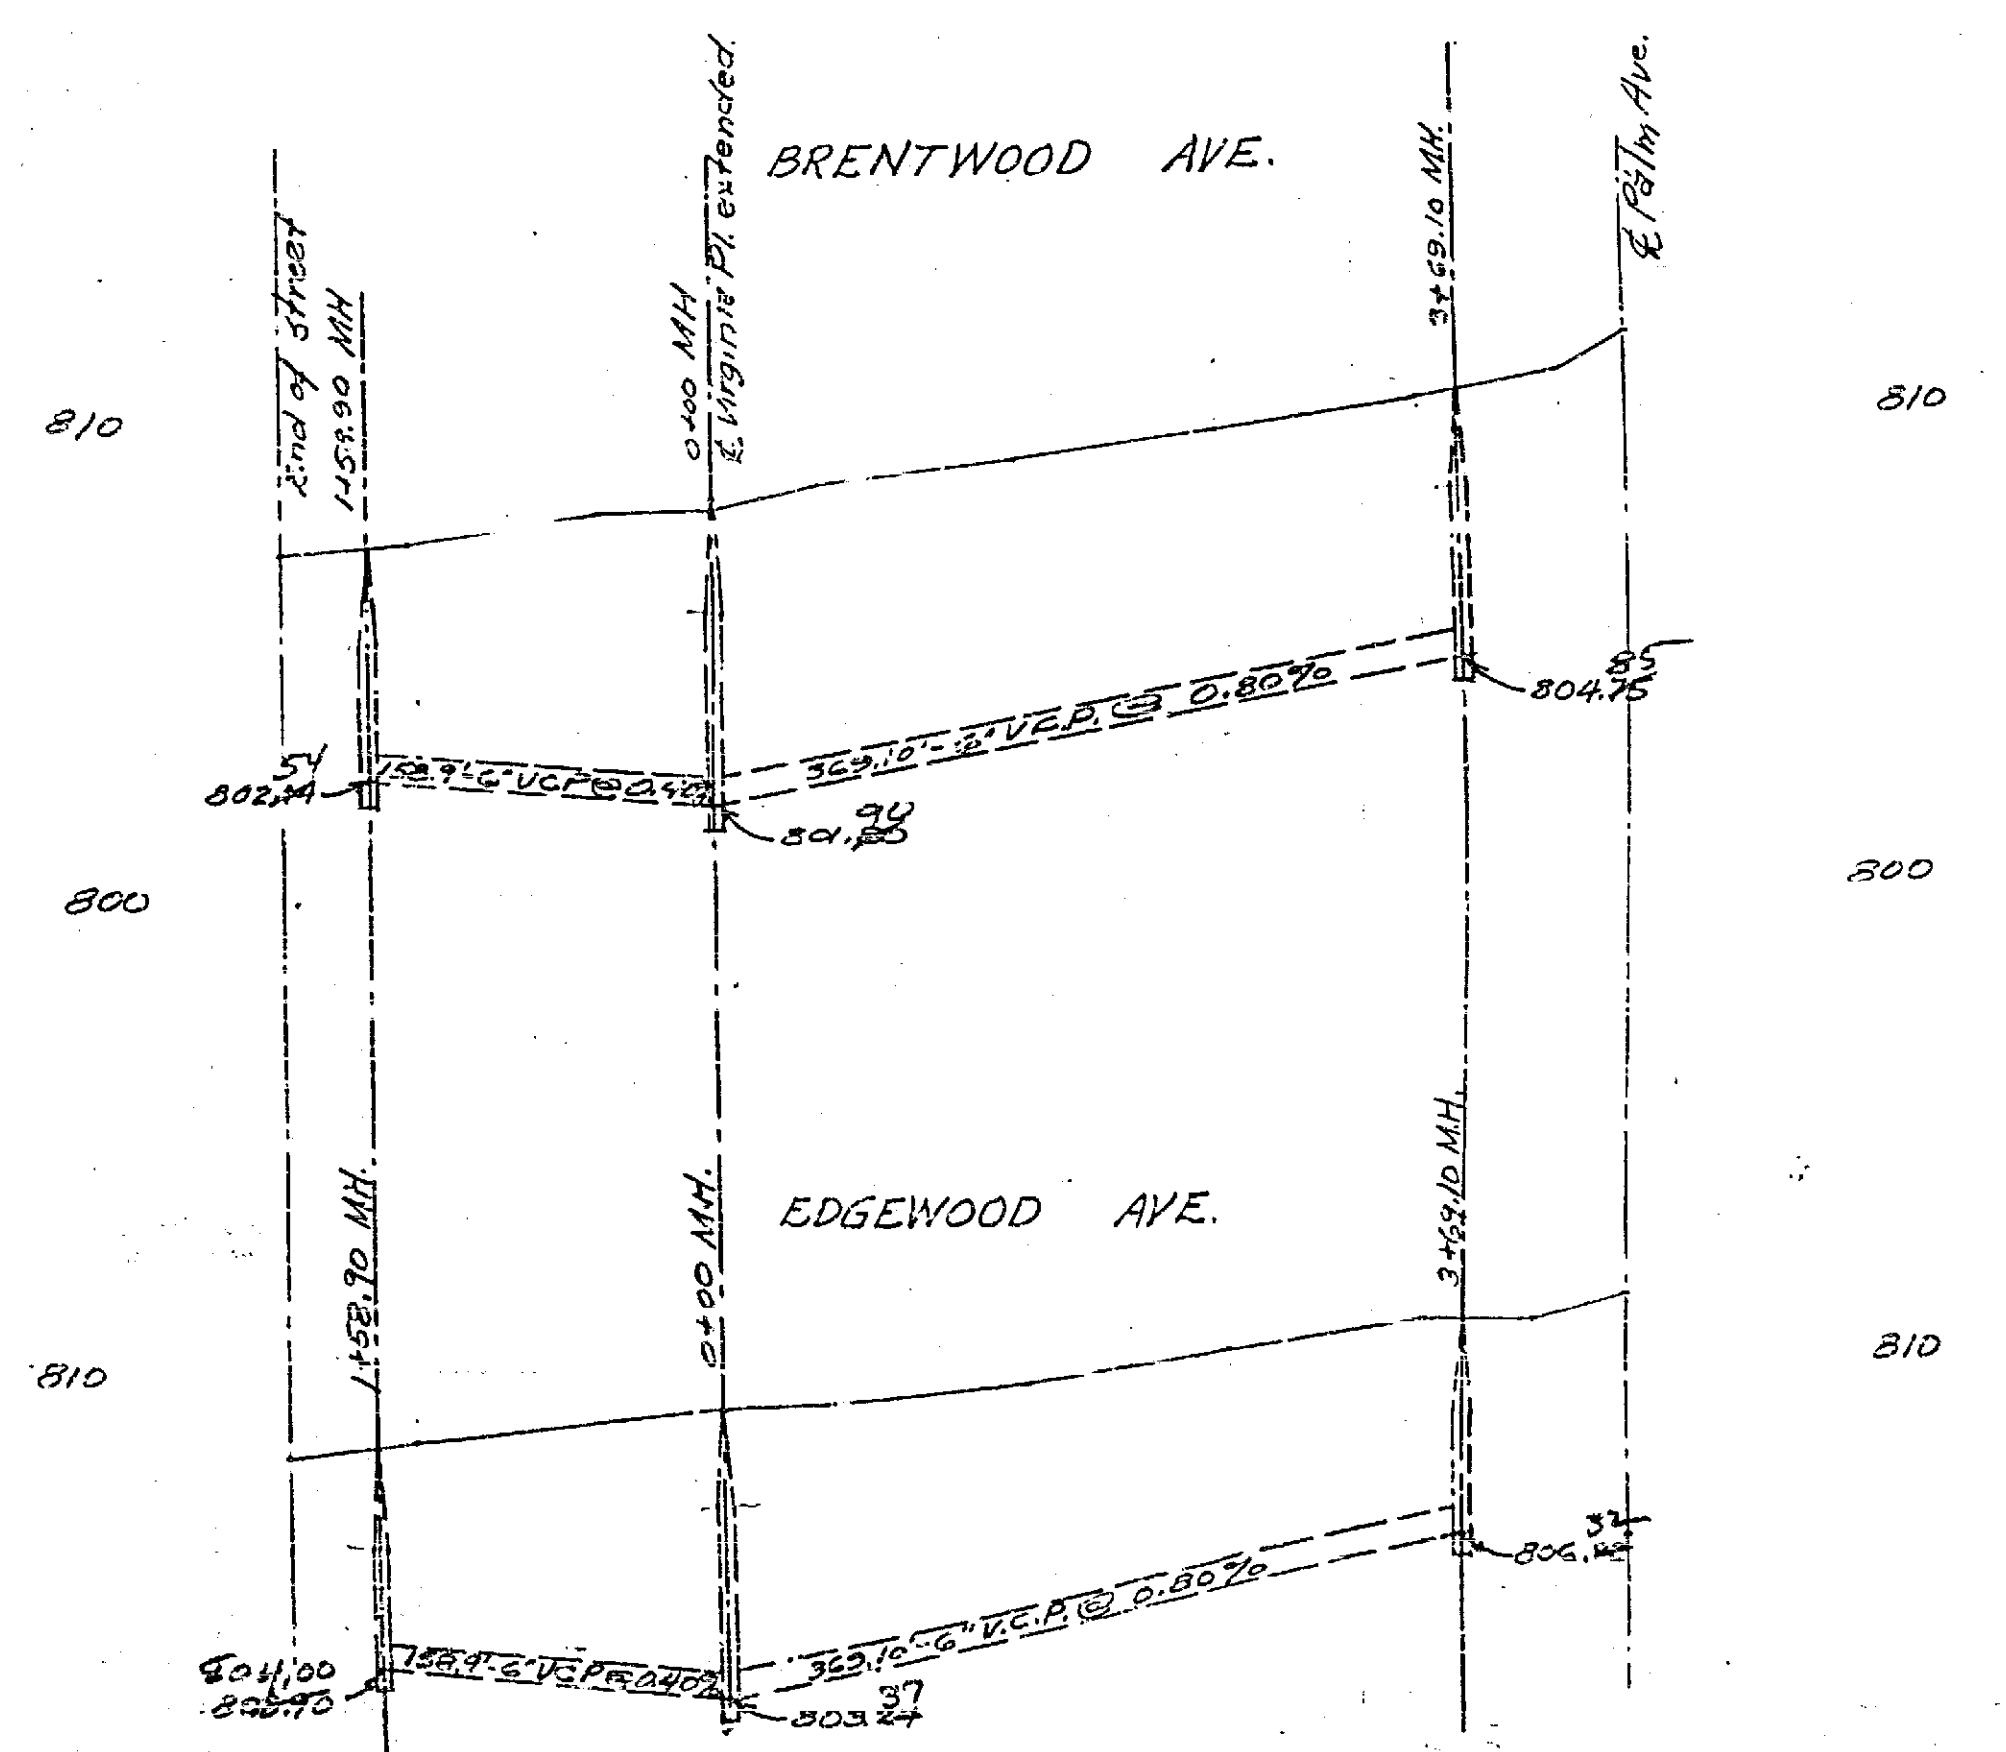


VIRGINIA PLACE SEWER			
DRAWING NUMBER	SHEET NUMBER	TOTAL SHEETS	FIELD BOOKS
588	1	1	
DRAWN	CHECKED	APPROVED	
N.M. FELT	June 6, 1946		

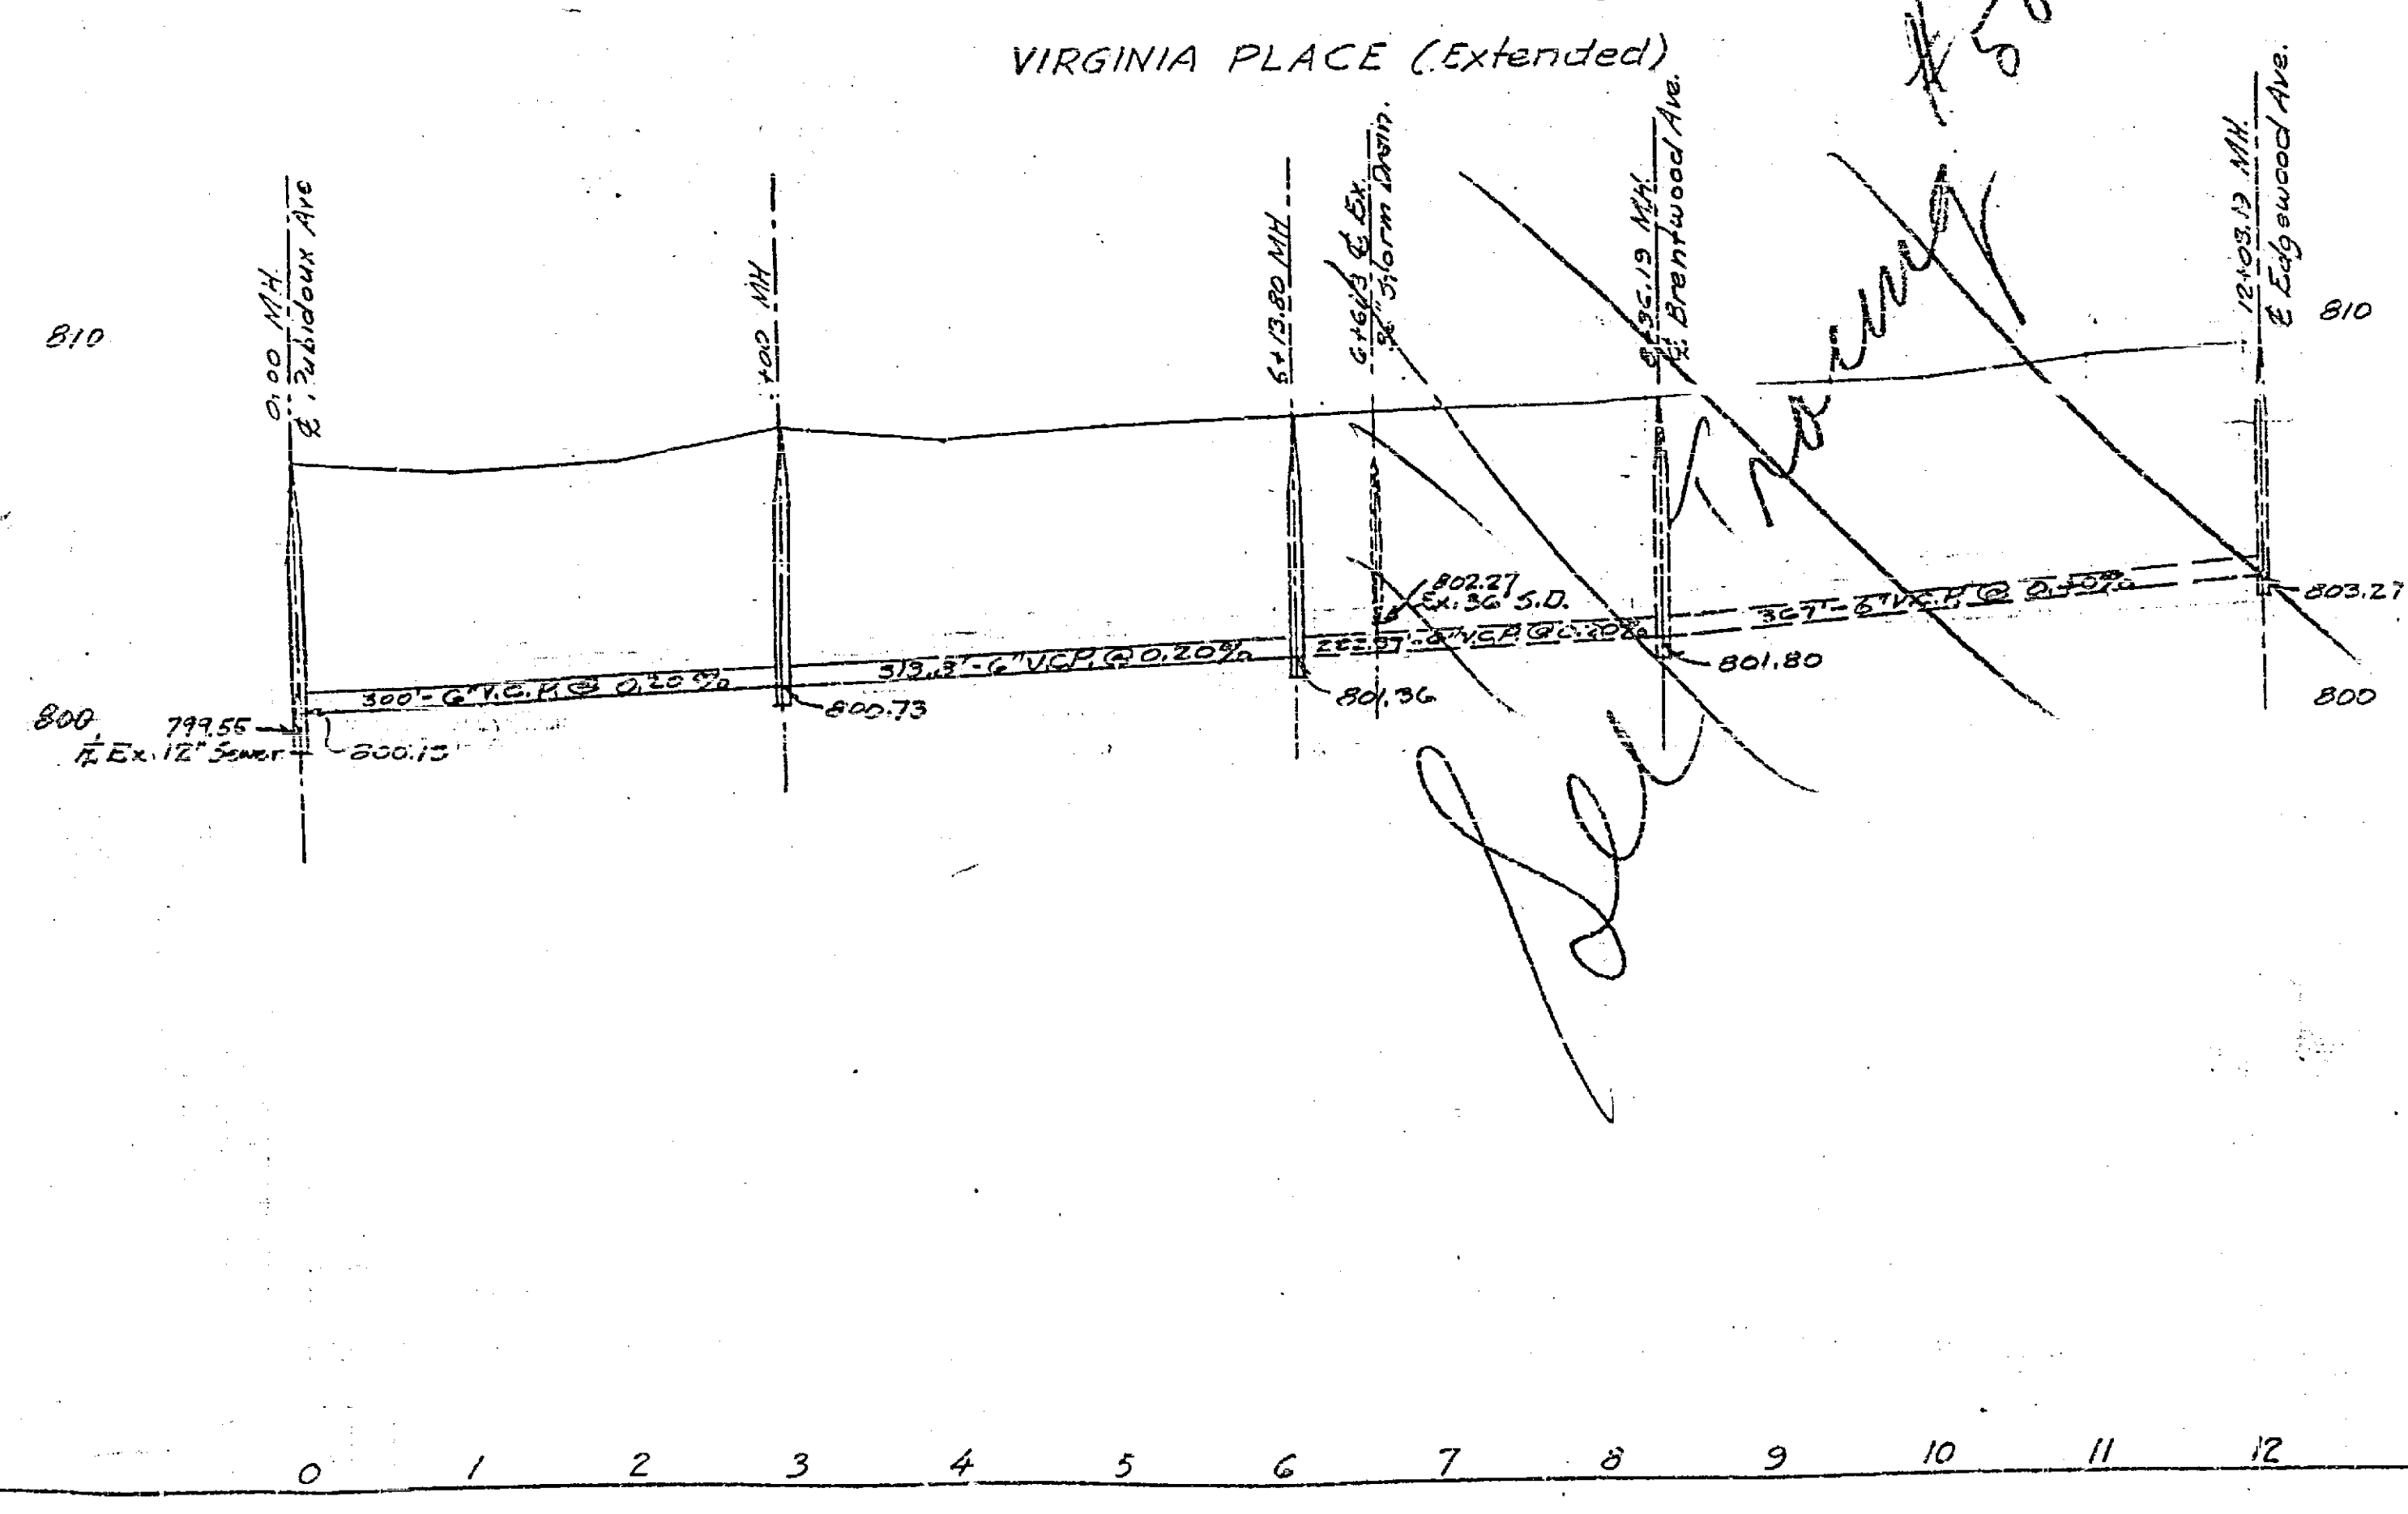

588 A