

PLAN & PROFILES
NO. 588-A
BRENTWOOD-EDGEWOOD SEWER DISTRICT
CITY OF RIVERSIDE - STATE OF CALIFORNIA


Scales: Horiz. 1 in. = 100 ft
Vert. 1 in. = 4 ft

August, 1946

Approved: *M. H. Dennis*
City Engineer
a Civil Engineer registered under the Laws
of the State of California

These plans approved and adopted by the Mayor and
Council of the City of Riverside, California on this 10th
day of Sept. 1946
James P. ...
City Clerk
of the City of Riverside, California.

NOTE! RED MARKS ARE AS CONSTRUCTED.
F.B. 409/27-29

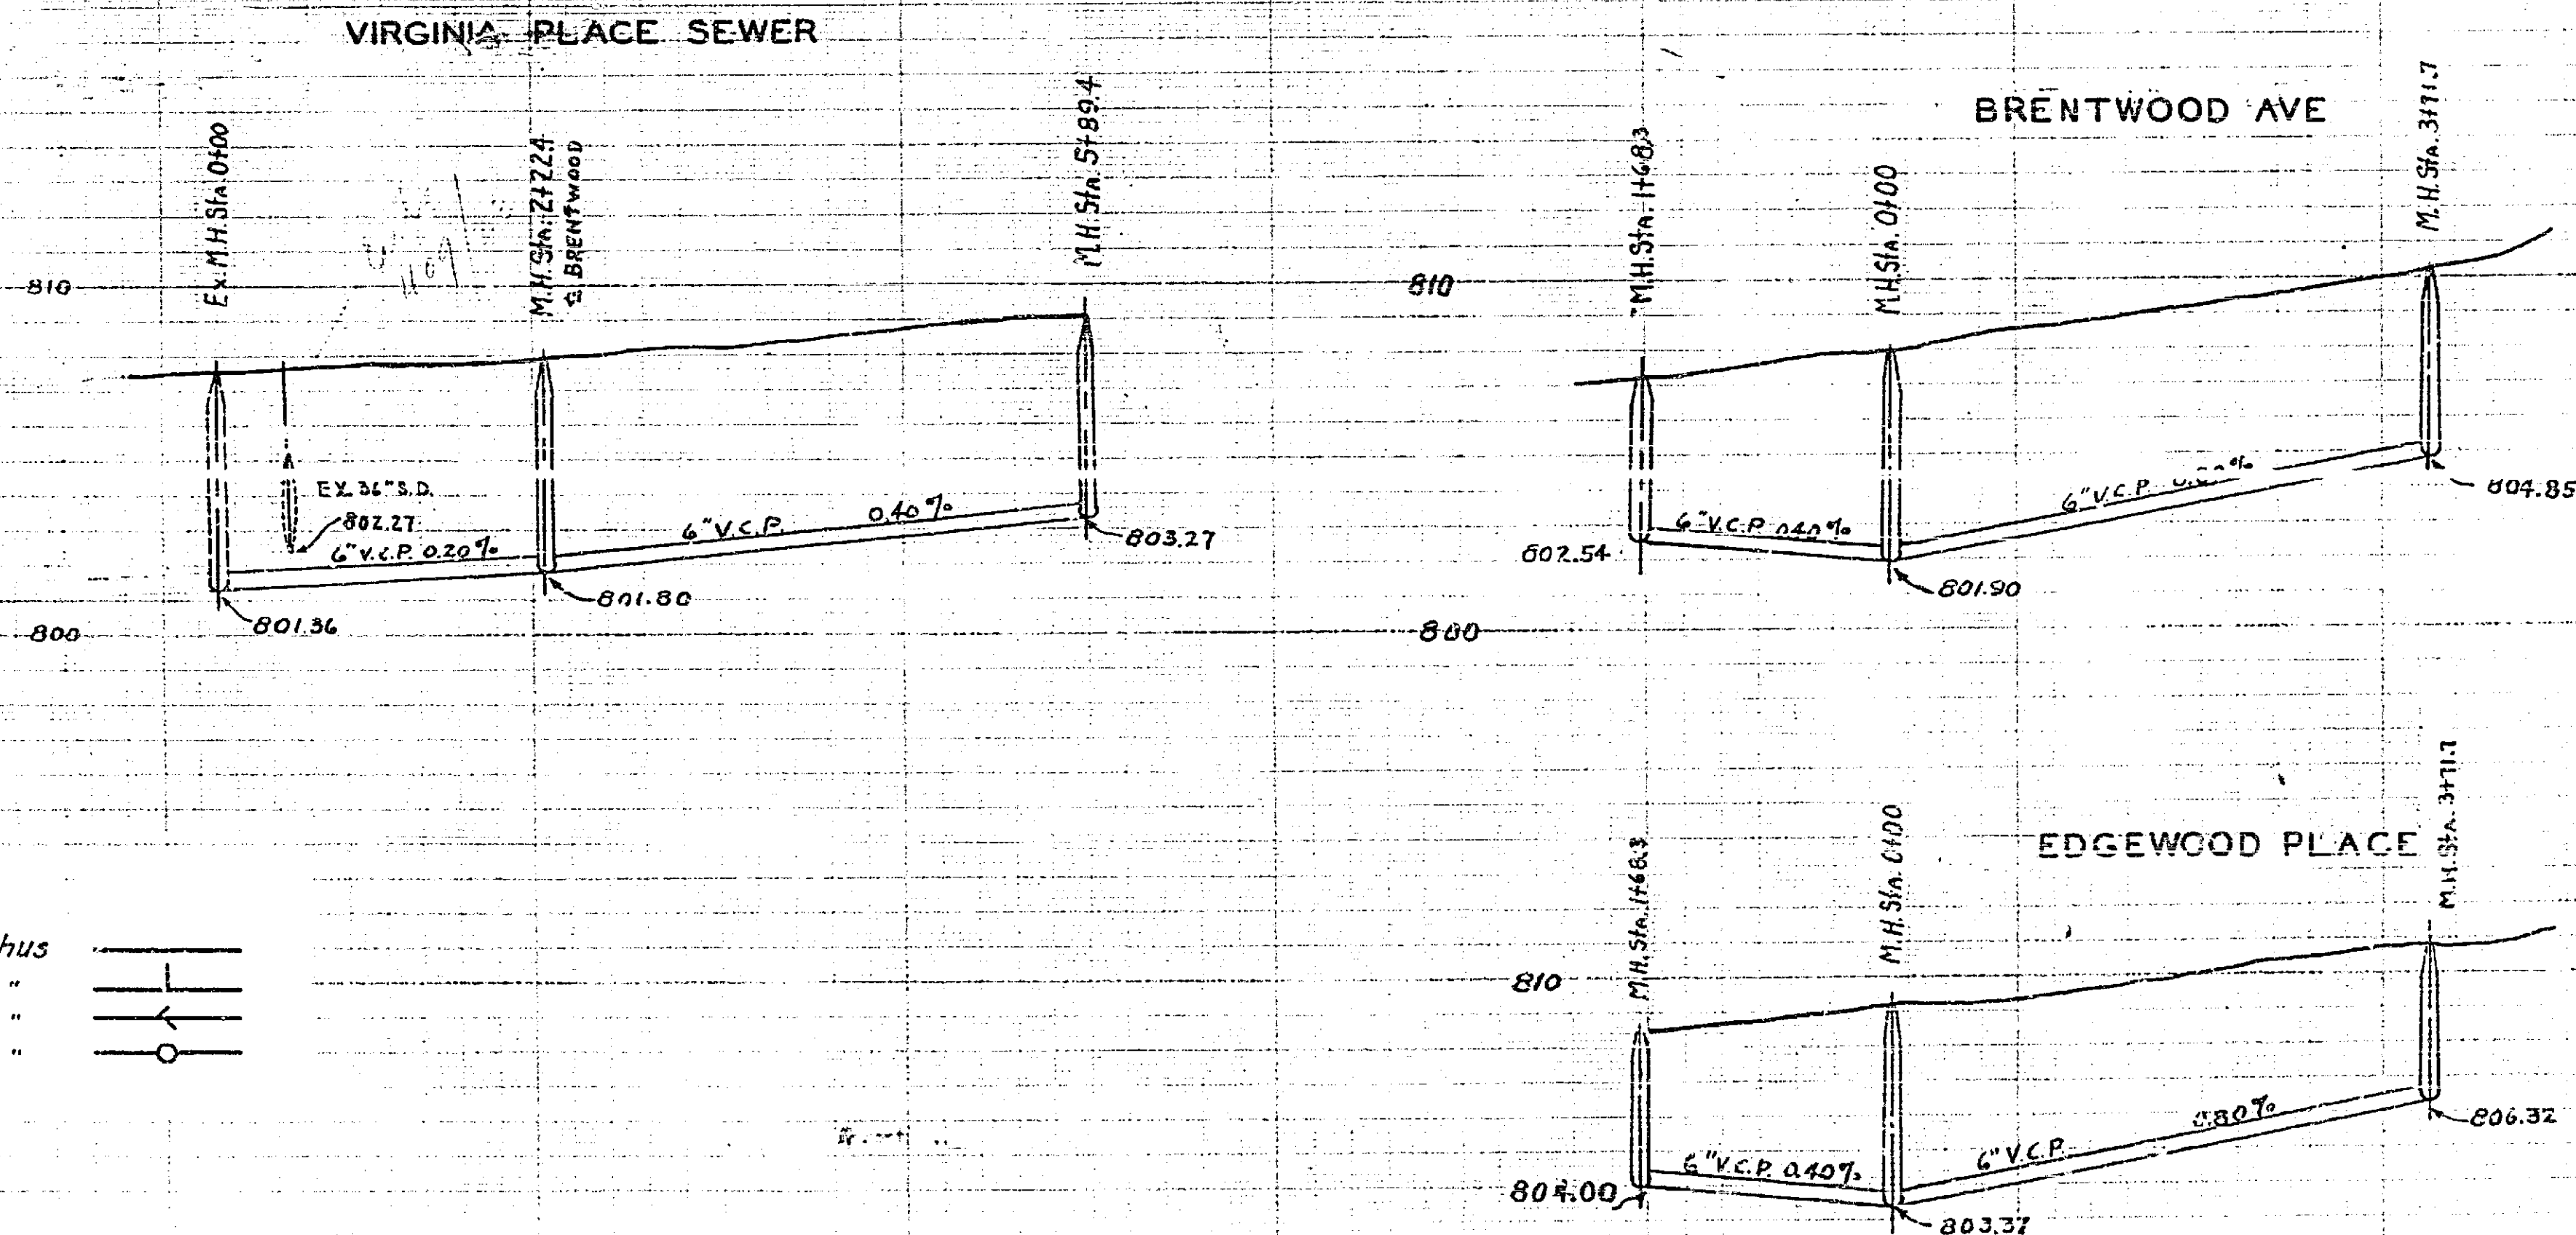

- QUANTITIES & LEGEND**
- 1669.40' - 6" V.C. Pipe
 - 276' - 6" V.C. Pipe House Connections
 - 54' - 6" x 6" Wye Branches
 - 6' - Standard Manholes
- shown thus
- 6" V.C. Pipe
 - 6" V.C. Pipe House Connections
 - 6" x 6" Wye Branches
 - Standard Manholes

588A