


PLAN No. 598-B
 FOR CURB & GUTTER ON
 ROCKLEDGE DRIVE
 BET. IVY HALLWOOD AVE.
 RIVERSIDE, CALIFORNIA
 APRIL 1955
 F.B. 567-48, 63
 597-28

APPROVED: *M.H. Irvine*
 M.H. IRVINE - Reg. C.E. No. 3011
 CITY ENGINEER

SCALE: HOR. 1" = 50'
 VER. 1" = 5'

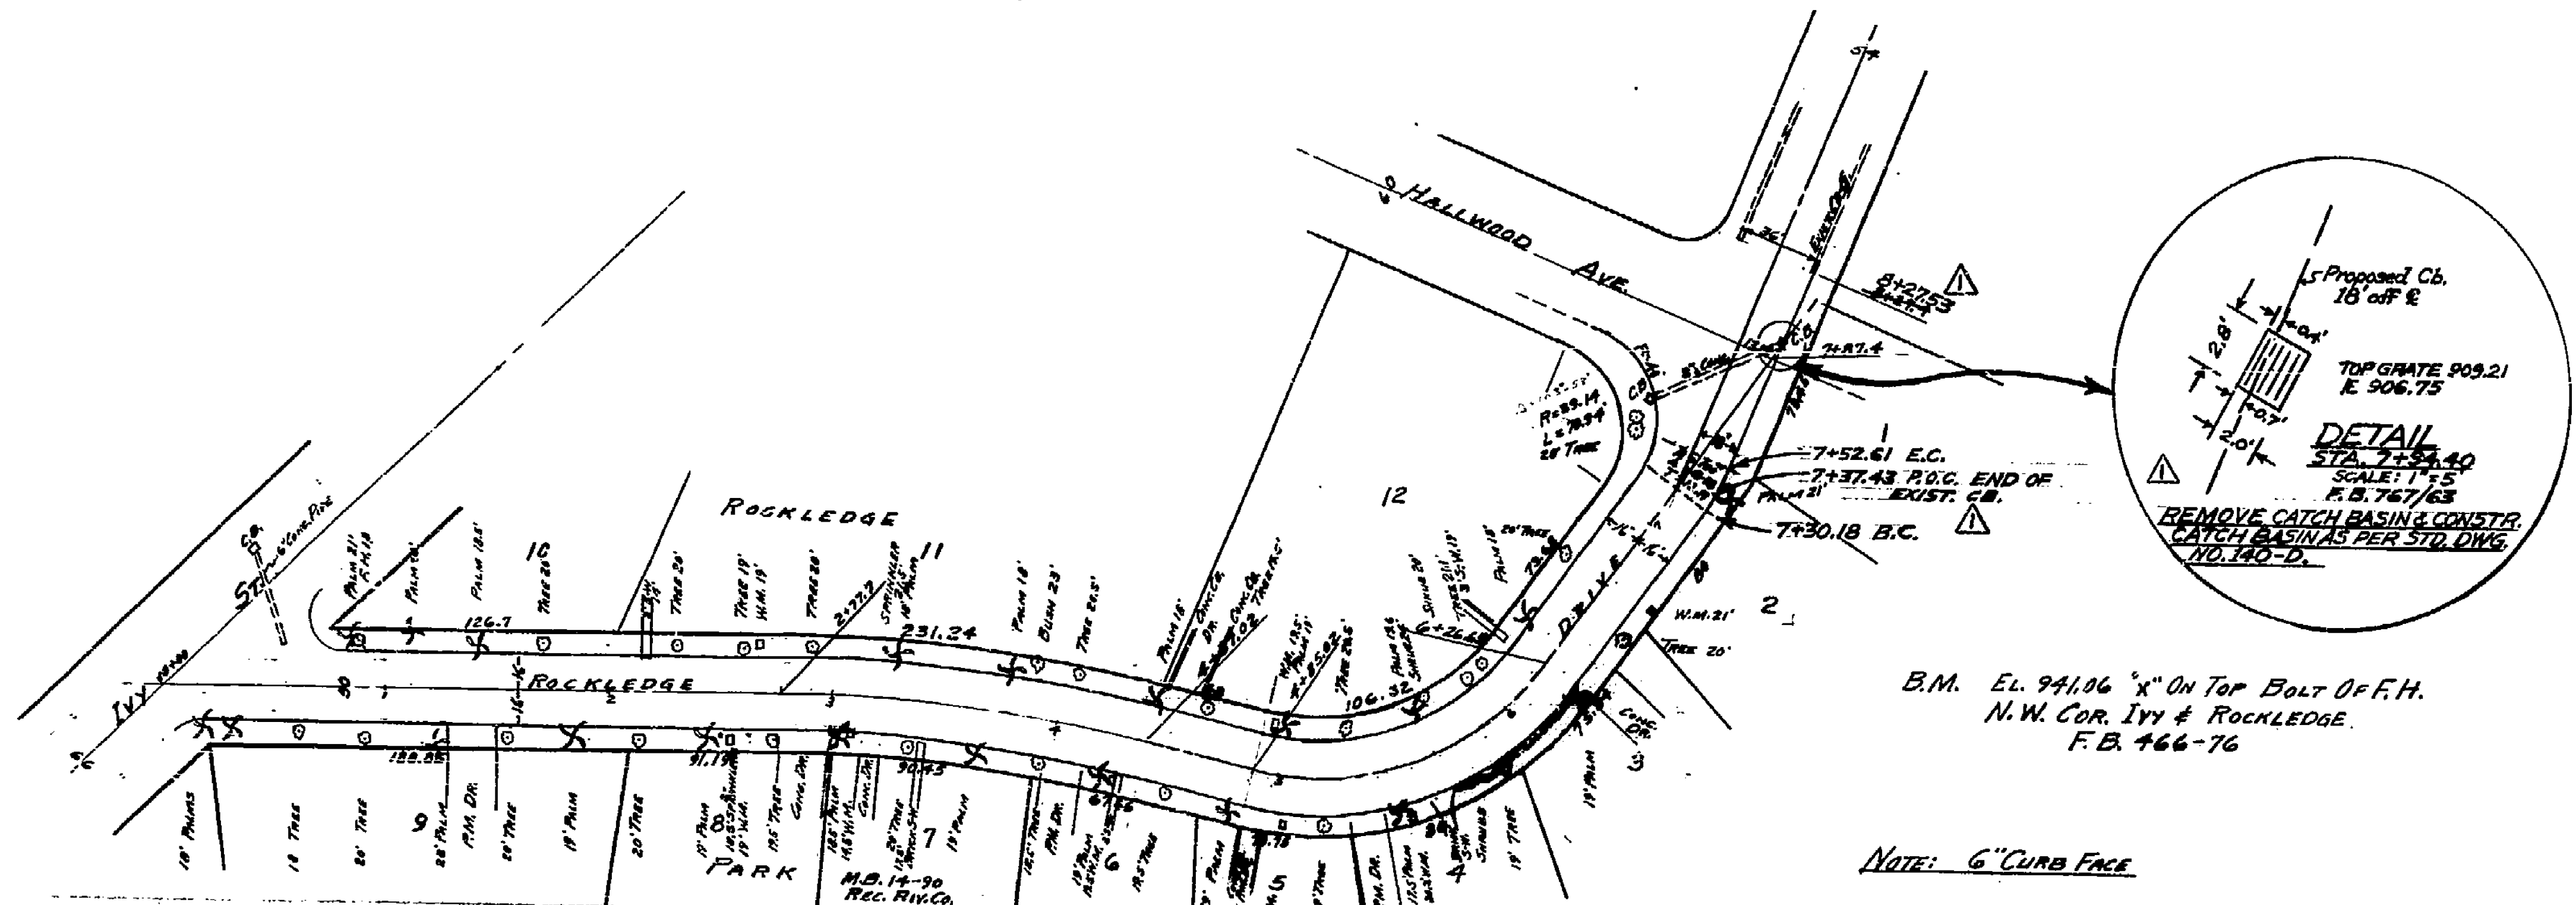


B.M. EL. 941.06 "X" ON TOP BOLT OF F.H.
 N.W. COR. IVY & ROCKLEDGE.
 F.B. 466-76

NOTE: 6" CURB FACE

REVISIONS		
MARK	DATE	DESCRIPTION
△	4-1-57 H.B.	DETAIL STA. 7+54.40 - STATIONING & PROFILE 7+30.18 - 7+8+27.52

DESIGNED BY: *H.B.* CHECKED BY: *H.H.*

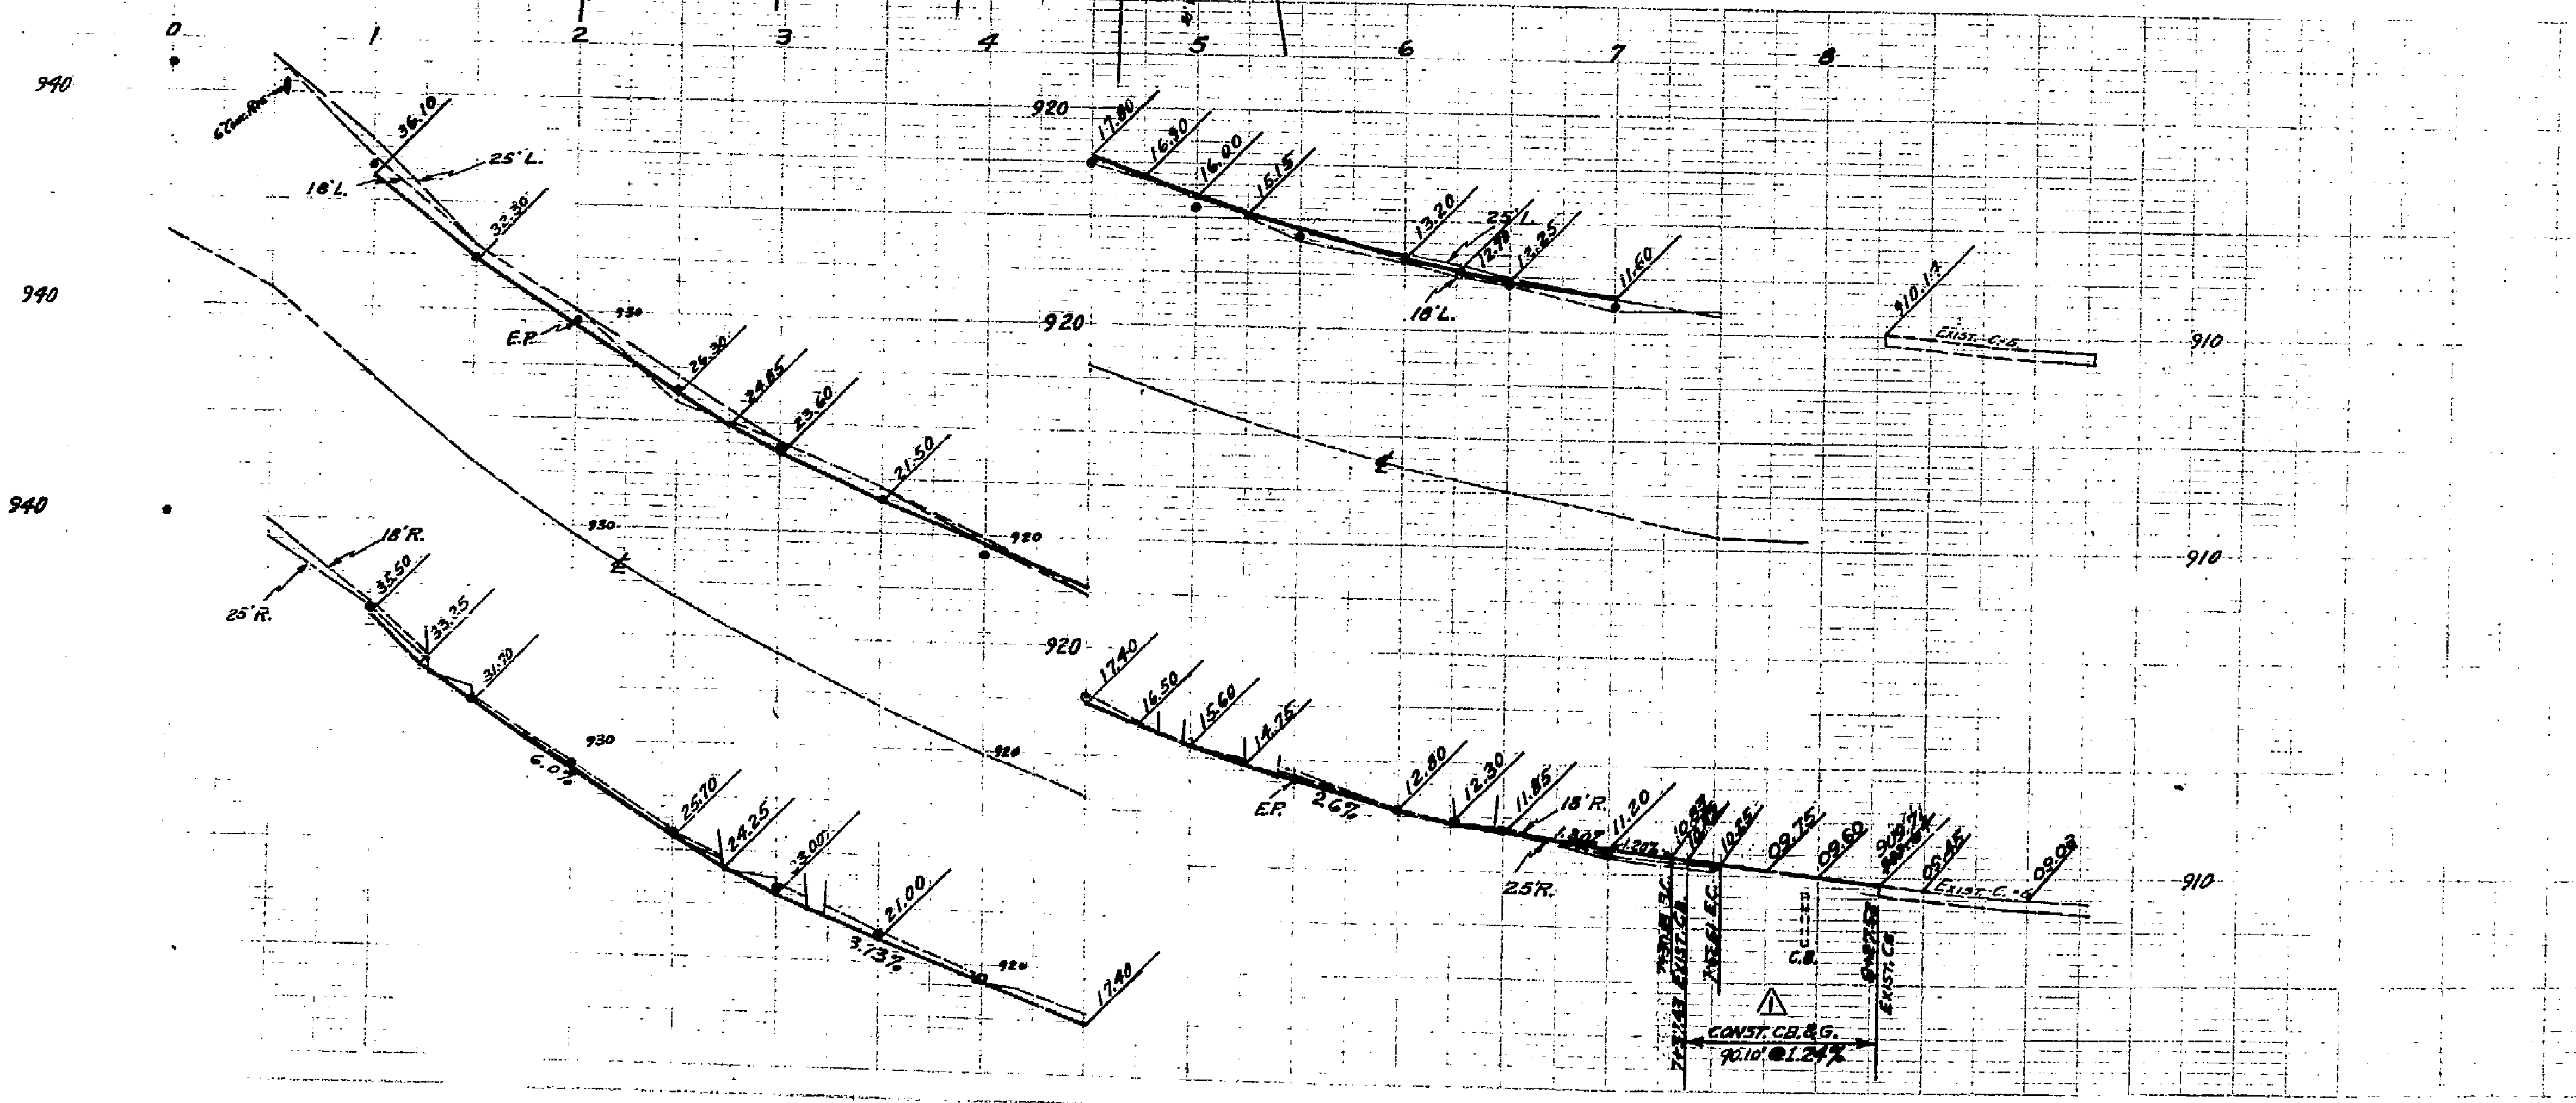

598B