
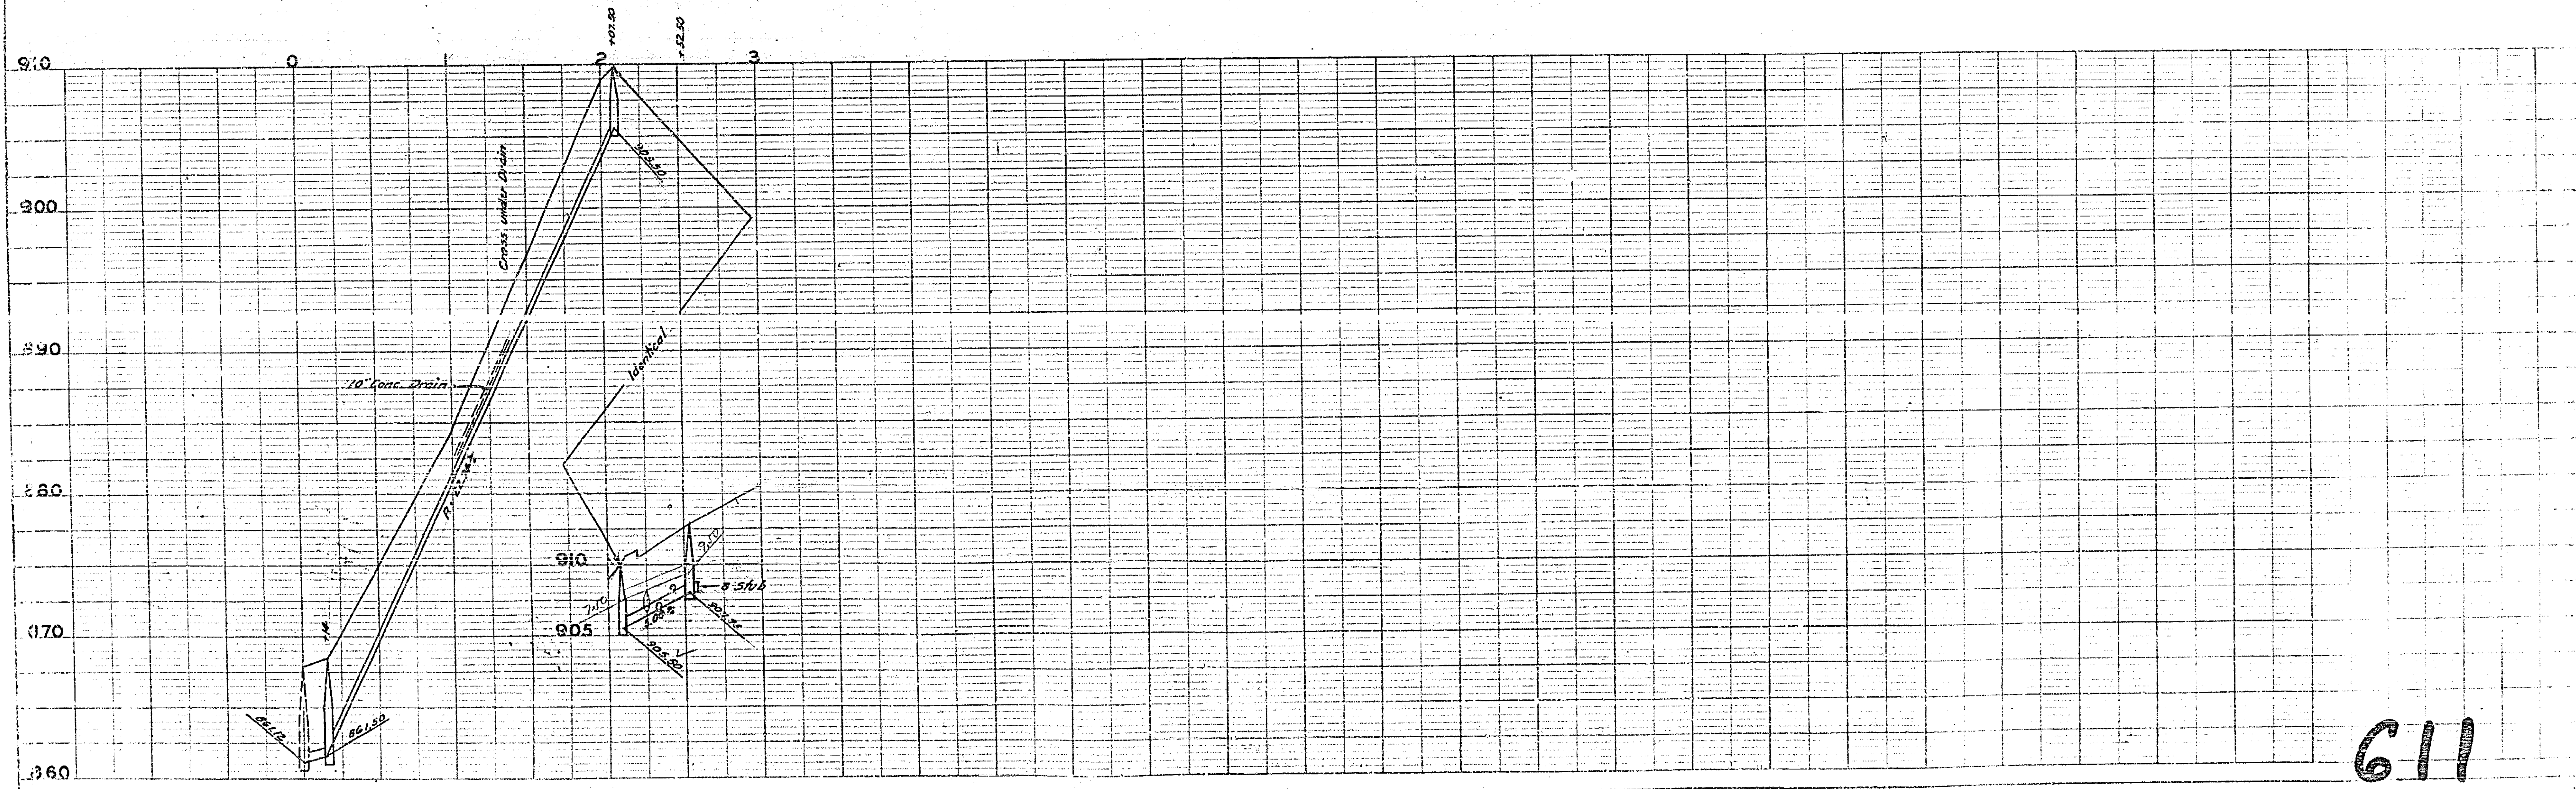


NO. 611  
 PLAN AND PROFILE  
 FOR THE CONSTRUCTION OF A  
 SANITARY SEWER  
 FOR  
 CARLTON PLACE  
 SANITARY SEWER DISTRICT

SCALES: HOR. 1 IN. = 50 FT.  
 VERT. 1 IN. = 5 FT.


F.B. 443-74  
 F.B. 544-46

APPROVED *M. H. Davis*  
 M. H. IRVINE - CITY ENGINEER  
 REG. C.E. NO. 3011

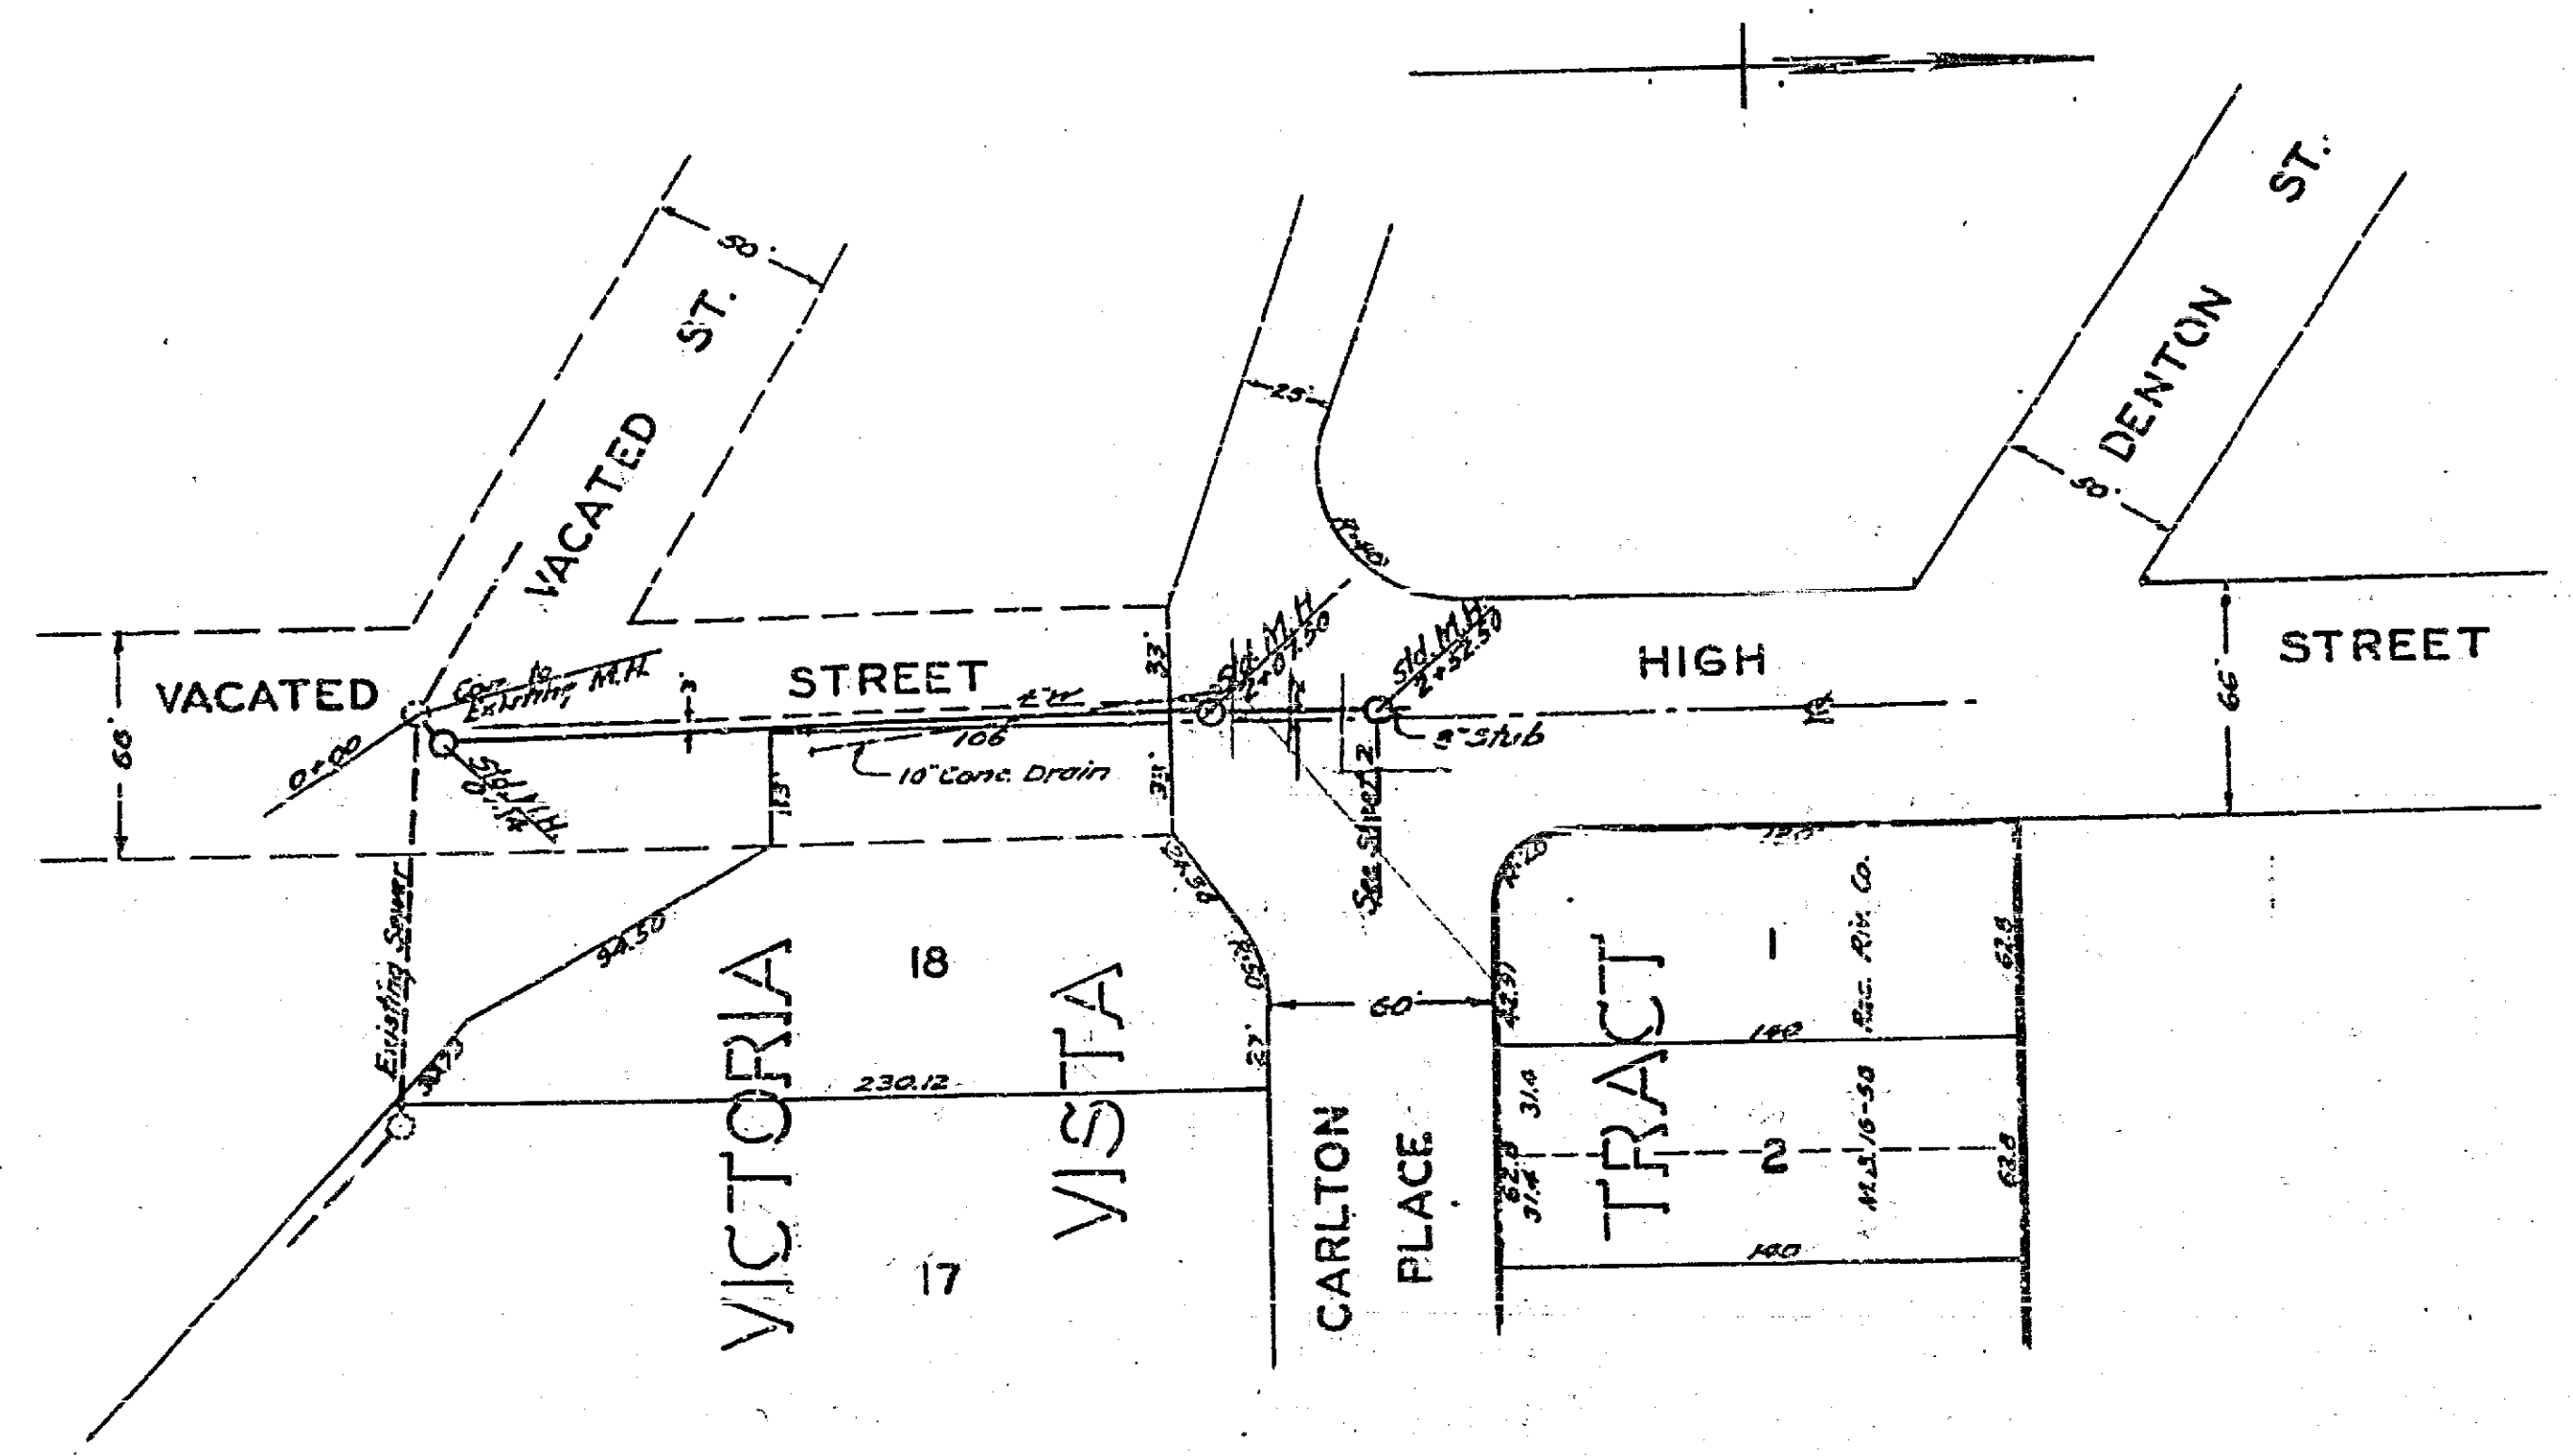


611

PLAN	DATE
PLAT	
FILE NO.	
PLAT NO.	
FILE NO.	
PLAT NO.	
FILE NO.	
PLAT NO.	
FILE NO.	
PLAT NO.	
FILE NO.	

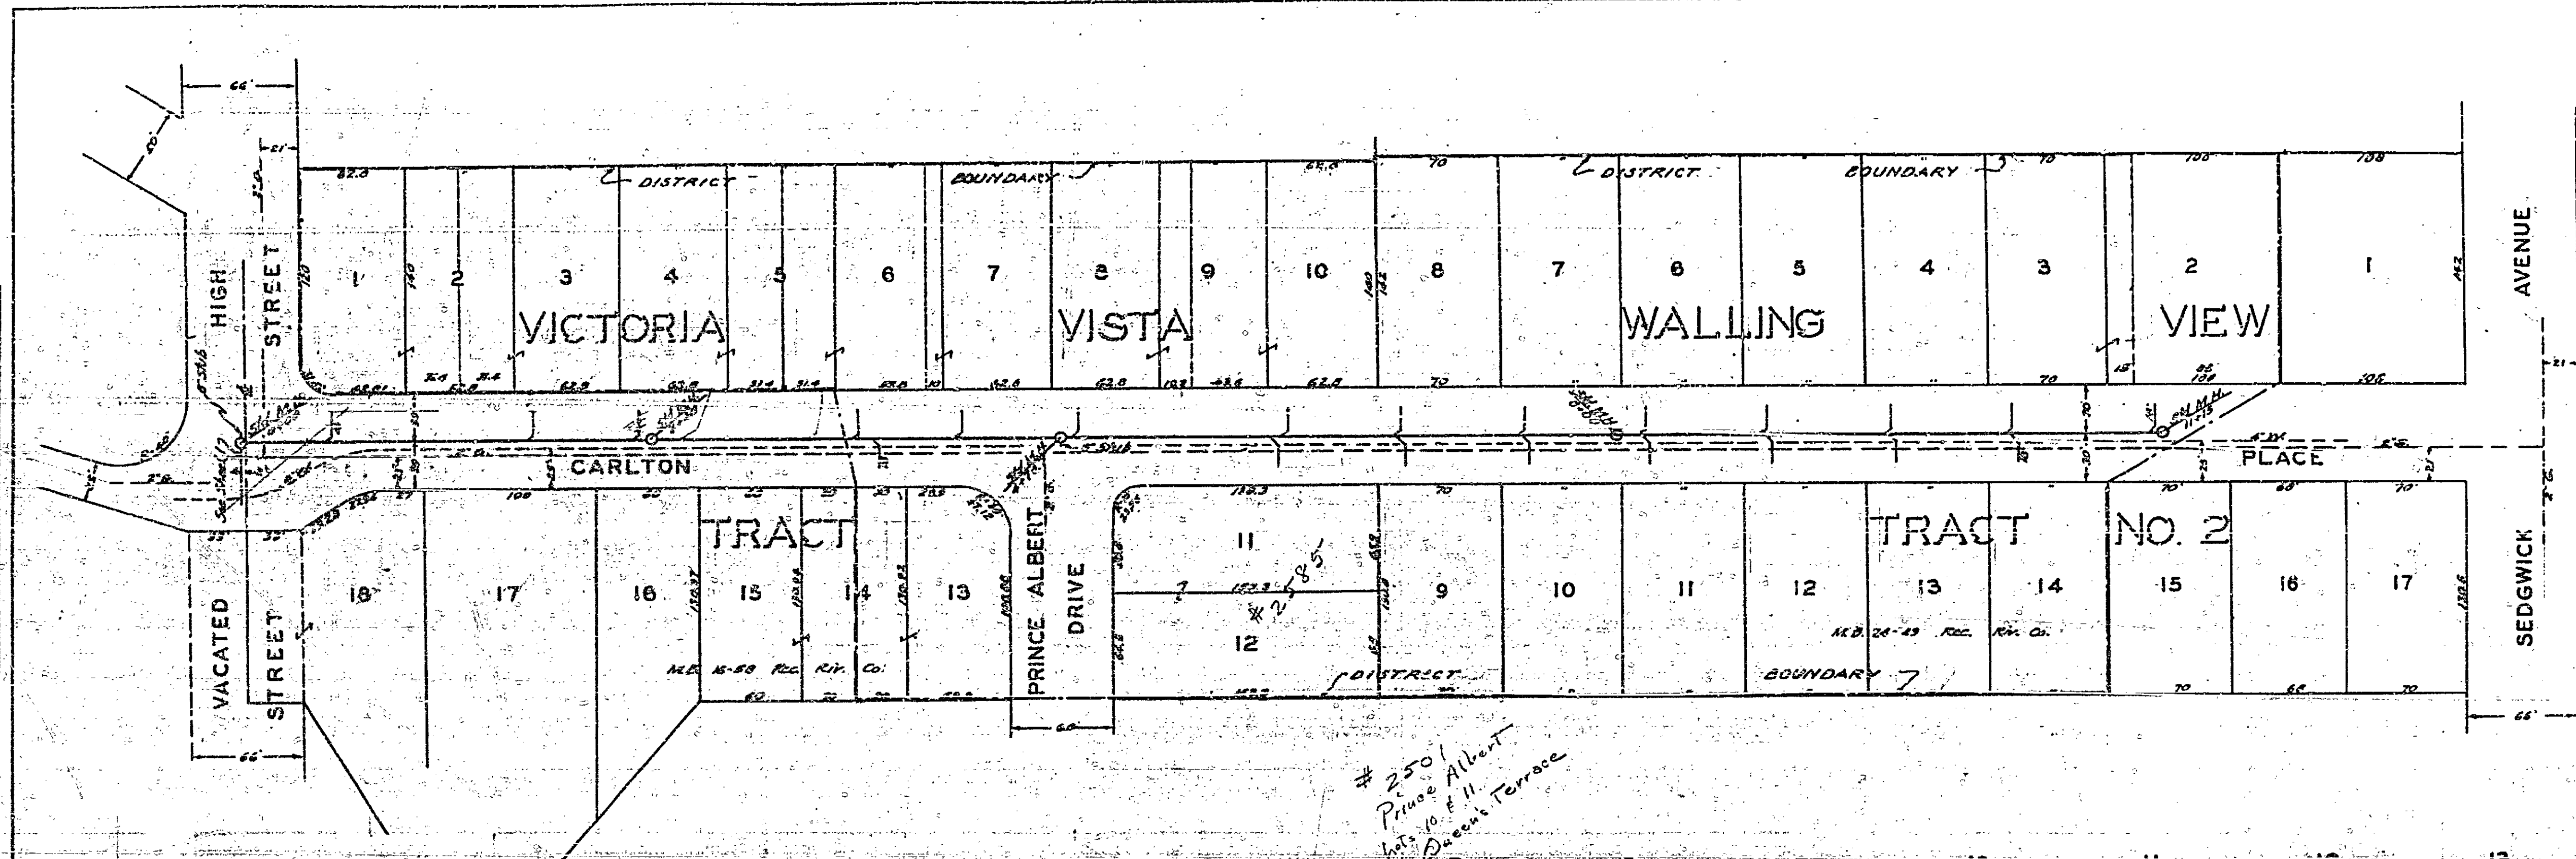

# 2501  
Prince Albert  
lots 10 & 11  
Queen's Terrace

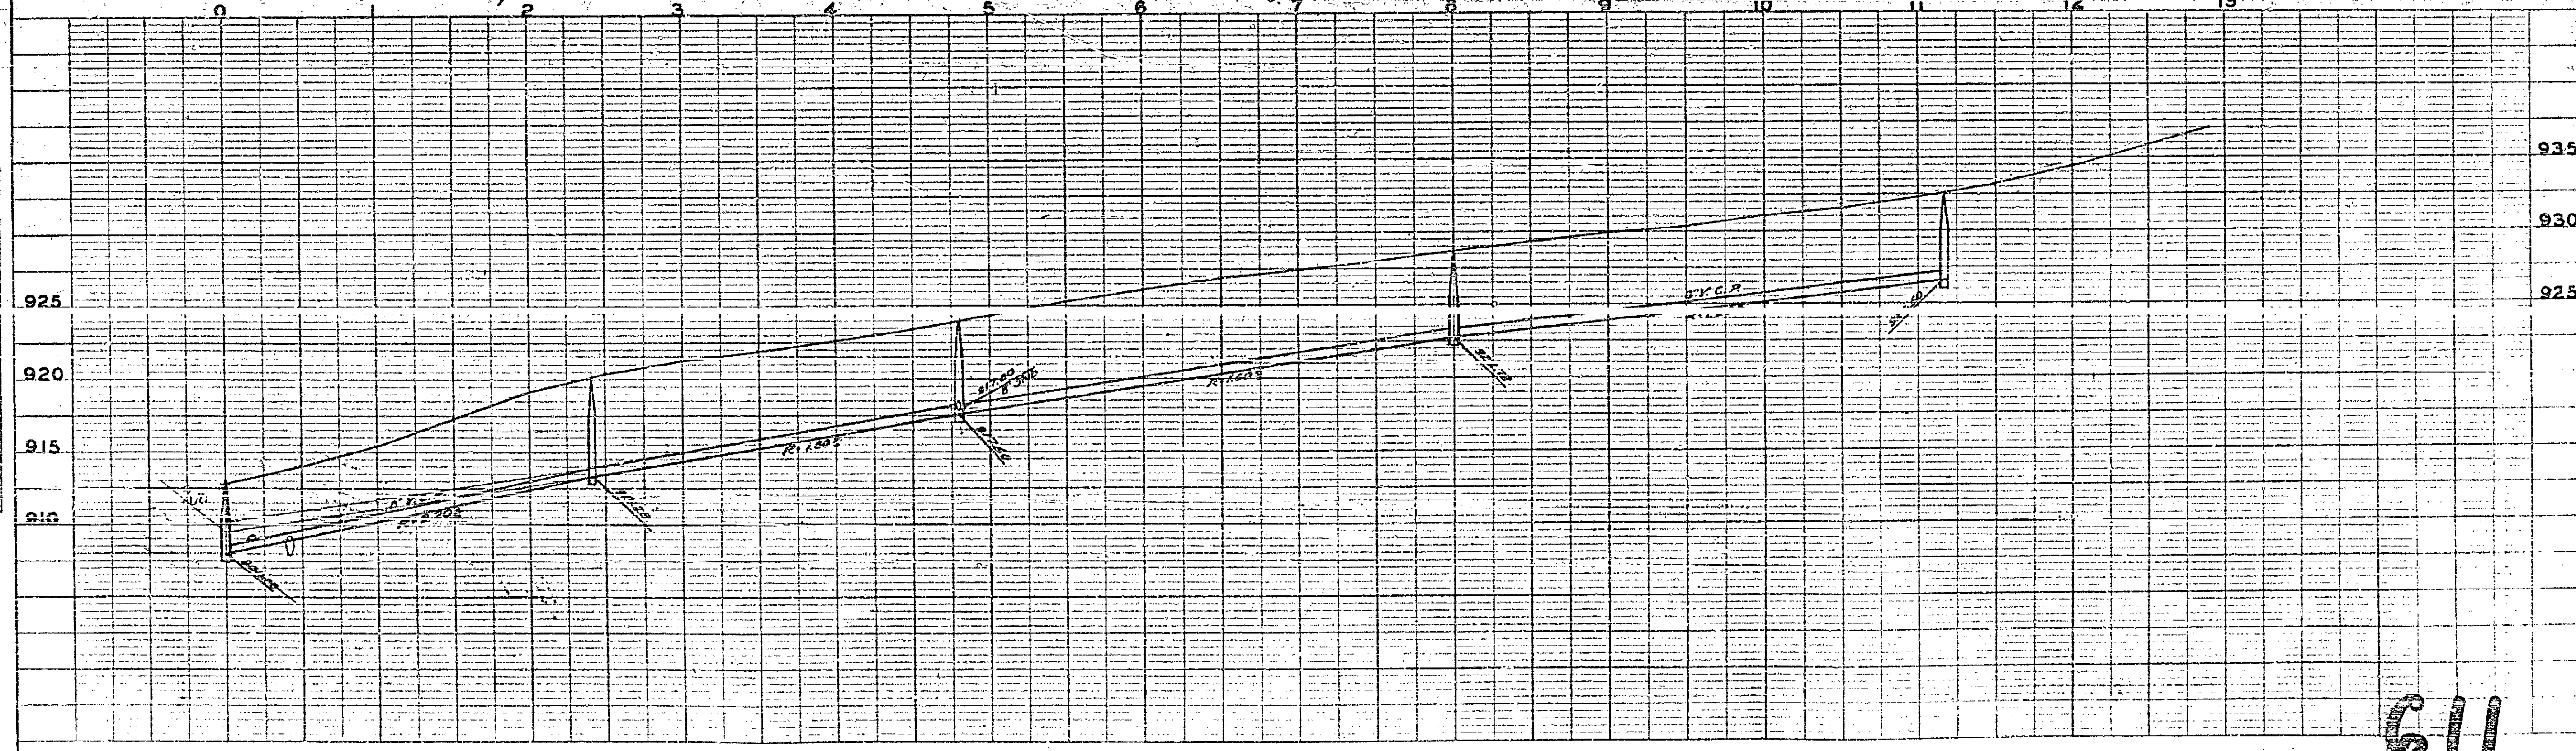

611