

ASSESSMENT NO. 388

DIAGRAM

EXHIBITING CARLTON PLACE SANITARY SEWER DISTRICT

IN THE CITY OF RIVERSIDE ON WHICH WORK HAS BEEN DONE UNDER THE OFFICIAL CONTRACT OF THE SUPERINTENDENT OF STREETS OF SAID CITY WITH HENRY B. STEVENS DATED JUNE 23, 1954

FOR THE CONSTRUCTION OF SANITARY SEWER MANHOLES WYE BRANCHES & HOUSE

CONNECTIONS AS IS MORE PARTICULARLY DESCRIBED IN SAID CONTRACT TO WHICH REFERENCE IS HEREBY MADE FOR FURTHER PARTICULARS; SAID DIAGRAM ALSO SHOWS THE RELATIVE LOCATION OF EACH LOT PORTION OF LOT PIECE OR PARCEL OF LAND ASSESSED FOR THE WORK DONE NUMBERED IN CIRCLES TO CORRESPOND TO THE RED INK NUMBERS IN THE ASSESSMENT

HEREIN FIGURES NEXT TO PROPERTY LINES SHOW LENGTH OF SAID LINES IN FEET. THE MARK (') MEANS FEET. PROPERTY LINES THAT DIFFER FROM THE RECORDED SUBDIVISIONS ARE SHOWN BY BROKEN LINES. THE DISTRICT BENEFITED IS BOUNDARY COVERED BY THIS ASSESSMENT IS SHOWN ON THE FOLLOWING RECORDED MAPS:

VICTORIA VISTA TRACT, RECORDED IN M.B. 16, PG. 58, REC. RIV. CO.  
WALLING VIEW TRACT NO. 2, RECORDED IN M.B. 24, PG. 49, REC. RIV. CO.

HEREIN THE LEGEND OF THE DIFFERENT KINDS OF WORK PERFORMED IS SHOWN AS FOLLOWS:

- SANITARY SEWER      - - - - -
- STD. MANHOLE        - - O - - -
- WYE BRANCH         - - T - - -
- HOUSE CONNECTION - - L - - -

CITY ENGINEER OF THE CITY OF RIVERSIDE  
THE FOLLOWING IS A STATEMENT OF AMOUNTS OF DIFFERENT KINDS OF WORK DONE BY HENRY B. STEVENS UNDER CONTRACT DATED JUNE 23, 1954 PURSUANT TO RESOLUTION OF INTENTION NO. 3147 ADOPTED BY THE CITY COUNCIL OF THE CITY OF RIVERSIDE ON THE 6TH DAY OF APRIL 1954

8" VITRIFIED CLAY PIPE SEWER	1376.35 LIN. FT.
4" " " " HOUSE CONNECTIONS	414.00 LIN. FT.
8" x 4" VITRIFIED CLAY WYE BRANCHES	23
STANDARD MANHOLES	7

AT SAID CITY OF RIVERSIDE THIS 11 DAY OF AUGUST 1954

CITY ENGINEER  
OF THE CITY OF RIVERSIDE

I HEREBY CERTIFY THAT THE ABOVE WORK WAS DONE IN ACCORDANCE WITH LINES AND GRADES FURNISHED BY ME AND THAT THE DIAGRAM OF THE ASSESSMENT DISTRICT FOR THE SAME IS CORRECT.

CITY ENGINEER  
OF THE CITY OF RIVERSIDE

RECORDED AT 9:15 O'CLOCK A.M.  
THIS 22 DAY OF SEPTEMBER 1954

SUPERINTENDENT OF STREETS  
OF THE CITY OF RIVERSIDE

CLERK

See Sheet No 80

HIGH

Validated by Resolution No 1155 B.S

See Sheet No 72

CASTLEMAN'S

49

M.B. 3/19, REG. S.B. CO.

ADDITION

50

See Sheet No 71

SEDGWICK

VICTORIA

GOLF

PRINCE

ALBERT

DRIVE

TERRACE

LINKS

47

See Sheet No 78

STREET DIST. BDRY

DISTRICT BOUNDARY

CARLTON

VICTORIA WISTA

QUEEN'S BOUNDARY


PLACE

BOUNDARY

AVENUE

Scale 1:500

See Sheet No 67

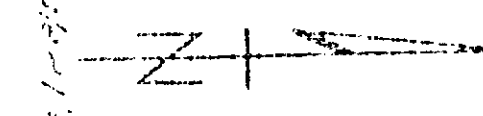

611-B

70