



618

# LOCATION OF SEWER CROSSING U.P. R.R. IN THE CITY OF RIVERSIDE

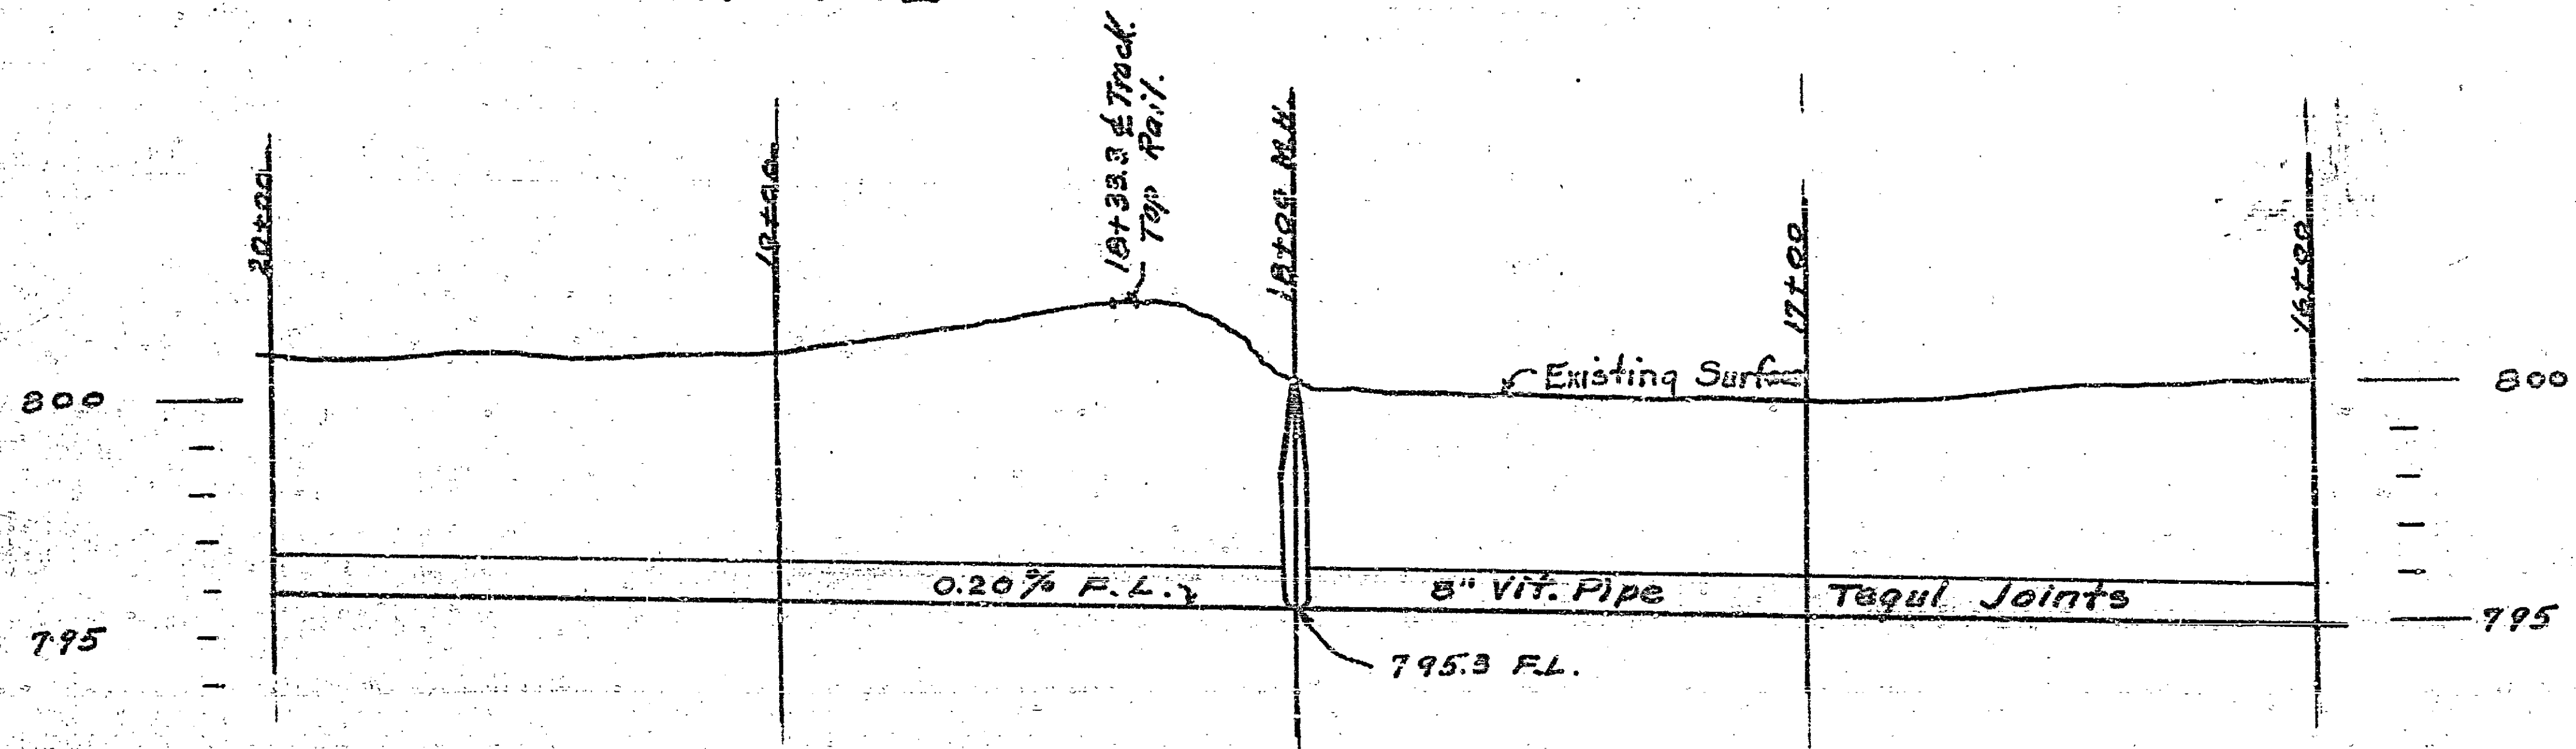

PROFILE: SCALE HOR. 1" = 40'  
VER. 1" = 4'

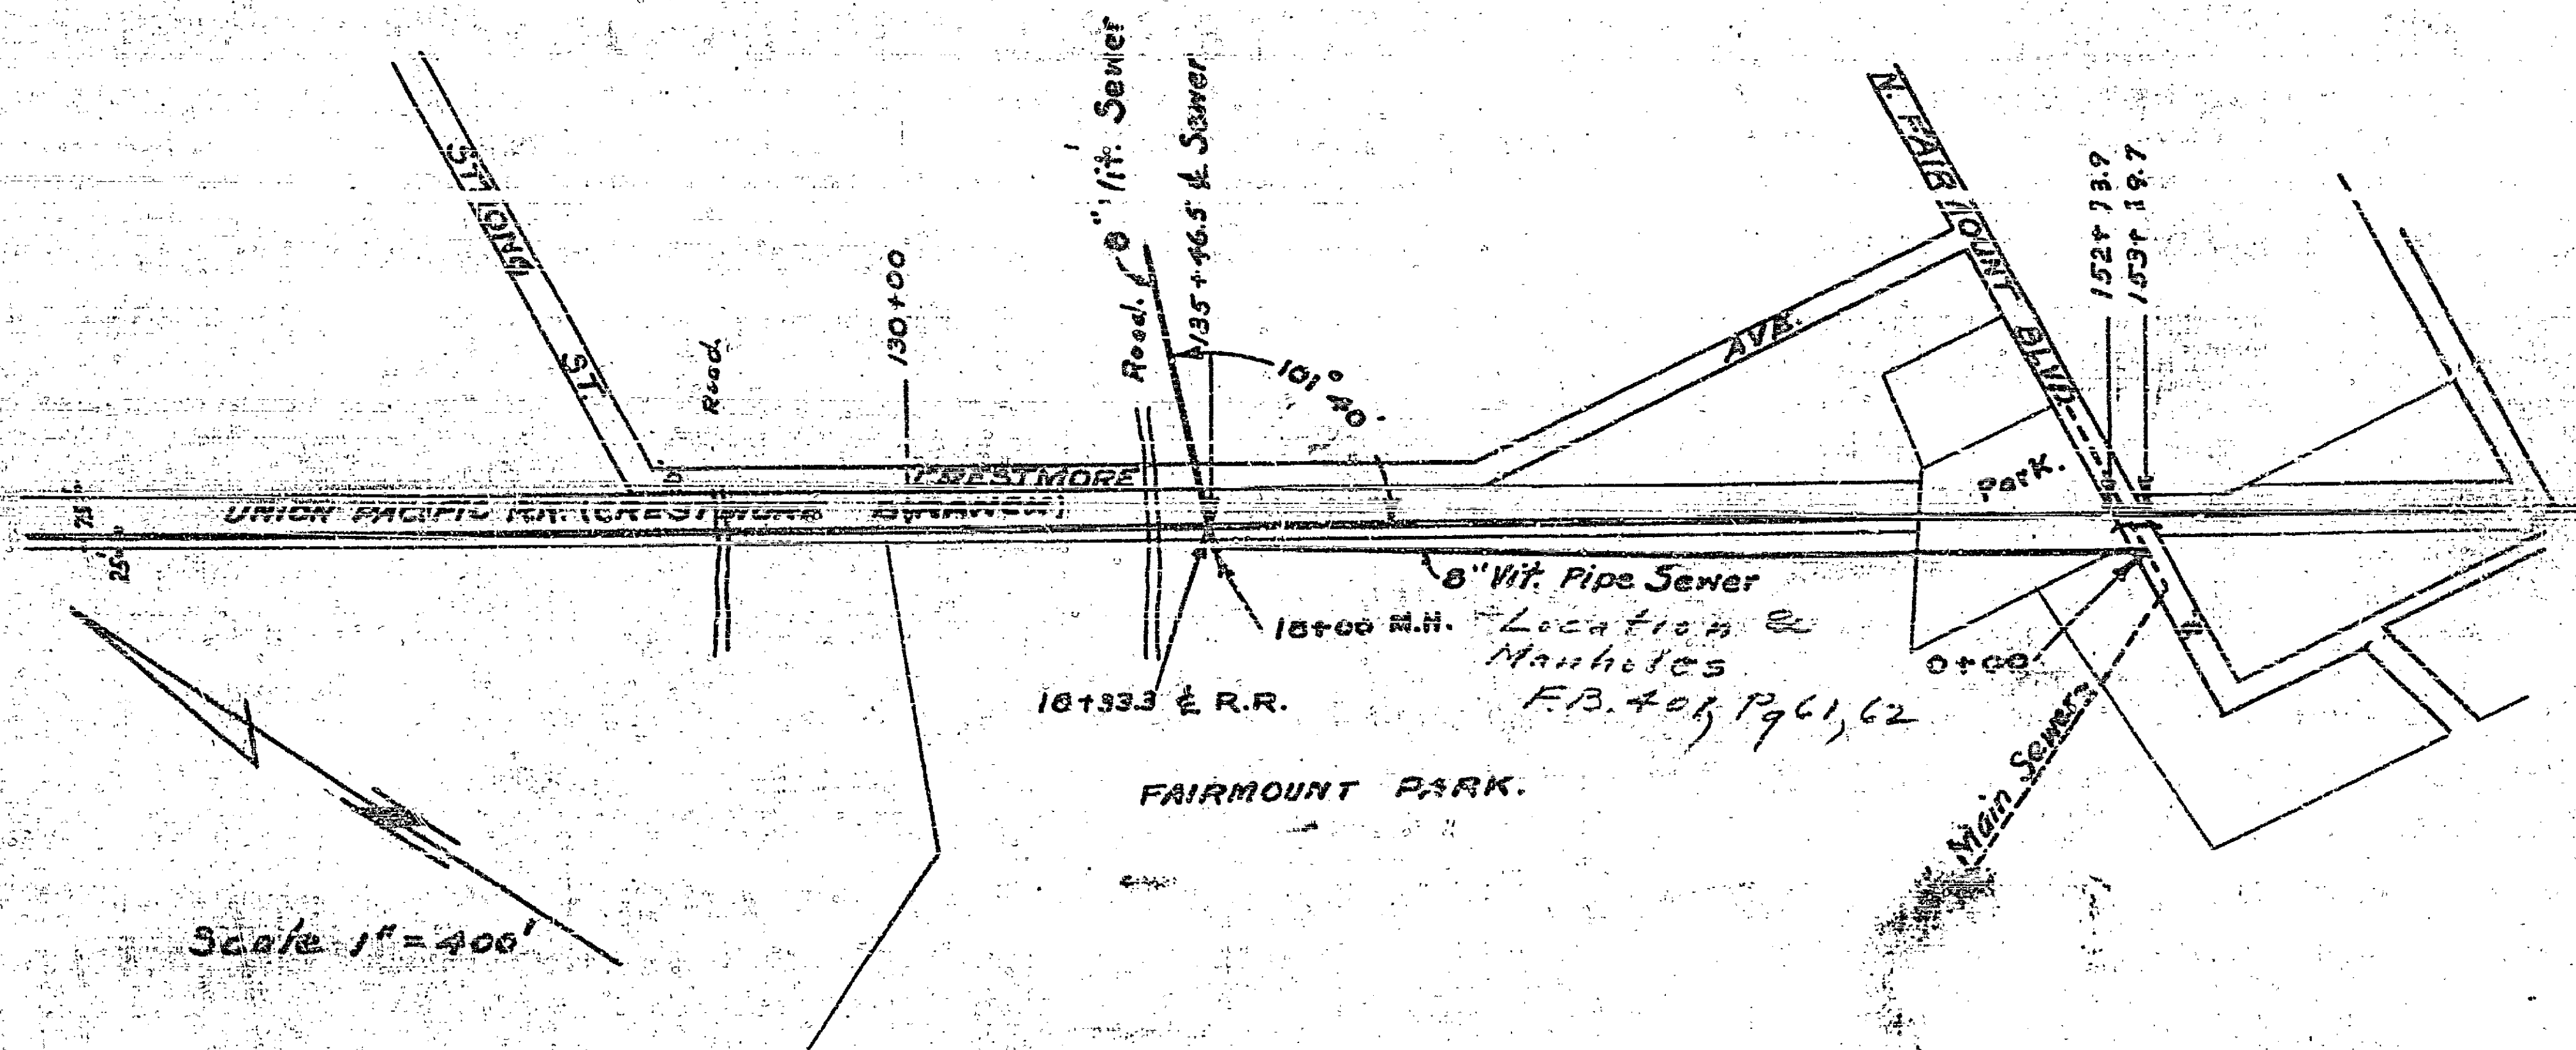

Scale 1" = 400'

618