


46/589 C.C. 1945

19197 C.C. 172.5 (20' x 43' 10")
Extension of sewer

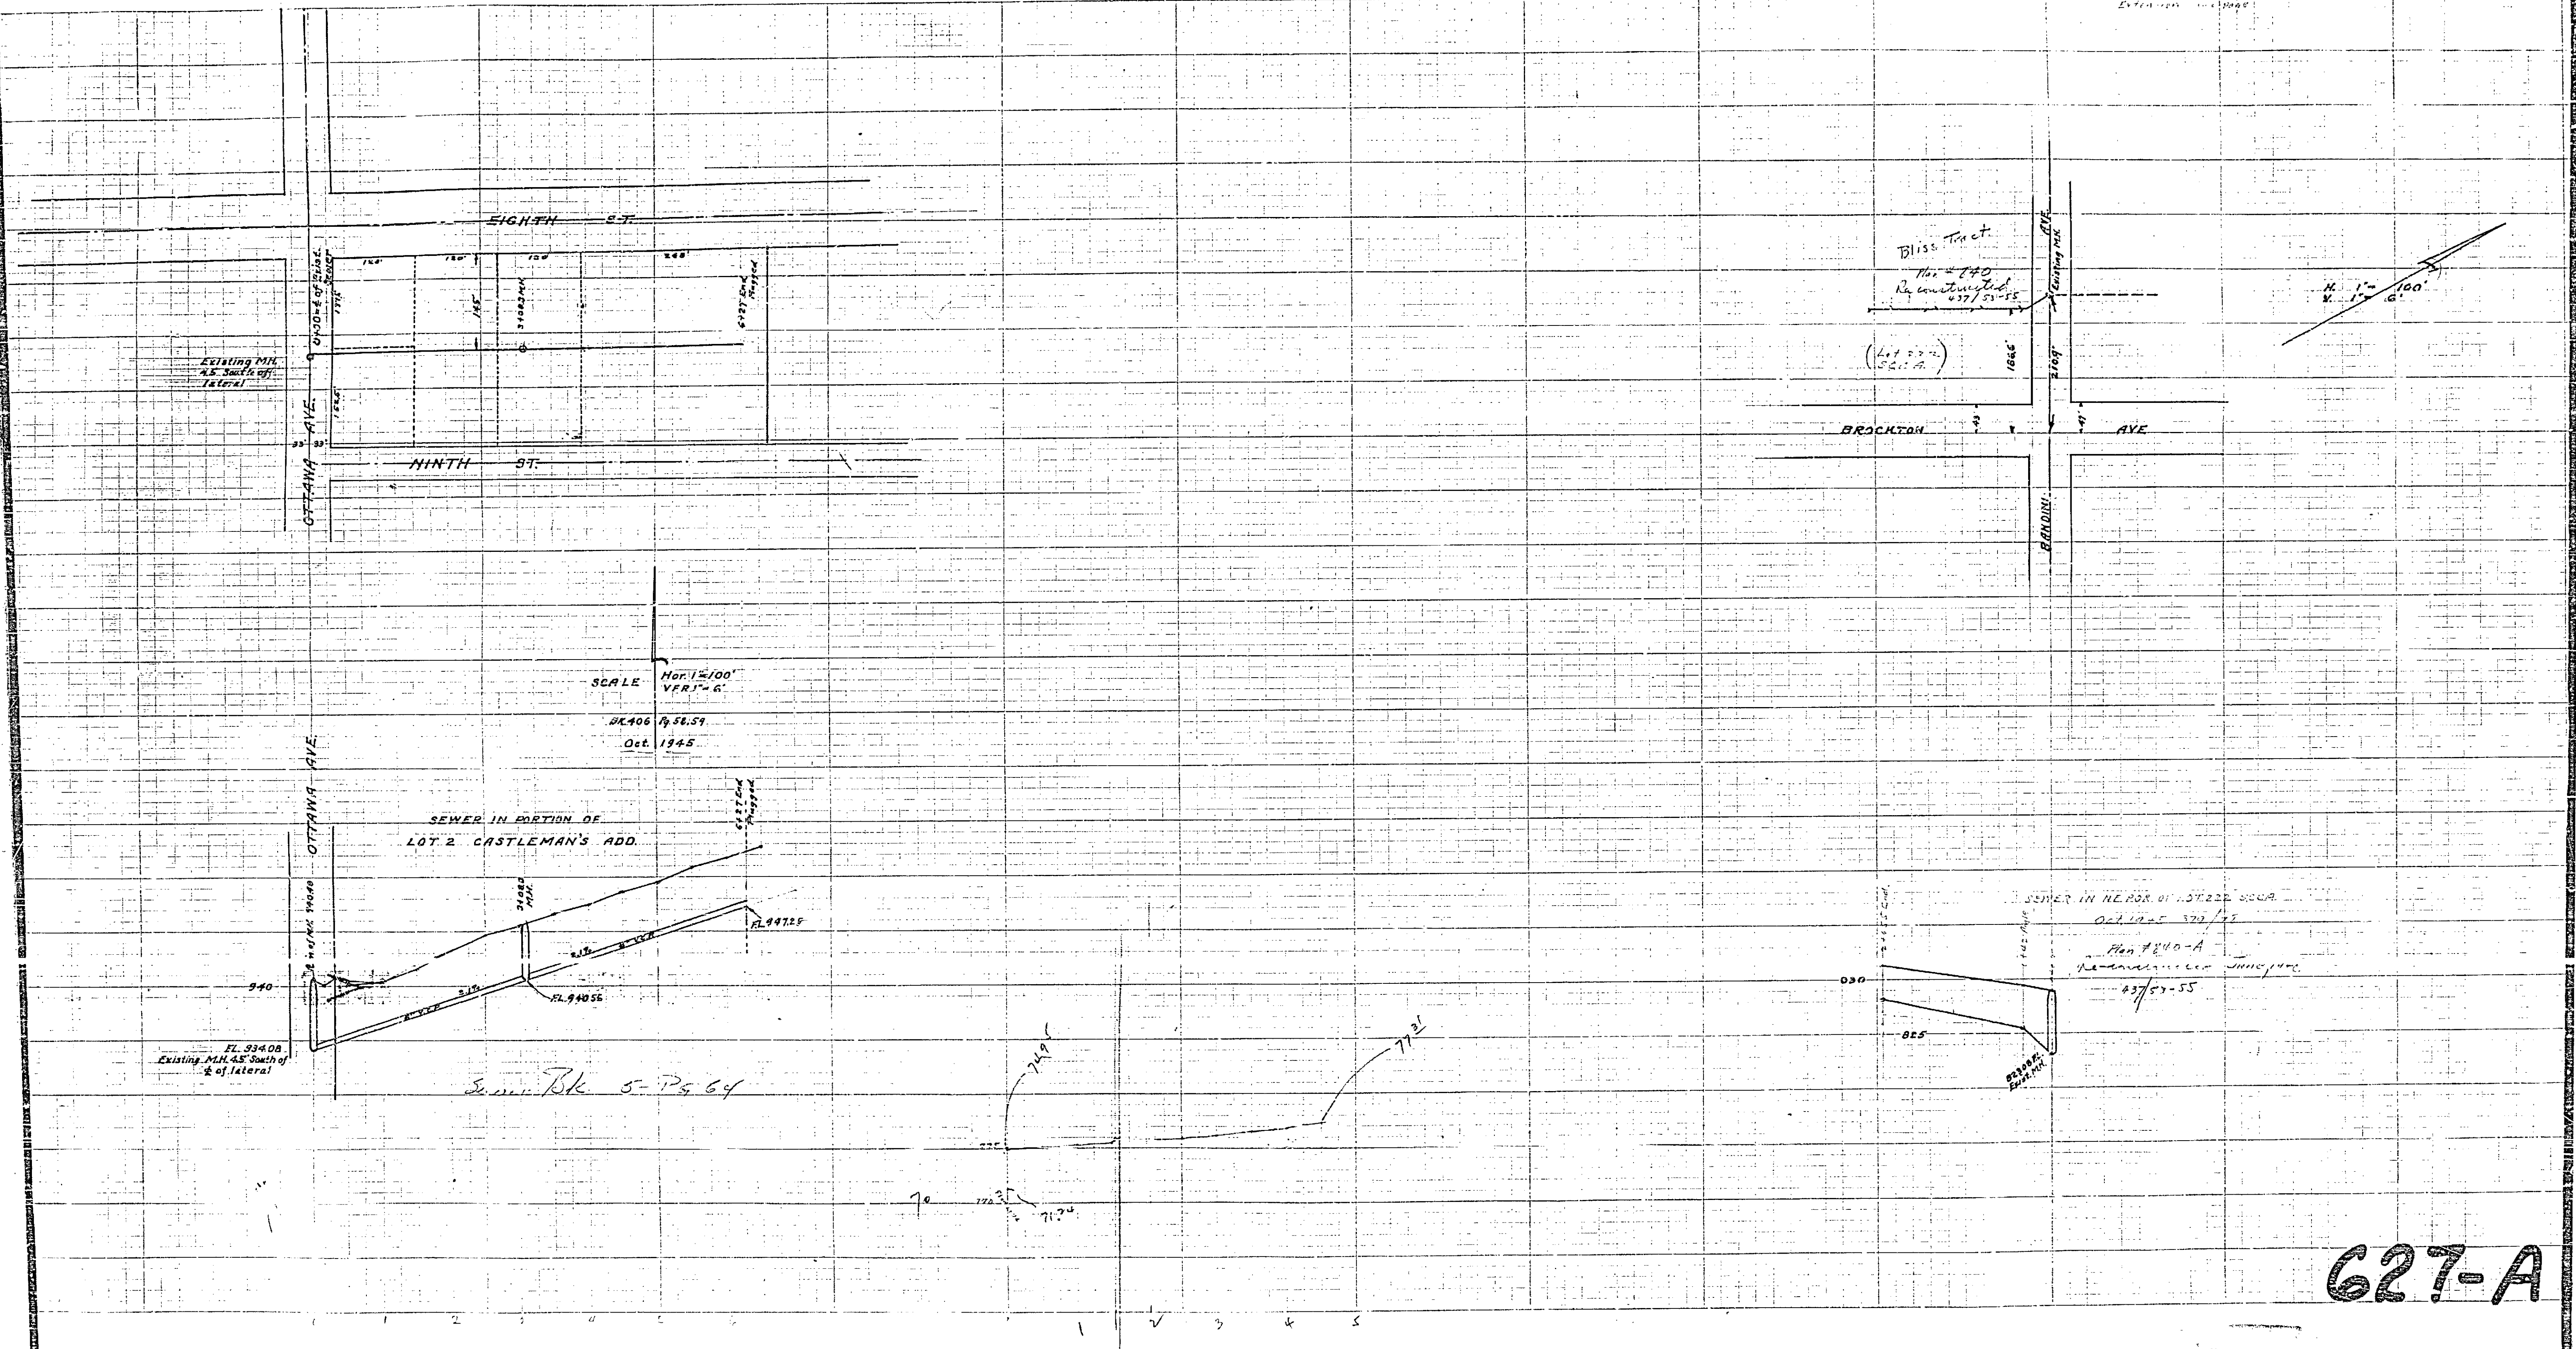

627-A