


BASEMENT FLOOR PLAN

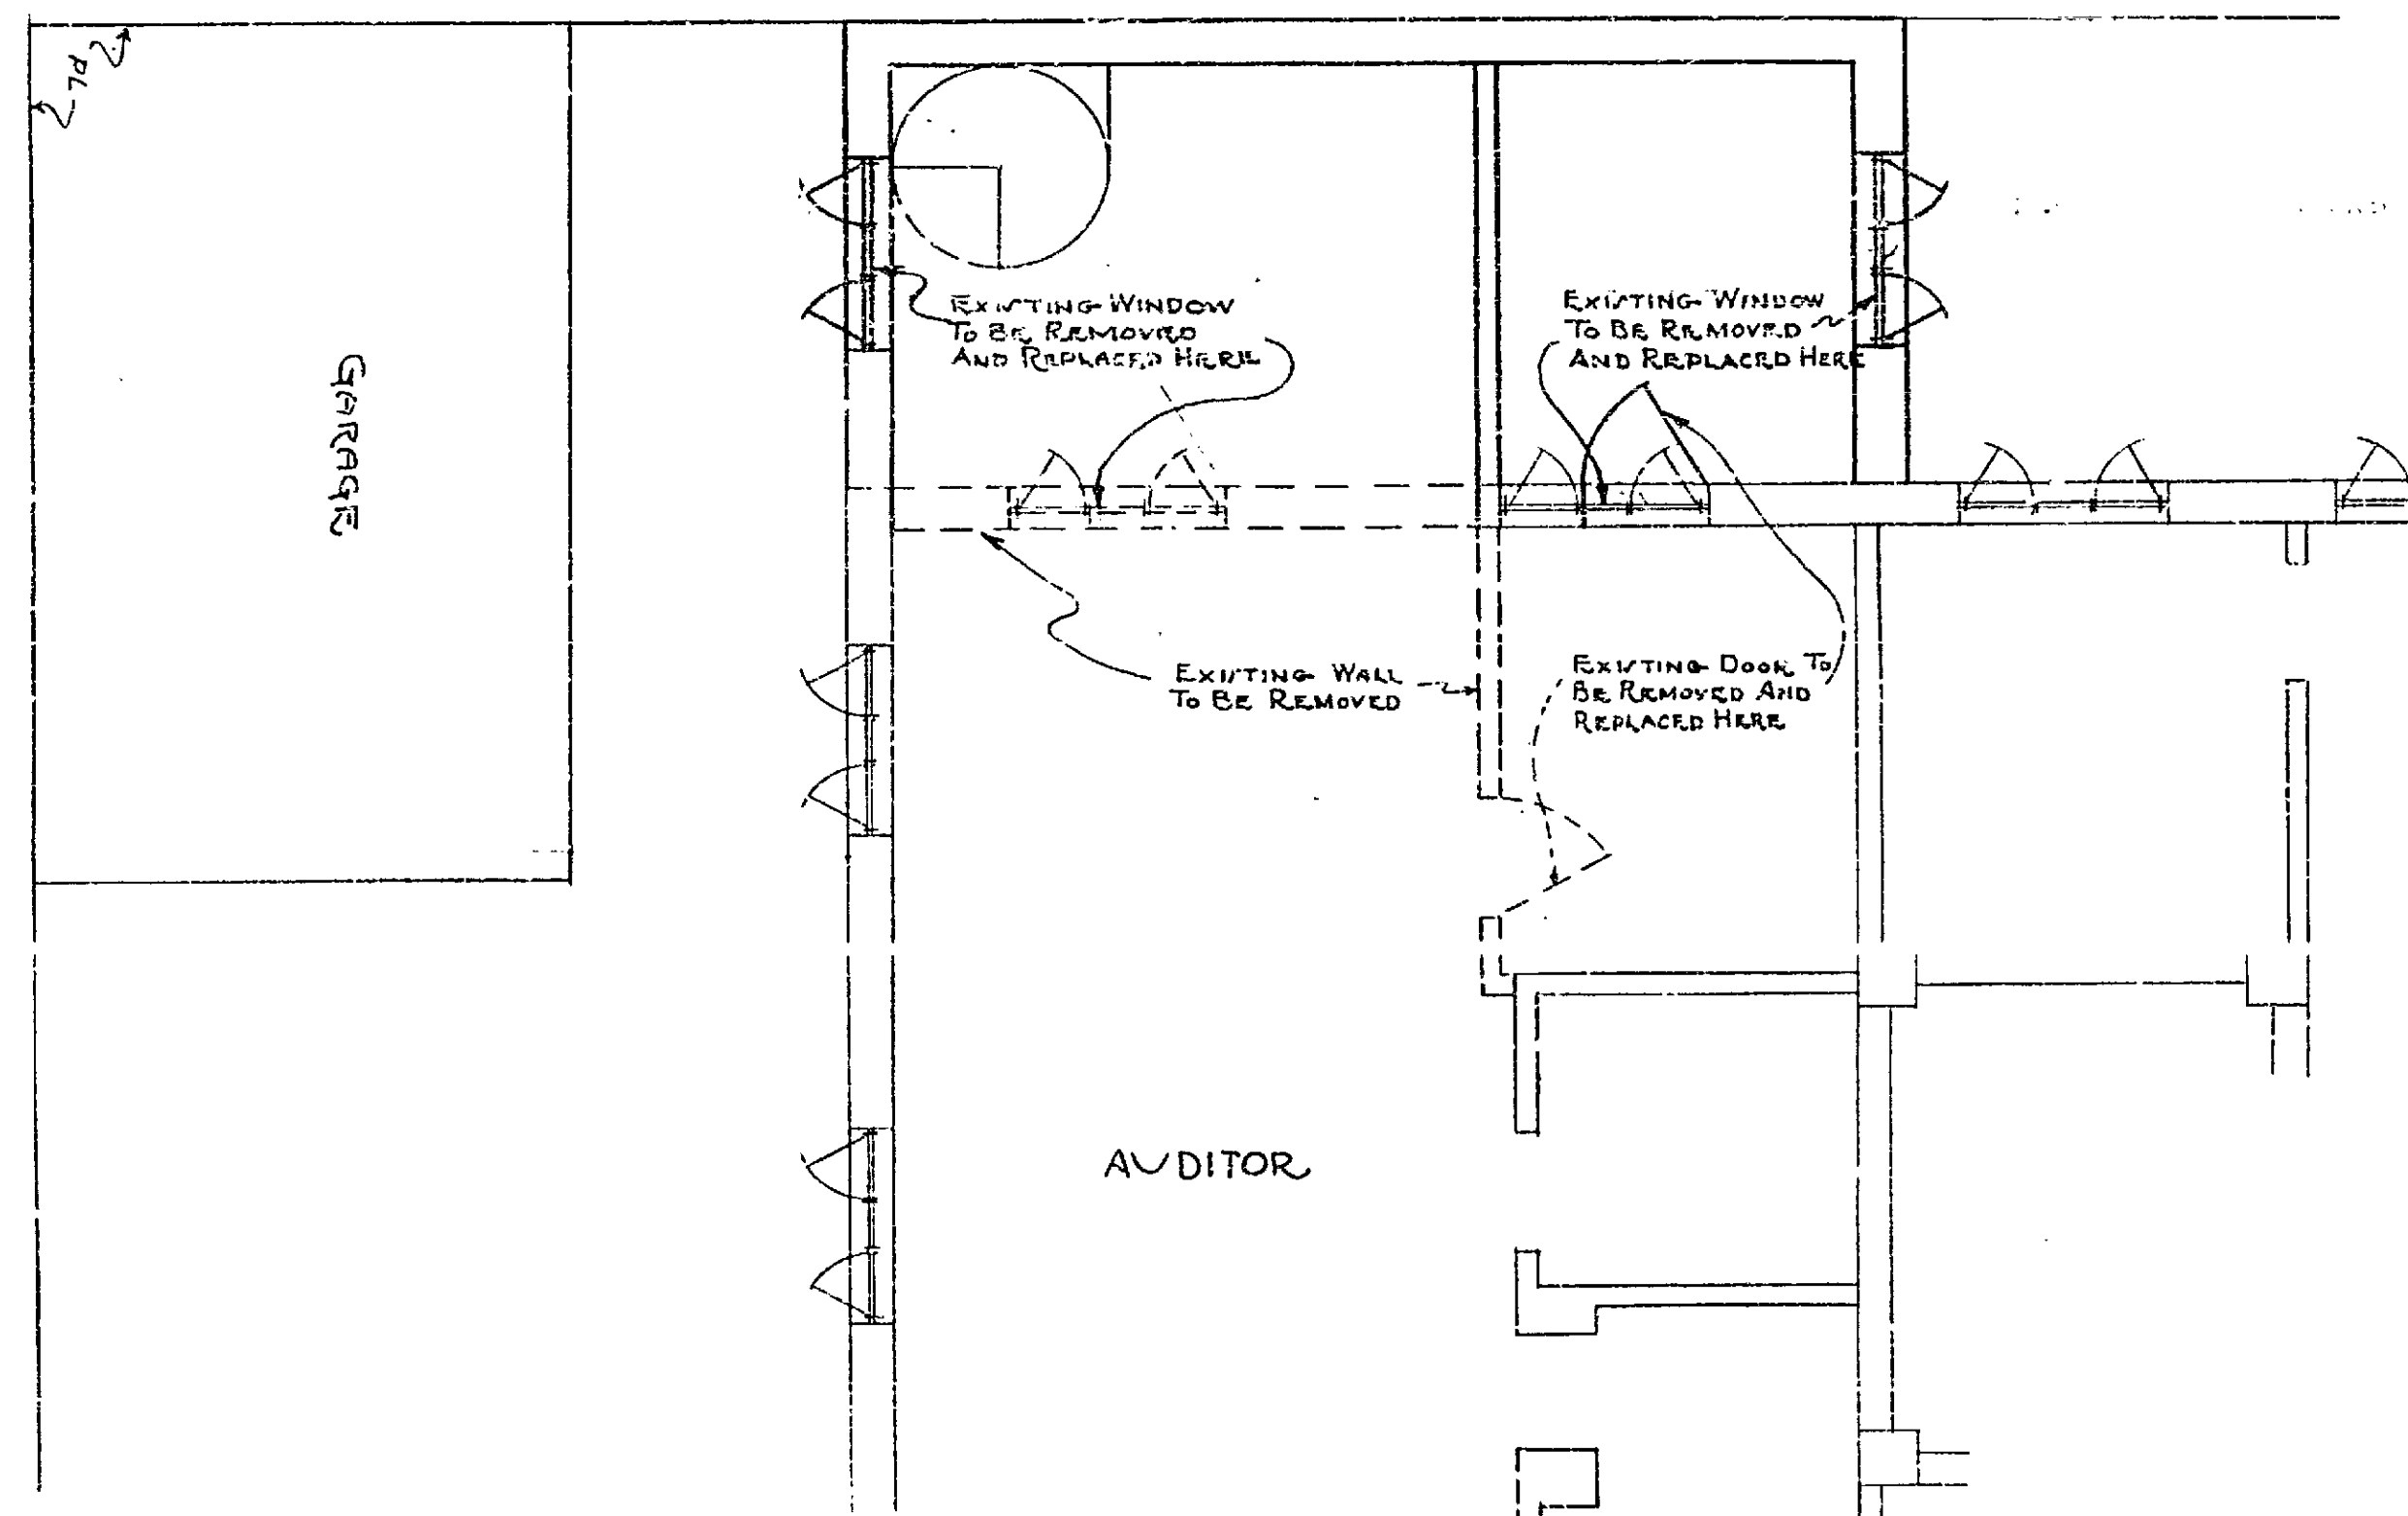

1ST FLOOR PLAN

628-C

scale 1/4\"/>