

# DIAGRAM

## EXHIBITING TROBRIDGE AND ROSE SUBDIVISION SEWER DISTRICT

IN THE CITY OF RIVERSIDE ON WHICH WORK HAS BEEN DONE UNDER MY OFFICIAL CONTRACT AS SUPERINTENDENT OF STREETS OF SAID CITY WITH CHORAK CONSTRUCTION COMPANY, DATED JANUARY 6, 1947 FOR THE CONSTRUCTION OF SANITARY SEWERS, WYE BRANCHES, AND MANHOLES.

AS IS MORE PARTICULARLY DESCRIBED IN SAID CONTRACT TO WHICH REFERENCE IS HEREBY MADE FOR FURTHER PARTICULARS; SAID DIAGRAM ALSO SHOWS THE RELATIVE LOCATION OF EACH LOT, PORTION OF LOT, PIECE OR PARCEL OF LAND ASSESSED FOR THE WORK DONE NUMBERED IN CIRCLES TO CORRESPOND TO THE RED INK NUMBERS IN THE ASSESSMENT MAP. HEREIN FIGURES NEXT TO PROPERTY LINES SHOW LENGTH OF SAID LINES IN FEET. THE MARK (O) MEANS FEET. PROPERTY LINES THAT DIFFER FROM THE RECORDED SUBDIVISIONS ARE SHOWN BY BROKEN LINES. THE DISTRICT BENEFITED IS BOUNDED BY A HEAVY DASHED LINE.





PROPERTY COVERED BY THIS ASSESSMENT IS SHOWN ON THE FOLLOWING RECORDED MAPS:

TROBRIDGE AND ROSE SUBDIVISION MAP BOOK 8, PAGE 23, RECORDS OF SAN BERNARDINO COUNTY, CALIFORNIA

I HEREBY CERTIFY THAT THIS ASSESSMENT DIAGRAM WAS APPROVED BY THE CITY COUNCIL OF THE CITY OF RIVERSIDE AT A MEETING THEREOF HELD ON THE \_\_\_\_\_ DAY OF \_\_\_\_\_ 19\_\_\_\_

\_\_\_\_\_  
CITY CLERK OF THE CITY OF RIVERSIDE.

HEREIN THE LEGEND OF THE DIFFERENT KINDS OF WORK PERFORMED IS SHOWN AS FOLLOWS:

- STANDARD MANHOLE 
- WYE BRANCH 
- SEWER CONSTRUCTED 
- EXISTING SEWER 

SUPERINTENDENT OF STREETS OF THE CITY OF RIVERSIDE THE FOLLOWING IS A STATEMENT OF AMOUNTS OF DIFFERENT KINDS OF WORK DONE BY CHORAK CONSTRUCTION COMPANY UNDER CONTRACT DATED JANUARY 6, 1947 PURSUANT TO RESOLUTION OF INTENTION NO. 4103 ADOPTED BY THE CITY COUNCIL OF THE CITY OF RIVERSIDE ON THE 29TH DAY OF OCTOBER 1946

AT SAID CITY OF RIVER SIDE THIS \_\_\_\_\_ DAY OF \_\_\_\_\_

\_\_\_\_\_  
SUPERINTENDENT OF STREETS OF THE CITY OF RIVERSIDE.

I HEREBY CERTIFY THAT THE ABOVE WORK WAS DONE IN ACCORDANCE WITH LINES AND GRADES FURNISHED BY ME AND THAT THE DIAGRAM OF THE ASSESSMENT DISTRICT FOR THE SAME IS CORRECT.

\_\_\_\_\_  
CITY ENGINEER OF THE CITY OF RIVERSIDE.



RECORDED AT \_\_\_\_\_ O'CLOCK \_\_\_\_\_ M.  
THIS \_\_\_\_\_ DAY OF \_\_\_\_\_ 19\_\_\_\_

\_\_\_\_\_  
SUPERINTENDENT OF STREETS OF THE CITY OF RIVERSIDE.

637-1

See Sheet No 57

Scale - 1"=100'

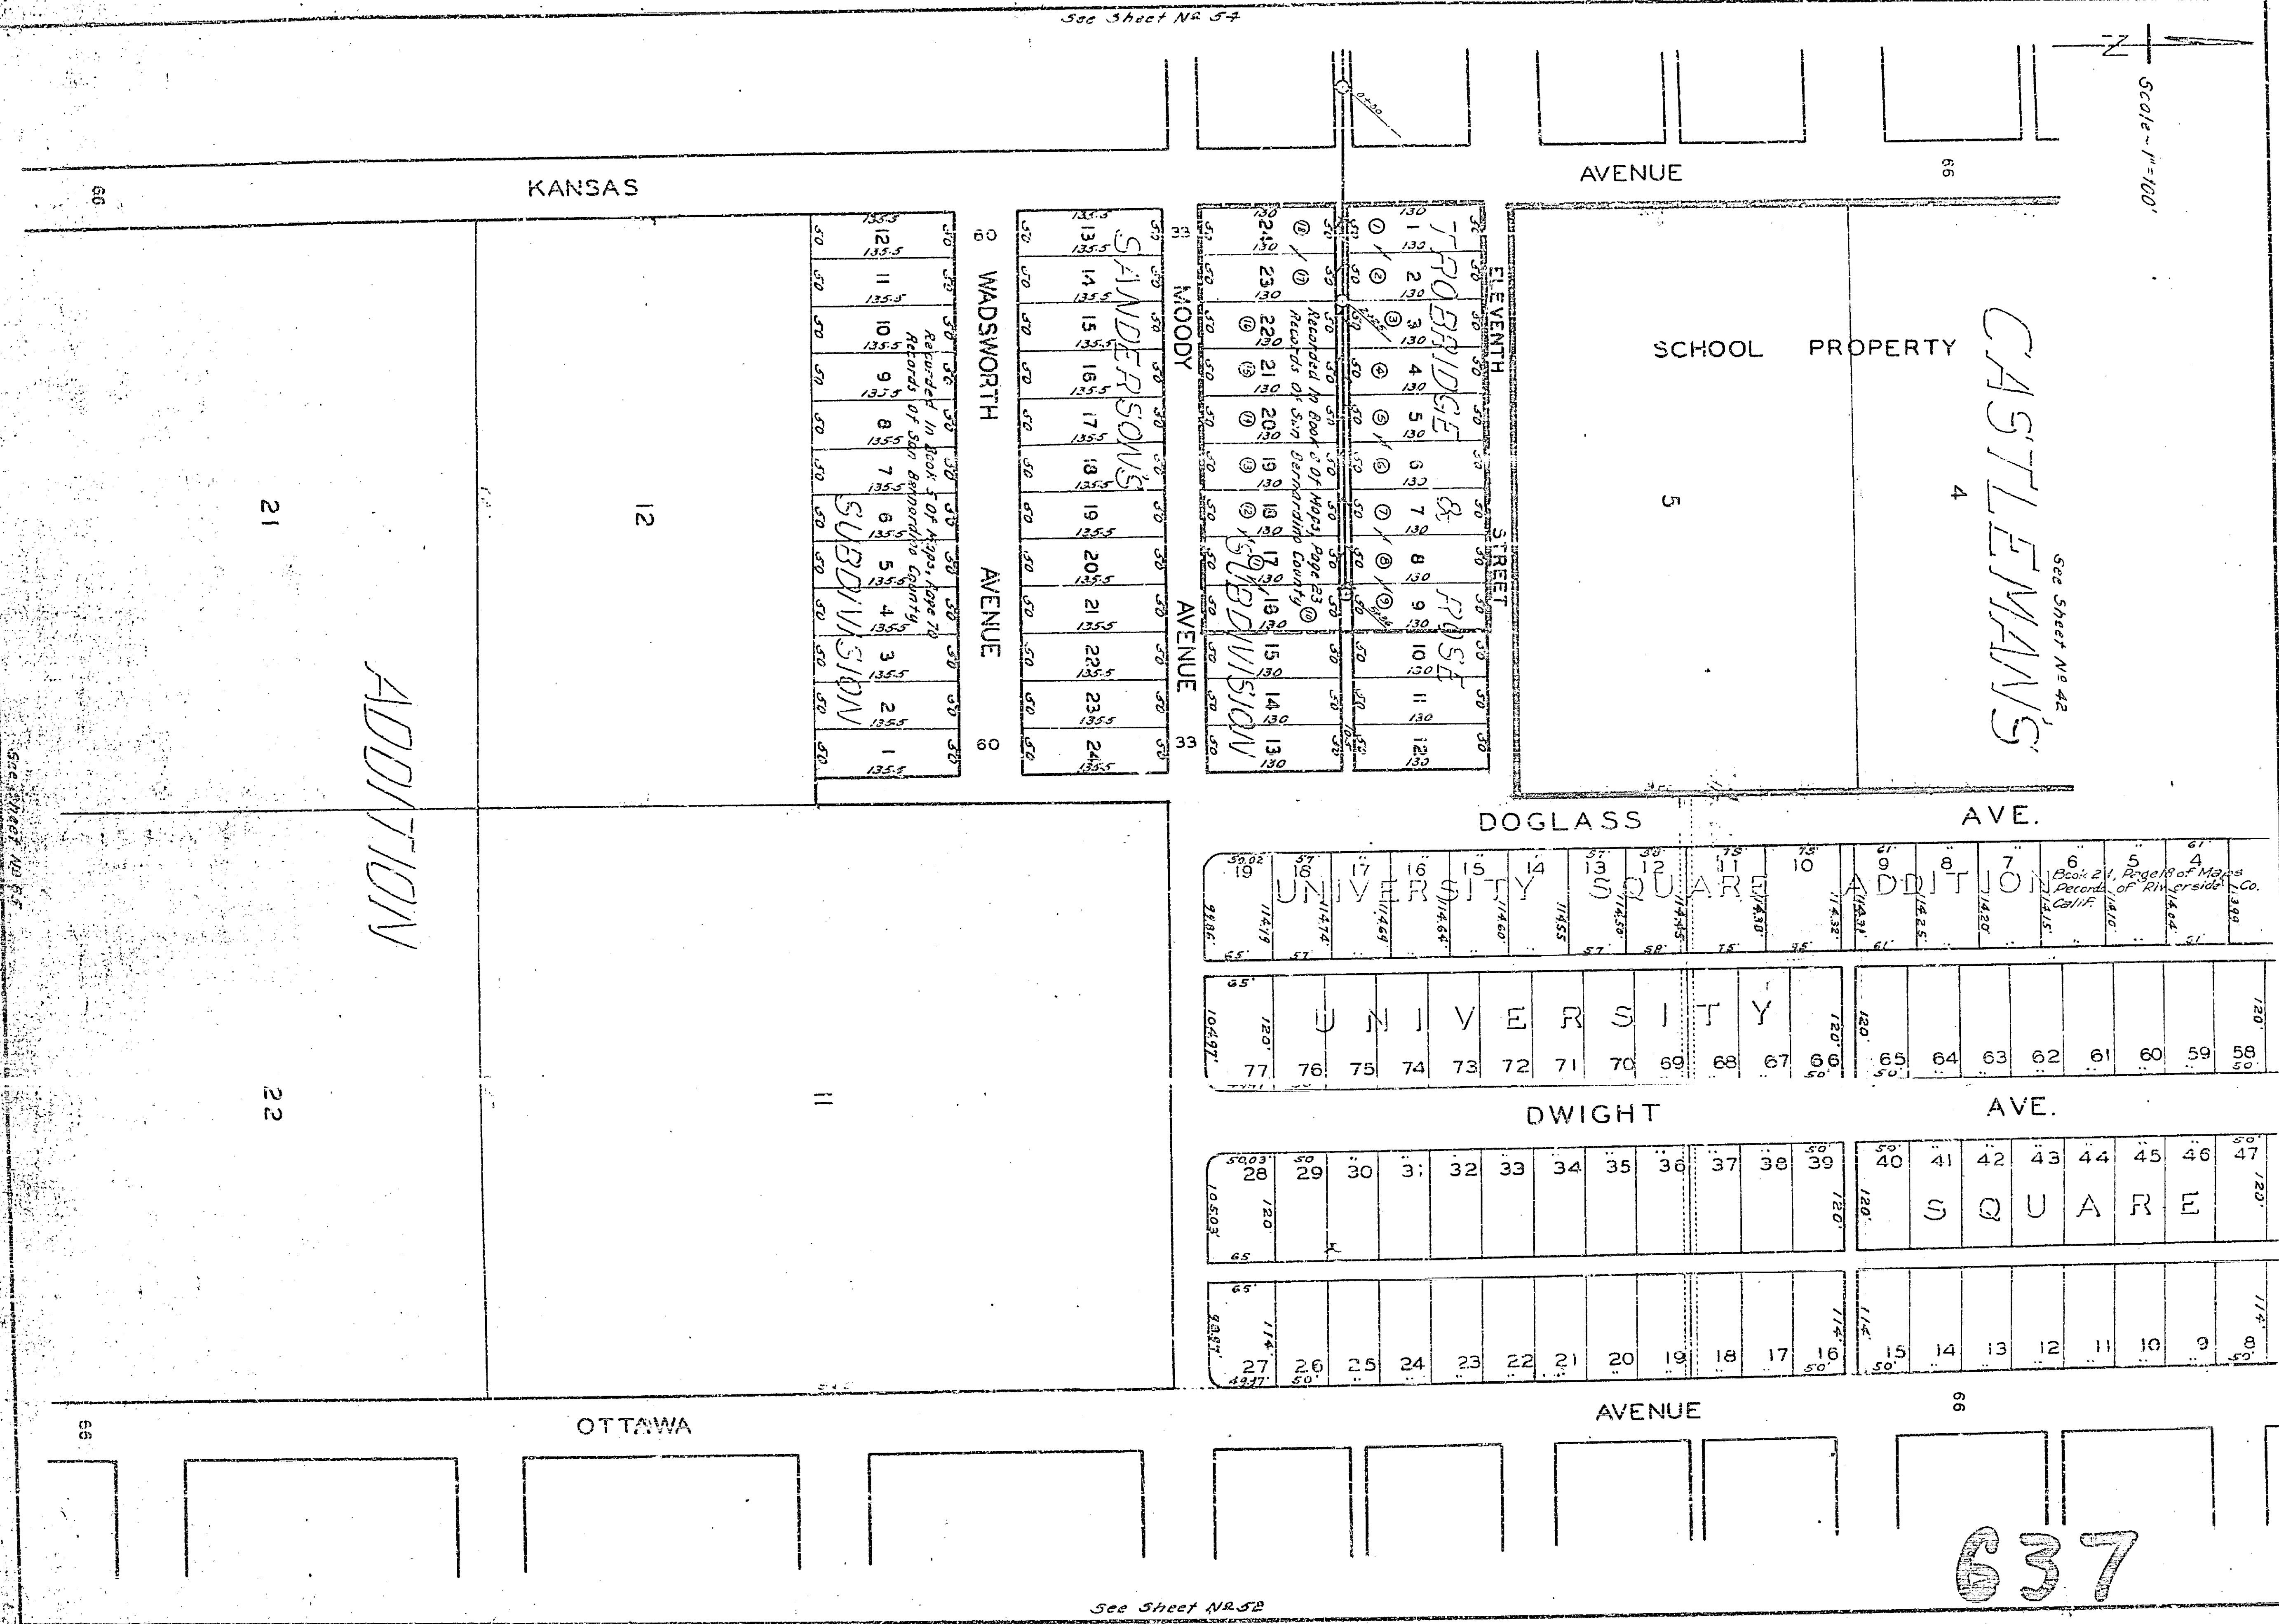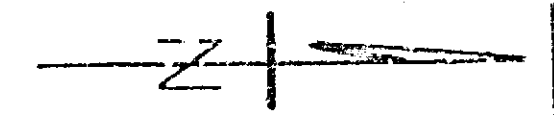

Records in Book of Apprs. Page 70  
Records of San Bernardino County

12	135.5
11	135.5
10	135.5
9	135.5
8	135.5
7	135.5
6	135.5
5	135.5
4	135.5
3	135.5
2	135.5
1	135.5

SANDERSON'S


13	135.5
14	135.5
15	135.5
16	135.5
17	135.5
18	135.5
19	135.5
20	135.5
21	135.5
22	135.5
23	135.5
24	135.5

Records in Book of Apprs. Page 83  
Records of San Bernardino County

22	130
23	130
21	130
20	130
19	130
18	130
17	130
16	130
15	130
14	130
13	130

PROBRIDGE & ROUSE

1	130
2	130
3	130
4	130
5	130
6	130
7	130
8	130
9	130
10	130
11	130
12	130

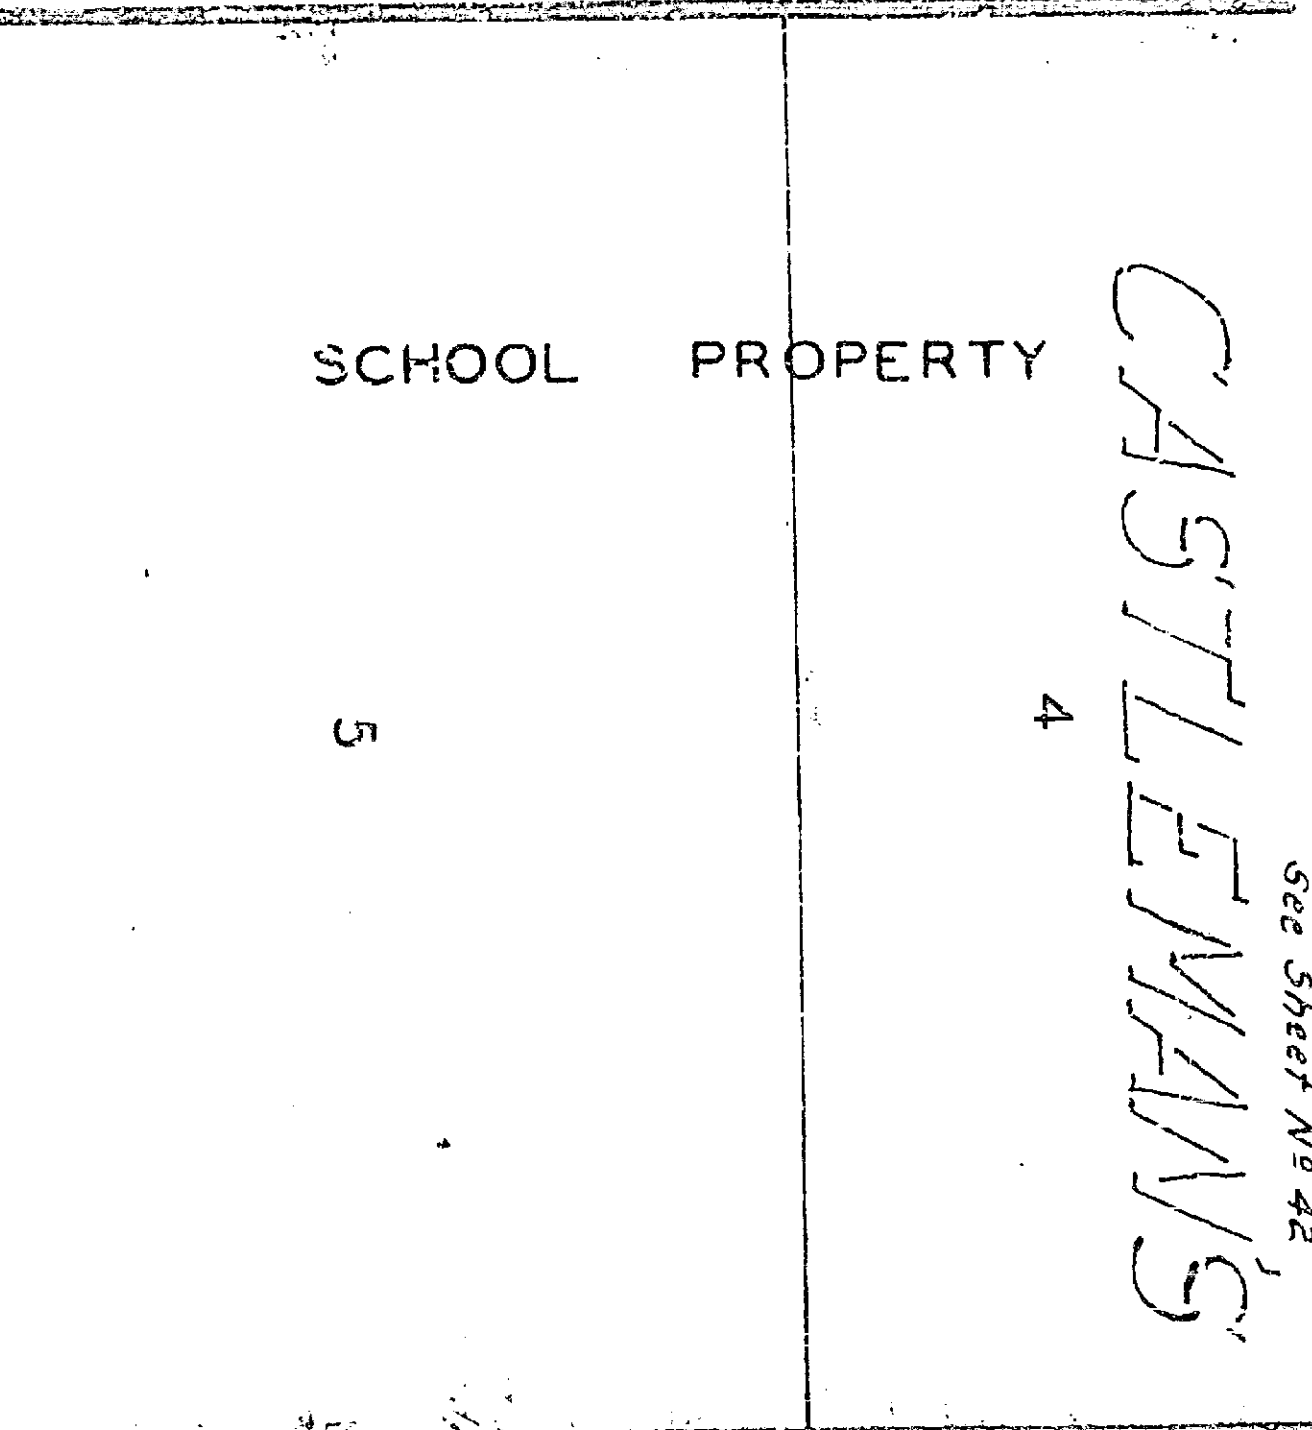

UNIVERSITY SQUARE ADDITION

19	17	16	15	14	13	12	11	10	9	8	7	6	5	4	3	2	1
114.7	114.7	114.64	114.60	114.55	114.50	114.45	114.40	114.35	114.30	114.25	114.20	114.15	114.10	114.05	114.00	113.95	113.90

UNIVERSITY

77	76	75	74	73	72	71	70	69	68	67	66	65	64	63	62	61	60	59	58
104.87	120	120	120	120	120	120	120	120	120	120	120	120	120	120	120	120	120	120	120

DWIGHT SQUARE

28	29	30	31	32	33	34	35	36	37	38	39	40	41	42	43	44	45	46	47
104.03	120	120	120	120	120	120	120	120	120	120	120	120	120	120	120	120	120	120	120

27	26	25	24	23	22	21	20	19	18	17	16	15	14	13	12	11	10	9	
114	114	114	114	114	114	114	114	114	114	114	114	114	114	114	114	114	114	114	114

637

SHEET 2 TOTAL 2

See Sheet No 58