

# DIAGRAM

## EXHIBITING ELEVENTH-TWELFTH STREETS IMPROVEMENT DISTRICT

IN THE CITY OF RIVERSIDE ON WHICH WORK HAS BEEN DONE UNDER MY OFFICIAL CONTRACT AS SUPERINTENDENT OF STREETS OF SAID CITY WITH C.O. BRAND DATED FEBRUARY 9, 1953


FOR THE CONSTRUCTION OF COMBINATION CURB & GUTTER, DOUBLE GUTTER, & GUTTER CATCH BASIN AND GRATING. AS IS MORE PARTICULARLY DESCRIBED IN SAID CONTRACT TO WHICH REFERENCE IS HEREBY MADE FOR FURTHER PARTICULARS; SAID DIAGRAM ALSO SHOWS THE RELATIVE LOCATION OF EACH LOT, PORTION OF LOT, PIECE OR PARCEL OF LAND ASSESSED FOR THE WORK DONE, NUMBERED IN CIRCLES TO CORRESPOND TO THE RED INK NUMBERS IN THE ASSESSMENT HEREIN FIGURE; NEXT TO PROPERTY LINES SHOW LENGTH OF SAID LINES IN FEET. THE MARK ( ) MEANS FEET. PROPERTY LINES THAT DIFFER FROM THE RECORDED SUBDIVISIONS ARE SHOWN BY BROKEN LINES. THE DISTRICT BENEFITED IS BOUNDED BY A HEAVY DASHED LINE. PROPERTY COVERED BY THIS ASSESSMENT IS SHOWN ON THE FOLLOWING RECORDED MAPS:

- TROBRIDGE & ROSE SUBDIVISION M.B. 8, PG. 23, REC. S.E. CO.
- COX ADDITION M.B. 3, PG. 59, REC. S.B. CO.
- JOHNSON'S SUBDIVISION M.B. 6, PG. 57, REC. RIV. CO.
- CASTLEMAN'S ADDITION M.B. 3, PG. 19, REC. S.B. CO.

I HEREBY CERTIFY THAT THIS ASSESSMENT DIAGRAM WAS APPROVED BY THE CITY COUNCIL OF THE CITY OF RIVERSIDE AT A MEETING THEREOF HELD ON THE \_\_\_\_\_ DAY OF \_\_\_\_\_ 19\_\_

\_\_\_\_\_  
CITY CLERK OF THE CITY OF RIVERSIDE.

HEREIN THE LEGEND OF THE DIFFERENT KINDS OF WORK PERFORMED IS SHOWN AS FOLLOWS:

- COMBINATION CURB & GUTTER 
- DOUBLE GUTTER 

SUPERINTENDENT OF STREETS OF THE CITY OF RIVERSIDE THE FOLLOWING IS A STATEMENT OF AMOUNTS OF DIFFERENT KINDS OF WORK DONE BY C.O. BRAND UNDER CONTRACT DATED FEBRUARY 9, 1953 PURSUANT TO RESOLUTION OF INTENTION NO 5479 ADOPTED BY THE CITY COUNCIL OF THE CITY OF RIVERSIDE ON THE 28TH DAY OF OCTOBER 1952

COMBINATION CURB & GUTTER	251071 LIN. FT.
DOUBLE GUTTER	50166 SQ. FT.
GUTTER CATCH BASIN & GRATING	0

AT SAID CITY OF RIVERSIDE THIS \_\_\_\_\_ DAY OF \_\_\_\_\_

\_\_\_\_\_  
SUPERINTENDENT OF STREETS OF THE CITY OF RIVERSIDE.


I HEREBY CERTIFY THAT THE ABOVE WORK WAS DONE IN ACCORDANCE WITH LINES AND GRADES FURNISHED BY ME AND THAT THE DIAGRAM OF THE ASSESSMENT DISTRICT FOR THE SAME IS CORRECT.

\_\_\_\_\_  
CITY ENGINEER OF THE CITY OF RIVERSIDE.

RECORDED AT \_\_\_\_\_ O'CLOCK \_\_\_\_\_ M.  
THIS \_\_\_\_\_ DAY OF \_\_\_\_\_ 19\_\_

\_\_\_\_\_  
SUPERINTENDENT OF STREETS OF THE CITY OF RIVERSIDE.

643-B

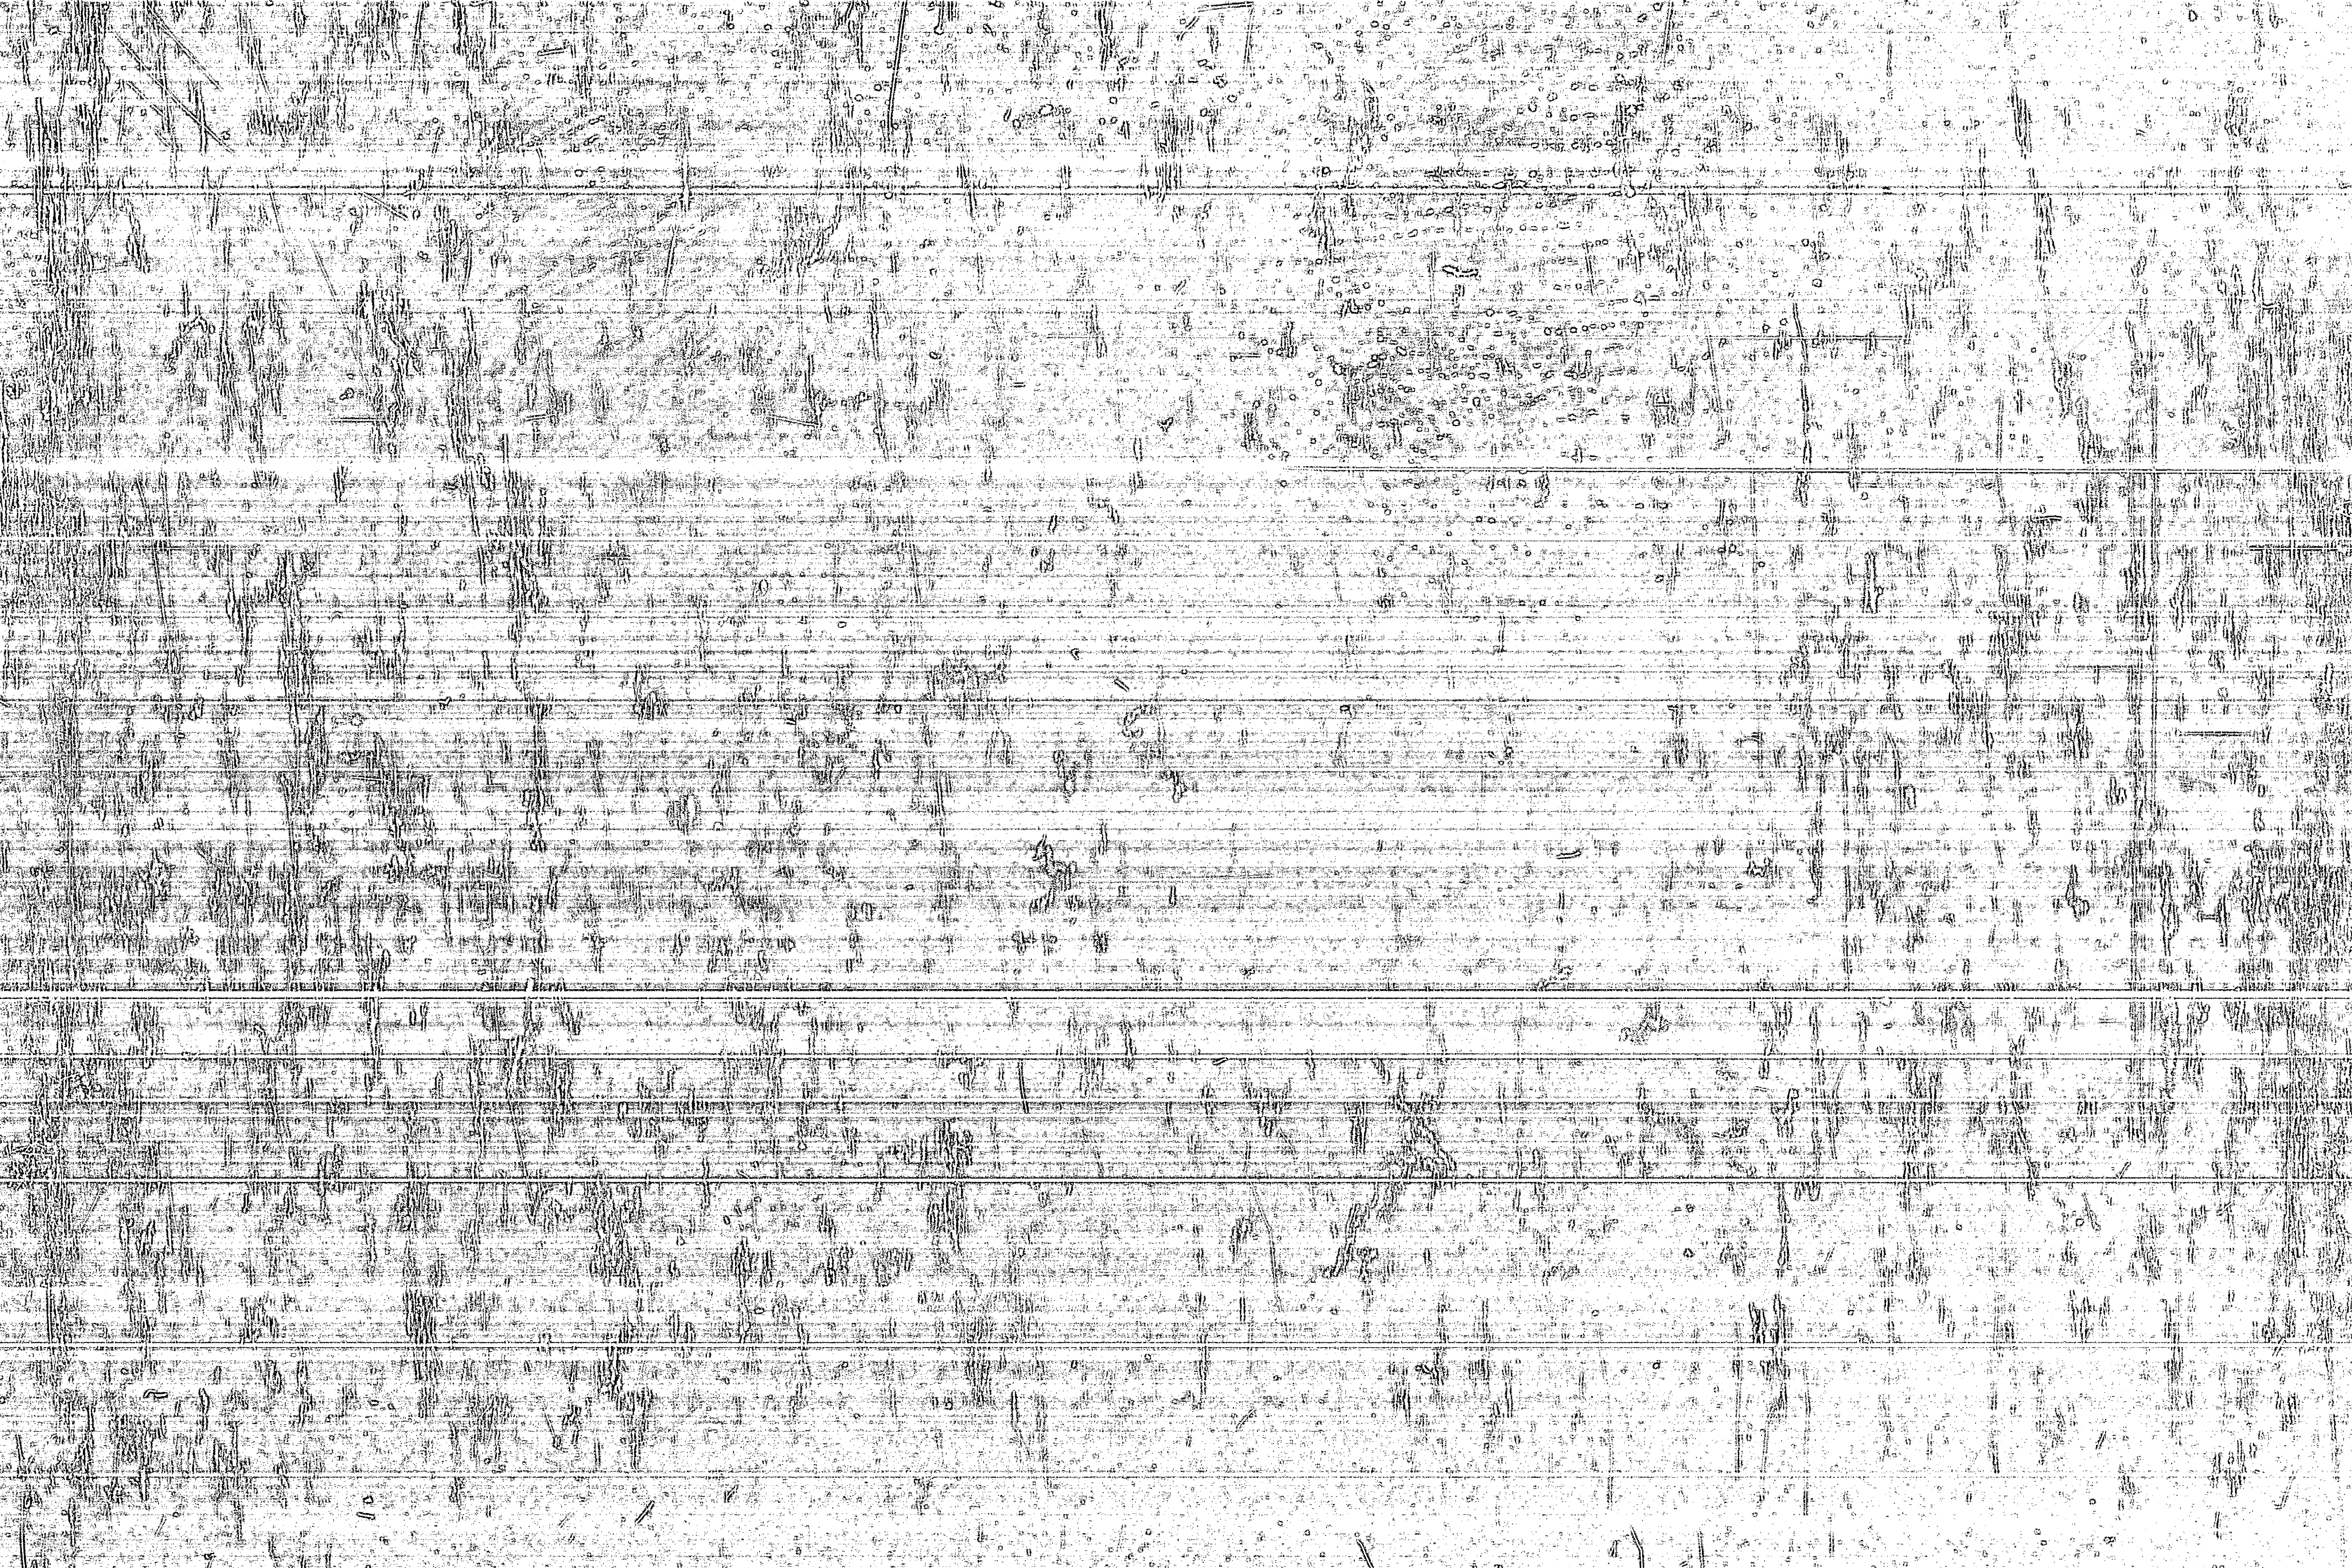

**MISSING**

**MISSING**