

See 695-C (Tracing)

See #173  
Carote

INDIAN

Southerly corner Lot J  
Indian Hill Tract.

S.W. 1/4 Cor. Lot K

34<sup>09</sup> Acres.

HILL TRACT



Book 10 of Maps, Page 3. Riverside Co.

LOT 3

LOT H

Fairmount Park Lake Extension  
Indian Hill Tract

695

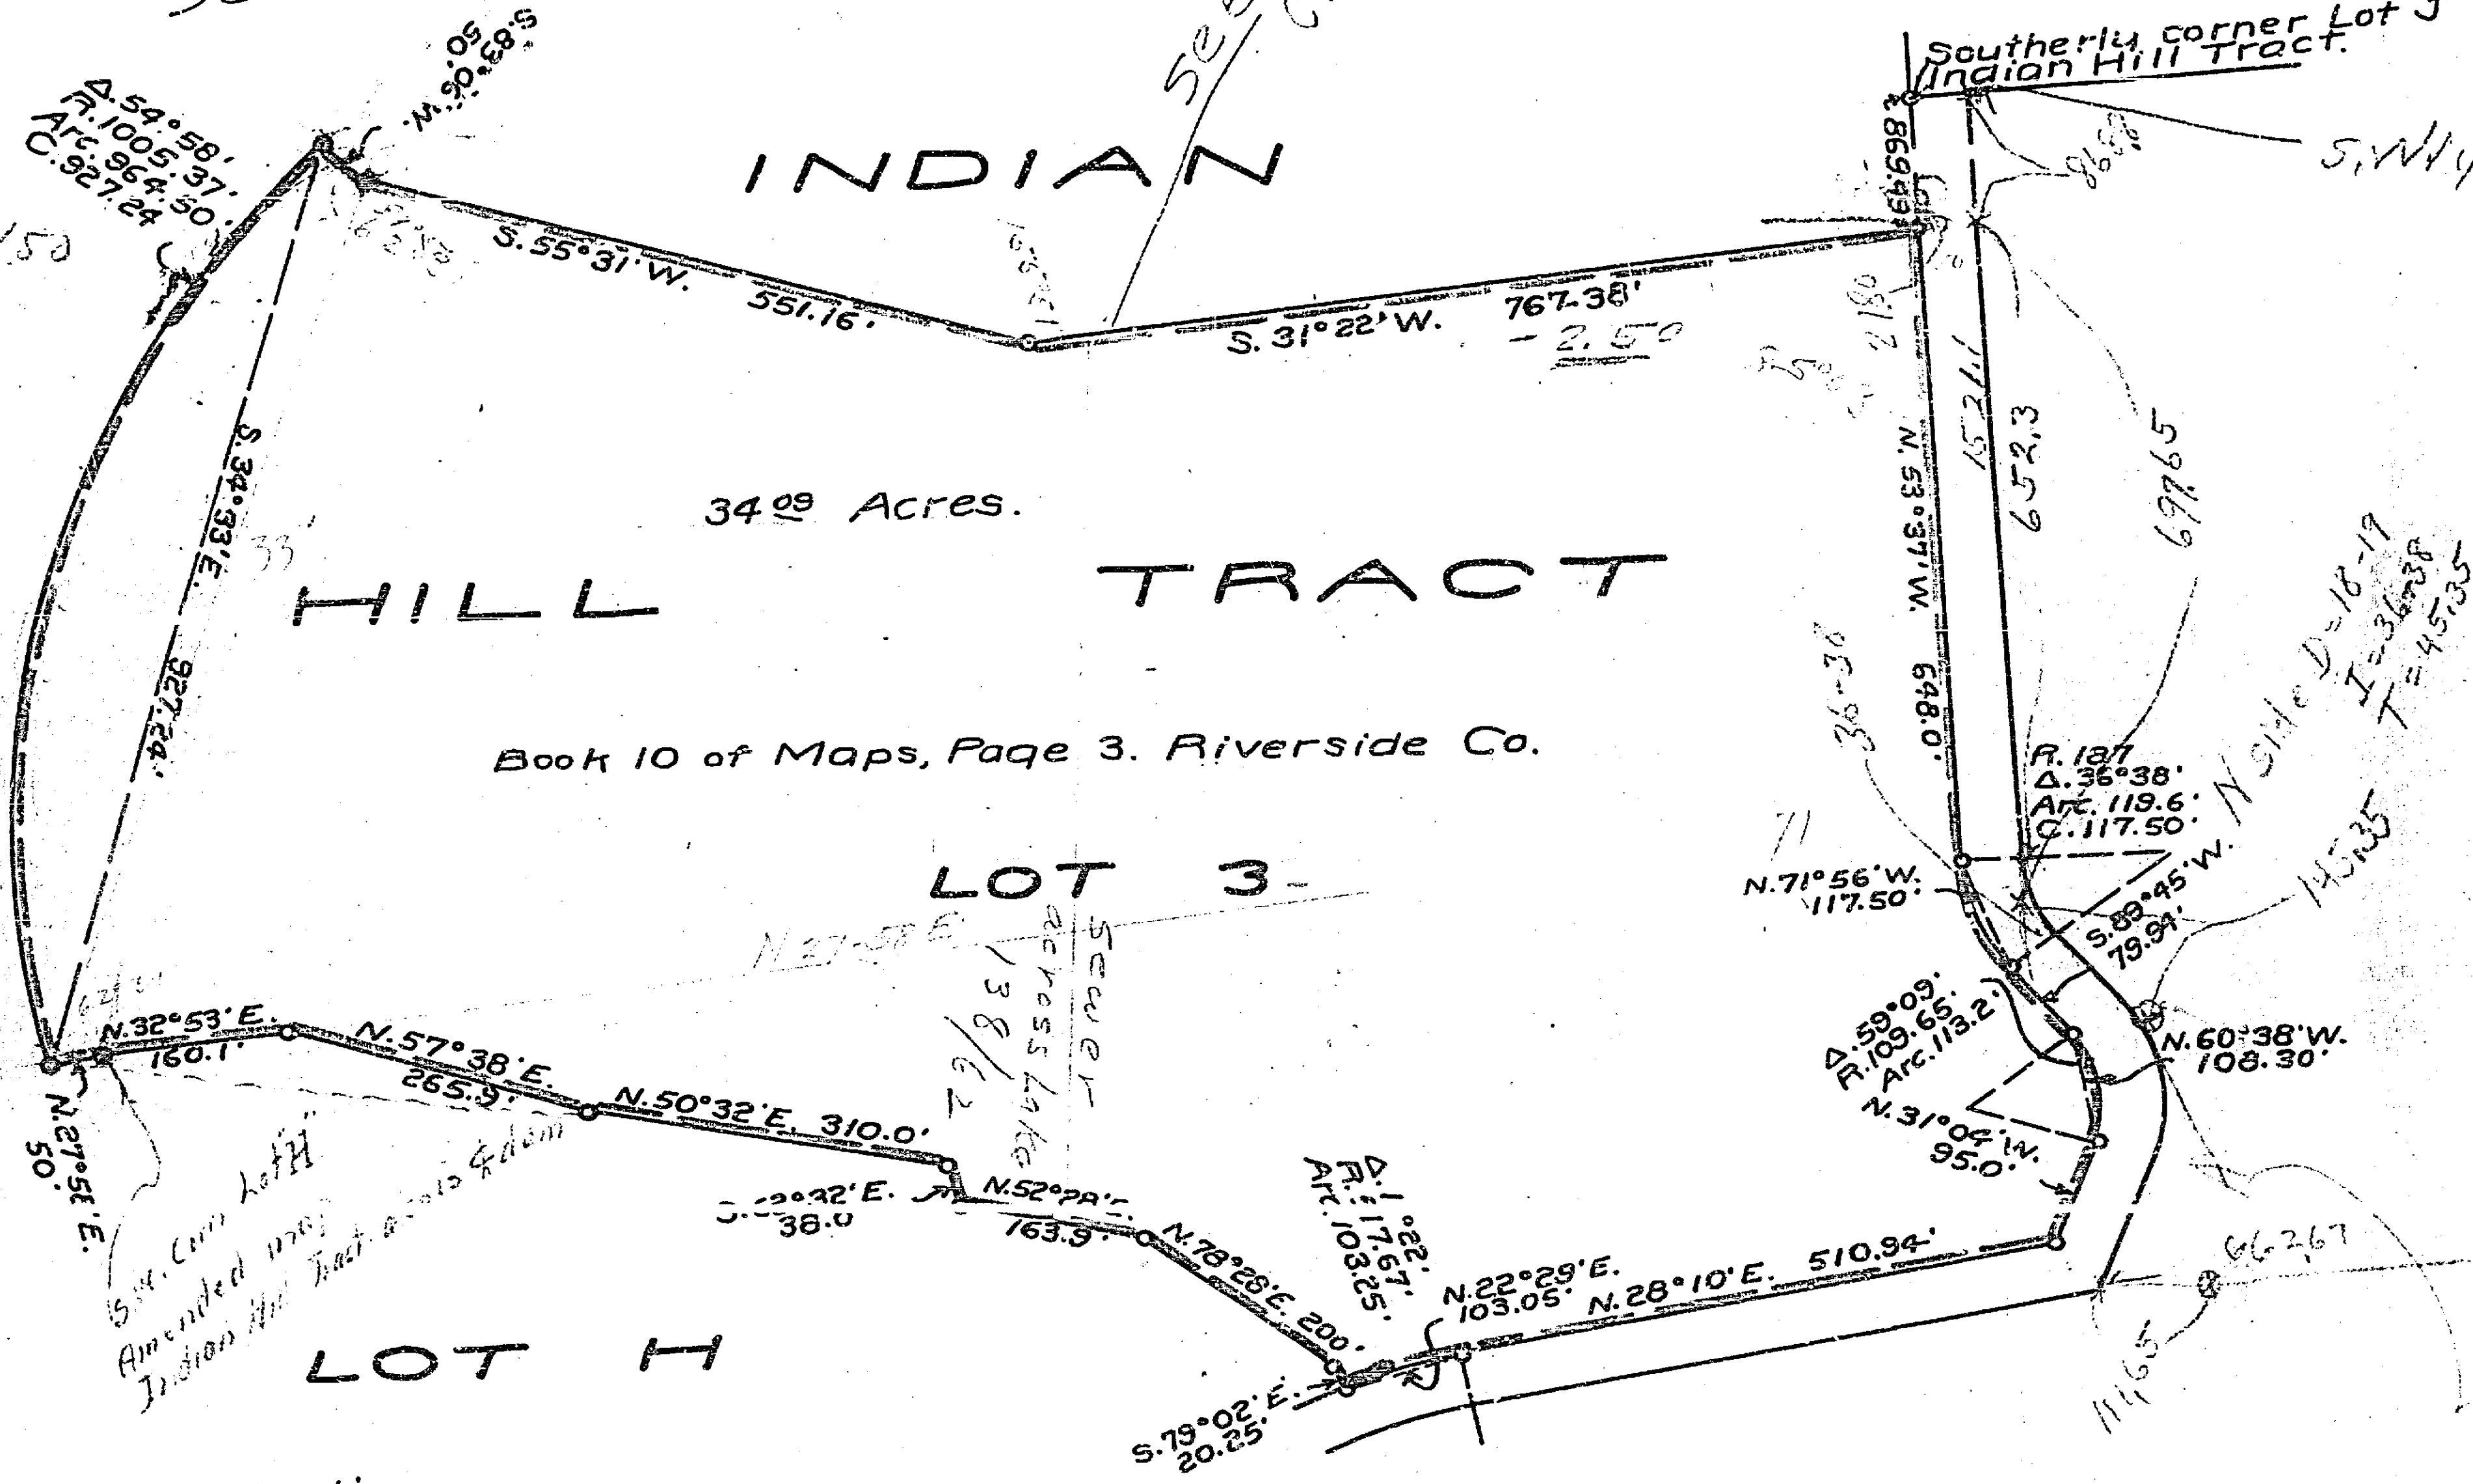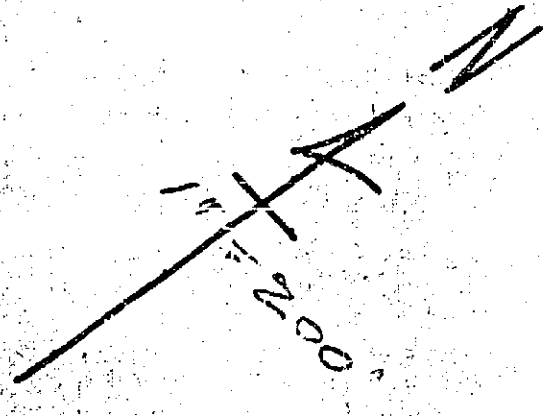

F. 127  
A. 36°38'  
Arc. 119.6'  
C. 117.50'

F. 109.65'  
A. 59°09'  
Arc. 113.2'  
C. 117.50'

F. 171.855'  
A. 11°22'  
Arc. 103.05'  
C. 103.05'

N. 58°45' W. 79.94'

N. 60°38' W. 108.30'

S. 79°02' E. 20.25'

N. 22°29' E. 103.05'

N. 28°10' E. 510.94'

662.67

611.15

964.50

152.11

652.3

697.65

36-30

N. 51°18' W. 18.19'  
I = 36°38'  
T = 45°05'

S. 1/4 Cor. Lot H  
Amended map  
Indian Hill Tract a 2015 Edition

Sewer  
across Lake  
138/62