
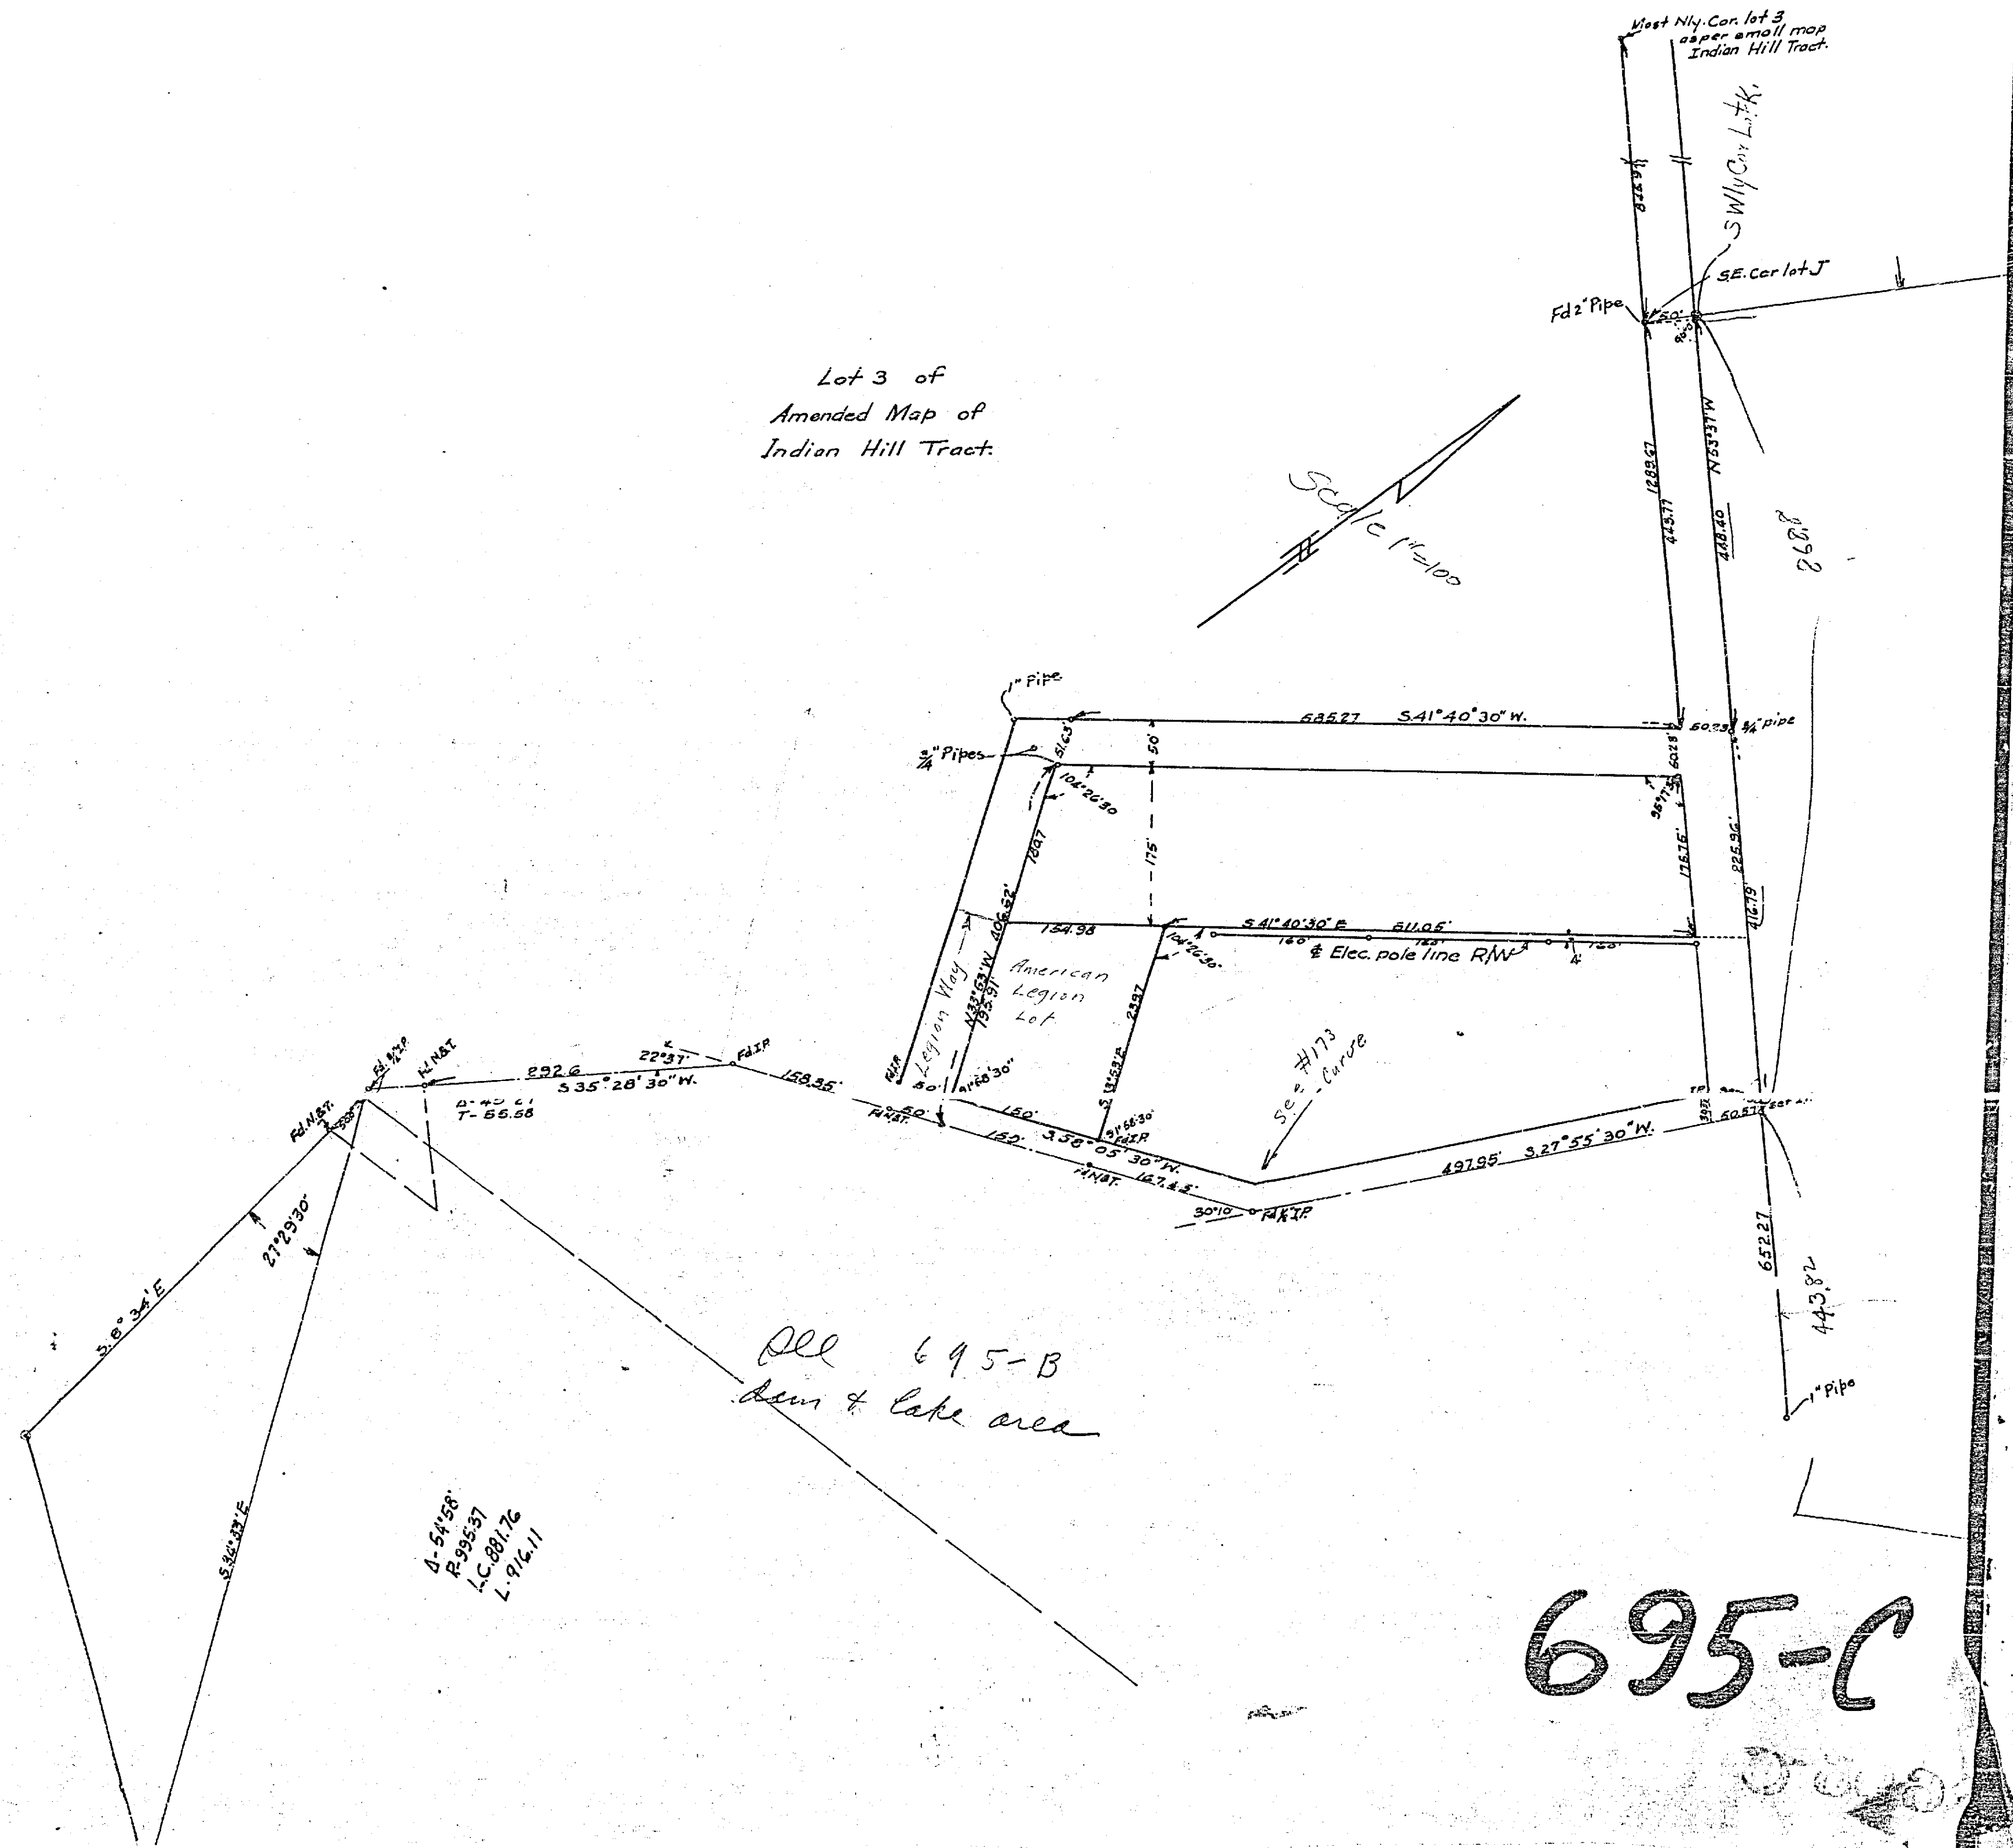


Lot 3 of
Amended Map of
Indian Hill Tract.

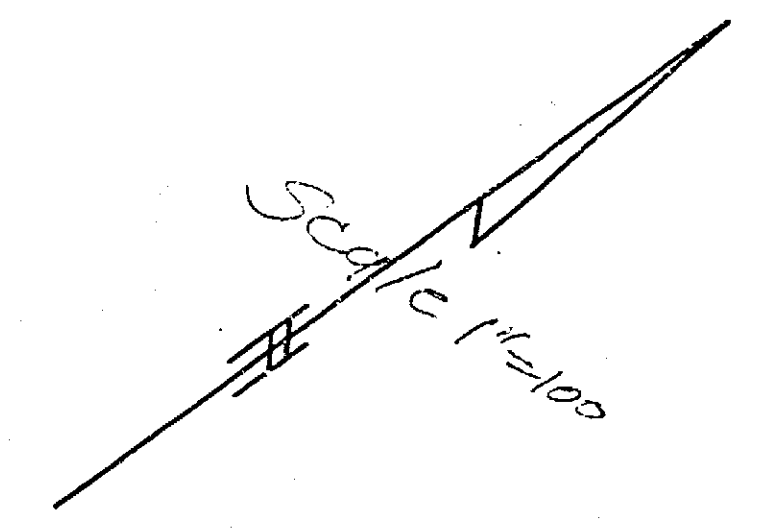

All 695-B
dems & lake area

D-54158
R-99537
L.C. 88176
L-91611

695-C