


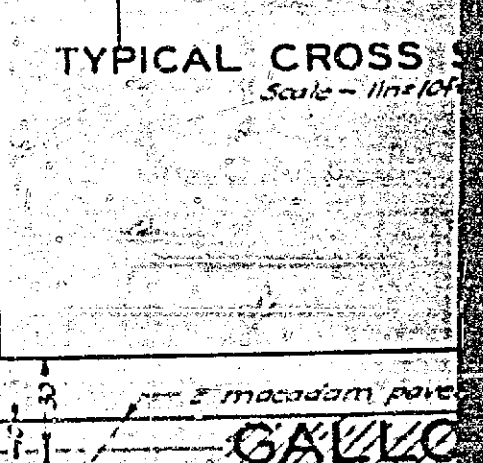
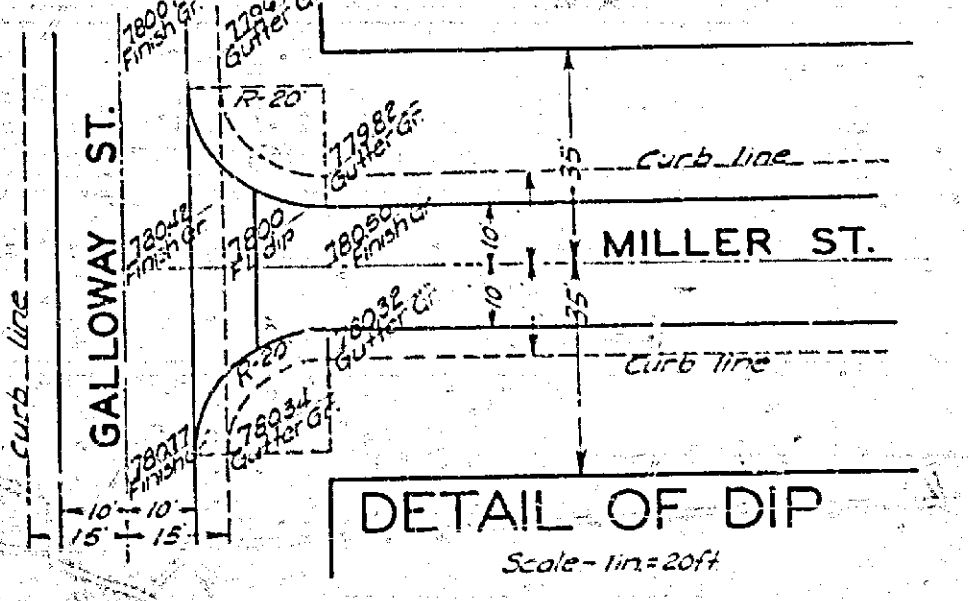


Note:  
Suggested street width change to 36 ft due to trees, poles, etc. July 14, 1937.  
Lee Nafzgar

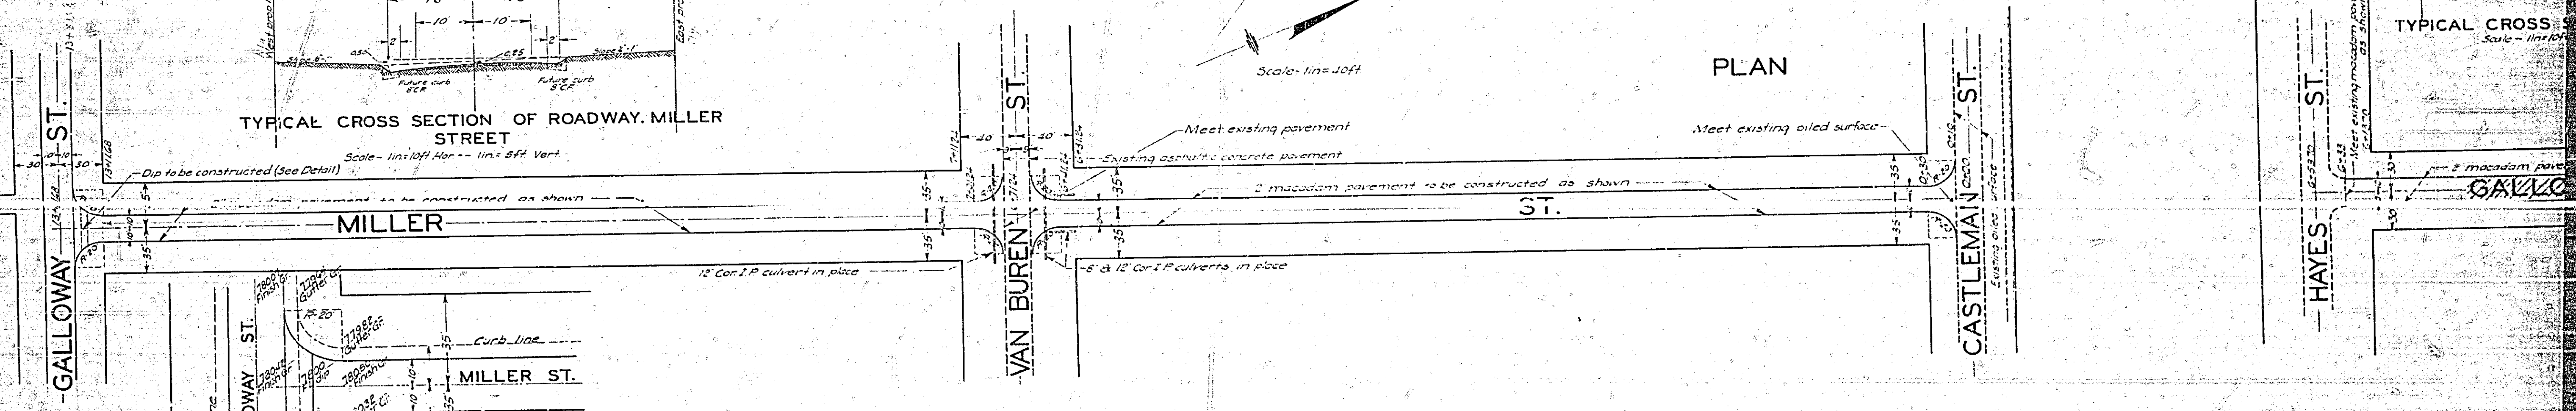

FRAME 2 OF 2

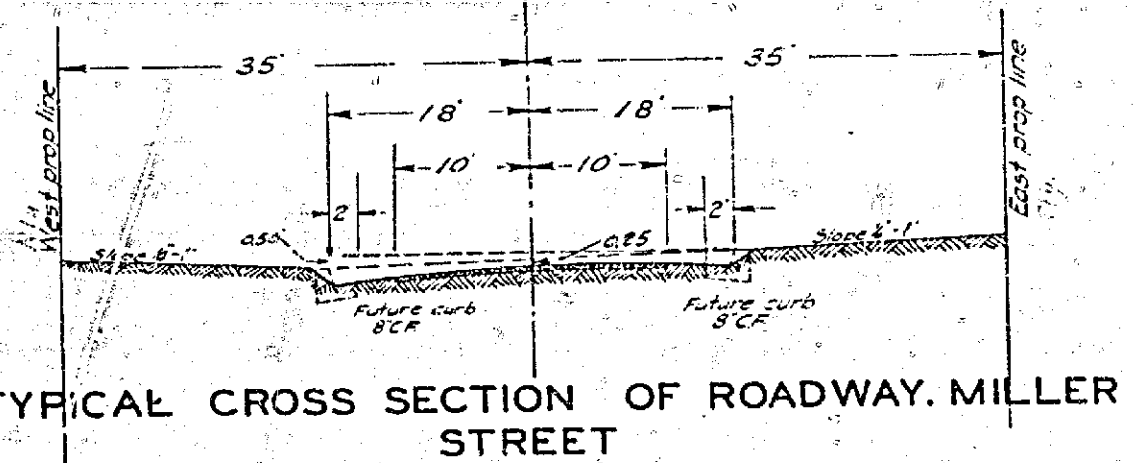


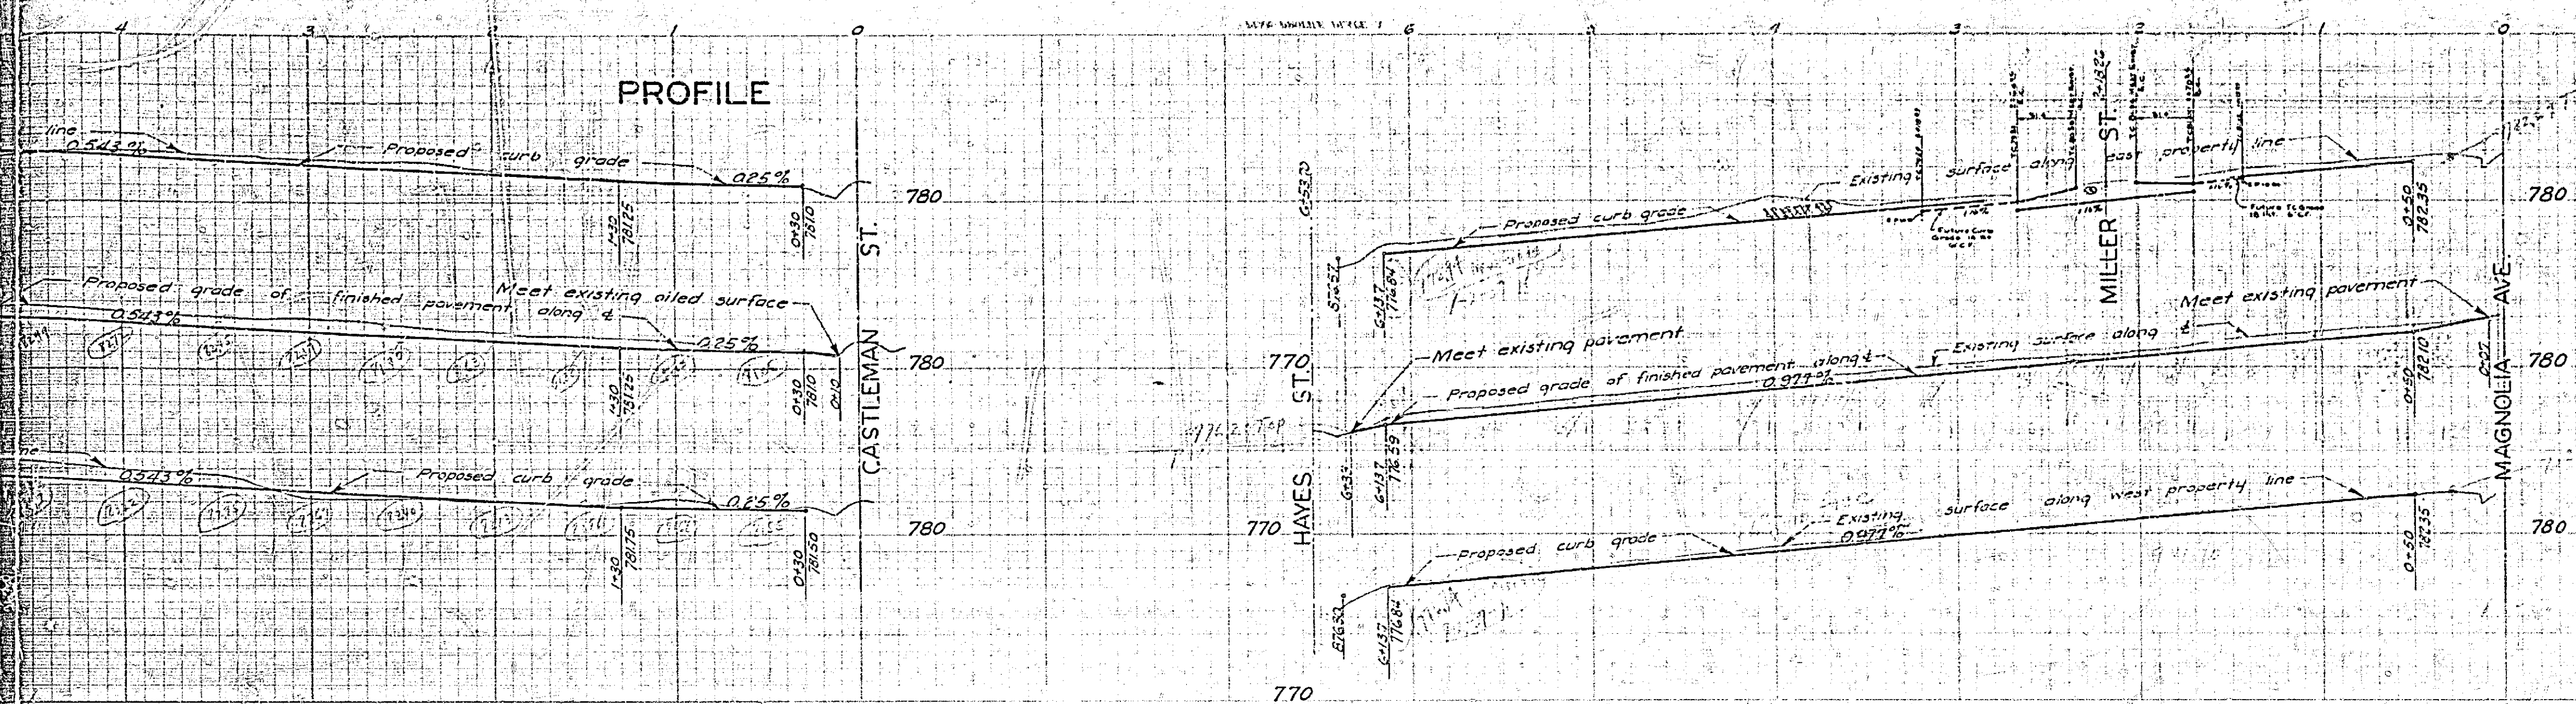


PLANS AND PROFILES  
 OF THE PROPOSED STREET IMPROVEMENT OF  
 MILLER STREET  
 GALLOWAY STREET  
 CHANGED TO ROOSEVELT  
 ENGINEERING DEPT. CITY OF RIVERSIDE APR. 1934

FIELD BOOK: 286  
 633  
 Constructed by Street Dept. 1934. WPA Labor.  
 ELEVATIONS SHOWN HEREON ARE U.S.C.S. DATUM  
 WHICH IS THE OFFICIAL CITY DATUM PLANE AS  
 ESTABLISHED BY ORDINANCE NO. 551 N.S.

APPROVED AND ADOPTED BY THE MAYOR AND  
 COUNCIL OF THE CITY OF RIVERSIDE THIS 24TH DAY OF  
 JULY 1934.  
 CITY CLERK, CITY OF RIVERSIDE

REVISIONS			
MARK	DESCRIPTION	APPROVED	DATE
①	Revised and Resubmitted to Department of Public Works, City of Riverside	<i>[Signature]</i>	2/14/33

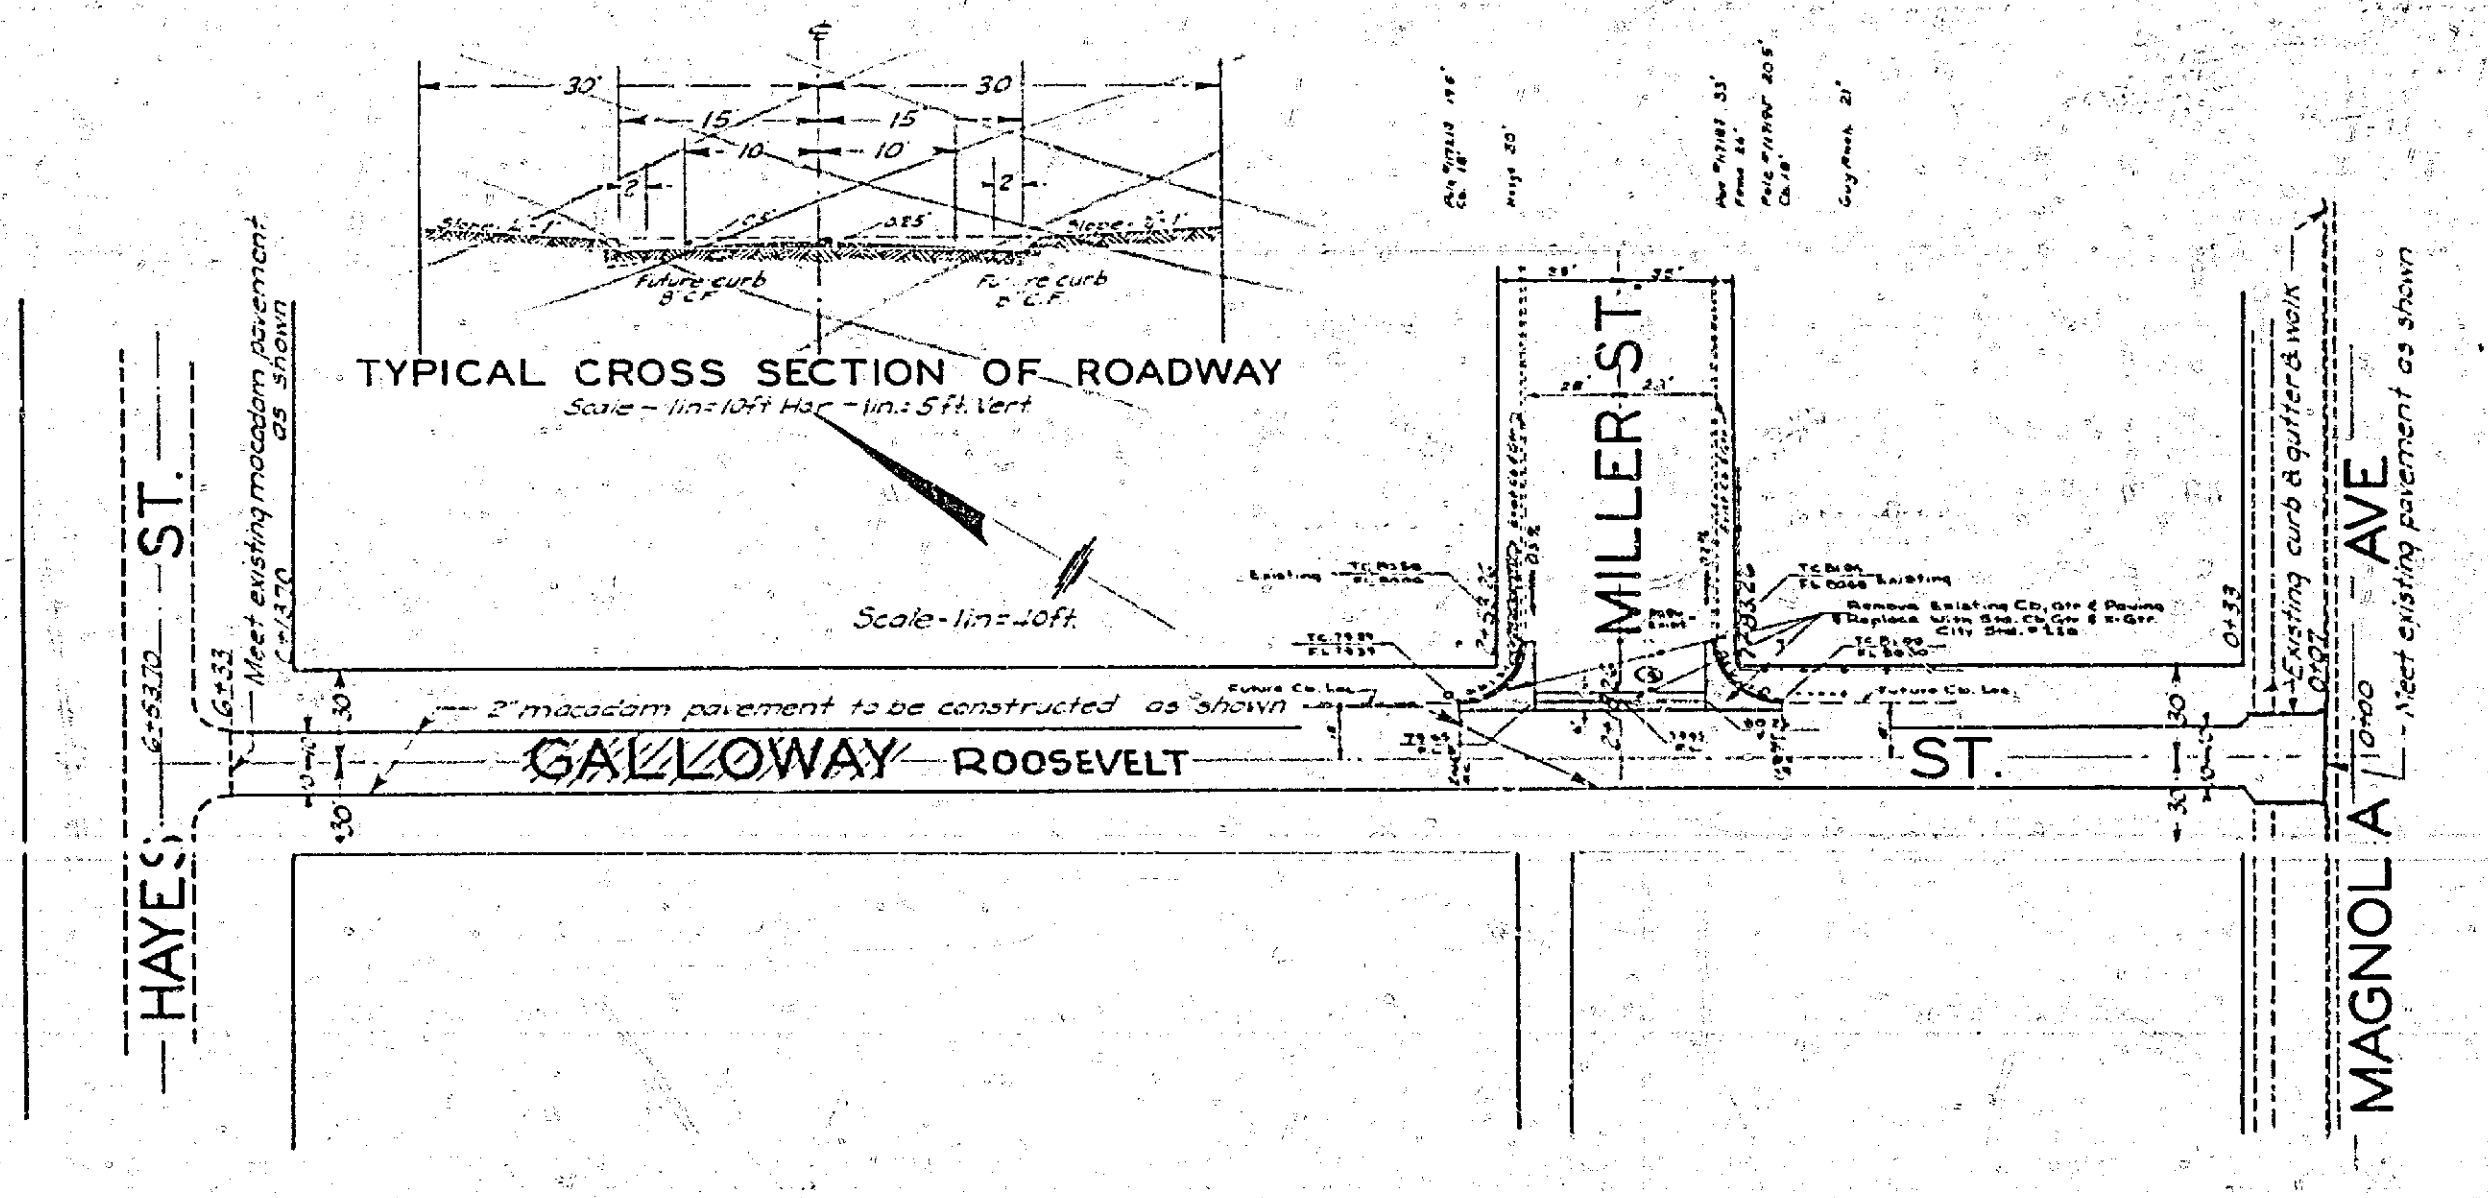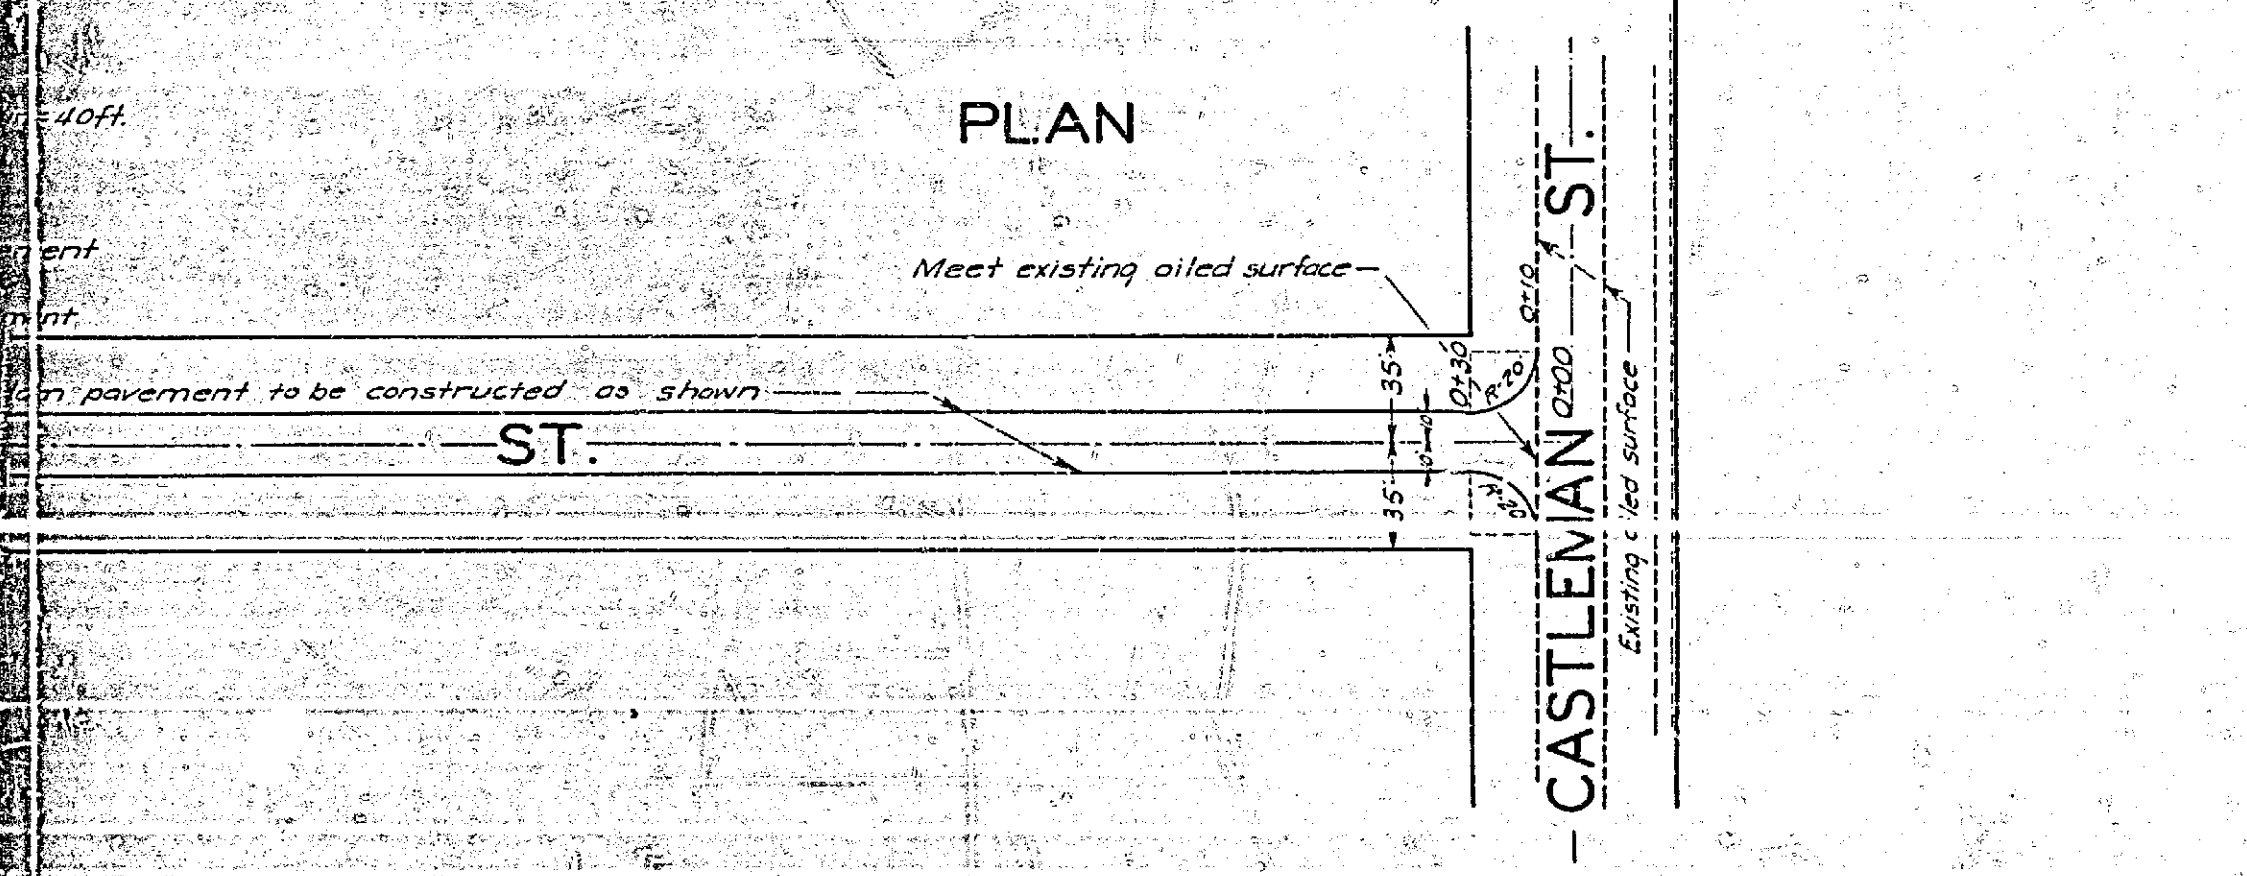

FRAME 2 of 2

FRAME 1 of 2

732