


PLANS & PROFILES
NO. 756
OF
MARKET AND FAIRMOUNT STREETS
SEWER DISTRICT
RIVERSIDE, CALIFORNIA

APPROVED: *M. H. Swain*
CITY ENGINEER
A CIVIL ENGINEER REGISTERED UNDER
THE LAWS OF THE STATE OF CALIFORNIA
REG. C. E. 1011

THESE PLANS APPROVED AND ADOPTED BY THE MAYOR AND
COUNCIL OF THE CITY OF RIVERSIDE, STATE OF CALIFORNIA ON
THIS 22 DAY OF December 1947
John J. ...
CITY CLERK
OF RIVERSIDE, STATE OF CALIFORNIA


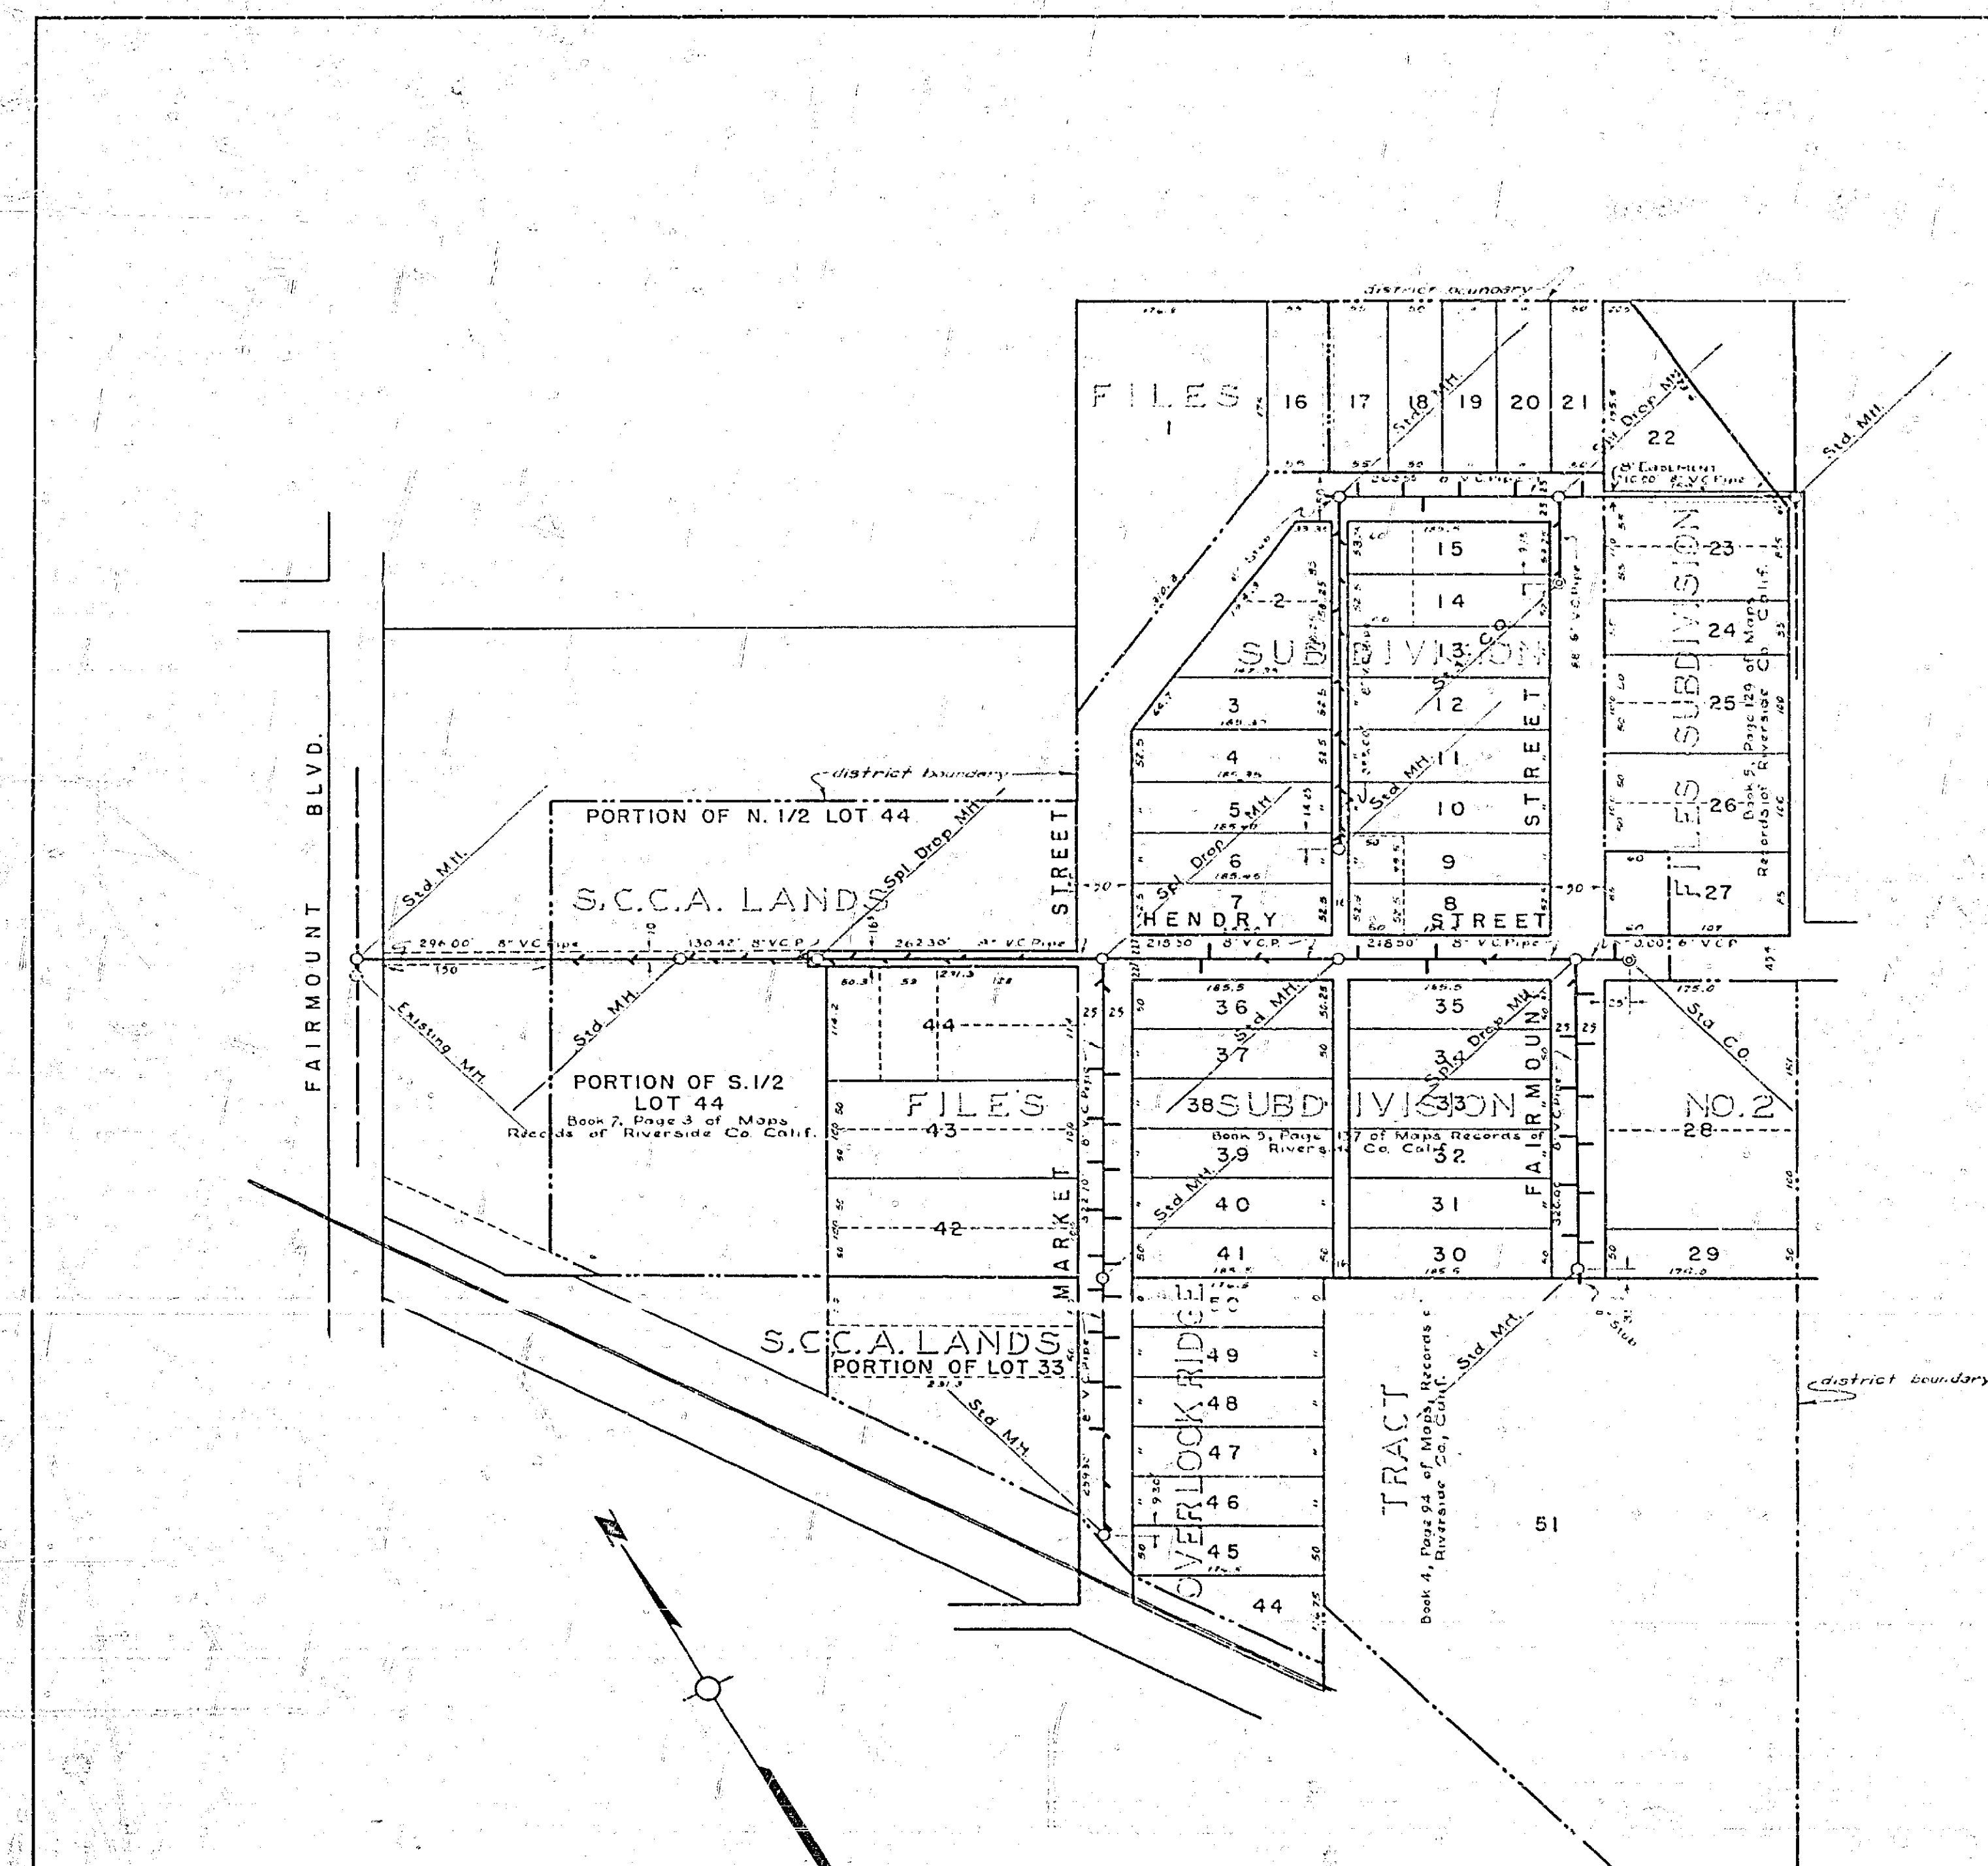


MAP SHOWING
DISTRICT TO BE BENEFITTED
SCALE 1"=100'

756

22"
17"
11"
8.5"
11"
17"
22"

34"
22"
17"
11"
8.5"
11"
8.5"
11"
17"
22"

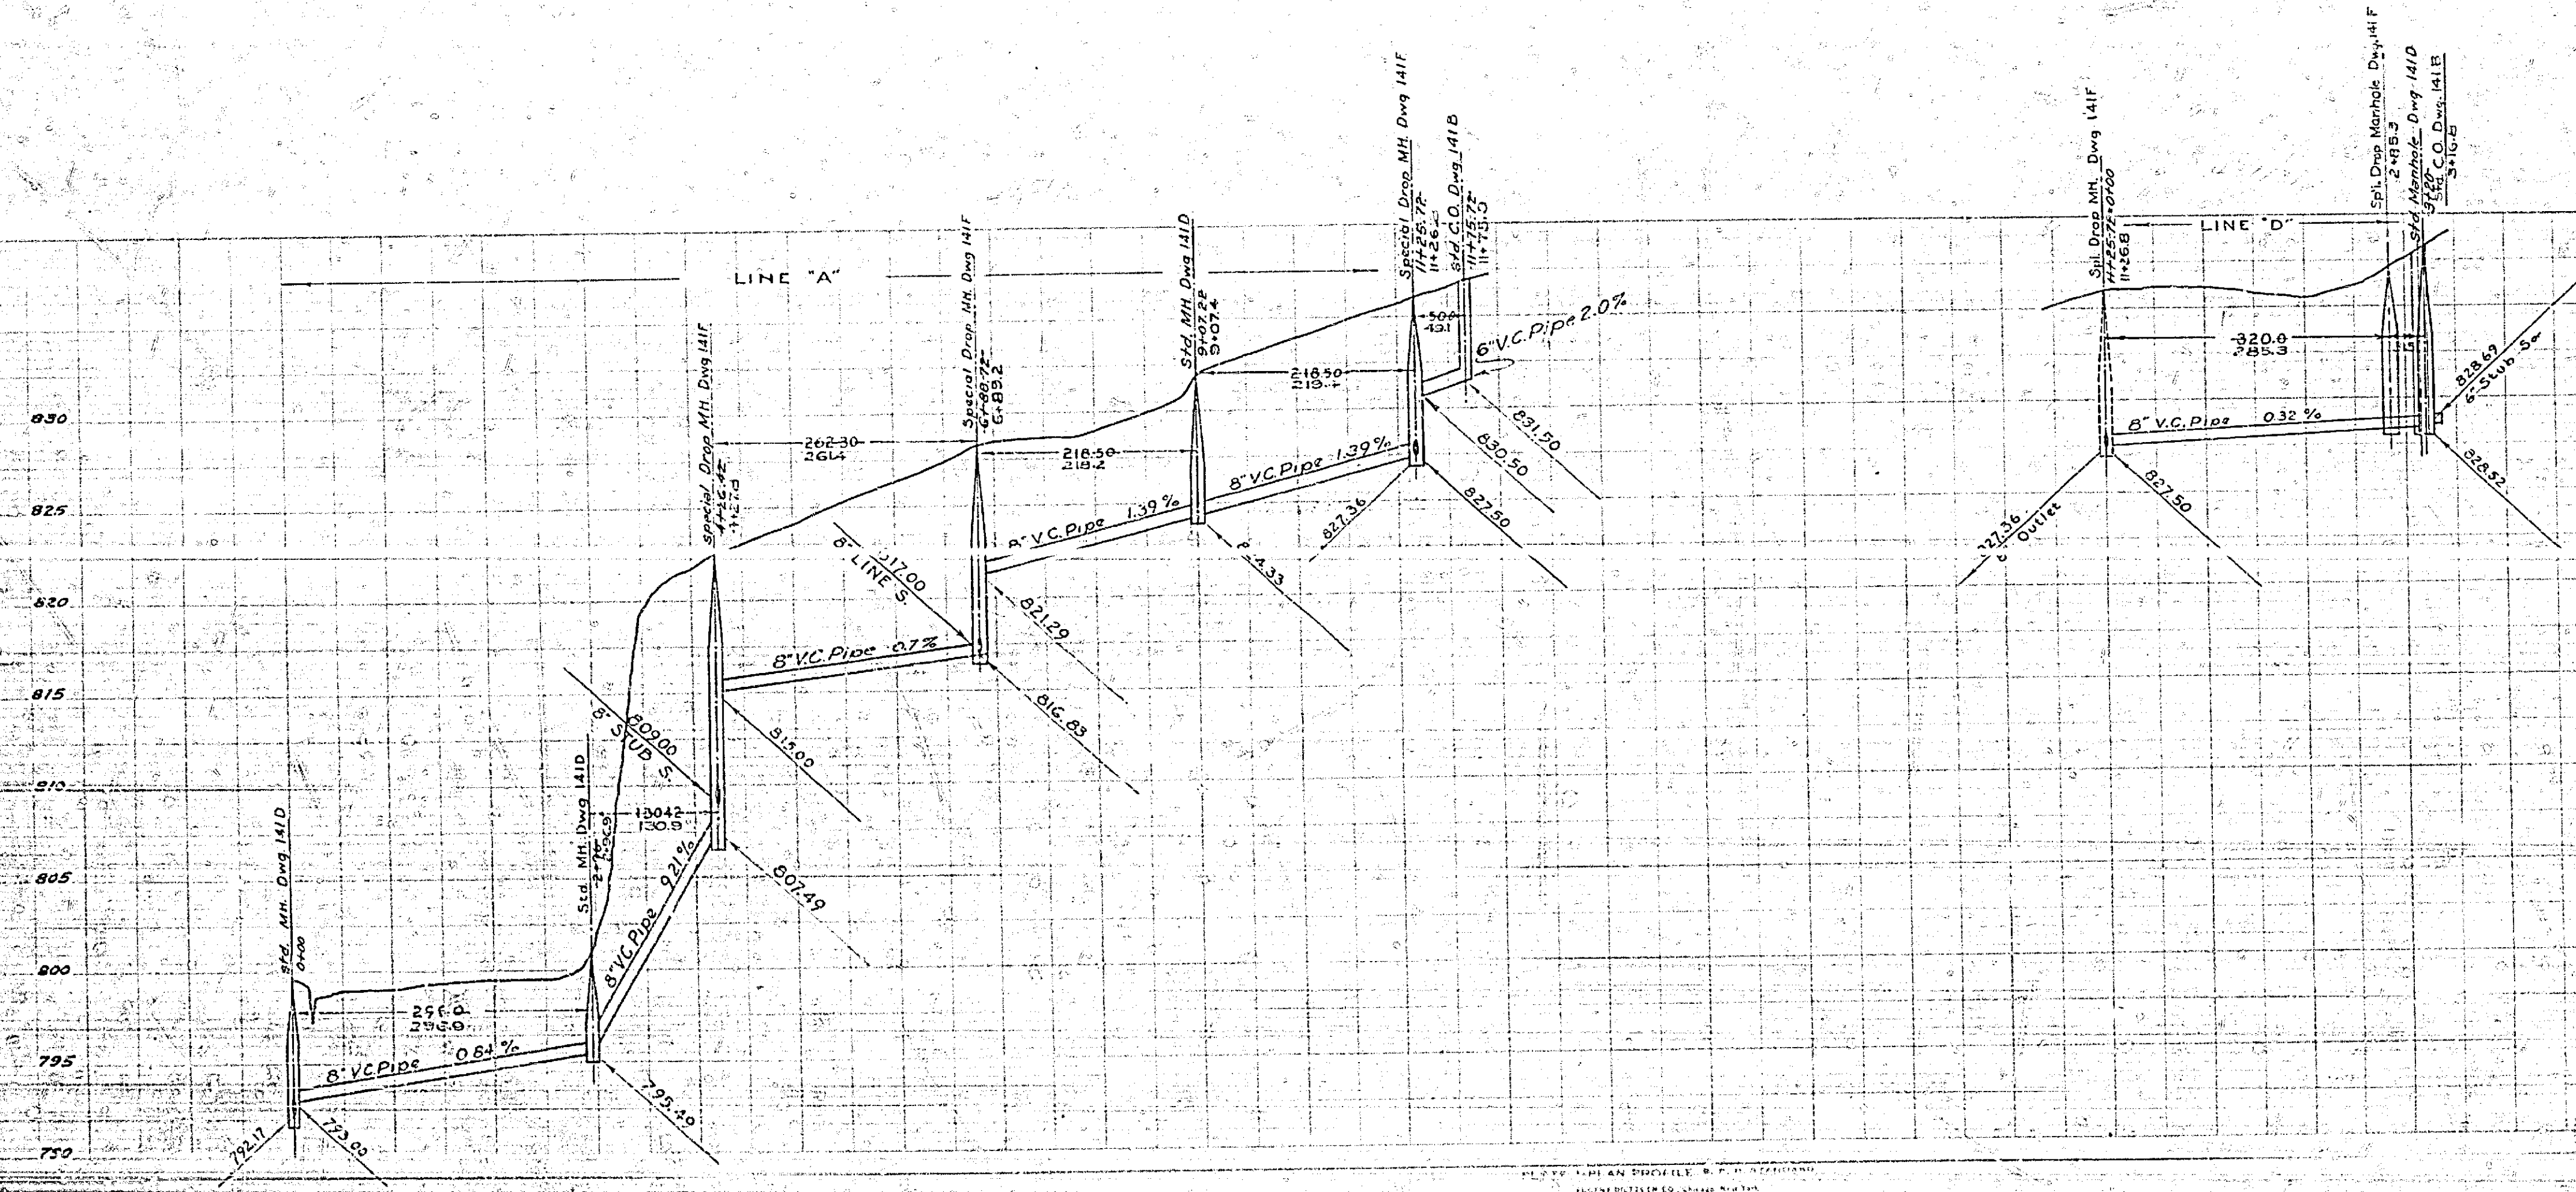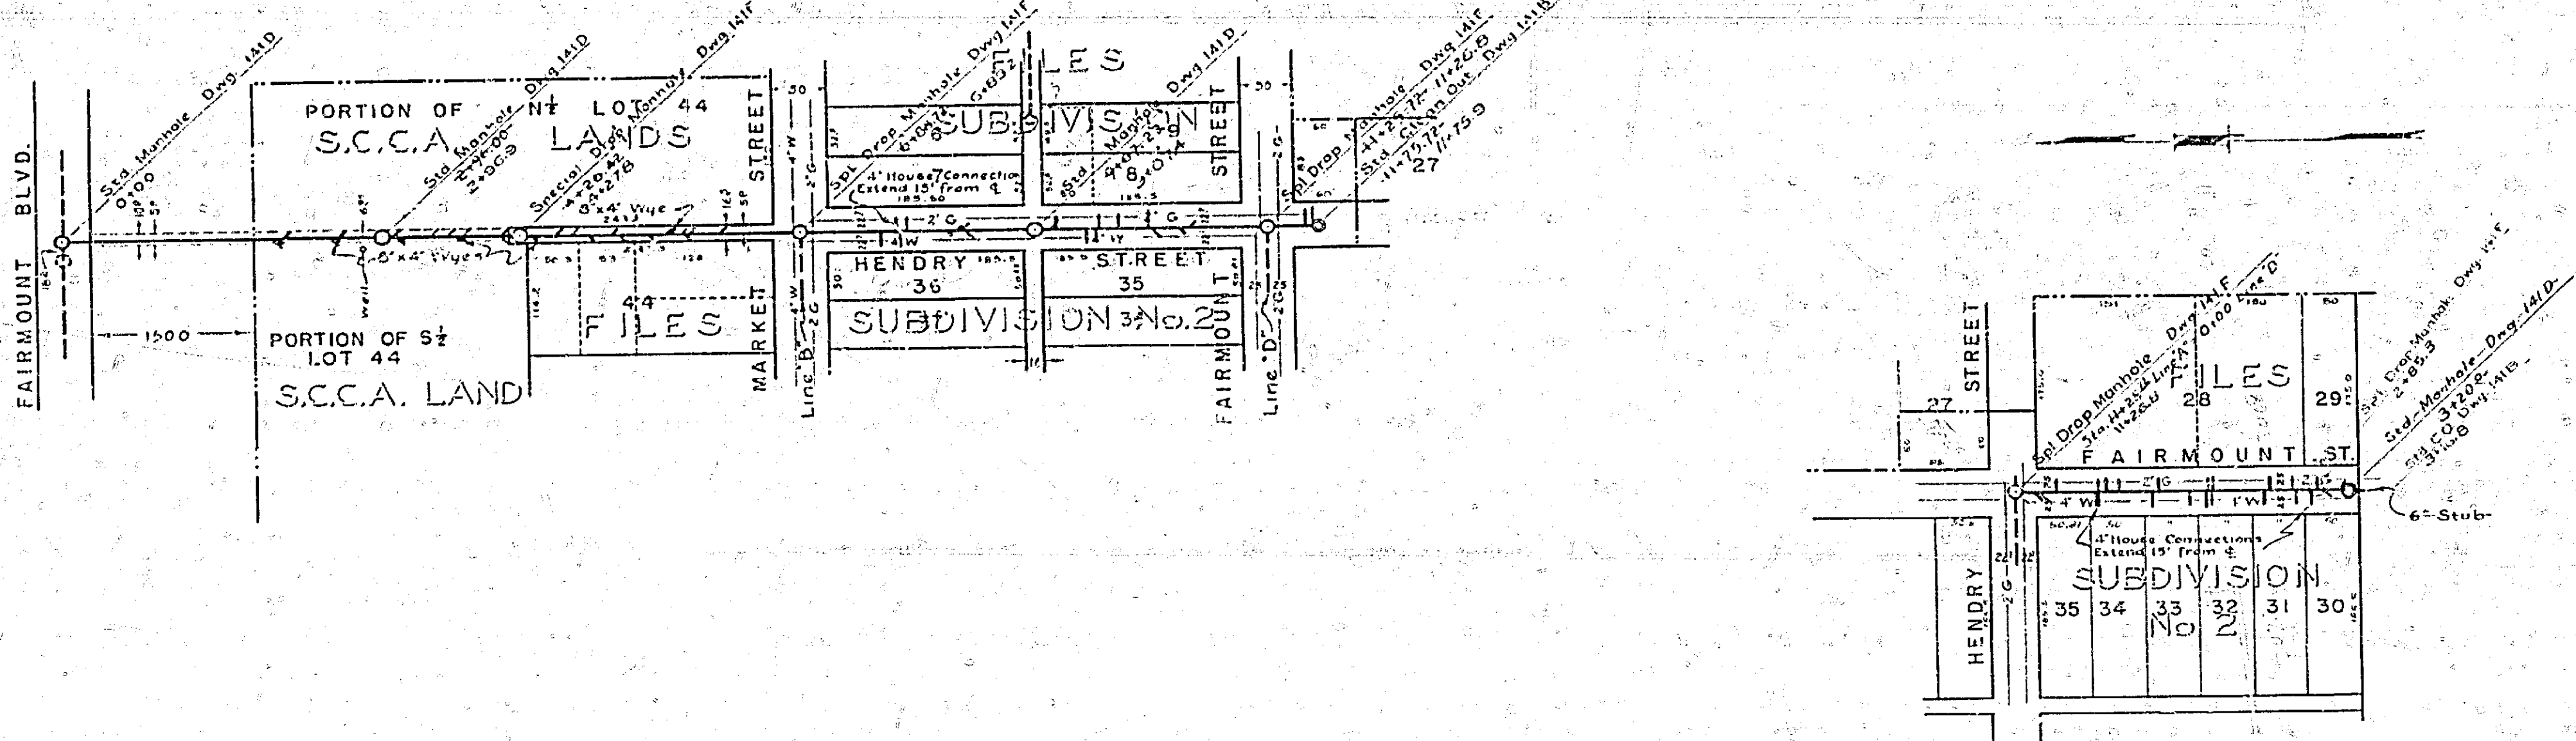


NOTE: RED LINE SHOWS SEWER AS CONSTRUCTED.
E.B. 451 PG. 201, 31.


756

22"
17"
11"
8.5"
11"
8.5"
17"
22"

22"
17"
11"
8.5"
8.5"
11"
17"
22"

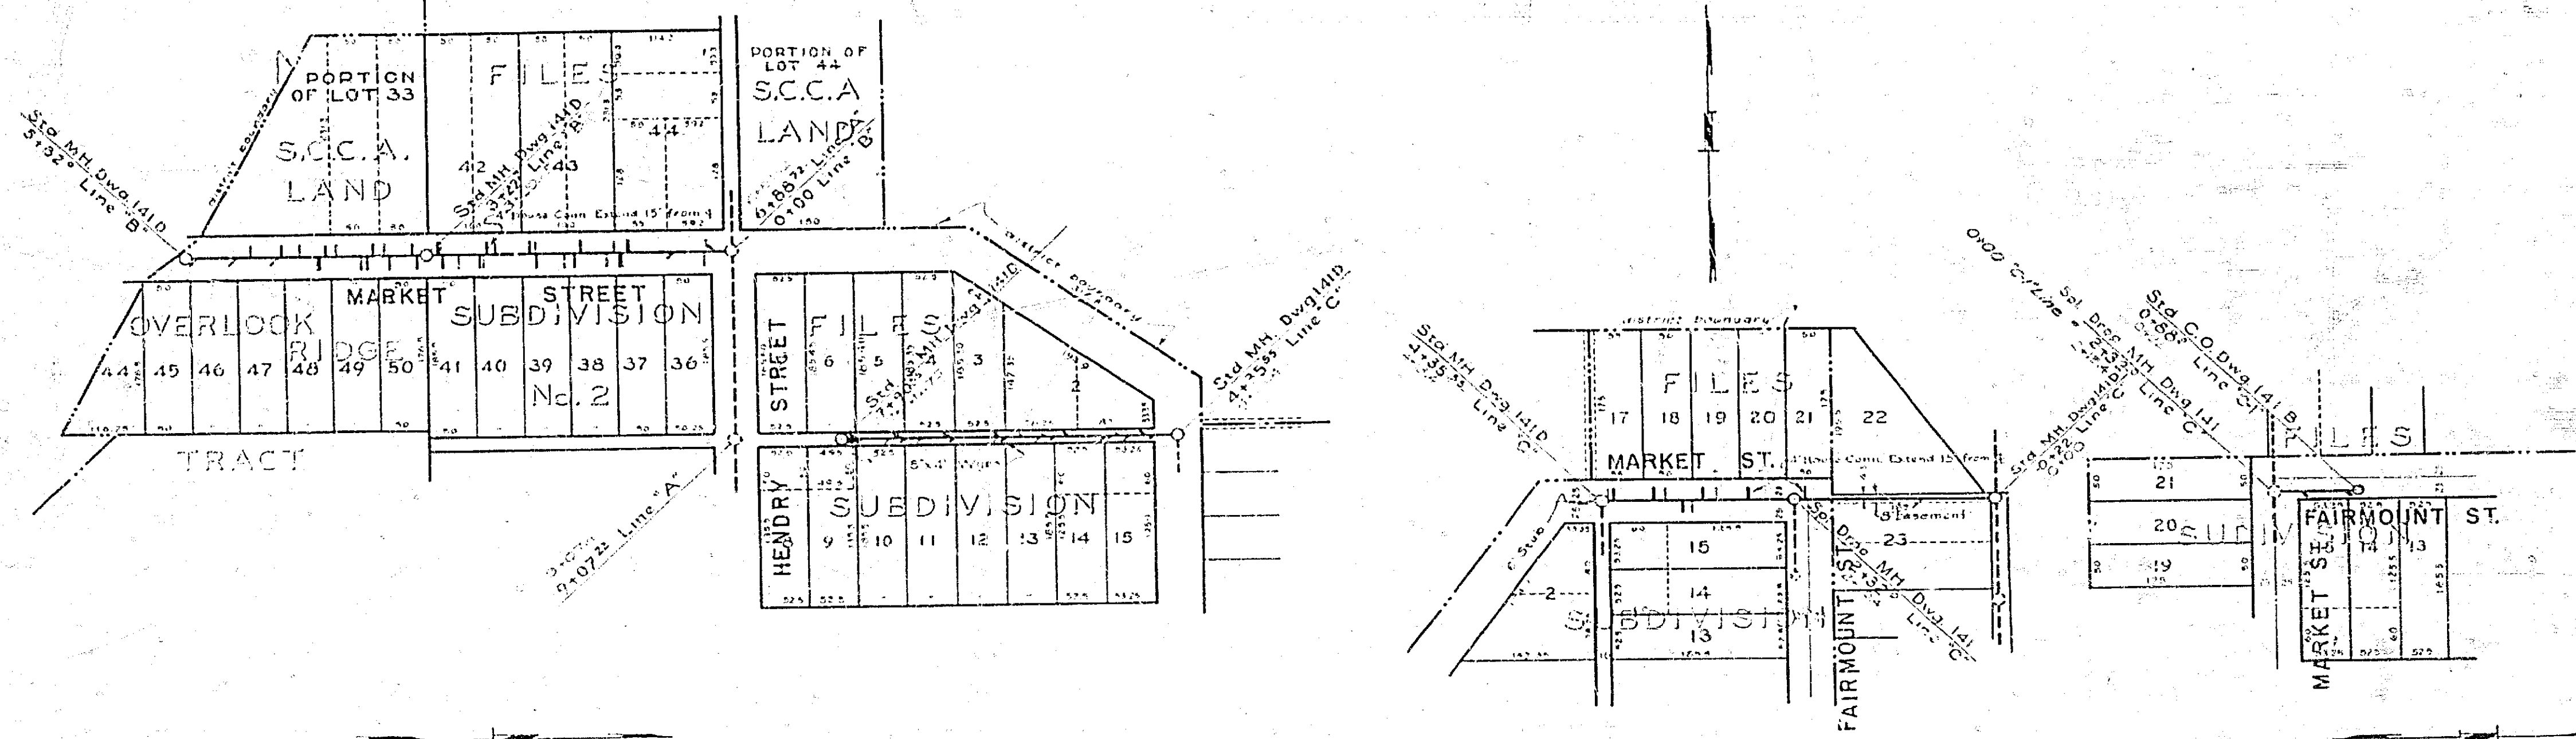

NOTE: RED LINE SHOWS SEWER AS CONSTRUCTED
 F.B. 151 Pgs. 19, 22, 32

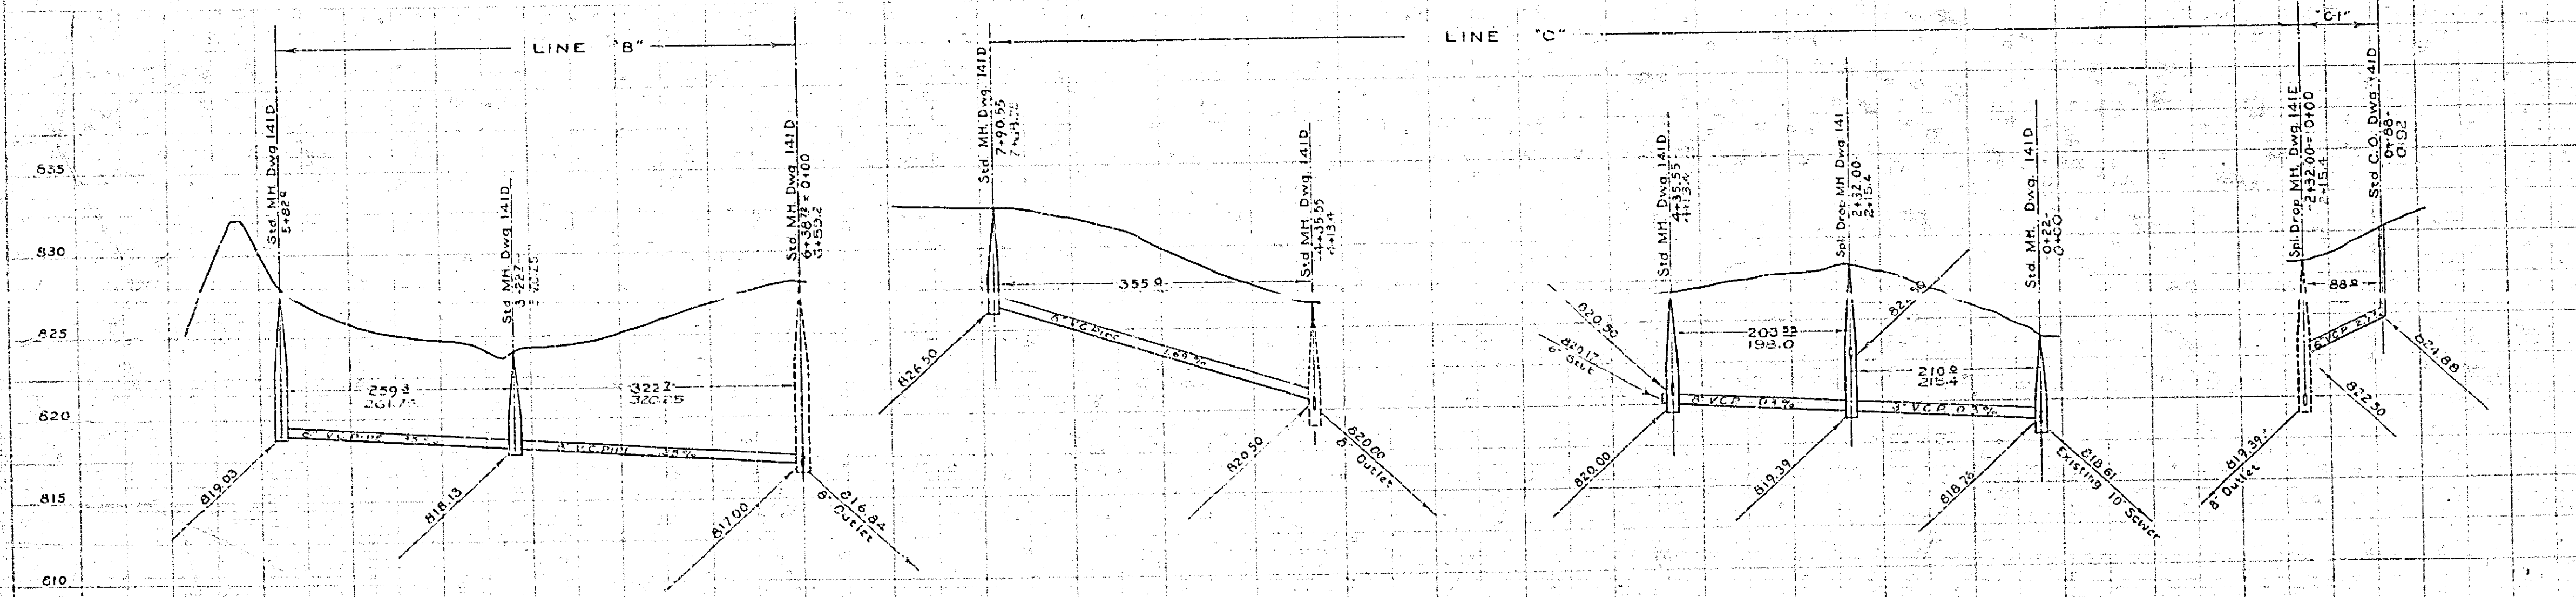

756