


PLANS & PROFILES
 NO. 758
 OF
ORANGE — HOLDING STREETS
SEWER DISTRICT
 RIVERSIDE, CALIFORNIA

SCALE: 1"=100'-0"


APPROVED: *M. H. Savin*
 CITY ENGINEER
 A CIVIL ENGINEER REGISTERED UNDER
 THE LAWS OF THE STATE OF CALIFORNIA
 REG. C.E. 3011

THESE PLANS APPROVED AND ADOPTED BY THE MAYOR AND
 COUNCIL OF THE CITY OF RIVERSIDE, STATE OF CALIFORNIA
 ON THIS 24 DAY OF December 1947
James S. ...
 CITY CLERK
 OF RIVERSIDE, STATE OF CALIFORNIA

758

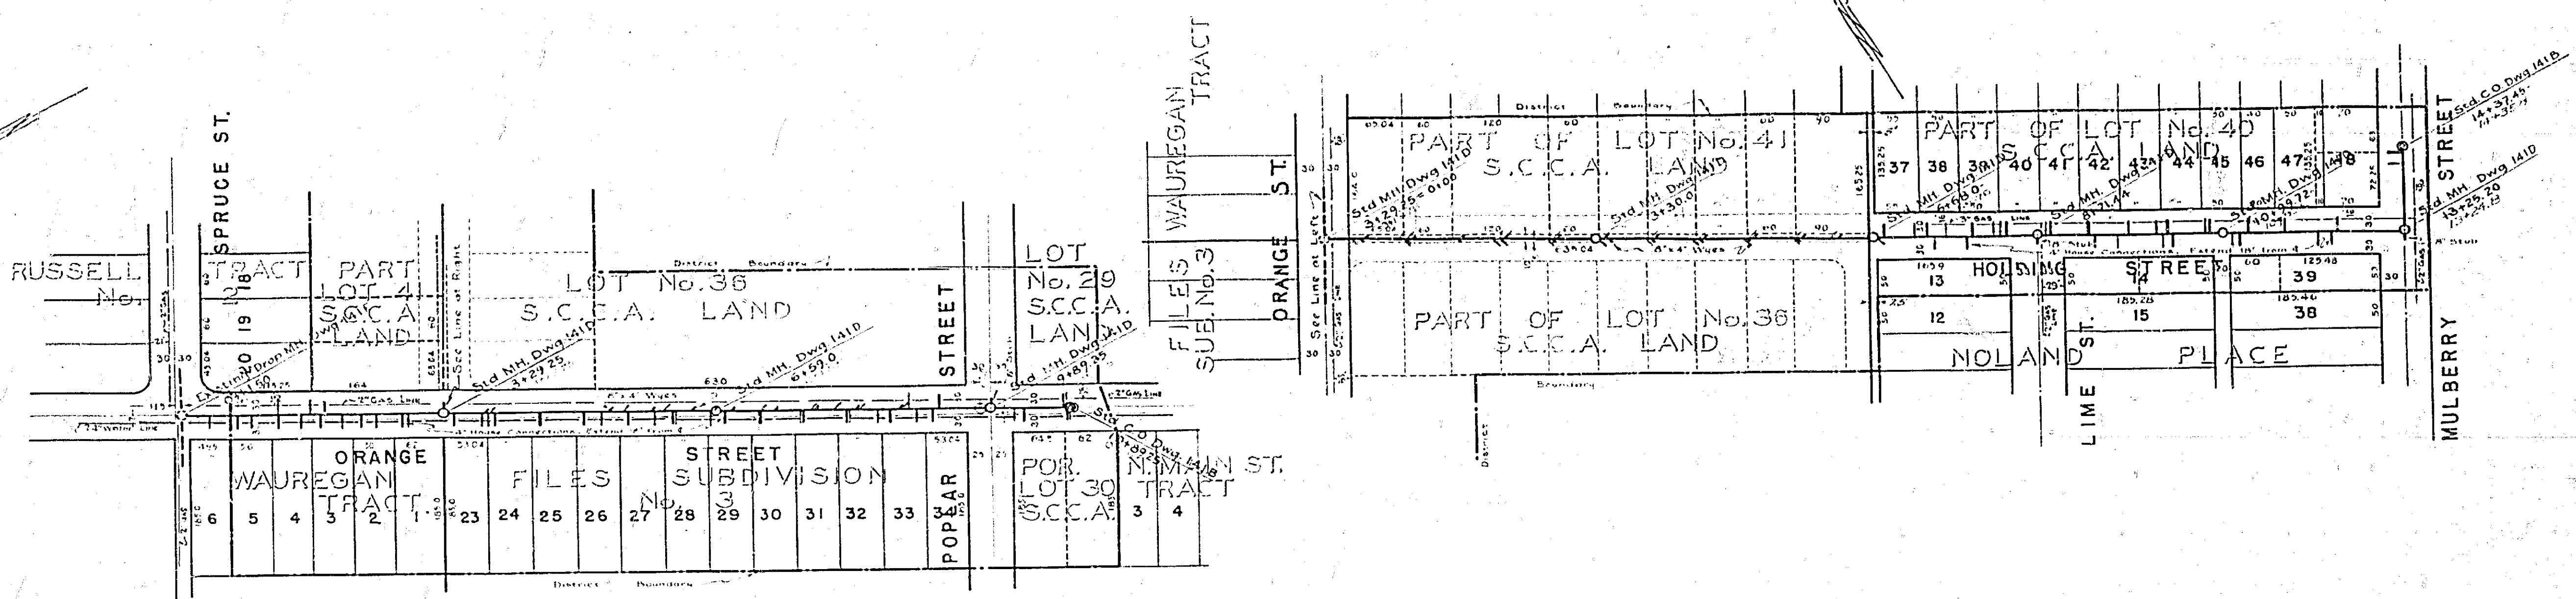

NOTE: RED LINE SHOWS CHANGE AS CONSTRUCTED. F.B. 451, PG. 34, 38-17

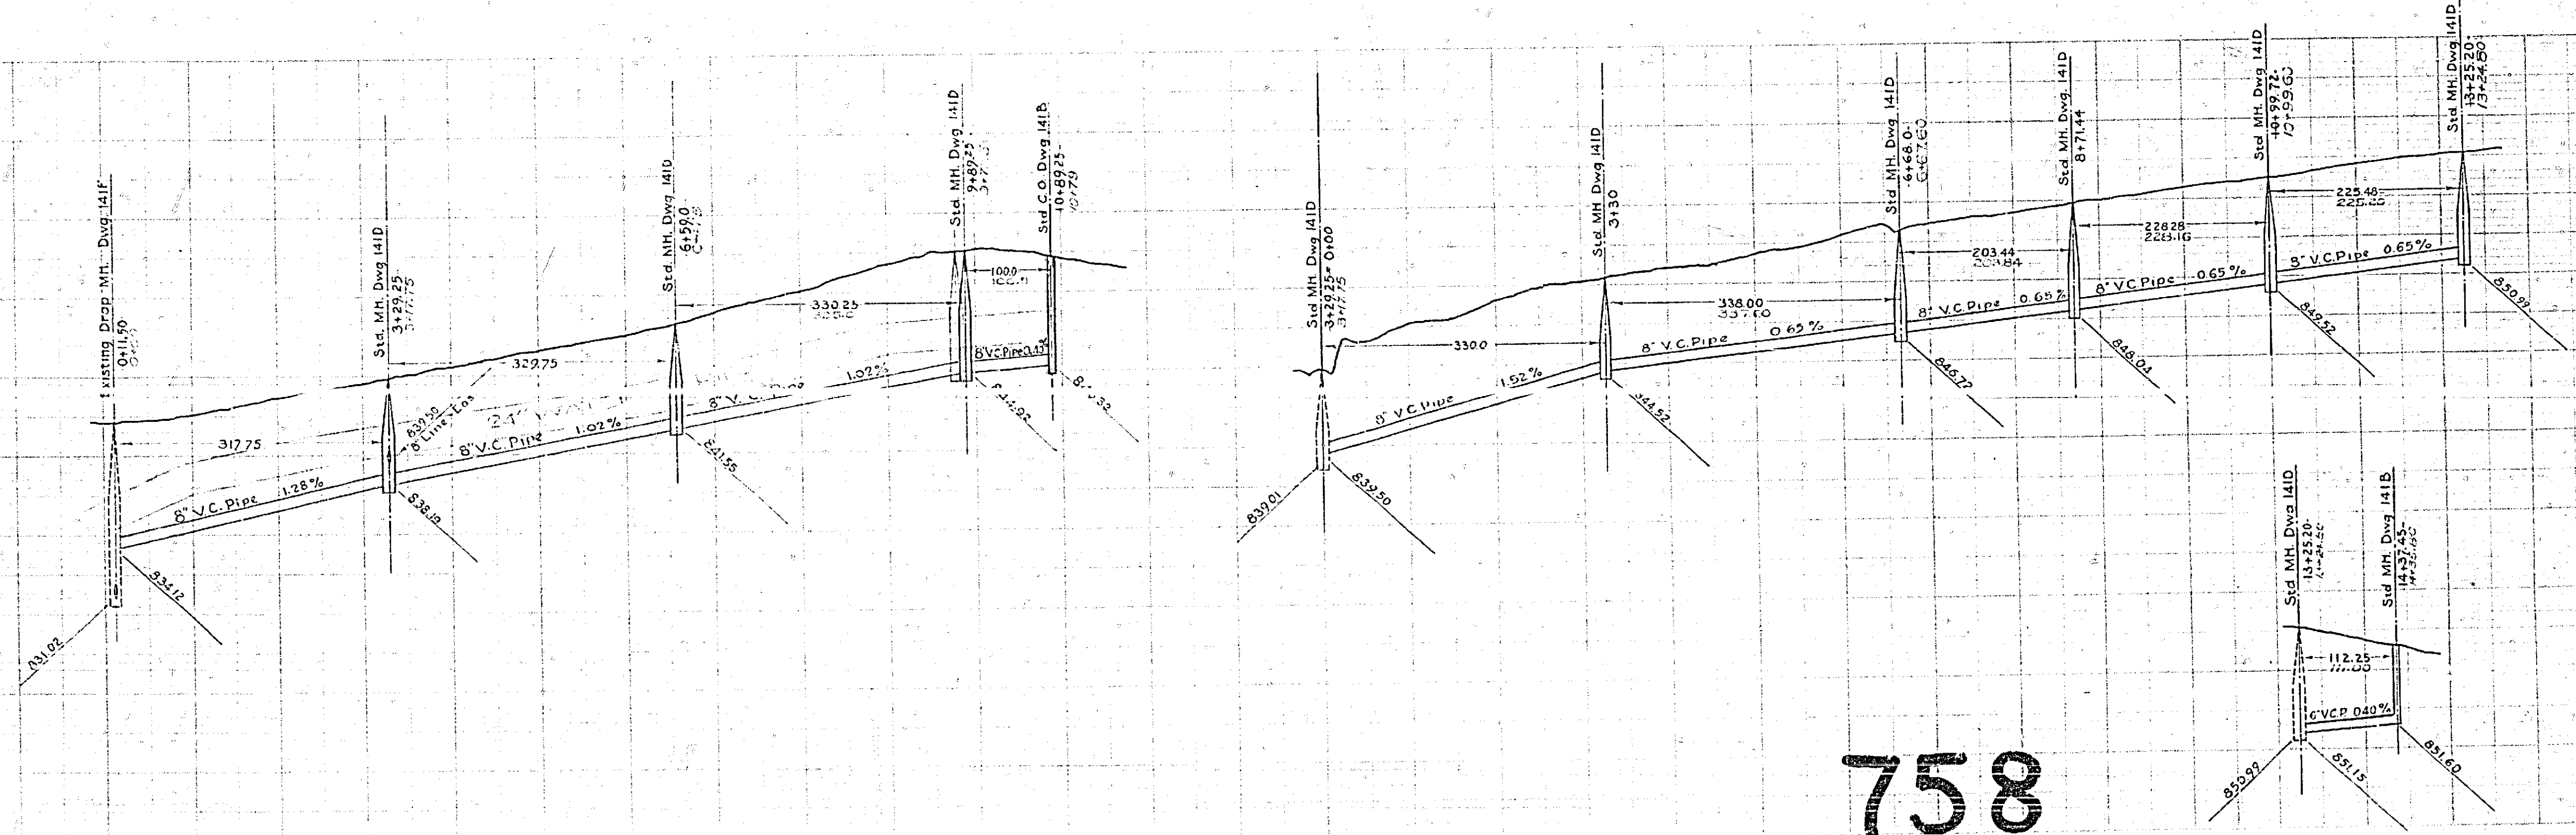

758