
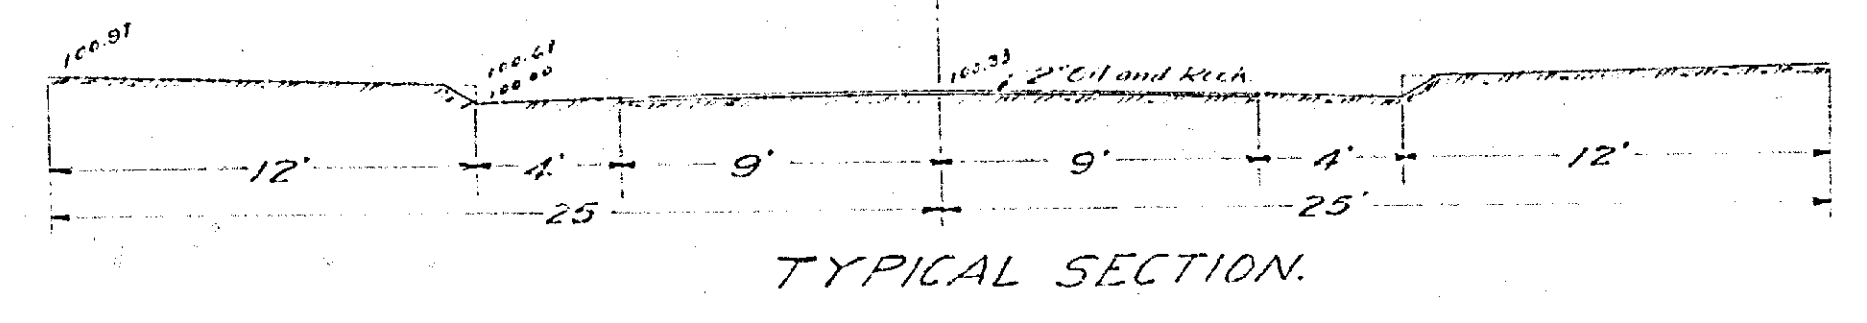


Constructed by Street Dept 1934.

PLAN & PROFILE  
**ROBERTSON STREET.**  
 CITY OF RIVERSIDE ENG. DEPT.  
 MARCH 1934  
 F.B. 280-65  
 1" = 40'

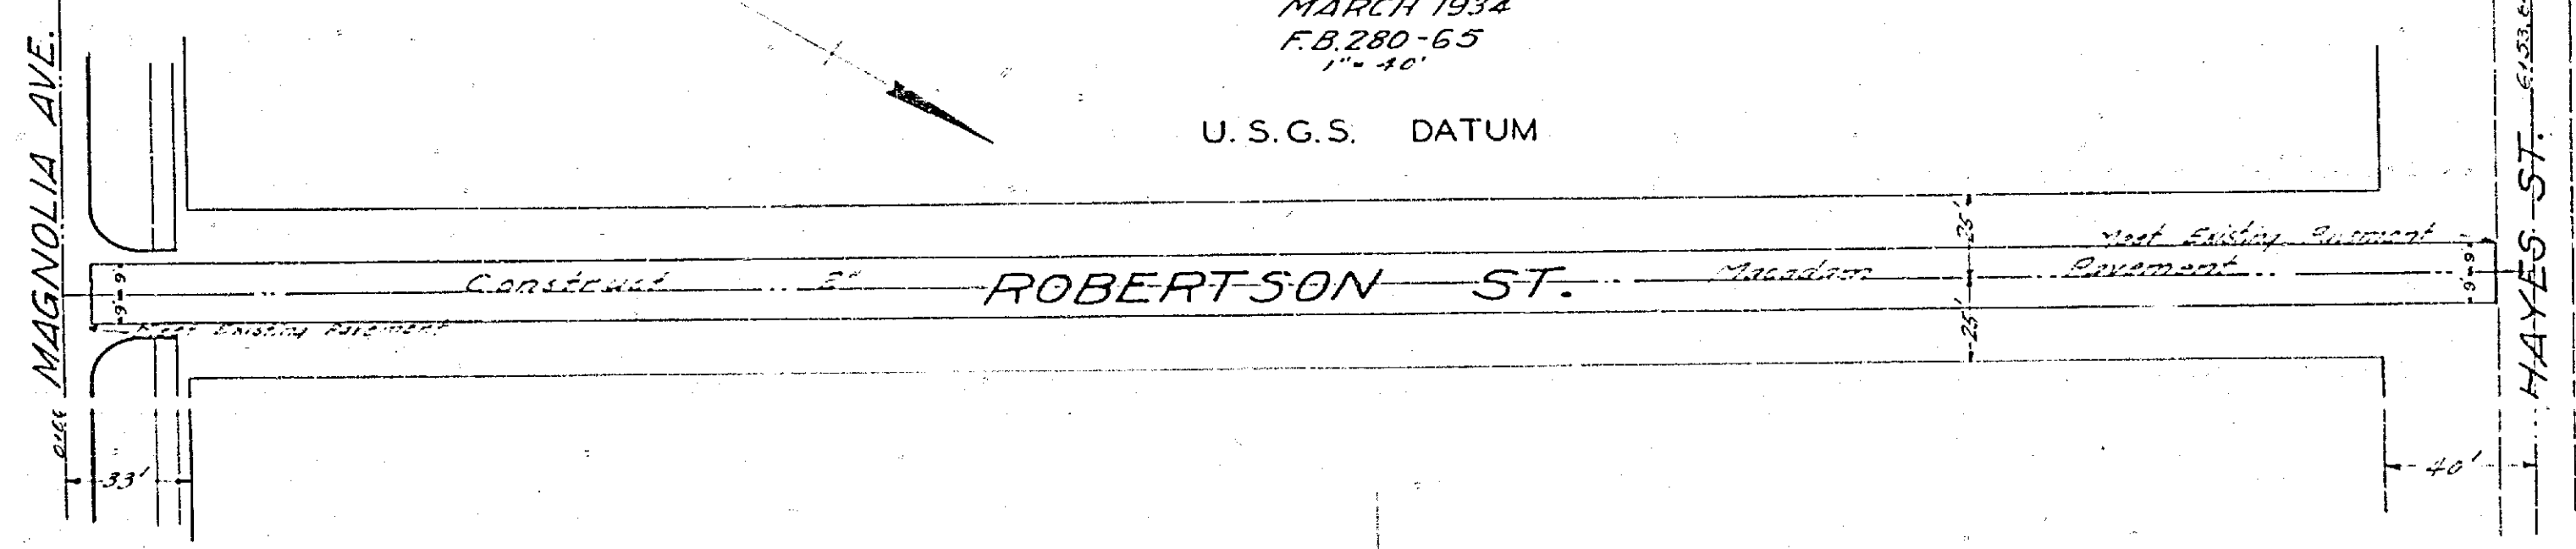

APPROVED AND ADOPTED BY THE MAYOR AND  
 COUNCIL OF THE CITY OF RIVERSIDE THIS  
 19TH DAY OF JUNE 1934.

*Robert Miller*  
 CITY CLERK CITY OF RIVERSIDE

8419