



Victoria Ave. 5/4 from Elsinore Road
440/71



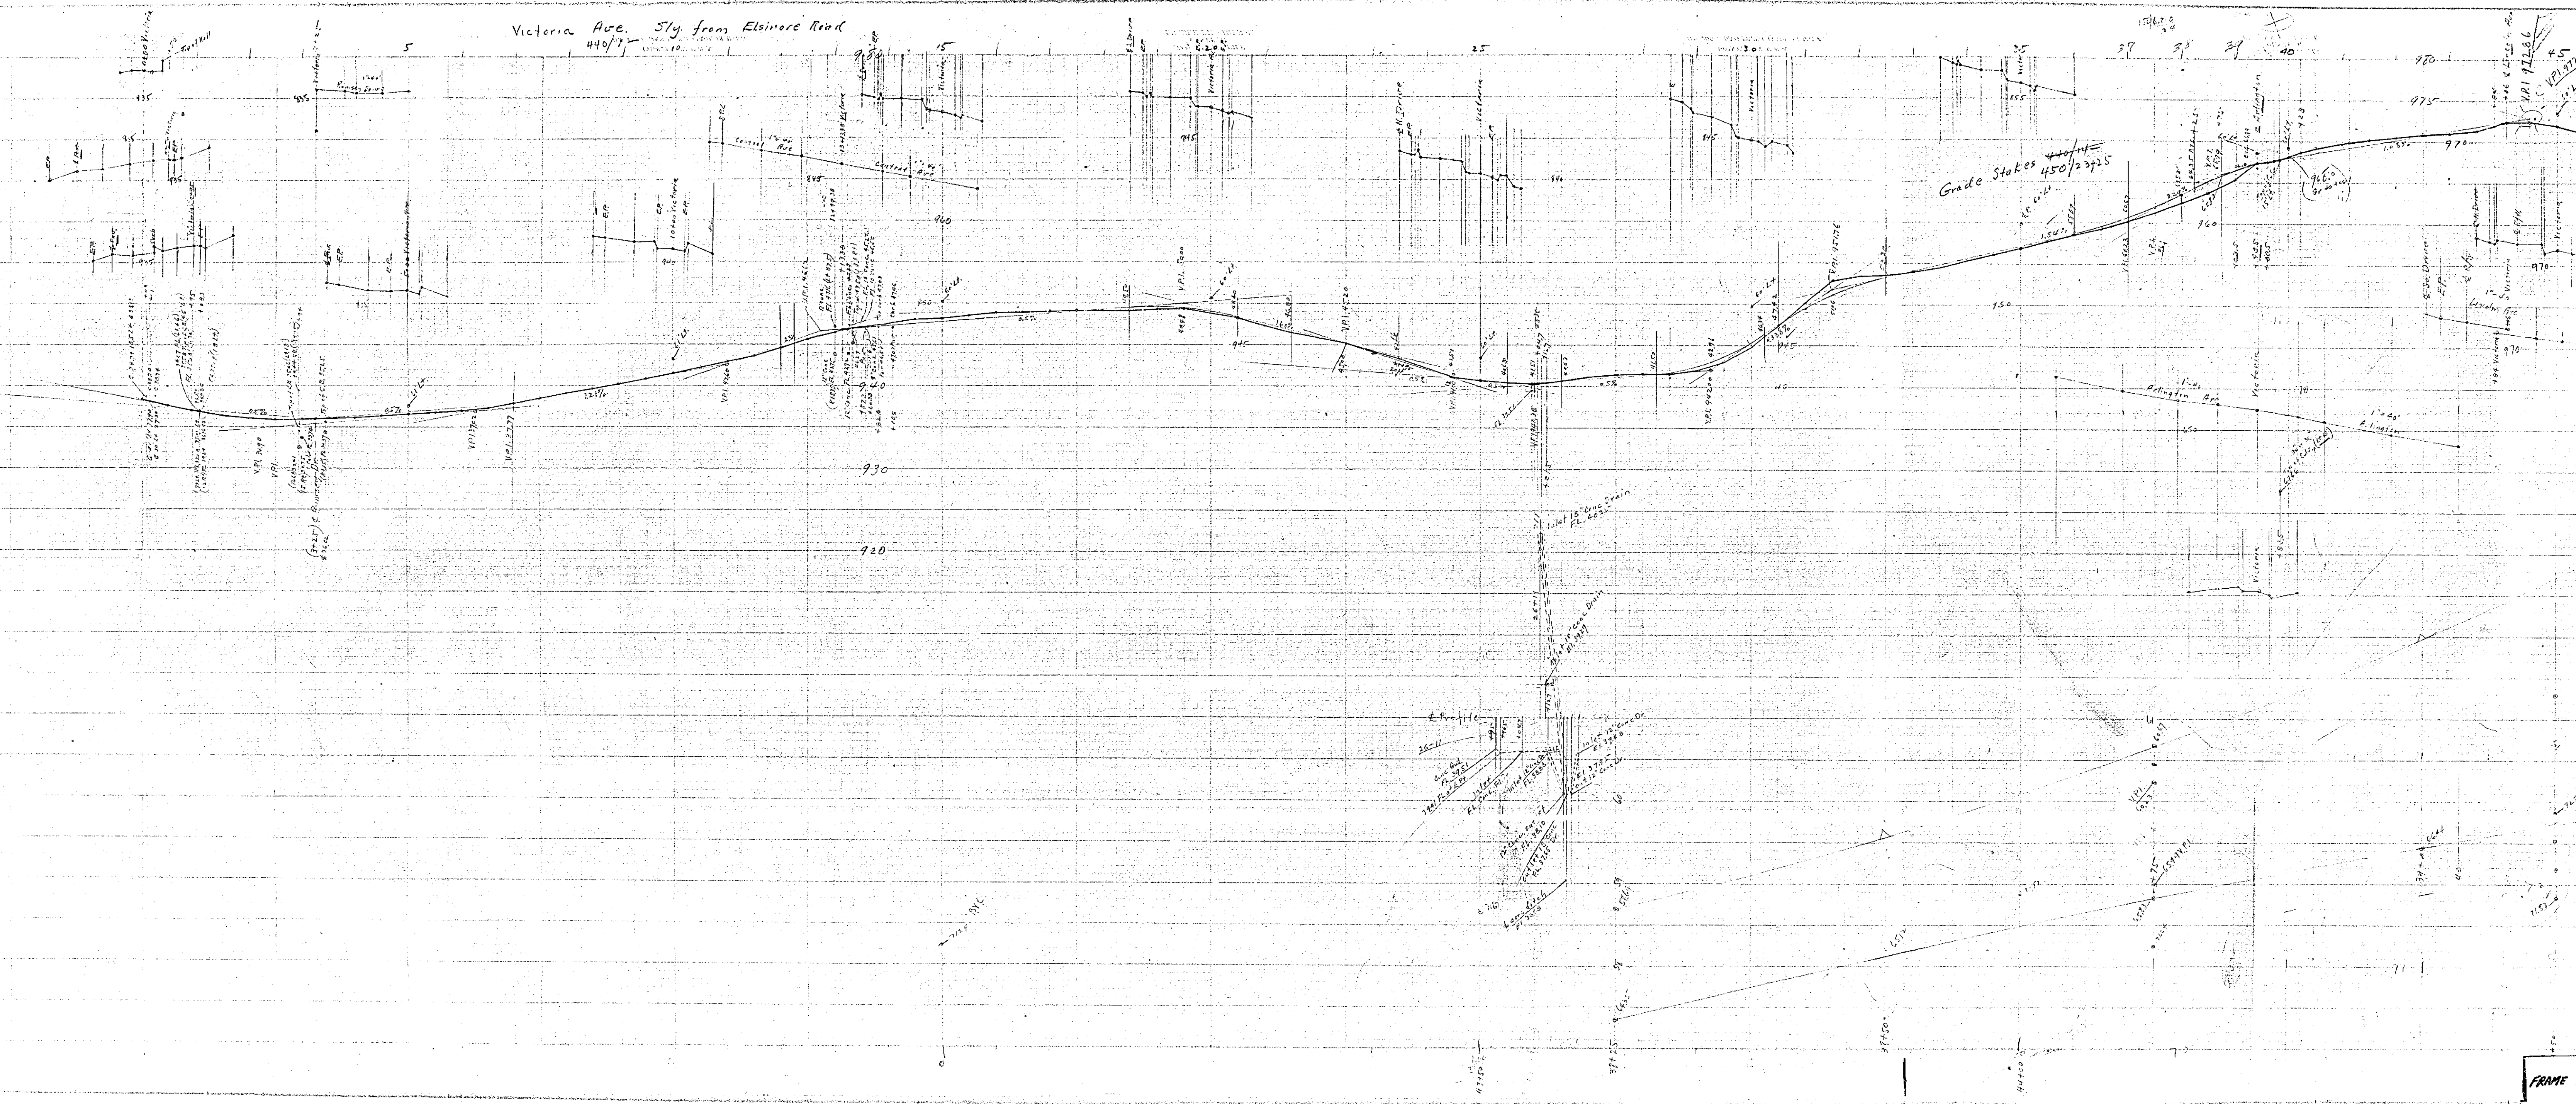

FRAME 2 OF B10

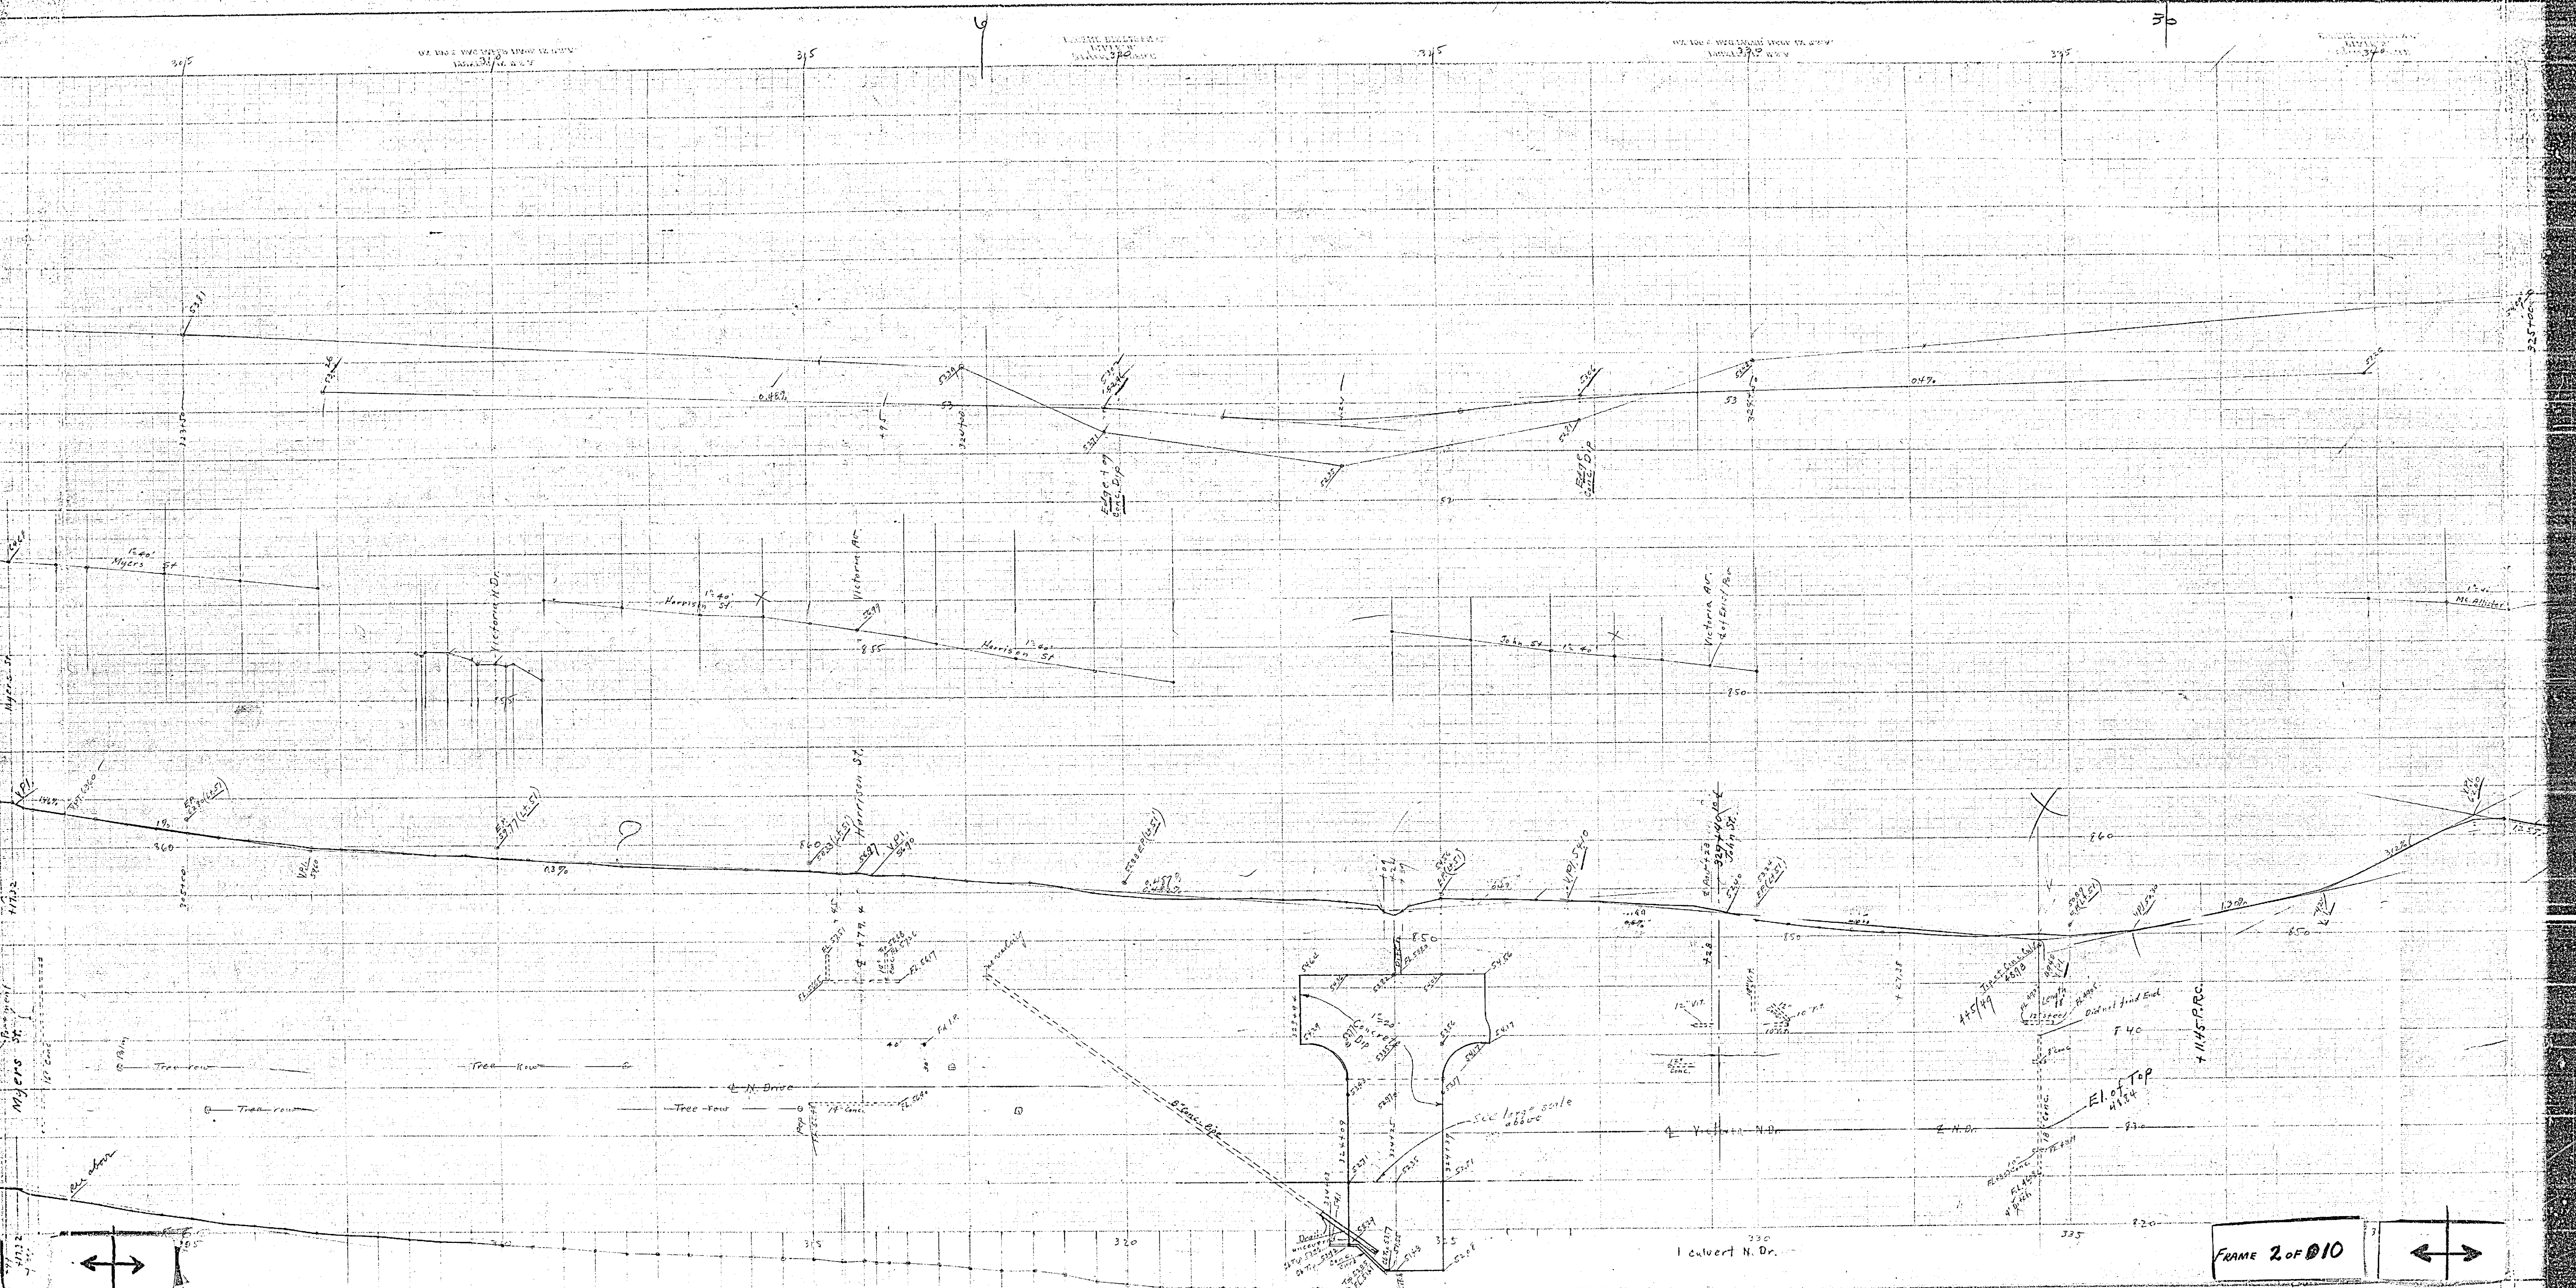

24


275

280

285

295

27

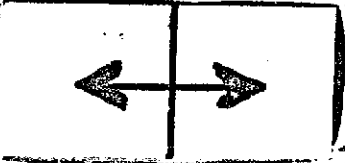

270

275


280

285

295

447

FRAME 3 OF 10

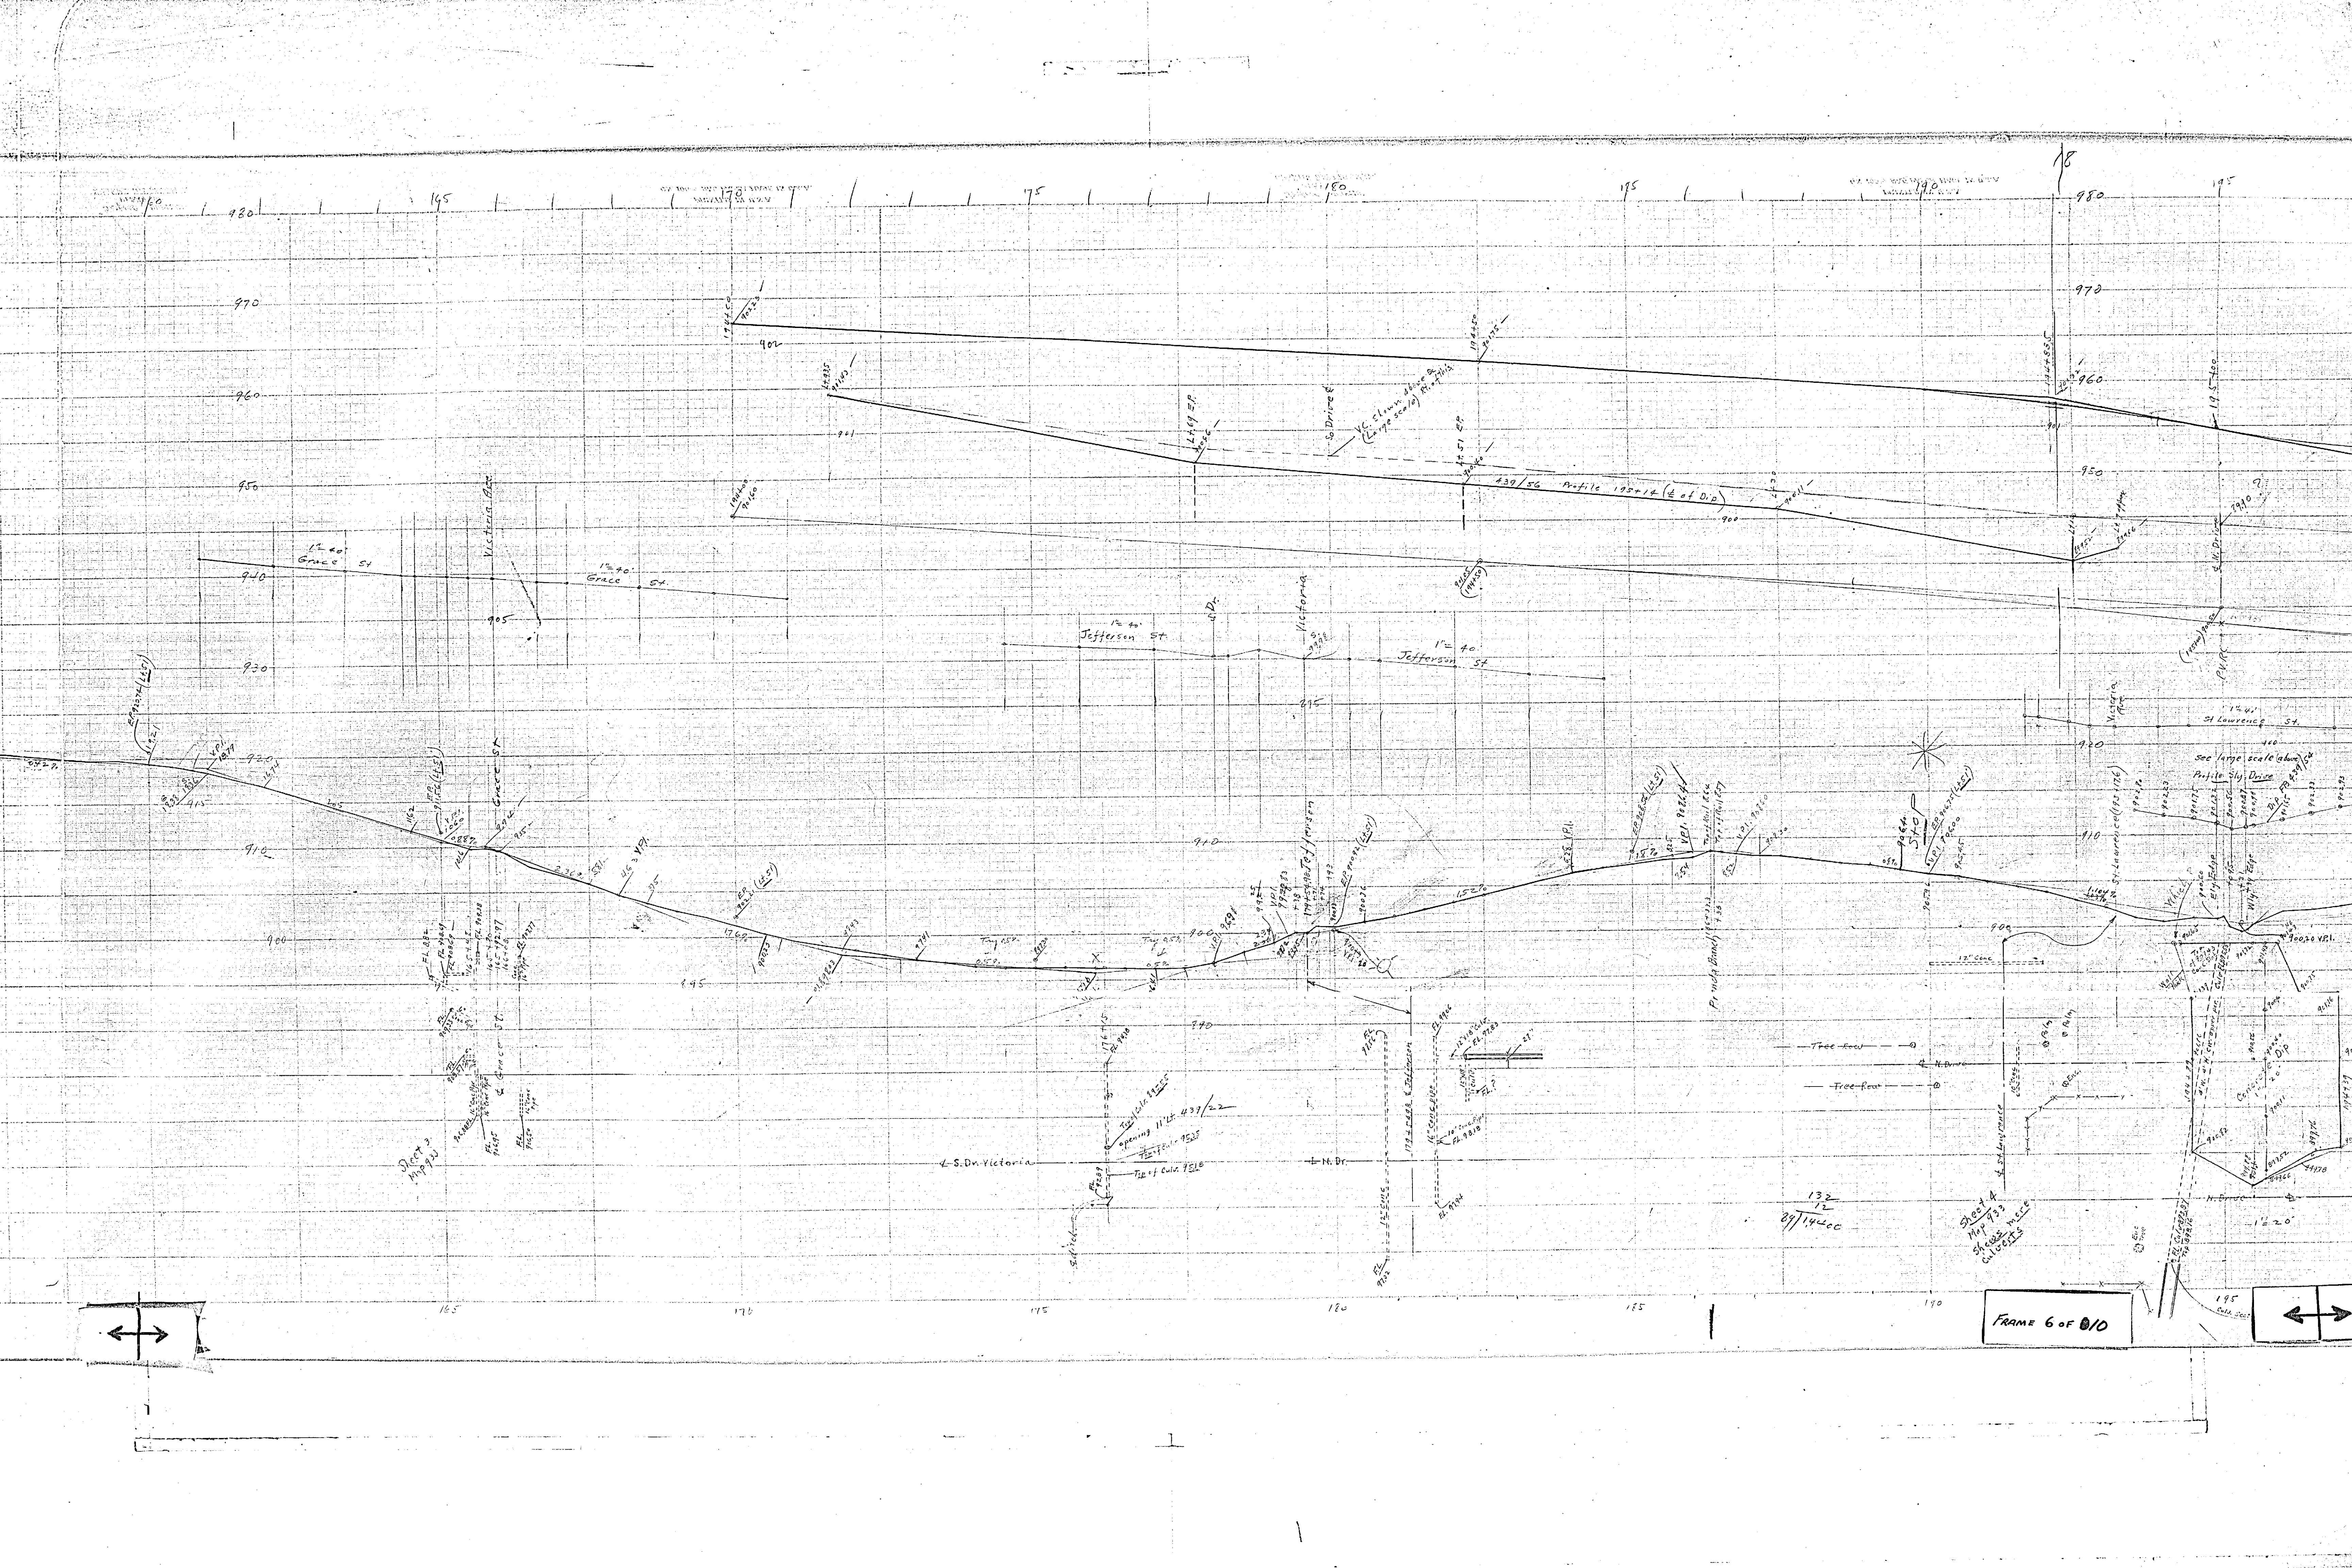

FRAME 6 OF 10



132
12
29/14/00

Sheet 4
Map 733
St. Louis
City


S. Dr. Victoria

N. Dr.



195
Call

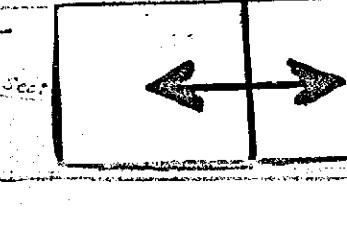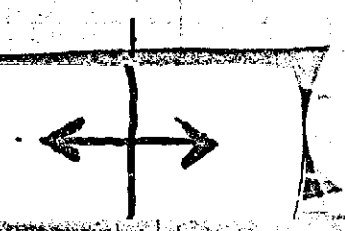

Victoria Ave South from Elsinore Road
440/1-78

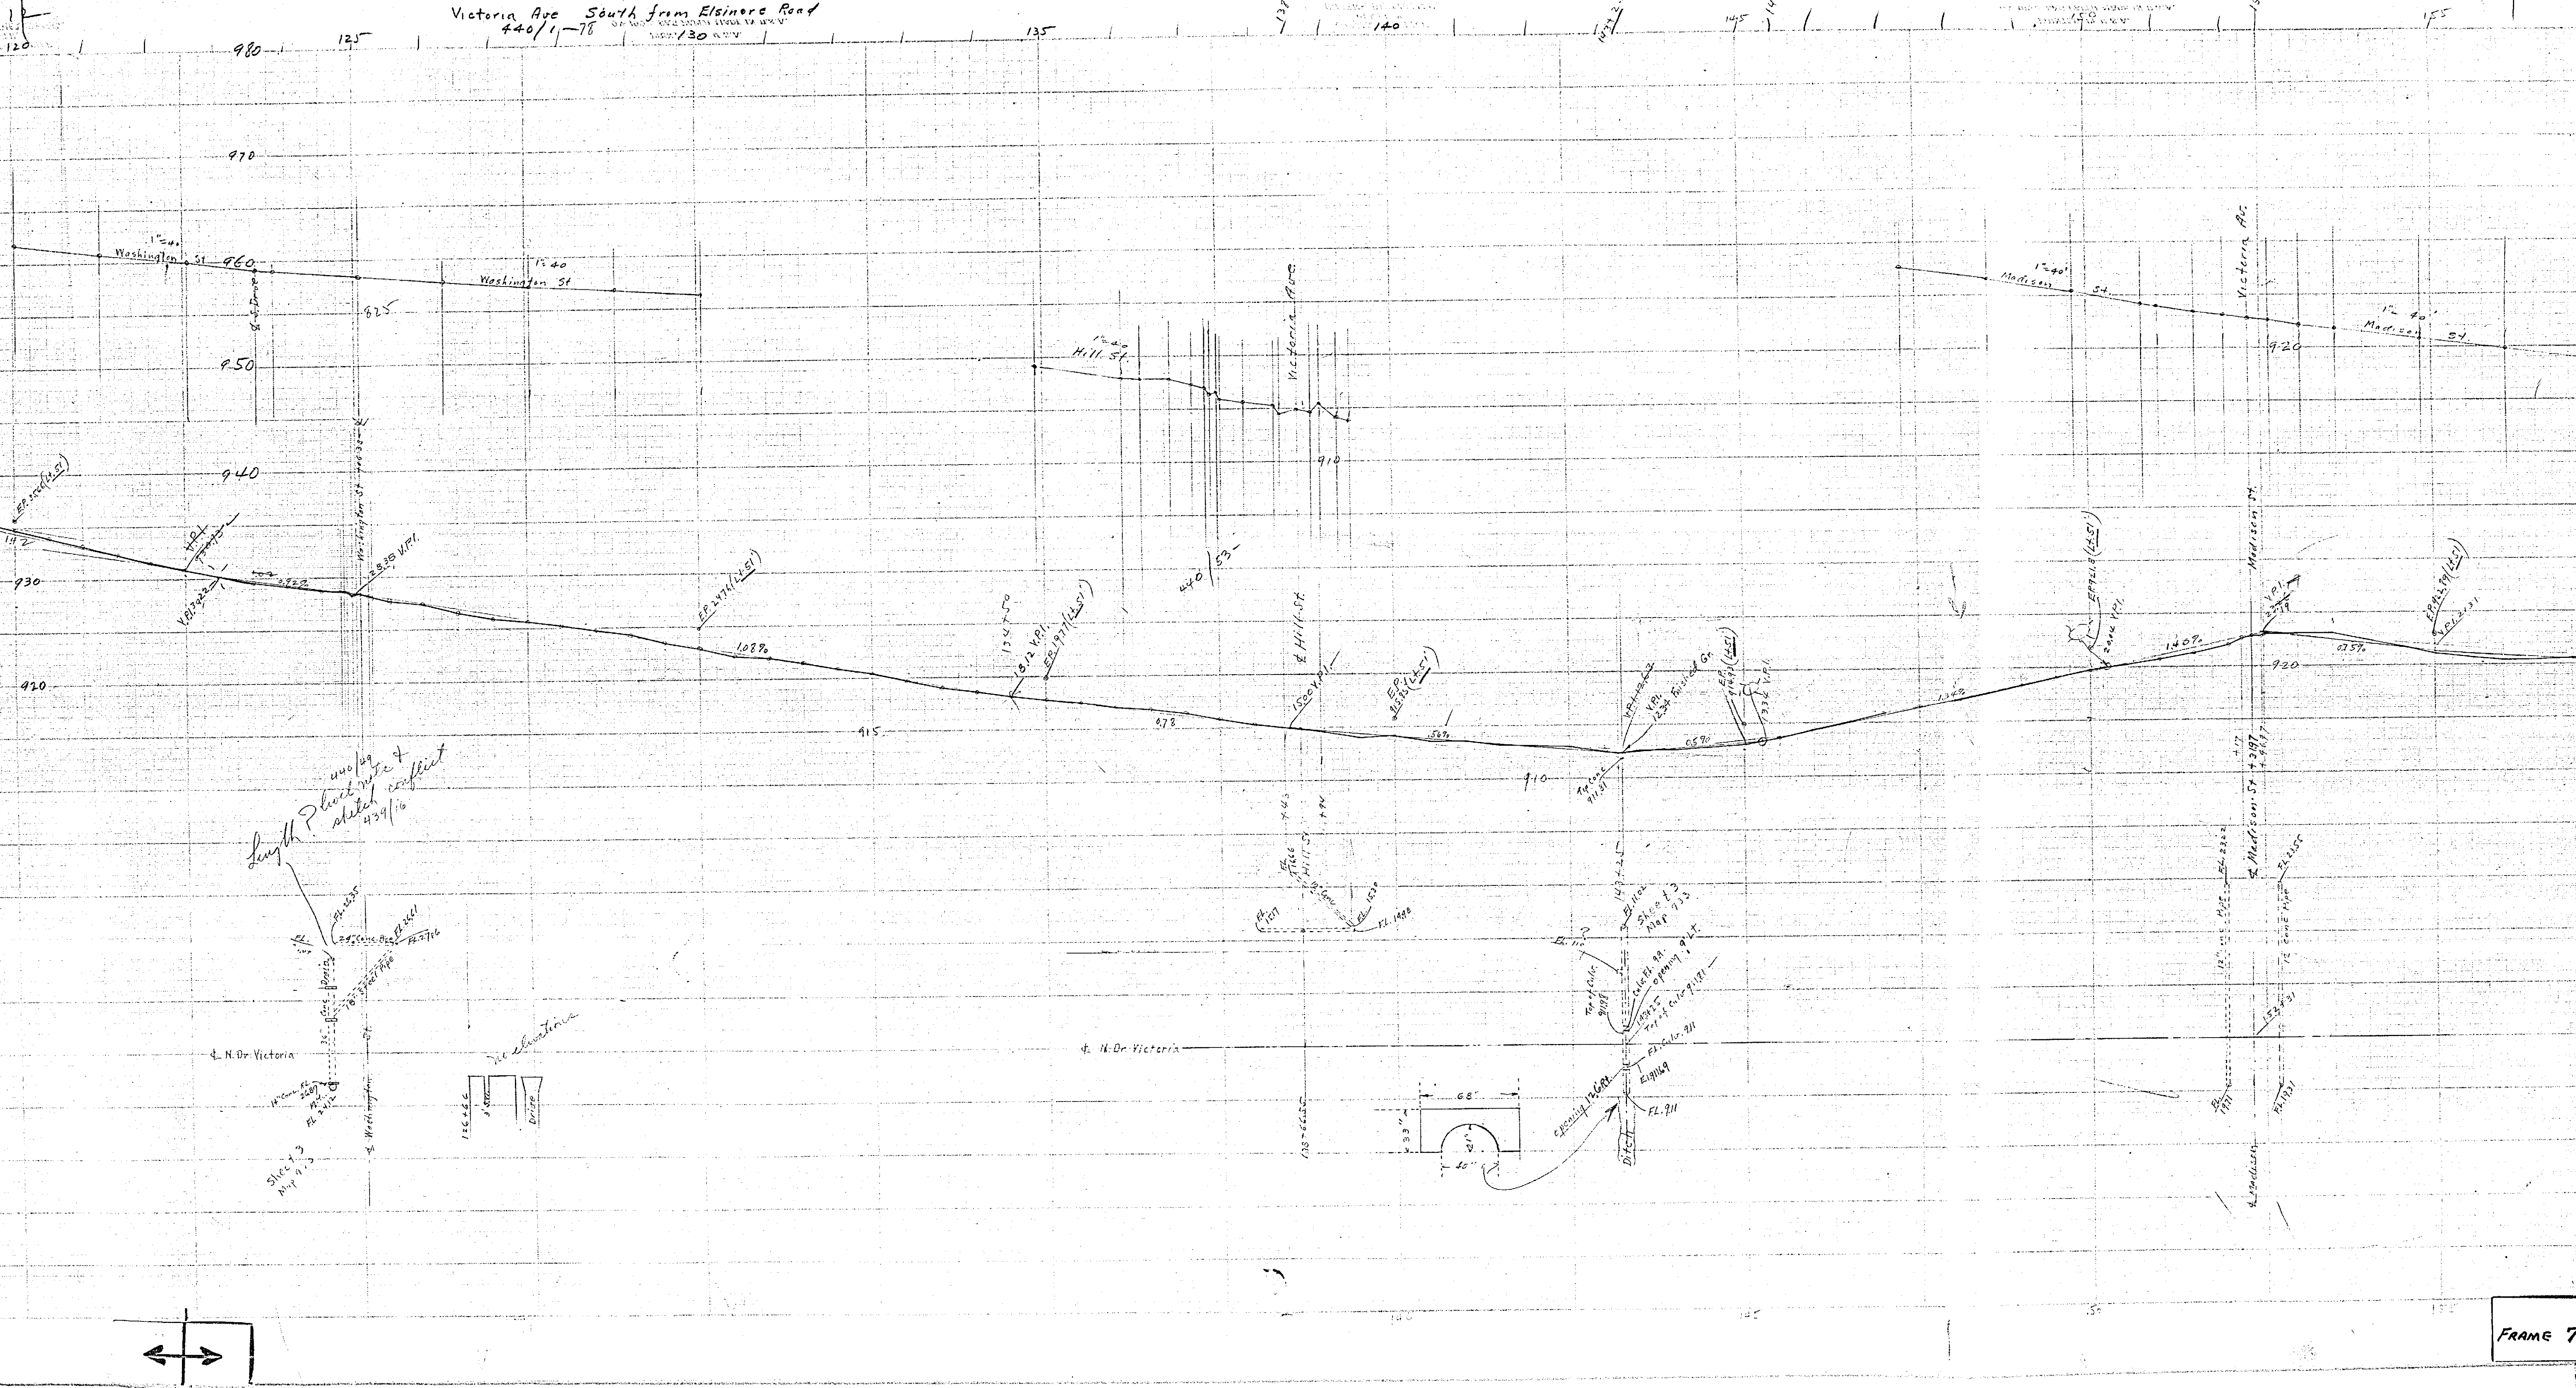

Length of level with sketch conflict
440/1-78
439/16

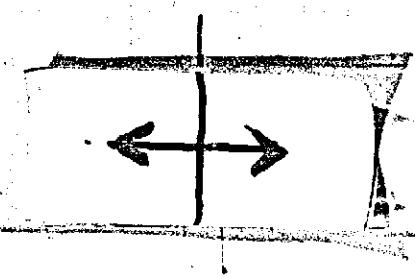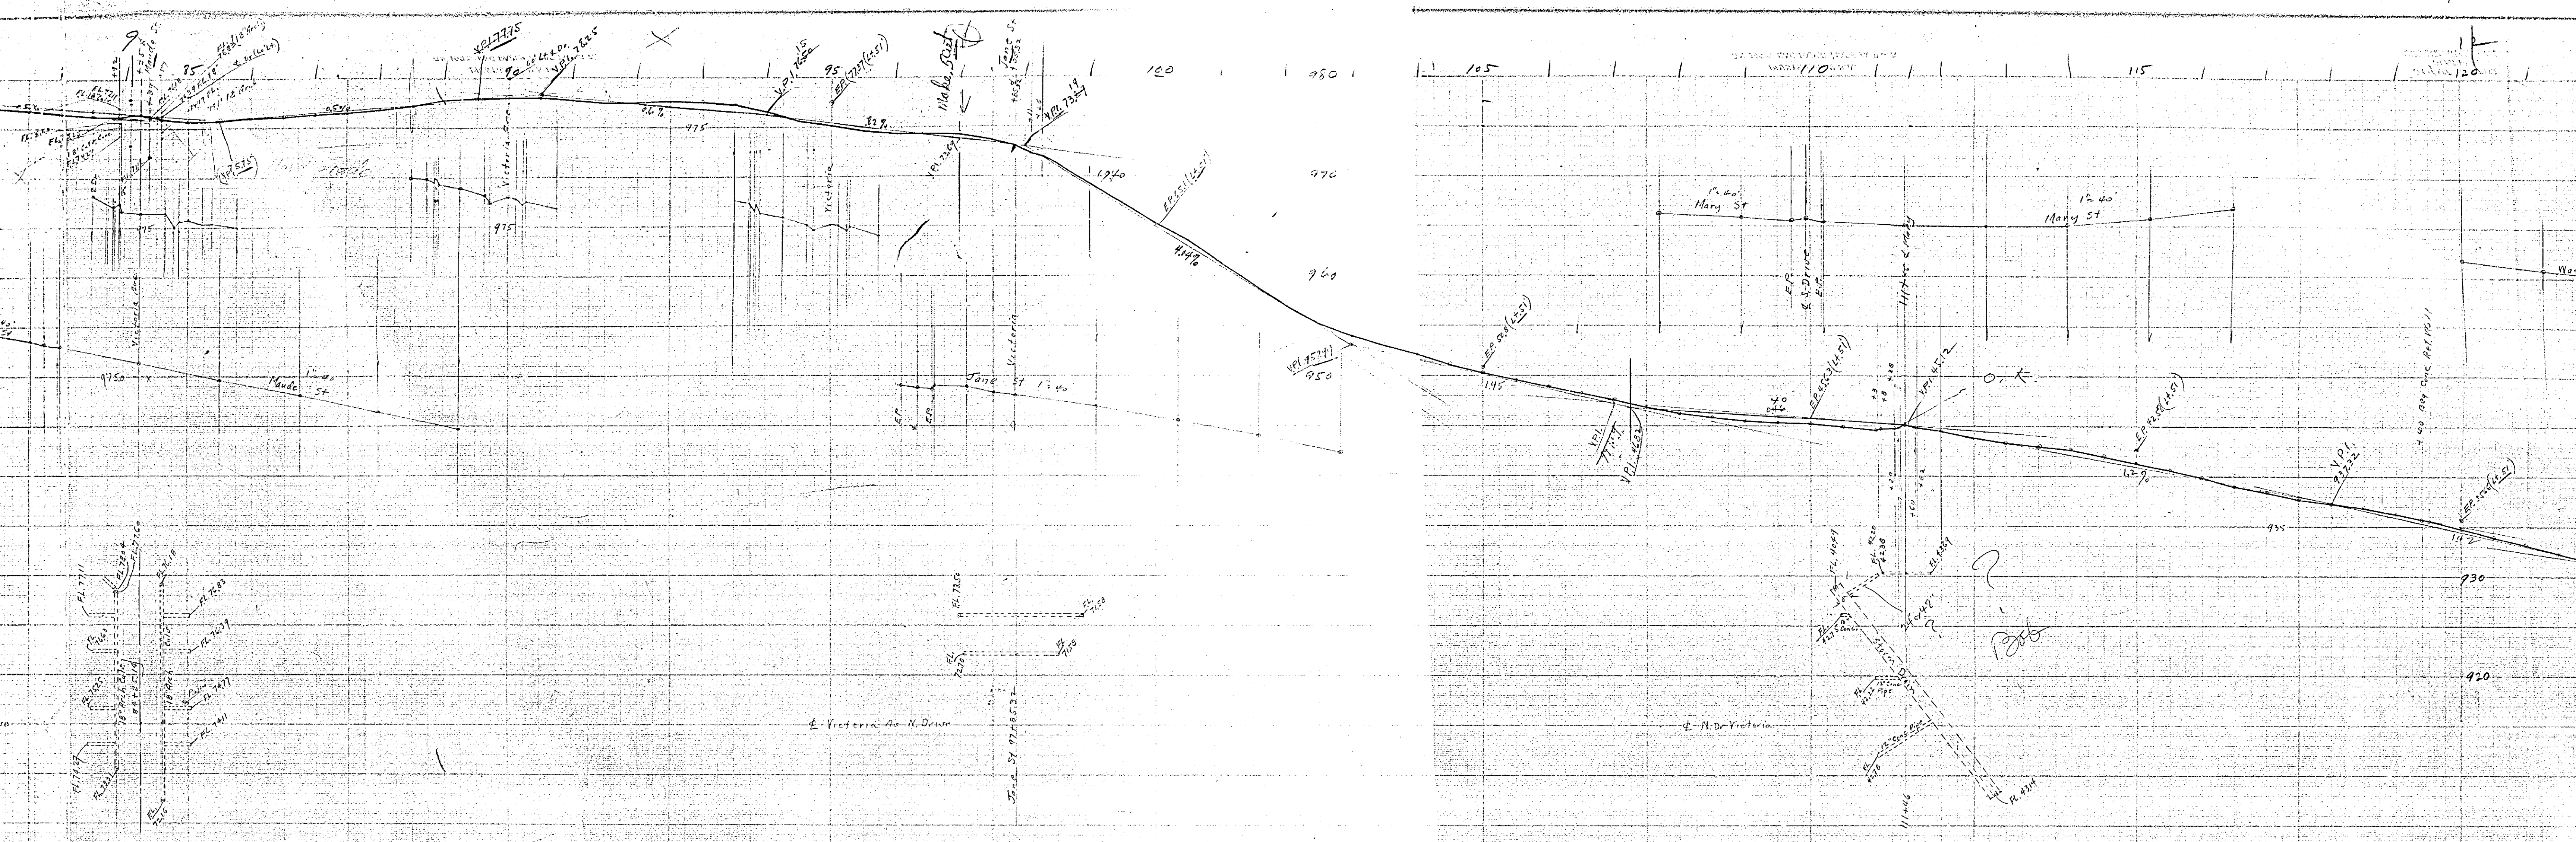

Grade Stakes 445/7-18

