
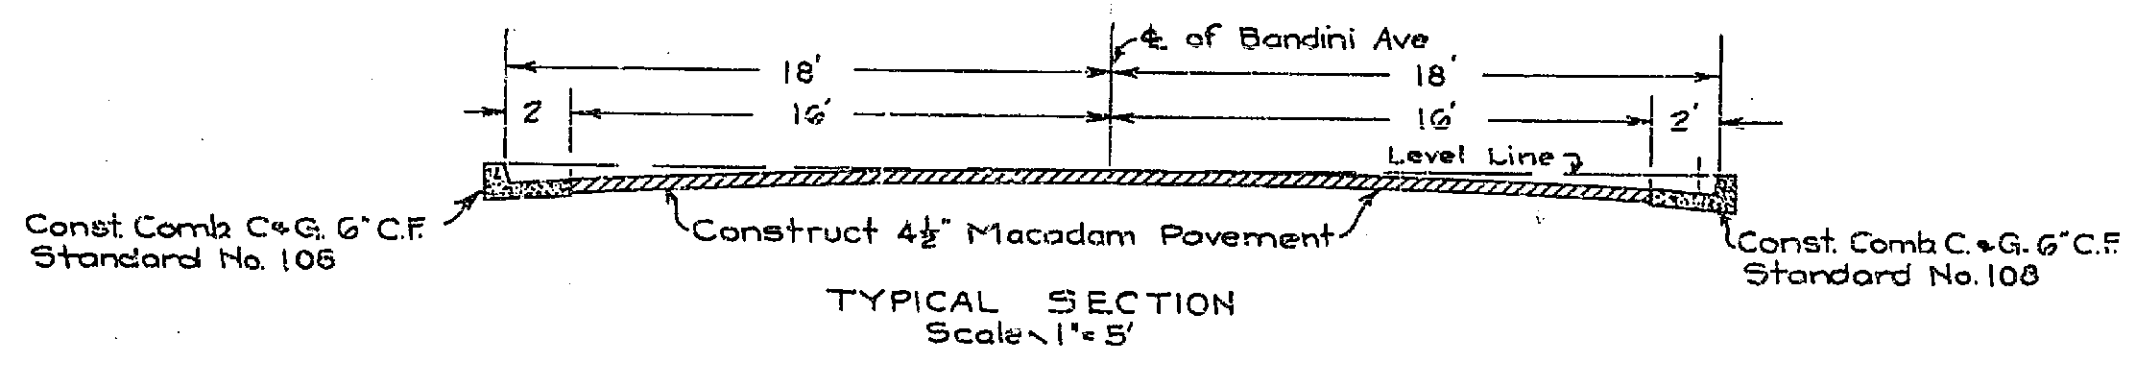
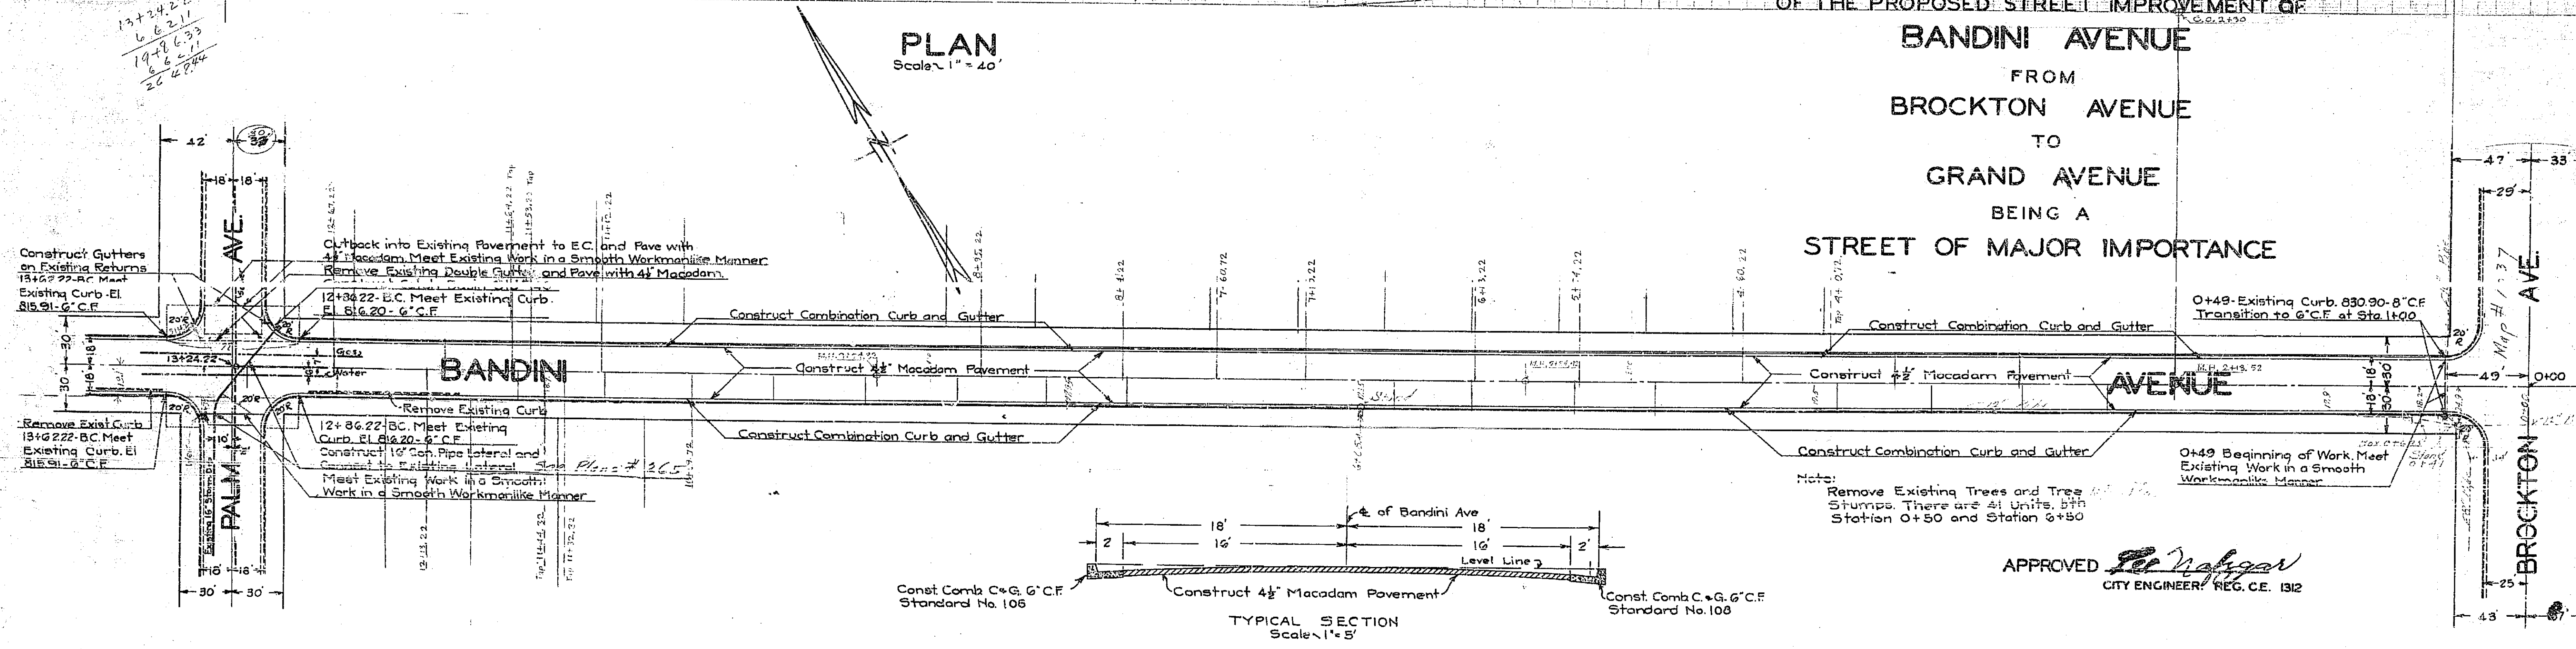


Bandini Ave. Brockton Ave to Grand Ave			
Drawing Number	Sheet Number	Total Sheets	Field Book
964-D	1	2	231
Drawn By	Checked By	Approved By	
Arthur N. Ridley		July 25, 1940	

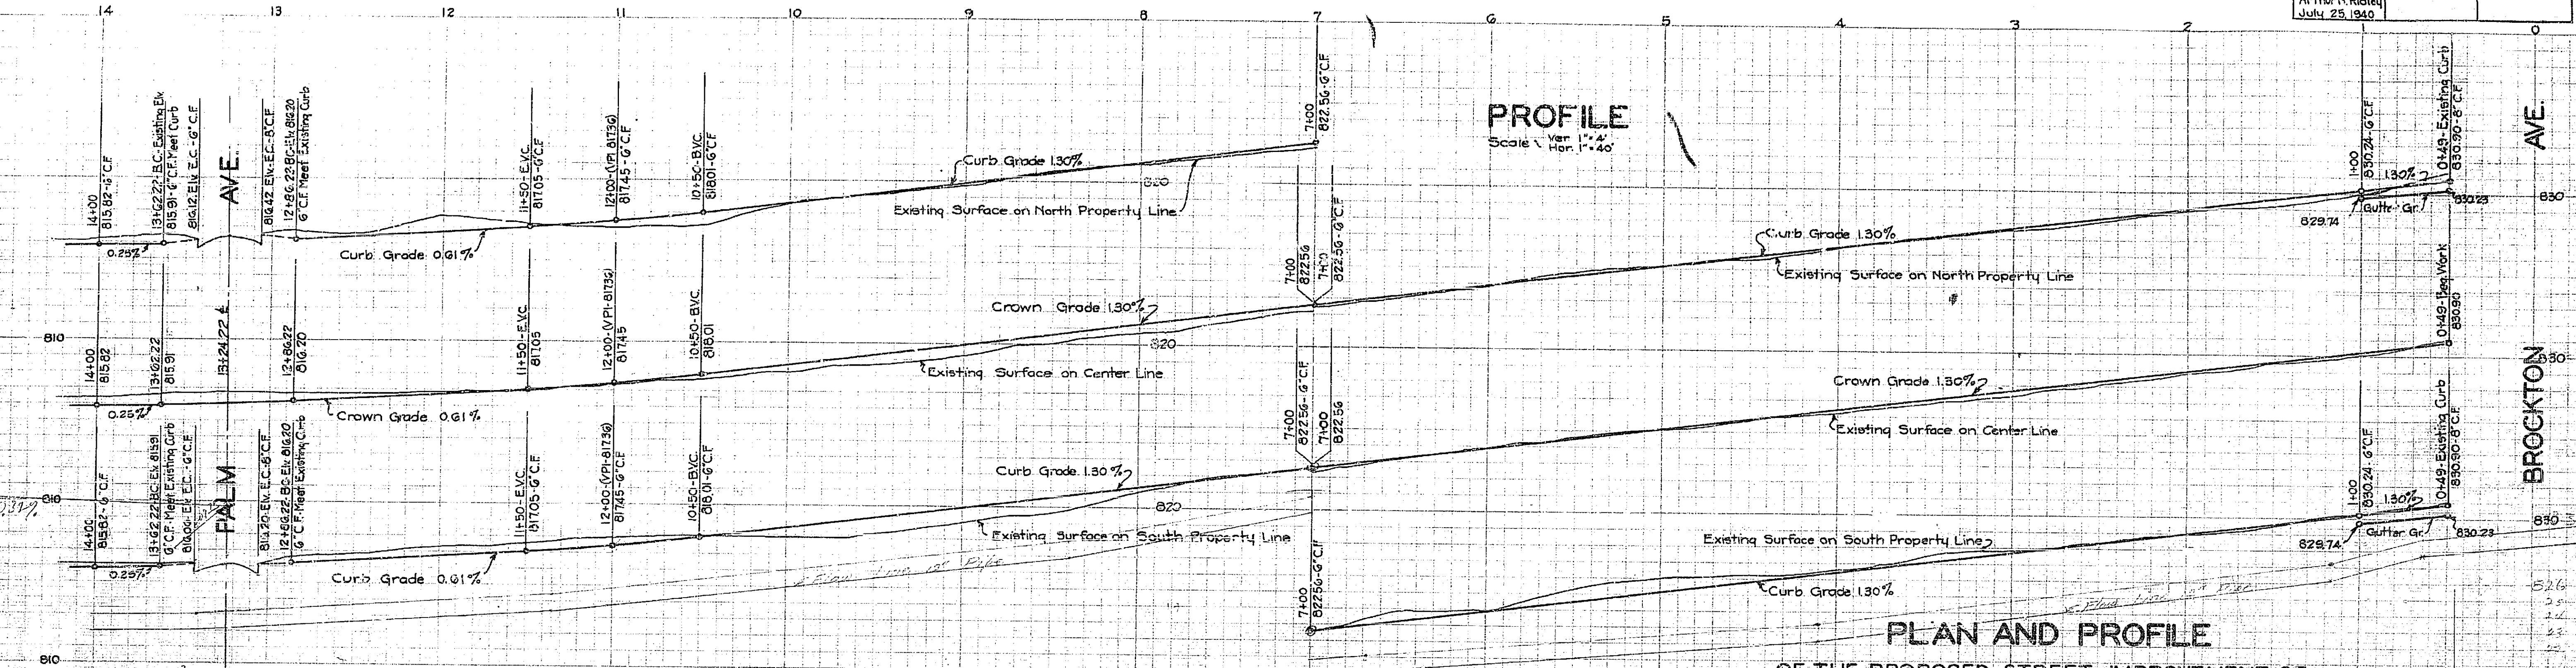


APPROVED *W. Mahgan*
CITY ENGINEER, REG. C.E. 1312


964D

Bondini Ave. Brockton Ave. to Grand Ave.			
Drawing Number	Sheet Number	Field Book	Book
964-D	2	2	291
Drawn By	Checked By	Approved By	
Arthur H. Kelley			
July 23, 1940			

PROFILE
Scale: Vert. 1" = 2'

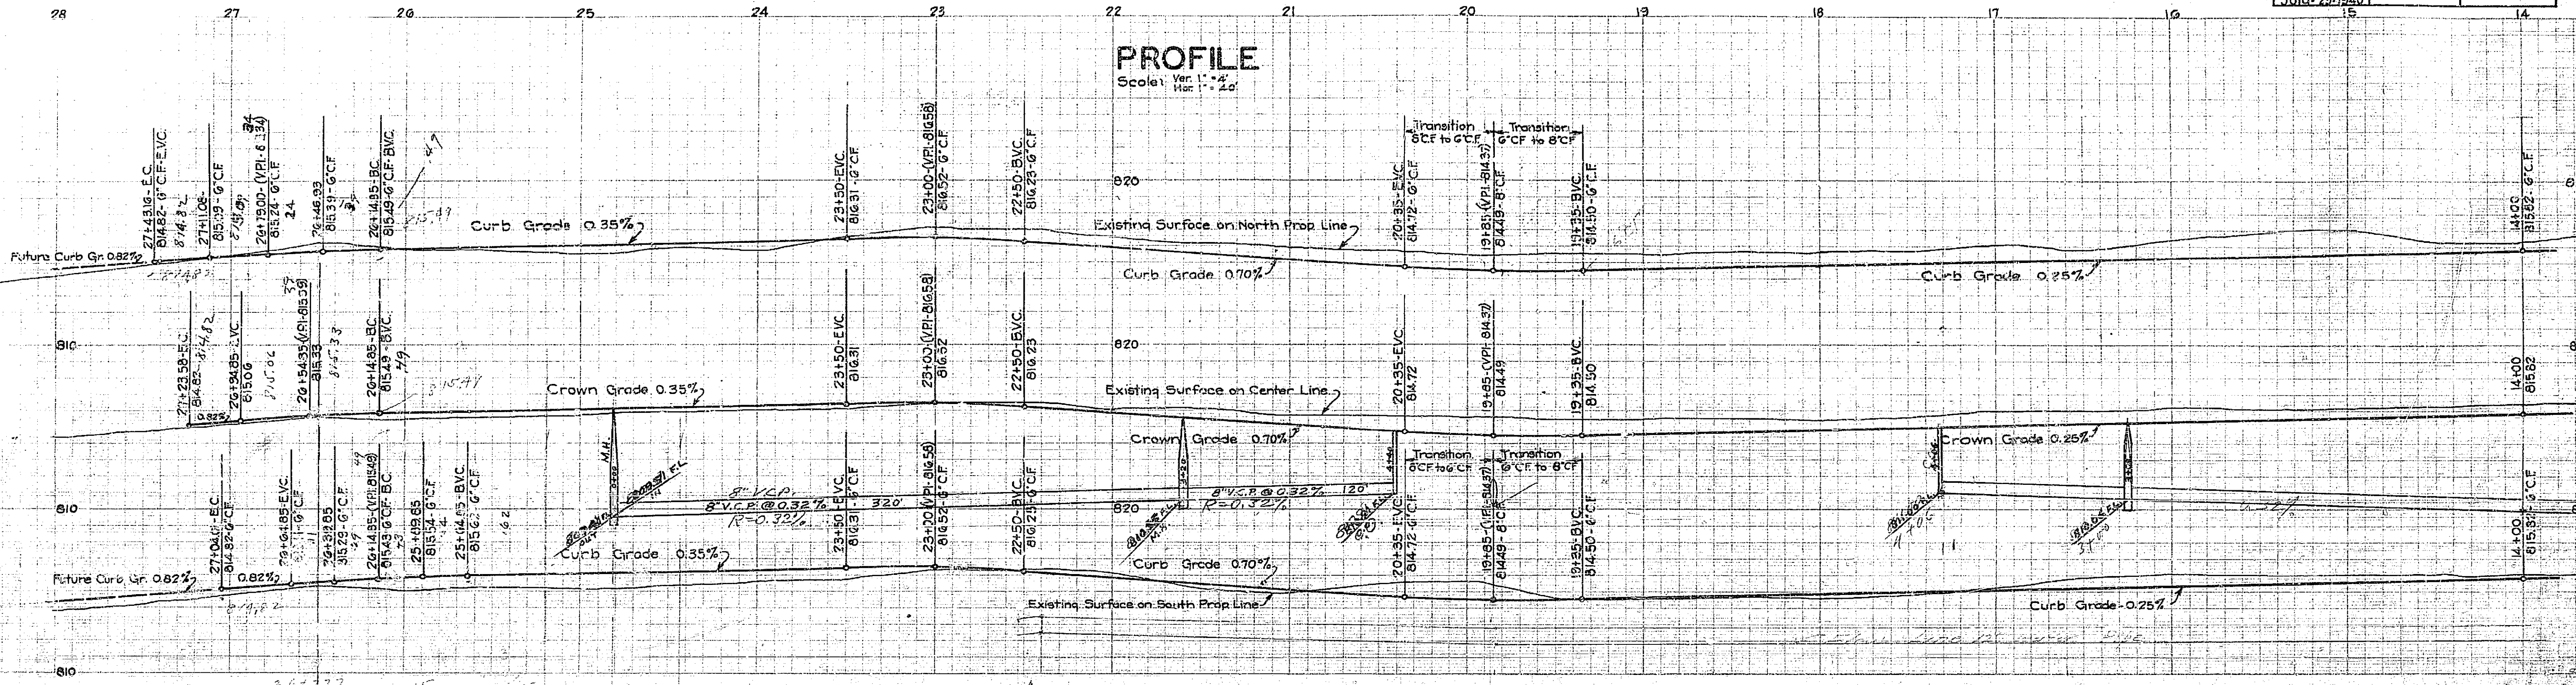

PLAN
Scale: 1" = 40'

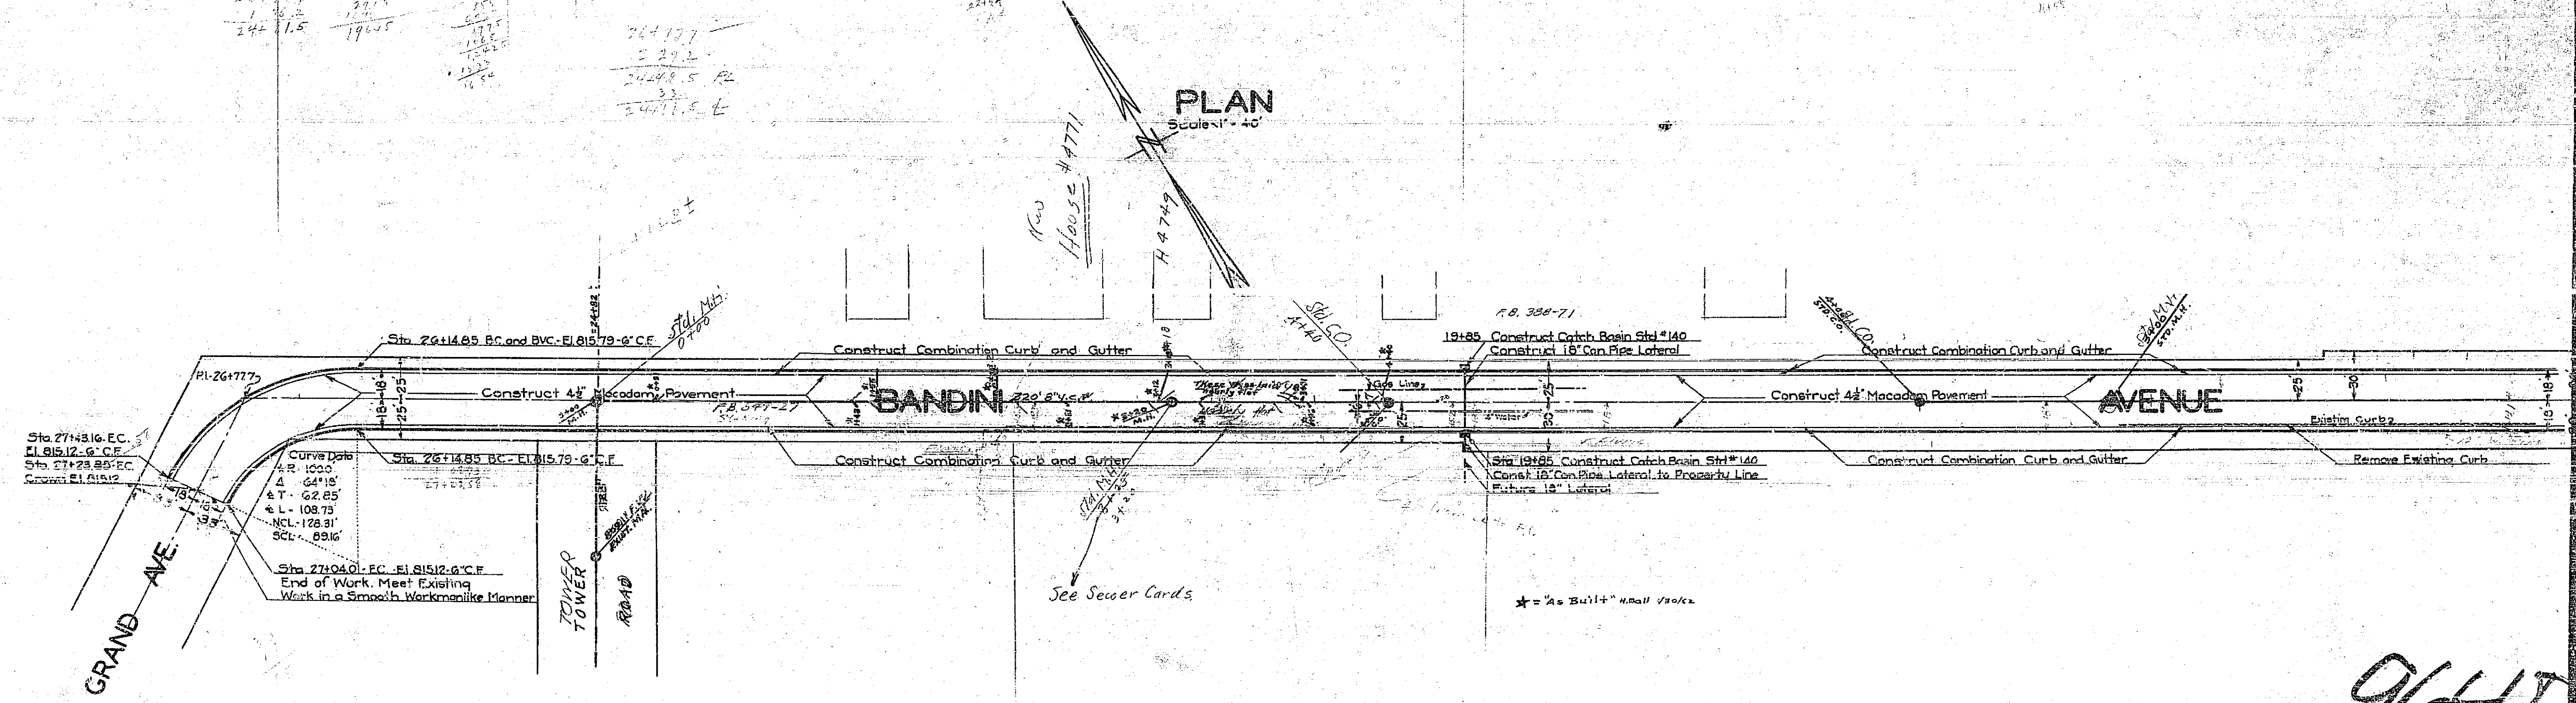

Curve Data
 R = 100.0'
 Δ = 24° 18'
 Δ T = 62.85'
 Δ L = 108.75'
 NCL = 128.31'
 SCL = 89.16'

Sta 27+04.0 - E.C. - El. 815.12 - G.C.F.
 End of Work. Meet Existing
 Work in a Smooth Workmanlike Manner

See Sewer Cards

* = "As Built" - No. 11 Voids

964-D