


CITY OF RIVERSIDE
ENGINEERING DEPT.

PROPERTY OF
CITY OF RIVERSIDE
CITY ENGINEERING DEPT.

HARDMAN TRACT
STREET LAYOUT
Sheet # 2

PROFILE ~~MONTEREY WAY~~
CAPISTRANO WAY
Scale 1"=40' Hor.
1"=4' Vert.

PROFILE BARCELONA WAY
Scale 1"=40' Hor.
1"=4' Vert.

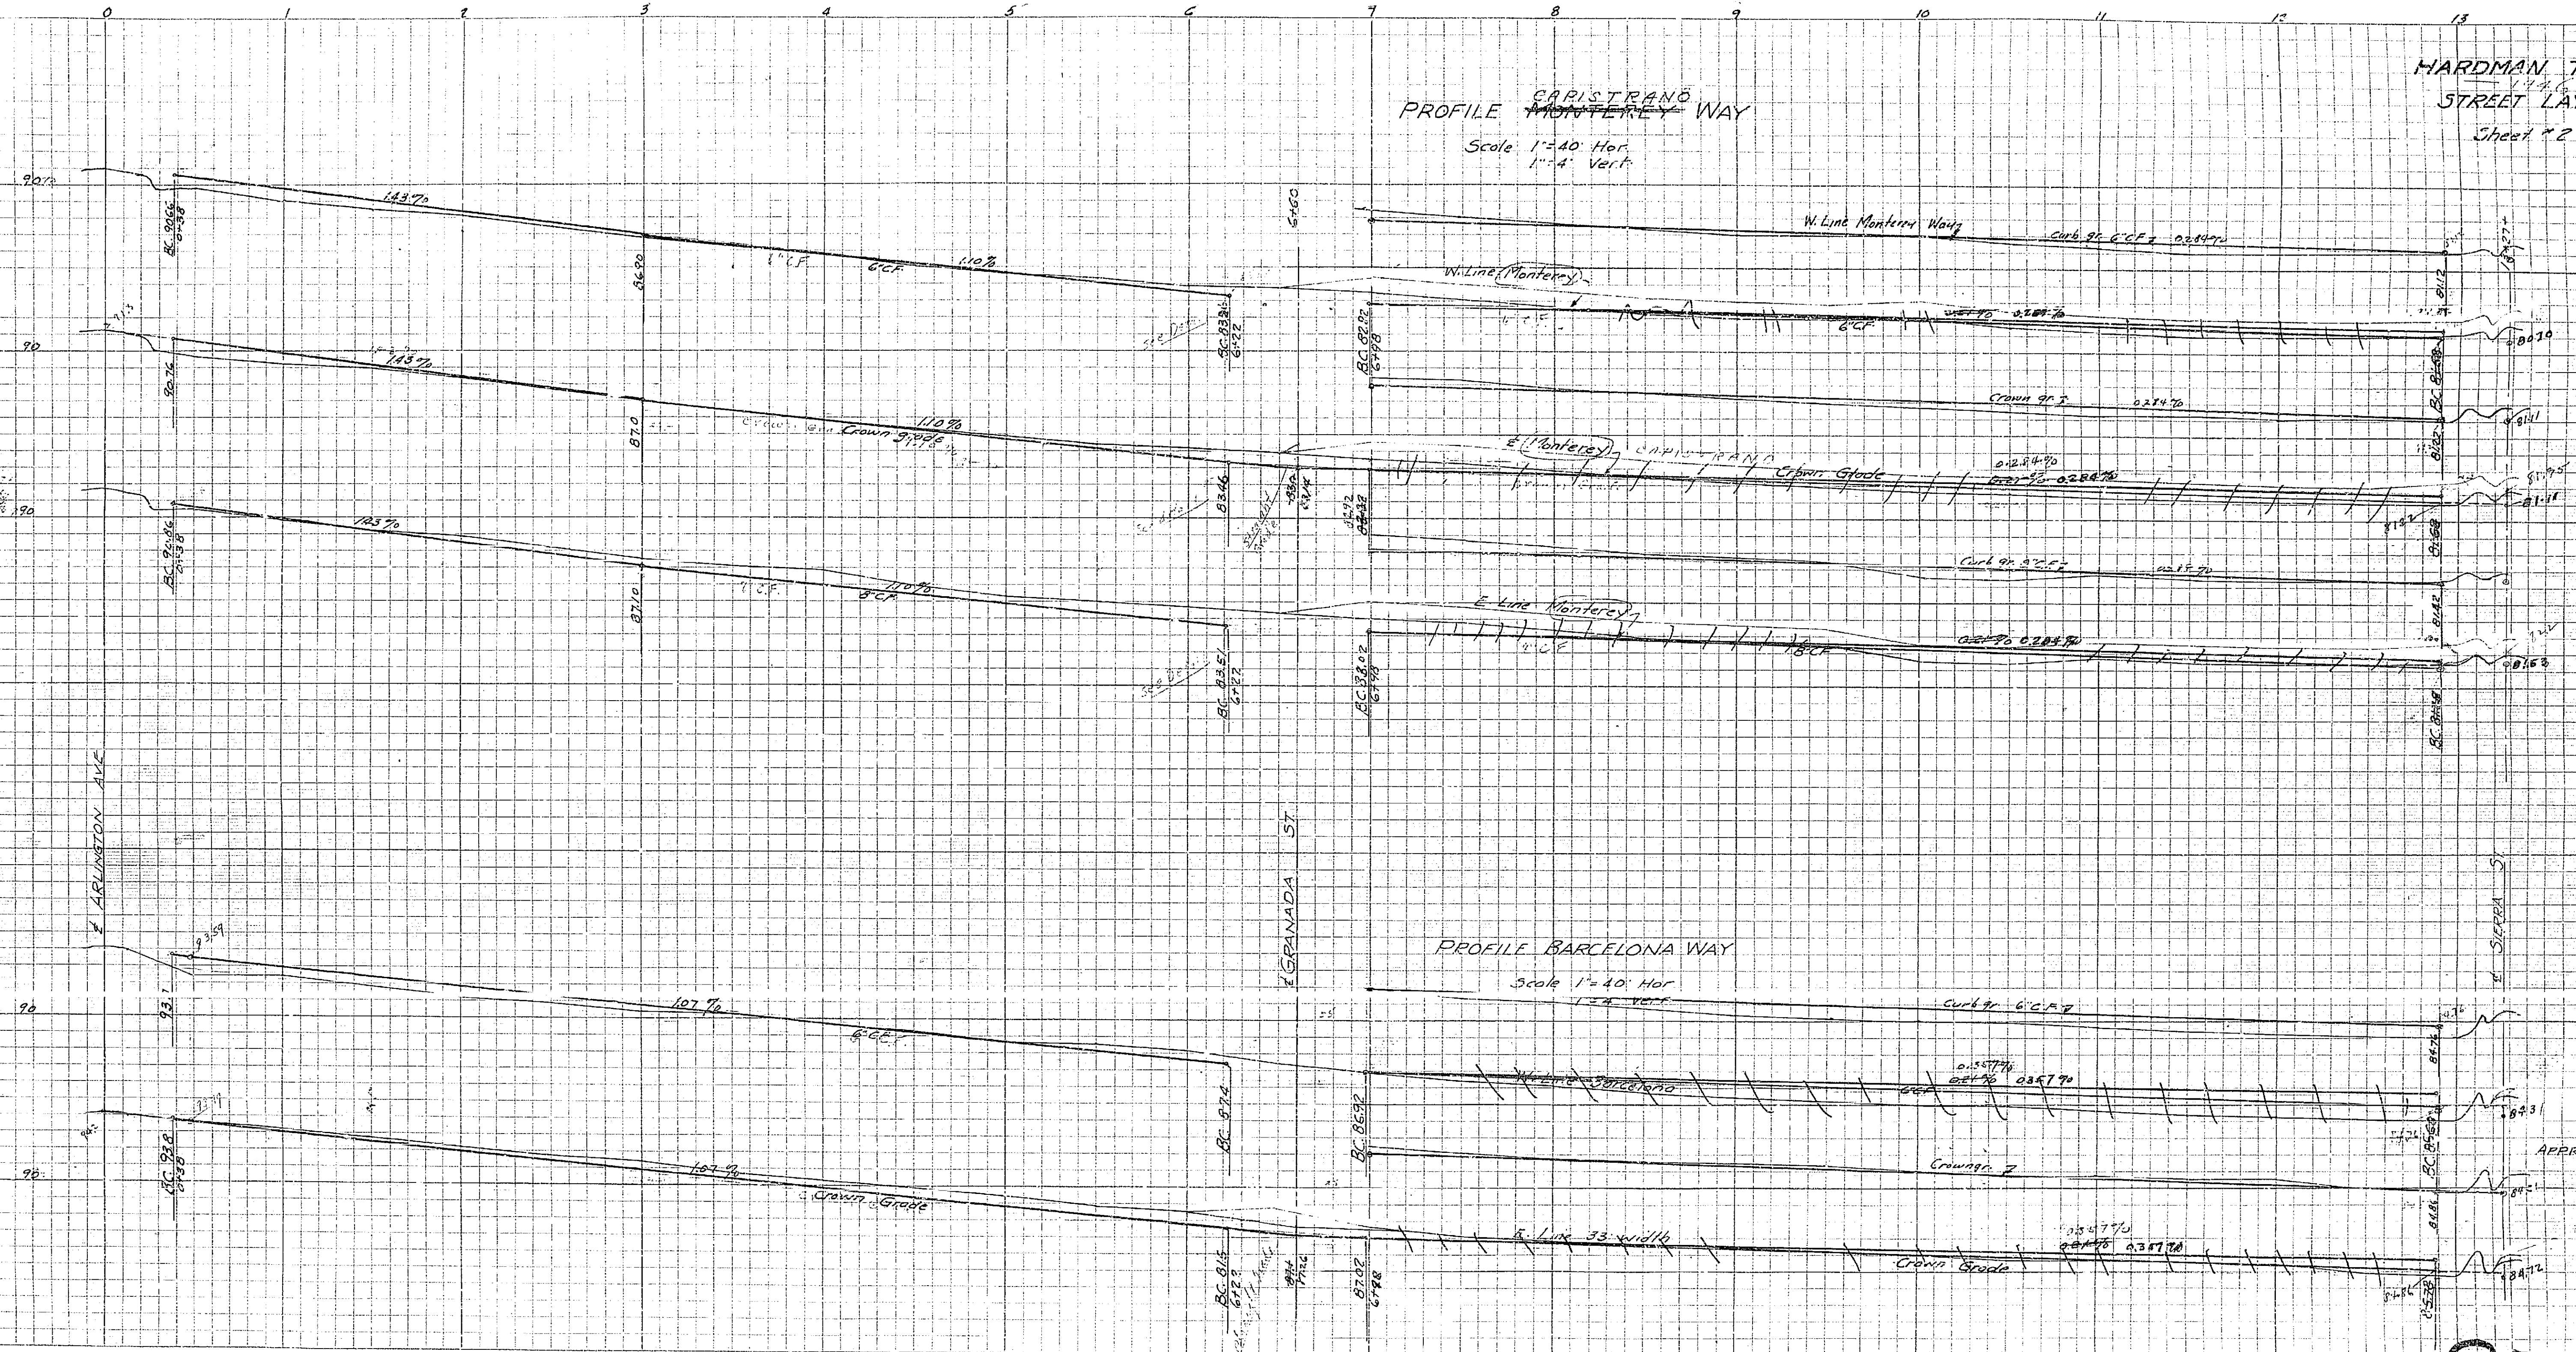

APPROVED BY
M. J. O'NEILL
CITY ENGINEER

PROPERTY OF
CITY OF RIVERSIDE
CITY ENGINEERING DEPT.

970