


PROFILE

SCALE: VER. 1" = 6'
HOR. 1" = 100'

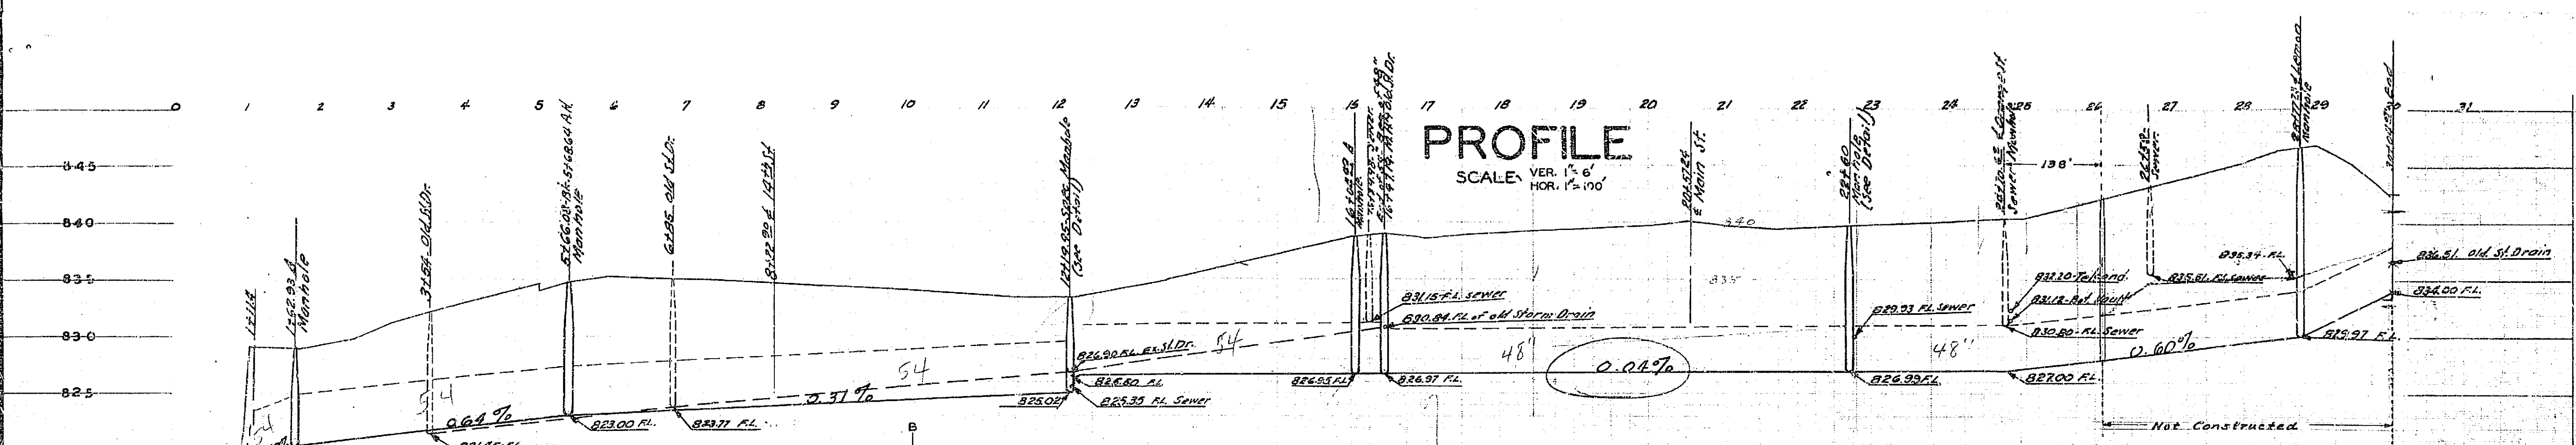

PLANS AND PROFILES OF THE PROPOSED MARKET & TWELFTH ST. STORM DRAIN


ELEVATIONS SHOWN HEREON ARE U.S.G.S. DATUM WHICH IS THE OFFICIAL CITY DATUM PLANE, ORD. NO. 551 N.S.

ENGINEERING DEPARTMENT - CITY OF RIVERSIDE JANUARY 1936

APPROVED *[Signature]*
CITY ENGINEER


APPROVED AND ADOPTED BY THE MAYOR AND COUNCIL OF THE CITY OF RIVERSIDE THIS 14TH DAY OF JANUARY 1936.

[Signature]
CITY CLERK, CITY OF RIVERSIDE.

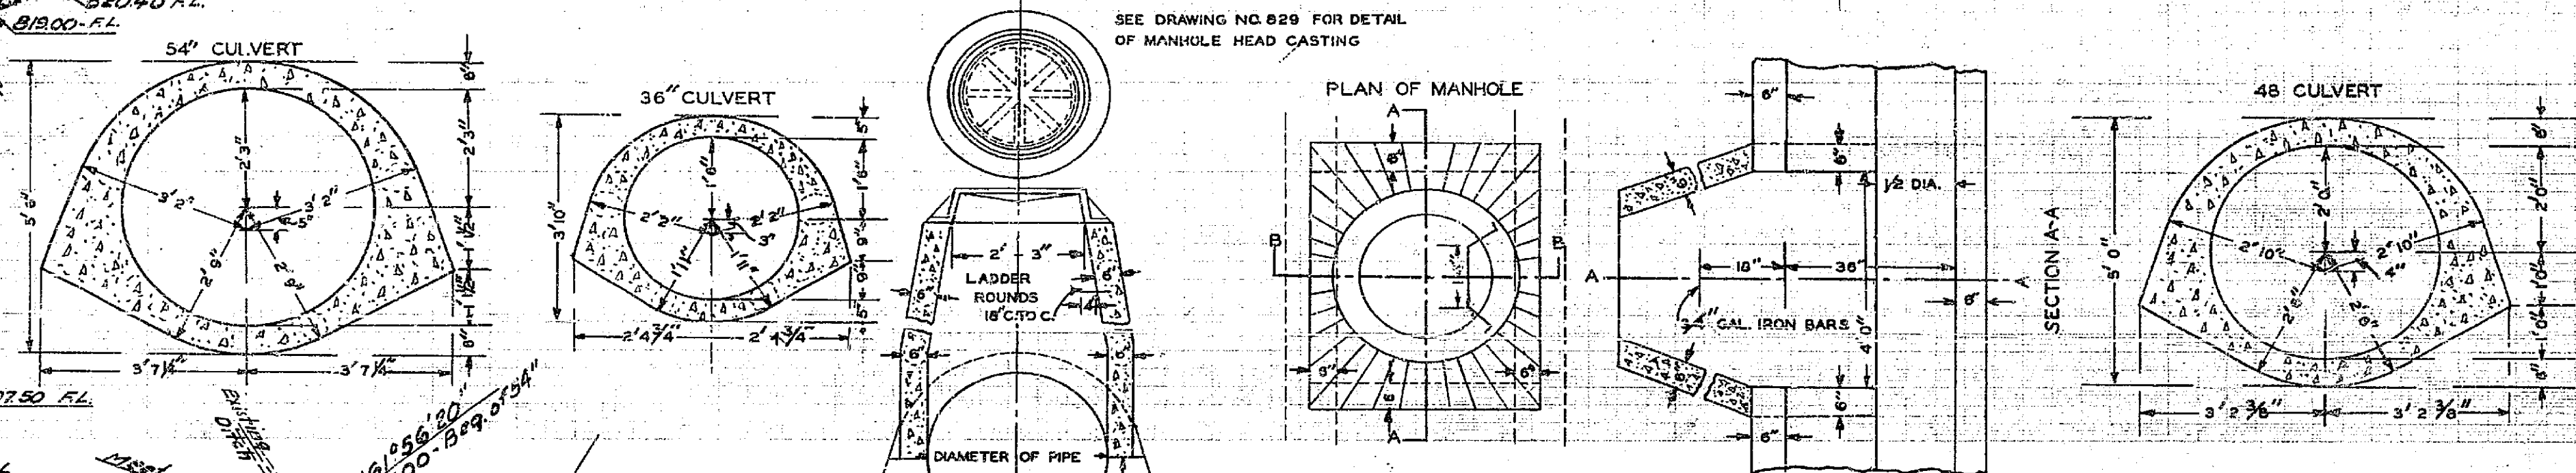


PLAN

SCALE: 1" = 100'

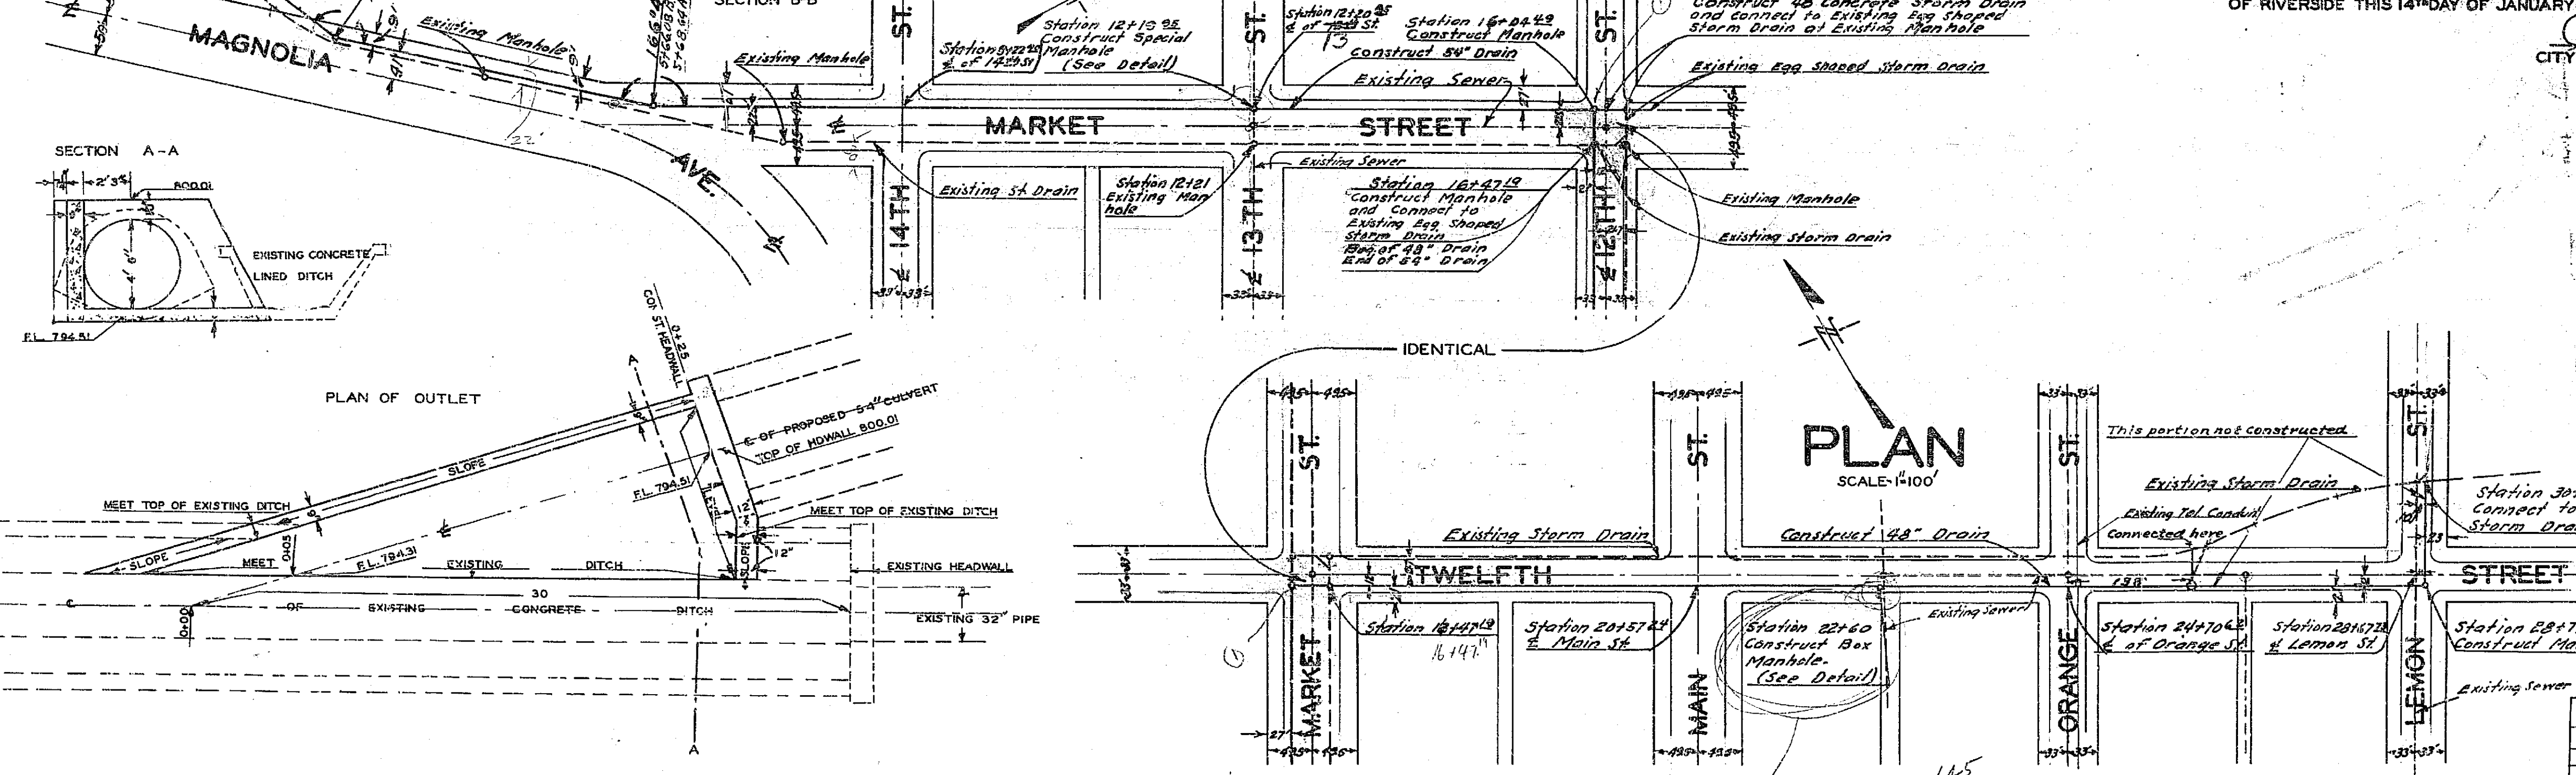


PLAN

SCALE: 1" = 100'

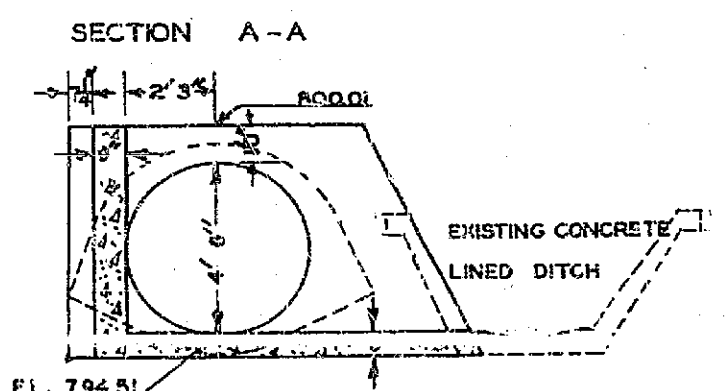

PLAN OF OUTLET

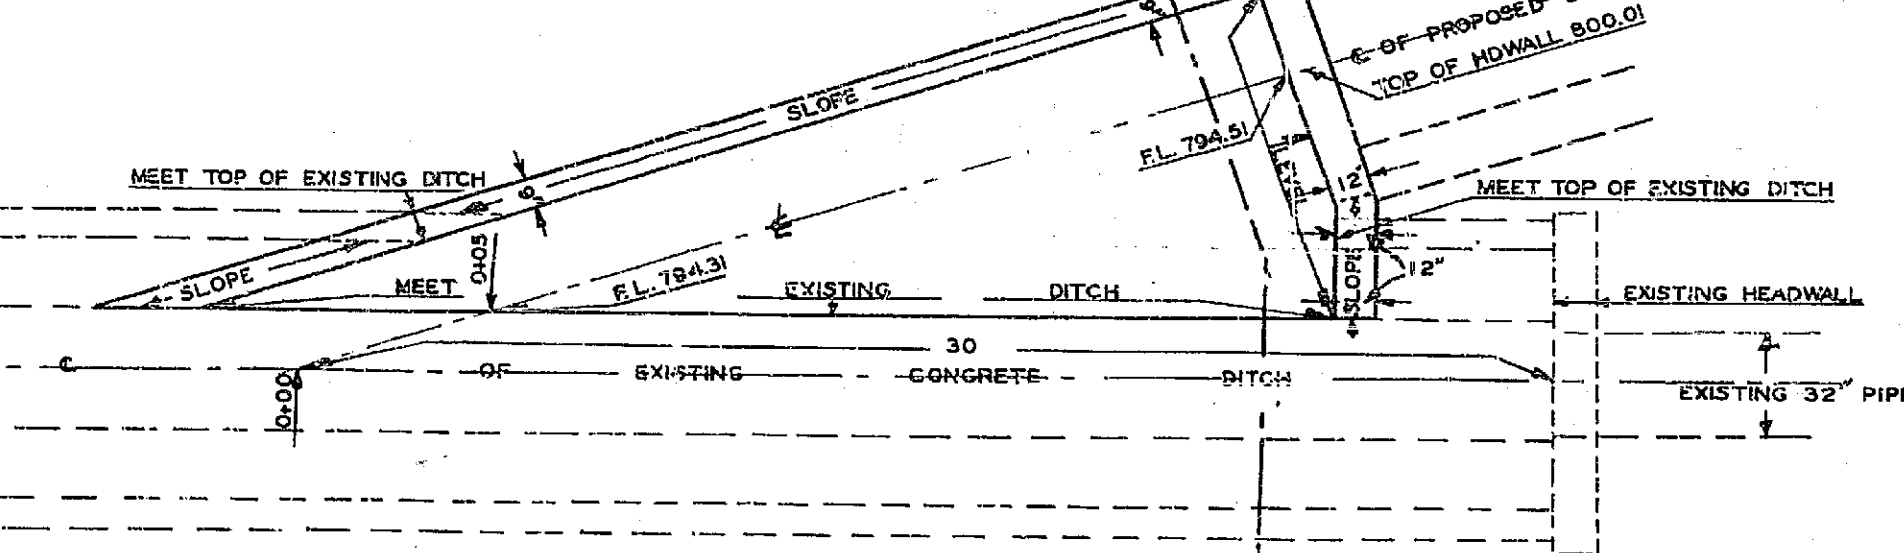

DRAWING NO.	SHEET NO.	TOTAL SHEETS	FIELD BOOK
977	1	2	319A.322
PLATTED	CHECKED	APPROVED	

977

See EB 486145 for location of M.H. as built (5)