


F.B. 543-62

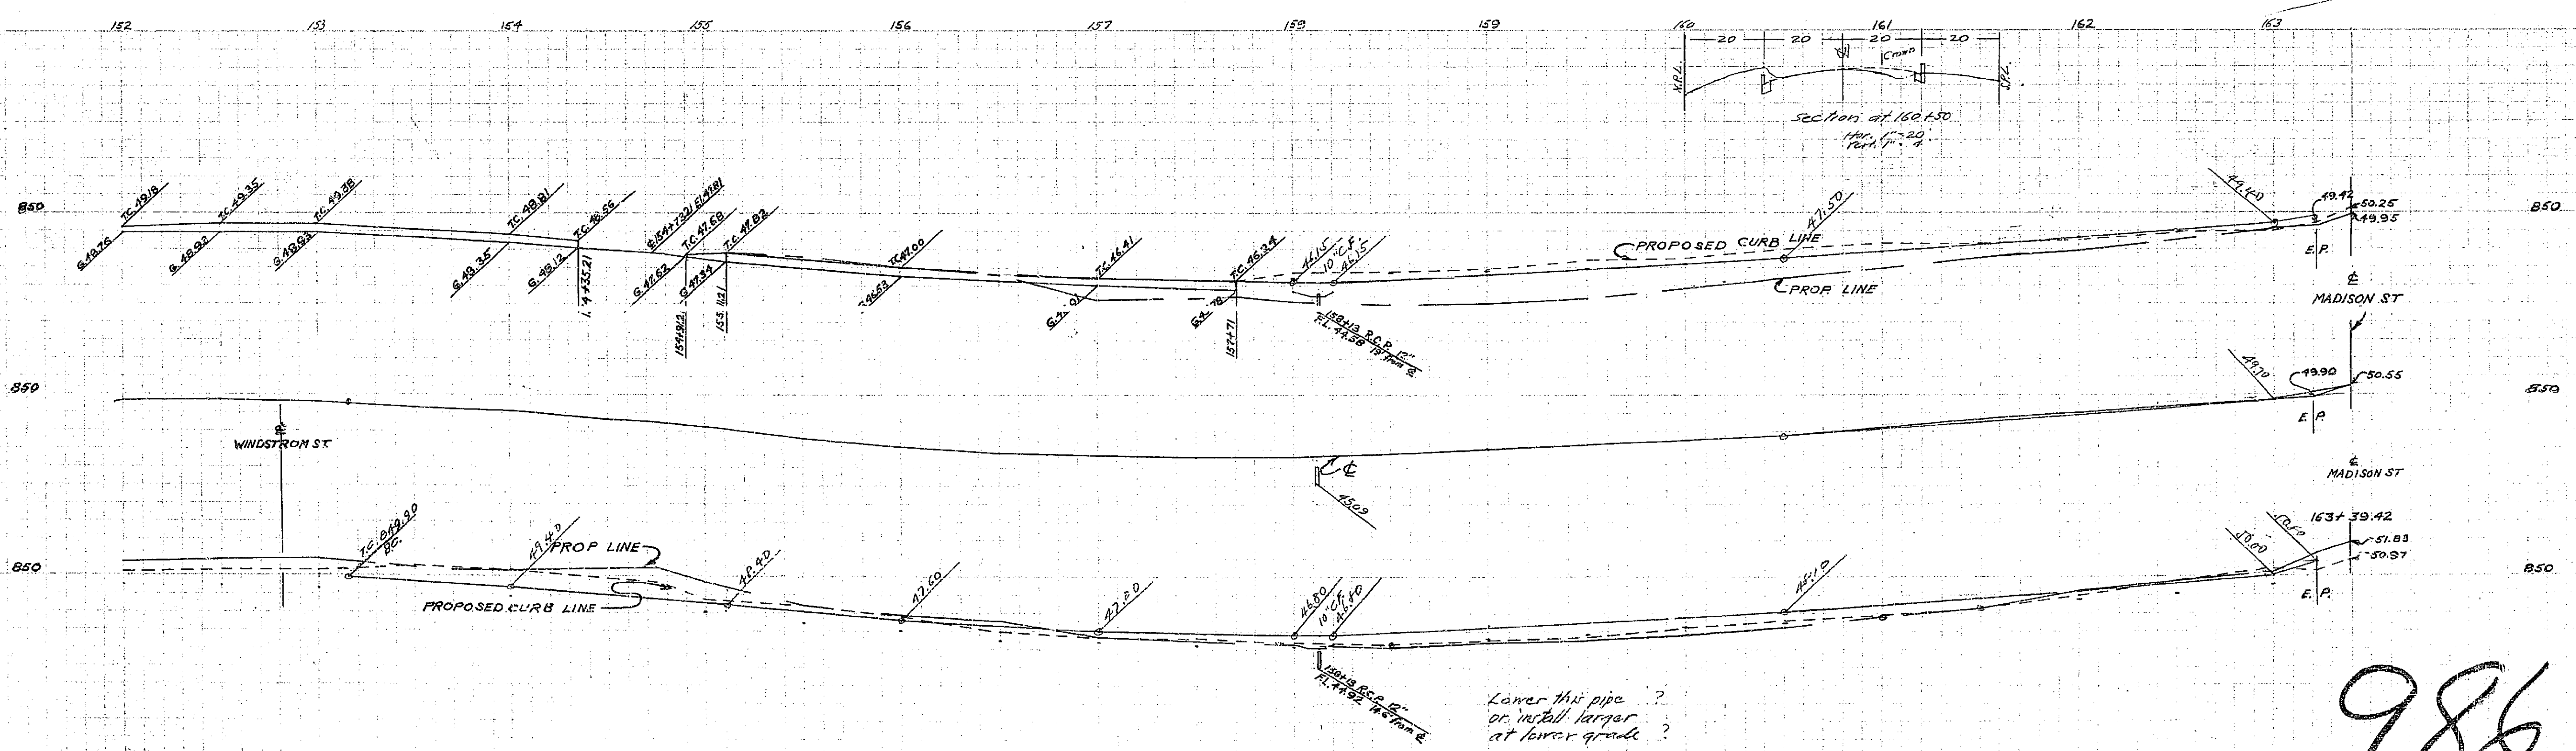

Lower this pipe or install larger at lower grade?

986 G