


L.S. 14
 7-25-55

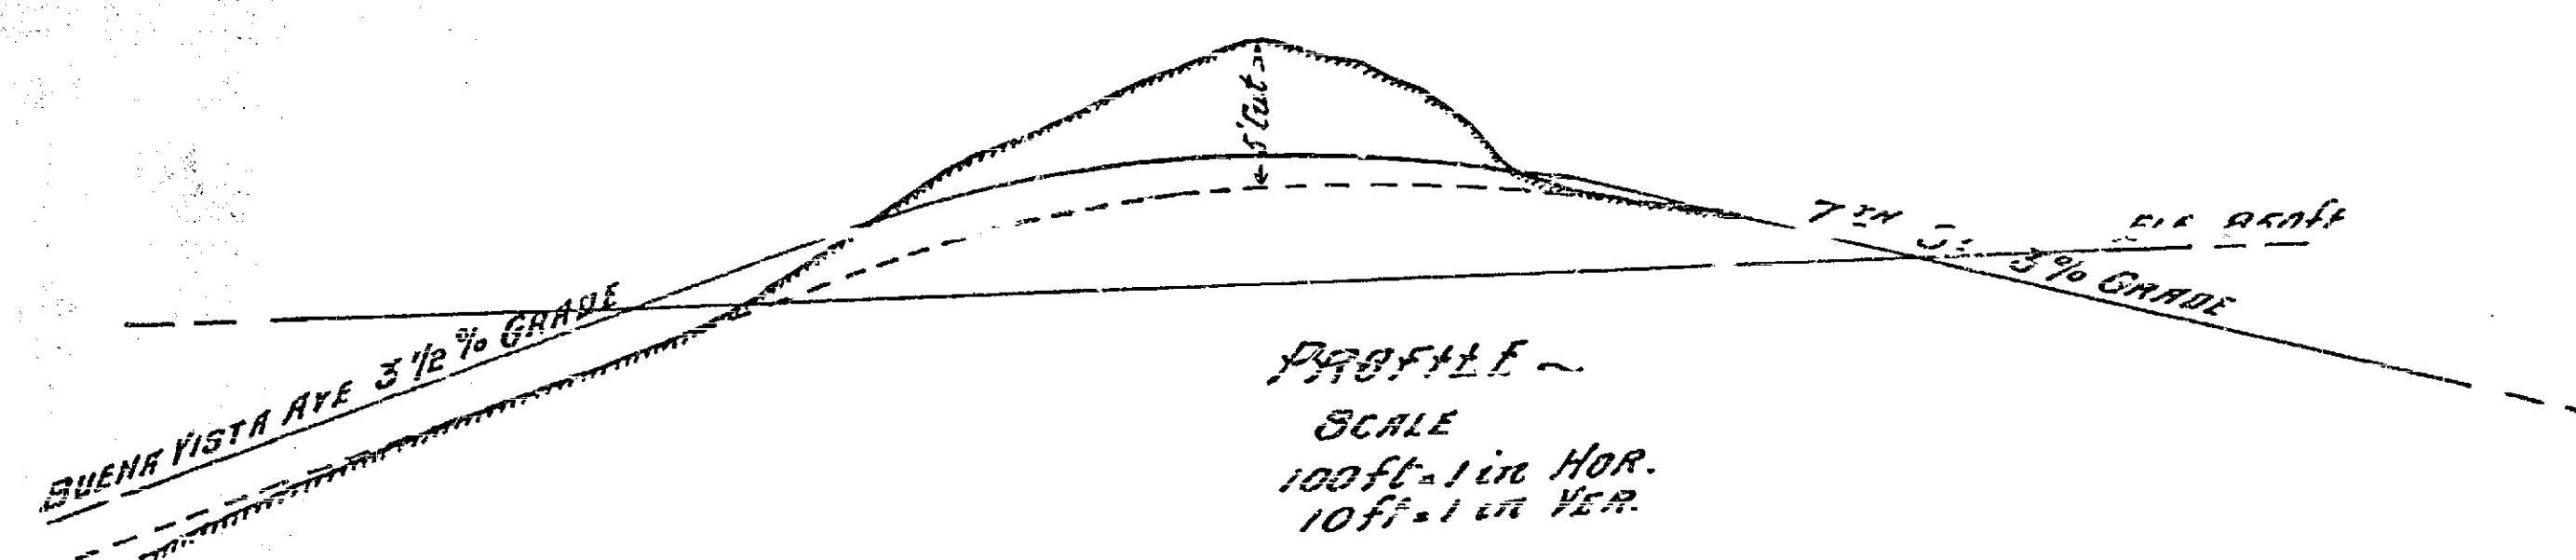

PROPOSED
 CHANGE OF LINE AND GRADE FOR
 7TH ST AND WEST RIVERSIDE ROAD

A. F. Campbell
 City Engineer

997 E

997