

**GENERAL CONSTRUCTION NOTES:**

- CONSTRUCTION SHALL BE IN ACCORDANCE WITH THE CITY OF RIVERSIDE STANDARD DRAWINGS AND STANDARD SPECIFICATIONS FOR PUBLIC WORKS CONSTRUCTION, 2012 EDITION.
- THE CONTRACTOR IS REQUIRED TO TAKE DUE PRECAUTIONARY MEASURES TO LOCATE AND PROTECT ALL UTILITIES.
- ALL PULL BOXES, AFFECTED BY CONSTRUCTION, SHALL BE ADJUSTED TO THE PROPOSED GRADE, UNLESS OTHERWISE NOTED.
- PRIME CONTRACTOR BIDDING THIS WORK SHALL HAVE A CLASS "A" OR "C-27".

**PLANTING NOTES:**

- CONTRACTOR SHALL NOTIFY THE LANDSCAPE INSPECTOR TO SITE CONDITIONS WHICH PREVENT INSTALLATION PER PLANS IN A REASONABLE MANNER.
- CONTRACTOR SHALL BE LIABLE FOR REMOVING AND RE-INSTALLING ALL IRRIGATION EQUIPMENT AND RE-PLANTING AREAS WHICH ARE NOT INSTALLED PER PLAN/SPECIFICATIONS.
- INSTALL SHREDDED MULCH IN ALL PLANTING AREAS AT A DEPTH OF 2".
- THE CONTRACTOR IS RESPONSIBLE FOR ALL REPAIRS AND/OR REPLACEMENT OF ANY DAMAGED LANDSCAPE AREAS BEYOND THE LIMIT OF WORK, AS A DIRECT RESULT OF THE LANDSCAPE CONSTRUCTION BY THE CONTRACTOR AND/OR BY HIS SUB-CONTRACTOR. REPLACEMENT ITEMS SHALL BE AN EXACT DUPLICATE OF THE ORIGINAL WORK, UNLESS OTHERWISE APPROVED BY THE CITY.
- CLEAN-UP SHALL TAKE PLACE ON A DAILY BASIS UNLESS OTHERWISE APPROVED BY THE PUBLIC WORKS LANDSCAPE INSPECTOR.
- THE CONTRACTOR SHALL VERIFY ALL QUANTITIES OF PLANTINGS.
- REPLACEMENT OF DAMAGED OR DESTROYED PLANTINGS SHALL TAKE PLACE WITHIN 48 HOURS OF NOTIFICATION BY THE ENGINEER, OR SAID REPLACEMENT ITEMS SHALL BE DEDUCTED FROM THE CONTRACTOR'S FINAL BILLING.
- A SITE SHALL BE PRE-SELECTED BY THE PUBLIC WORKS LANDSCAPE INSPECTOR FOR PLANT DELIVERY AND APPROVAL FOR MIXING OF BACKFILL.
- ALL PLANTING AND IRRIGATION WORK SHALL BE GUARANTEED AGAINST ANY AND ALL POOR, INADEQUATE OR INFERIOR MATERIALS AND/OR WORKMANSHIP FOR A PERIOD OF NINETY (90) DAYS FOLLOWING THE DATE OF PROJECT ACCEPTANCE.
- ALL PLANTING QUANTITIES AND PLANTING PANEL SIZES ARE APPROXIMATE.
- A 90 DAY WARRANTY PERIOD WILL BE REQUIRED FOR ALL PLANTINGS. THERE WILL BE NO 365 DAY PLANT ESTABLISHMENT PERIOD REQUIRED.

**GENERAL NOTES FOR PUBLIC LANDSCAPES:**

- ALL RELATED WORK SHALL CONFORM TO THE CITY OF RIVERSIDE PUBLIC WORKS DEPARTMENT STANDARDS AND SPECIFICATIONS FOR PLANTING AND IRRIGATION WORK. (SECTIONS 02441 AND 02483)
- A "PUBLIC LANDSCAPE" PERMIT, AS ISSUED BY THE PUBLIC WORKS DEPARTMENT IS REQUIRED. CONTACT THE PUBLIC WORKS LANDSCAPE INSPECTOR AT (951) 351-6313 TO OBTAIN THE PERMIT.
- WHEN CALLING FOR INSPECTIONS, CONTACT THE PUBLIC WORKS LANDSCAPE INSPECTOR A MINIMUM OF 48 HOURS IN ADVANCE TO SCHEDULE AN INSPECTION. A WRITTEN APPROVAL WILL BE PROVIDED ON THE PUBLIC LANDSCAPE PERMIT CARD FOR EACH STAGE OF INSPECTION. A VERBAL APPROVAL WILL NOT BE ACCEPTABLE. INSPECTIONS ARE REQUIRED PER THE STANDARD SPECIFICATIONS, AND INCLUDE BUT ARE NOT NECESSARILY LIMITED TO THE FOLLOWING:
  - AFTER COMPLETION OF FINAL GRADING AND WHEN ALL UTILITY SERVICES HAVE BEEN MARKED, BUT PRIOR TO INITIATING ANY LANDSCAPE WORK WITHIN THE PUBLIC RIGHT OF WAY.
  - AT TIME OF INSTALLATION, PRIOR TO BACKFILL OF TRENCHES, MAINLINES MUST BE PRESSURE TESTED IN THE PRESENCE OF THE PUBLIC WORKS LANDSCAPE INSPECTOR.
  - AT TIME OF INSTALLATION OF IRRIGATION DRIP LINE SYSTEM PER EXISTING VALVE.
  - WHILE DIGGING PLANT PITS AND PLANTING.
  - AFTER PLANTING AND ALL OTHER INDICATED OR SPECIFIED WORK HAS BEEN COMPLETED, FOR START OF MAINTENANCE.
  - AT SUBSTANTIAL COMPLETION OF THE PROJECT FOR CITY'S ACCEPTANCE.
- THE CONTRACTOR/DEVELOPER SHALL CALL THE PUBLIC WORKS LANDSCAPE INSPECTOR AT THE NUMBER LISTED ABOVE FOR A FINAL ACCEPTANCE AFTER THE 90 DAY WARRANTY PERIOD. CONTRACTOR'S BOND WILL NOT BE RELEASED UNTIL AFTER CITY'S ISSUANCE OF WRITTEN NOTIFICATION THAT THE PROJECT HAS PASSED FINAL INSPECTION.
- CONTRACTOR SHALL KEEP EXISTING IRRIGATION SYSTEMS OPERATIONAL AND SHALL BE RESPONSIBLE FOR REPLACING ANY DEAD PLANTS AND TREES AT THE CONTRACTOR'S EXPENSE AS A RESULT OF CONSTRUCTION ACTIVITIES.
- RECYCLED WATER PIPE SHALL BE PURPLE COLOR CODED INTEGRALLY STAMPED OR MARKED AS "CAUTION-RECYCLED WATER-DO NOT DRINK" AND "PELIGRO: AGUA IMPURA-NO BEBER" OR USE VINYL WRAP OR USE RECYCLED WATER WARNING TAPE.



**RIVERSIDE**




CITY OF RIVERSIDE

**CALIFORNIA**

**PUBLIC WORKS DEPARTMENT**

**MEDIAN TURF REMOVAL PROJECT,**

**PHASE II**

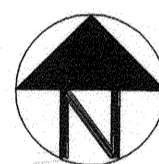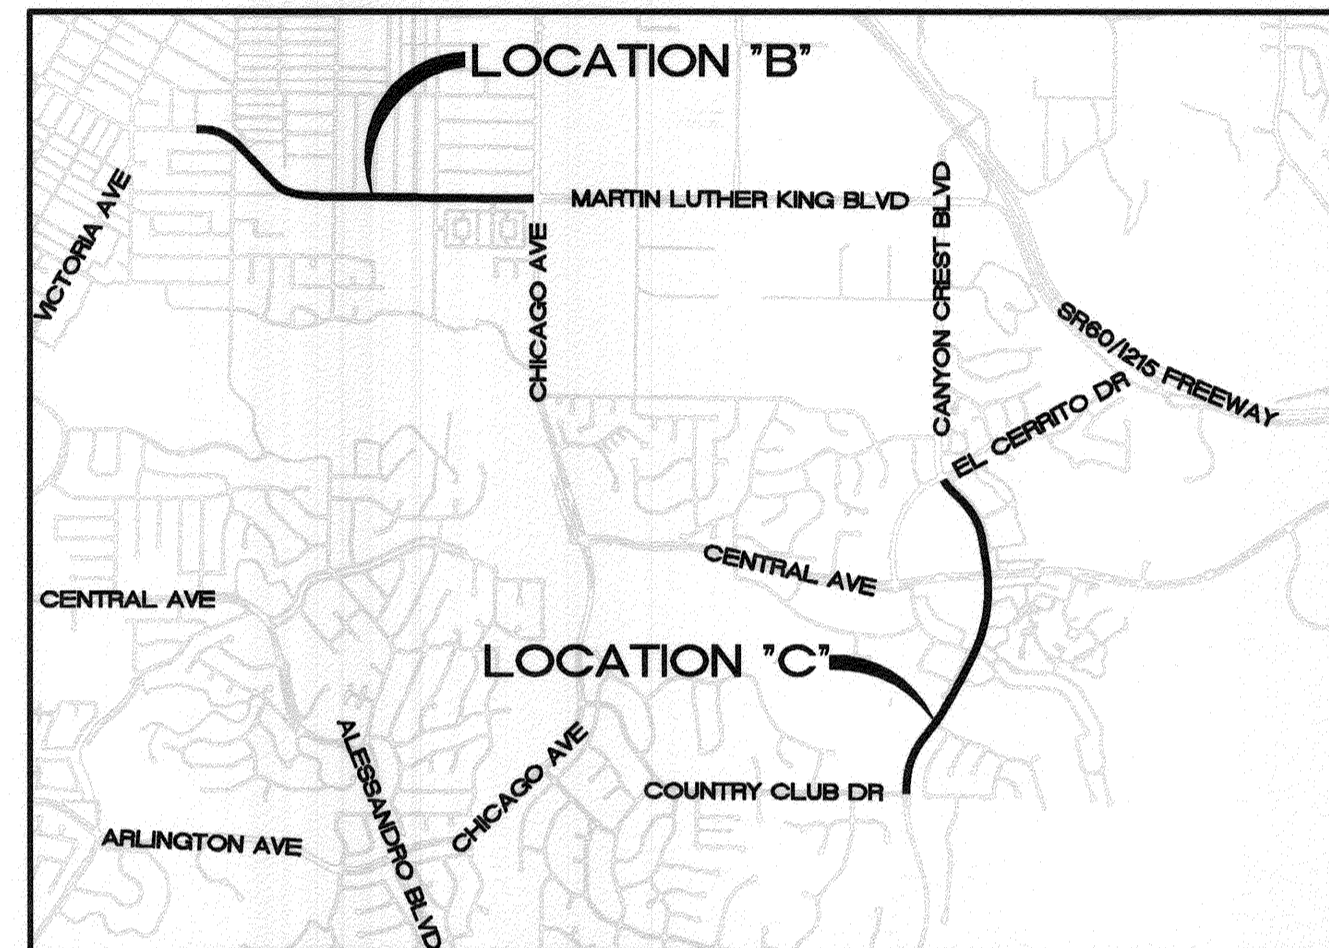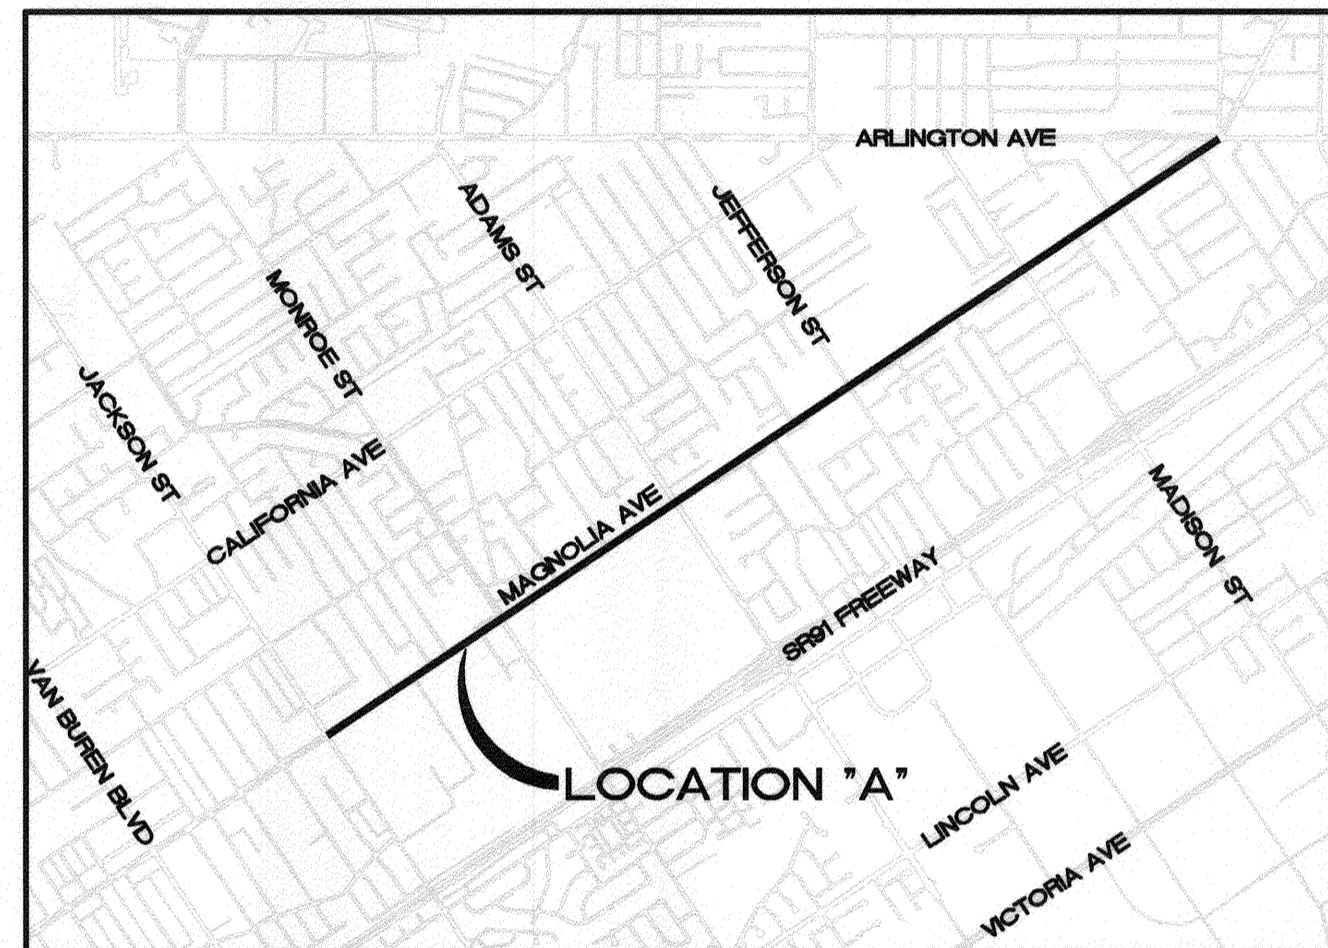

**LOCATION MAPS**

SCALE: NOT TO SCALE


**PLANTING LEGEND**

SYMBOL	COMMON NAME	SCIENTIFIC NAME	PLANT SPACING	PLANT SIZE
	DWARF BOTTLEBRUSH	CALLISTEMON CITRINUS	3' O.C.	1 GALLON
	BLUE FESCUE	FESTUCA GLAUCA	3' O.C.	1 GALLON
	STAR JASMINE	TRACHELOSPERMUM JASMINOIDES	3' O.C./ 1 GAL. & 12" O.C./FLAT*	1 GALLON & FLAT*
	PURPLE "ROSEA" ICEPLANT	DROSANTHEMUM FLORIBUNDUM	12" O.C.	FLAT*
	GAZANIA "TRAILING" YELLOW	GAZANIA HYBRID	12" O.C.	FLAT*
	SOCIETY GARLIC	TULBAGHIA VIOLACEA	3' O.C.	1 GALLON
	WHITE "ICEBERG" ROSE (1)	ROSA JACARE	4' O.C.	1 GALLON
	WHITE "ICEBERG" ROSE (2)	ROSA JACARE	4' O.C.	1 GALLON
	PLUMBAGO	PLUMBAGO AURICULATA	6' O.C.	1 GALLON
	NEW GOLD LANTANA	LANTANA CAMARA	5 O.C.	1 GALLON

NOTES:  
 \*FLATS SHALL HAVE 50 PLANTS PER FLAT  
 (1) CANYON CREST DRIVE LOCATION  
 (2) MAGNOLIA AVENUE LOCATION  
 O.C. = ON CENTER  
 GAL. = GALLON

**IRRIGATION CONSTRUCTION NOTES:**

- ALL IRRIGATION SHALL BE DESIGNED AS A TORO DRIP SYSTEM OR CITY APPROVED EQUAL PER SPECIAL PROVISIONS.
- EXISTING IRRIGATION SHALL BE REPLACED AS NECESSARY TO PROVIDE A NEW DRIP SYSTEM TO ALL EXISTING AND PROPOSED PLANTING.
- ALL PORTIONS OF THE EXISTING IRRIGATION SYSTEM WHICH WILL NO LONGER BE IN OPERATION AS A RESULT OF THE PROPOSED MODIFICATIONS INCLUDING IRRIGATION LINES AND SPRAYERS SHALL BE REMOVED AND PROPERLY DISPOSED.
- ALL EXISTING CONTROLLER WIRING AND SLEEVING SHALL BE PROTECTED IN PLACE. ALL EXISTING IRRIGATION FACILITIES WITHIN THE PARKWAYS INCLUDING CONTROLLERS SHALL REMAIN.
- ALL EXISTING PLANTS AND TREES SHALL BE WATERED AND MAINTAINED DURING CONSTRUCTION BY THE CONTRACTOR.
- IT IS ANTICIPATED THAT THE ONLY MODIFICATIONS TO THE IRRIGATION SYSTEM WILL BE THE REPLACEMENT OF THE VALVES AND CONVERSION OF THE OVERHEAD SPRAY SYSTEM TO A NEW DRIP SYSTEM. PRESSURE CALCULATIONS SHALL BE SUBMITTED BY A LICENSED LANDSCAPE ARCHITECT.

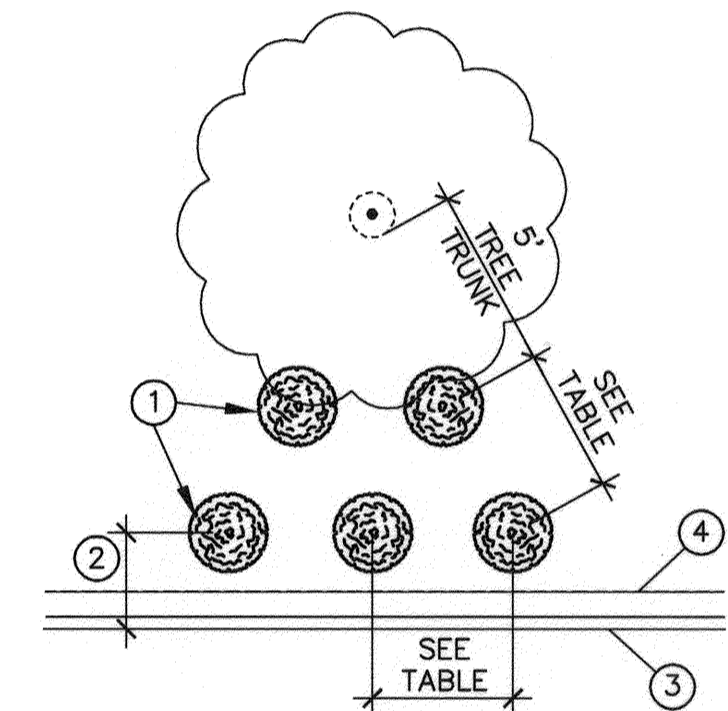

**LEGEND:**

- LOCATE PLANTS WITH EQUAL SPACING AS INDICATED. (SEE TABLES)
- 30"-36" ON-CENTER SPACING.
- EXISTING CONCRETE CURB FACE.
- EXISTING STAMPED CONCRETE BAND. (IF APPLICABLE)
- NO PLANTINGS ALLOWED WITHIN 5' OF EXISTING TREE TRUNKS.

**TYPICAL PLANTING SPACING:**

NOT TO SCALE

**TABLE OF CONTENTS:**

SHEET #	DESCRIPTION
1	GENERAL NOTES AND LOCATION MAPS
2-6	MAGNOLIA AVENUE FROM JACKSON TO ARLINGTON
7-8	MARTIN LUTHER KING BOULEVARD FROM BERMUDA TO CHICAGO
9-10	CANYON CREST BOULEVARD FROM EL CERRITO TO COUNTRY CLUB



**ENGINEER IN RESPONSIBLE CHARGE**  
 EDWARD LARA  
 R.C.E. No. 63753 EXPIRES: 9-30-16  
 DATE February 18, 2015

MARK	REVISIONS	APPR.	DATE

**CITY OF RIVERSIDE, CALIFORNIA DEPARTMENT OF PUBLIC WORKS**

APPROVED BY	BY	DATE	APPROVED BY
ENGINEERING MANAGER	E.L. Lara	2/19/15	[Signature]
CONSTRUCTION ADMIN.	[Signature]	2/19/15	CITY ENGINEER
TRAFFIC DIVISION	[Signature]	2-19-15	
STREETS SERVICES	[Signature]	2-20-15	

DESIGNED BY: DMC, DRAWN BY: DMC, CHECKED BY: EL

**LANDSCAPE MEDIAN IMPROVEMENTS**

**MEDIAN TURF REMOVAL PROJECT, PHASE II**

LOCATION MAPS, GENERAL NOTES AND PLANTING LEGEND

HORIZ. SCALE: N/A VERT. SCALE: N/A




AS-BUILT 10-21-15 DC

RPU DESIGN WORK ORDER: #1508348  
 RPU CONSTR. WORK ORDER: #1508353

**M-479**

SHEET 1 OF 10

FILE NAME: M479-1.DWG

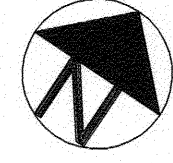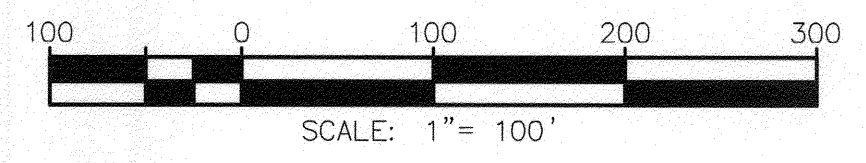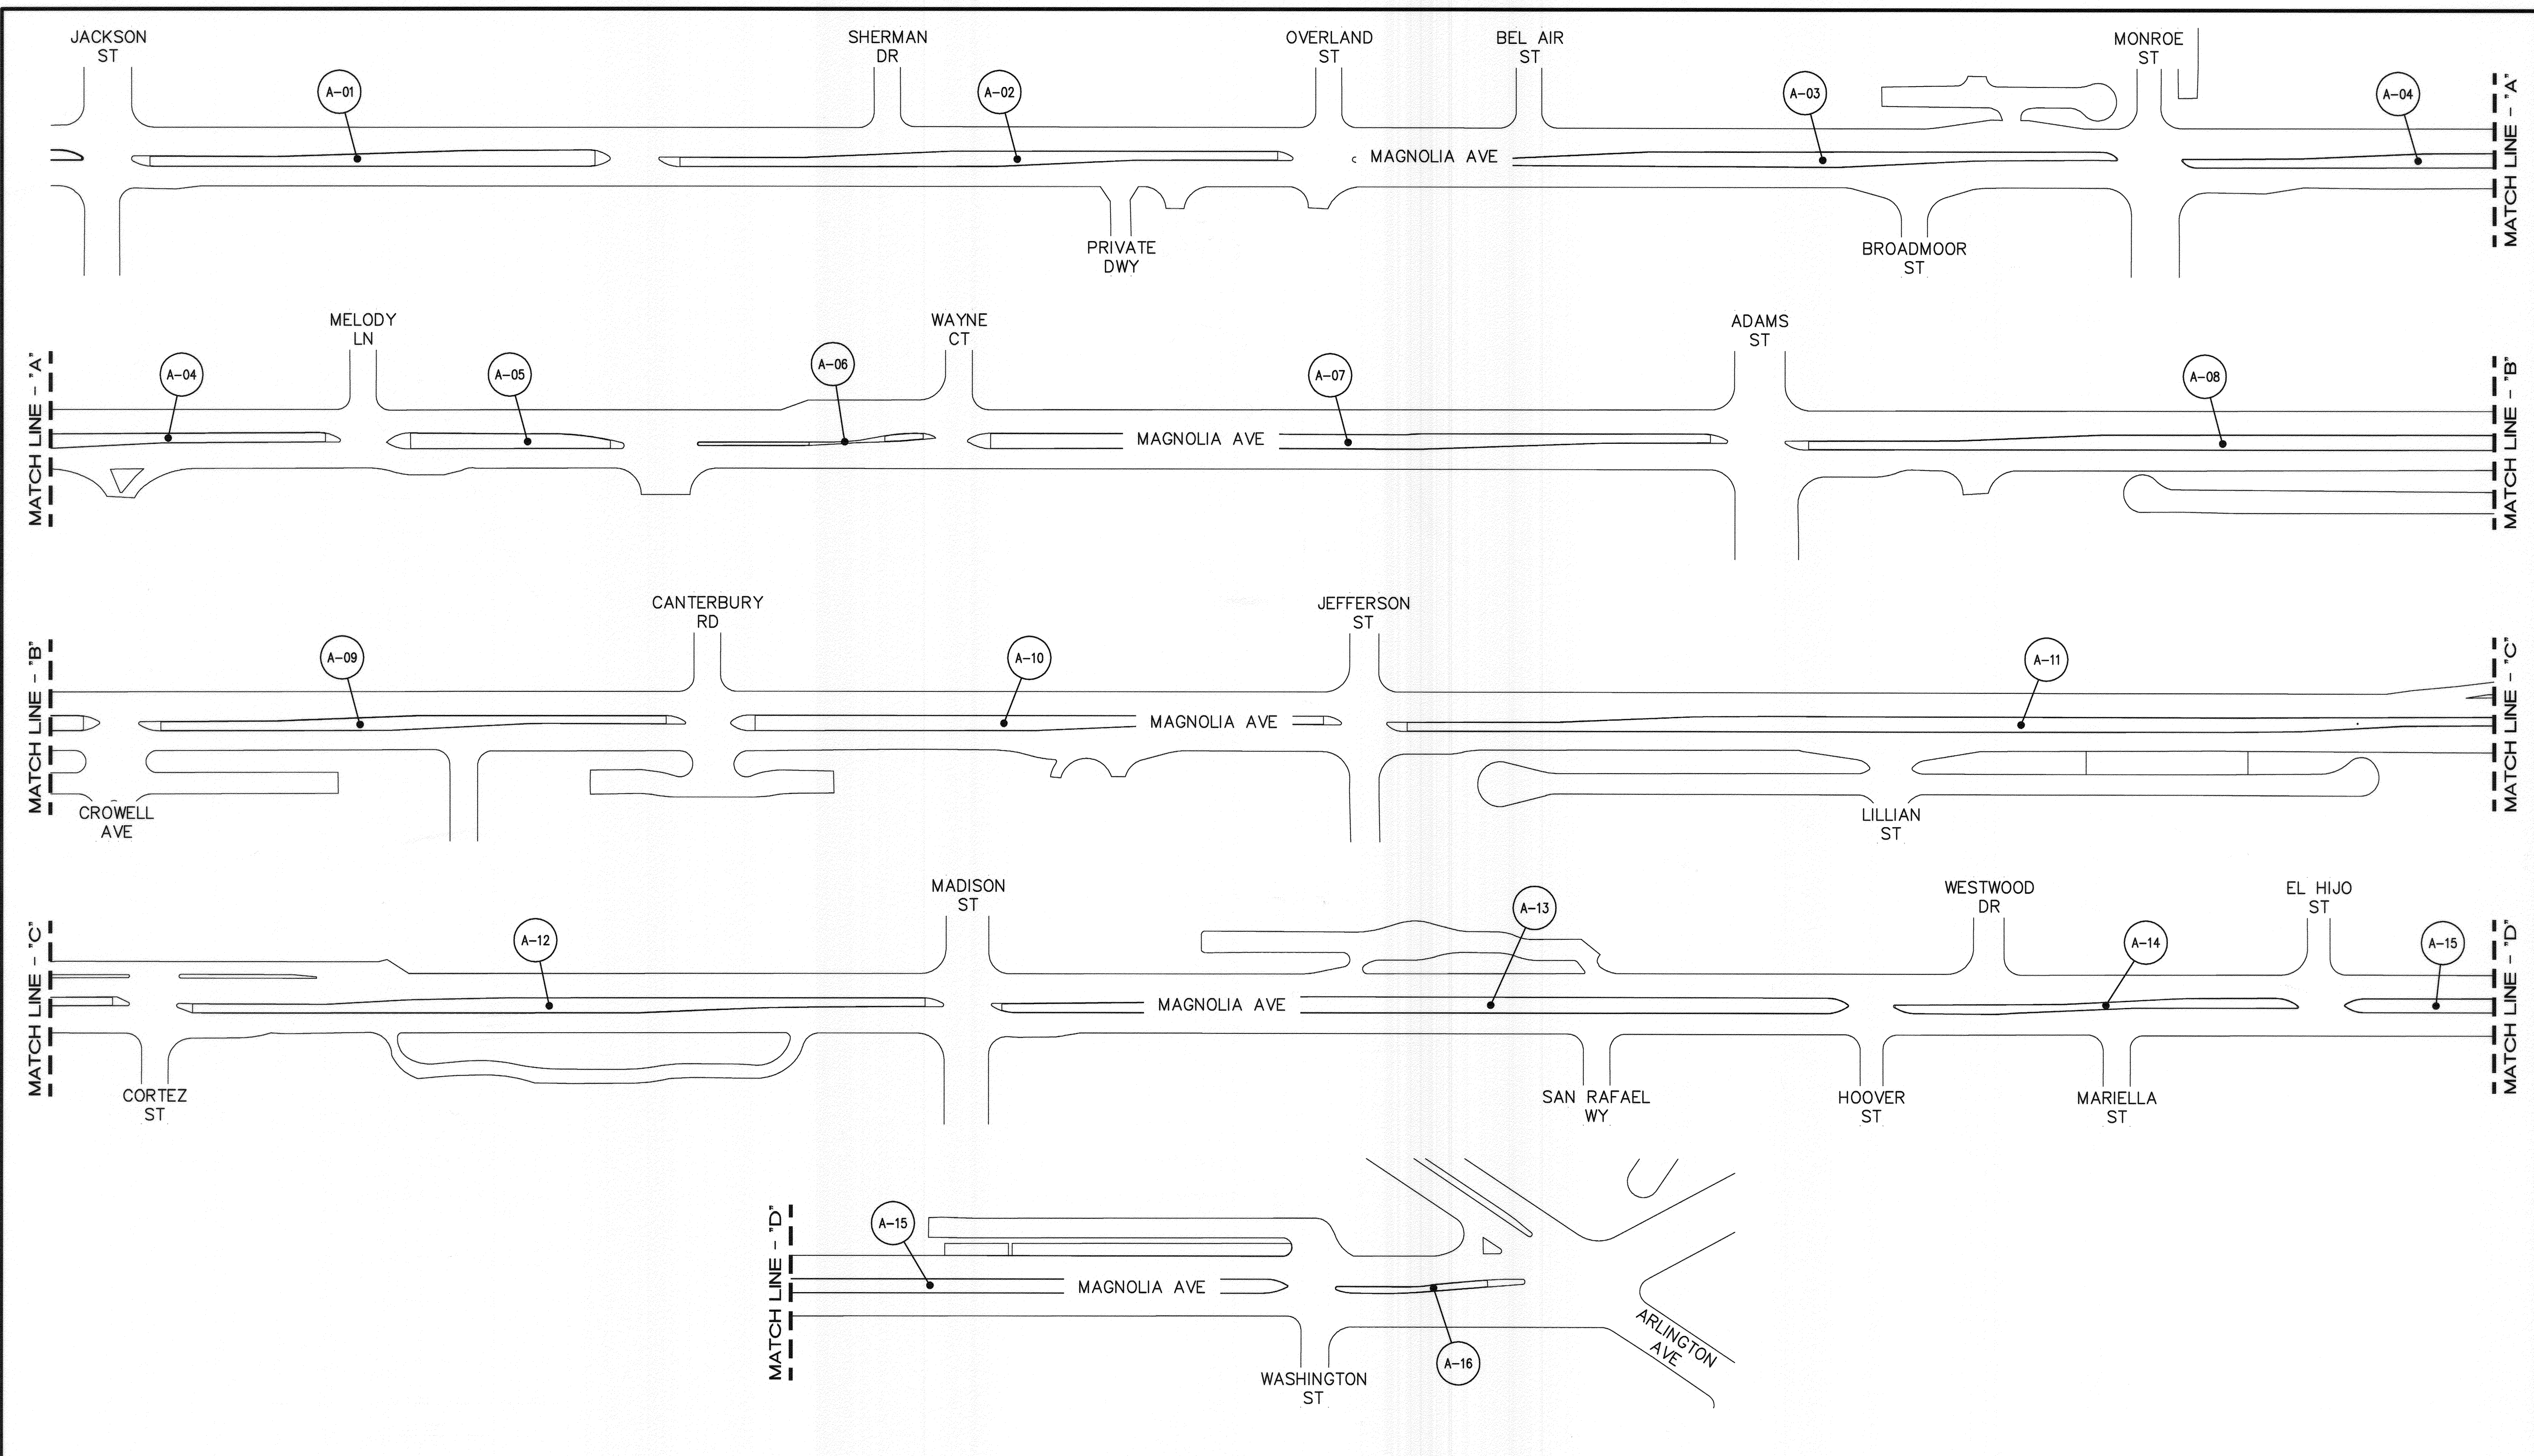

AREA MAP:  
SCALE: 1" = 100'

Under Ground Service Alert of Southern California  
Call: TOLL FREE 1-800-227-2600  
TWO WORKING DAYS BEFORE YOU DIG

**ENGINEER IN RESPONSIBLE CHARGE**  
Edward Lara  
EDWARD LARA  
R.C.E. No. 63753 EXPIRES: 9-30-16  
DATE: February 12, 2015

MARK	REVISIONS	APPR.	DATE

DESIGNED BY: DMC DRAWN BY: DMC CHECKED BY: EL

CITY OF RIVERSIDE, CALIFORNIA  
DEPARTMENT OF PUBLIC WORKS

APPROVED BY	BY	DATE	APPROVED BY
ENGINEERING MANAGER	E. L. Lara	2/19/2015	[Signature]
CONSTRUCTION ADMIN.	D.C.	2/19/15	CITY ENGINEER
TRAFFIC DIVISION	R.F.	2-19-15	
STREETS SERVICES	R.F.	2-20-15	

DATE: 2/19/2015

LANDSCAPE MEDIAN IMPROVEMENTS


MEDIAN TURF REMOVAL PROJECT, PHASE II
MAGNOLIA AVENUE
HORIZ. SCALE: 1"=100' VERT. SCALE: N/A

RPU DESIGN WORK ORDER: #1508348  
RPU CONSTR. WORK ORDER: #1508353


**M-479**

SHEET 2 OF 10


FILE NAME: M479-2.DWG

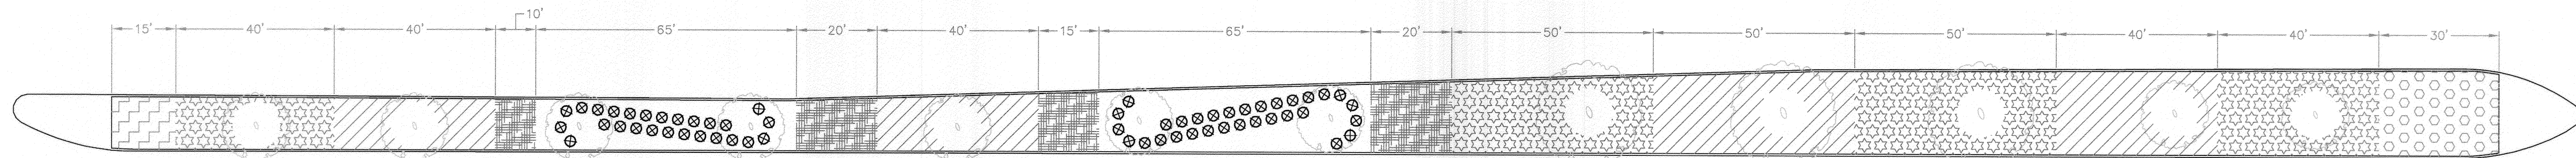


**MEDIAN A-01:**  
SCALE: 1" = 20'

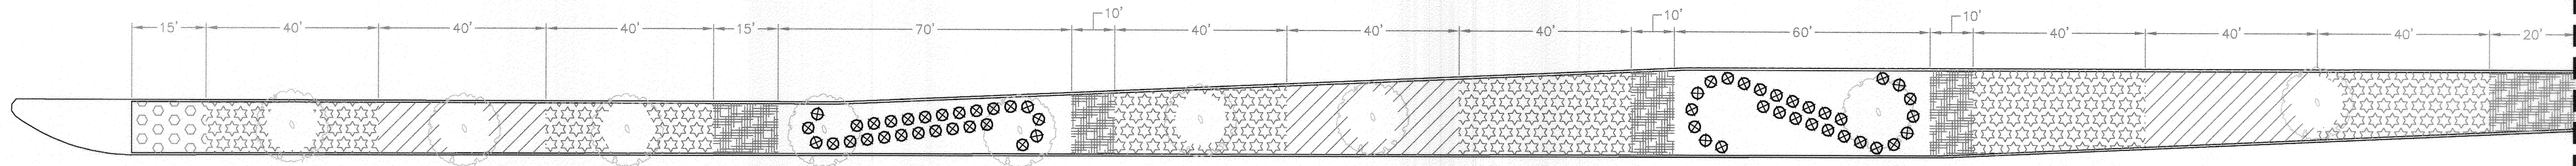


**MEDIAN A-02:**  
SCALE: 1" = 20'

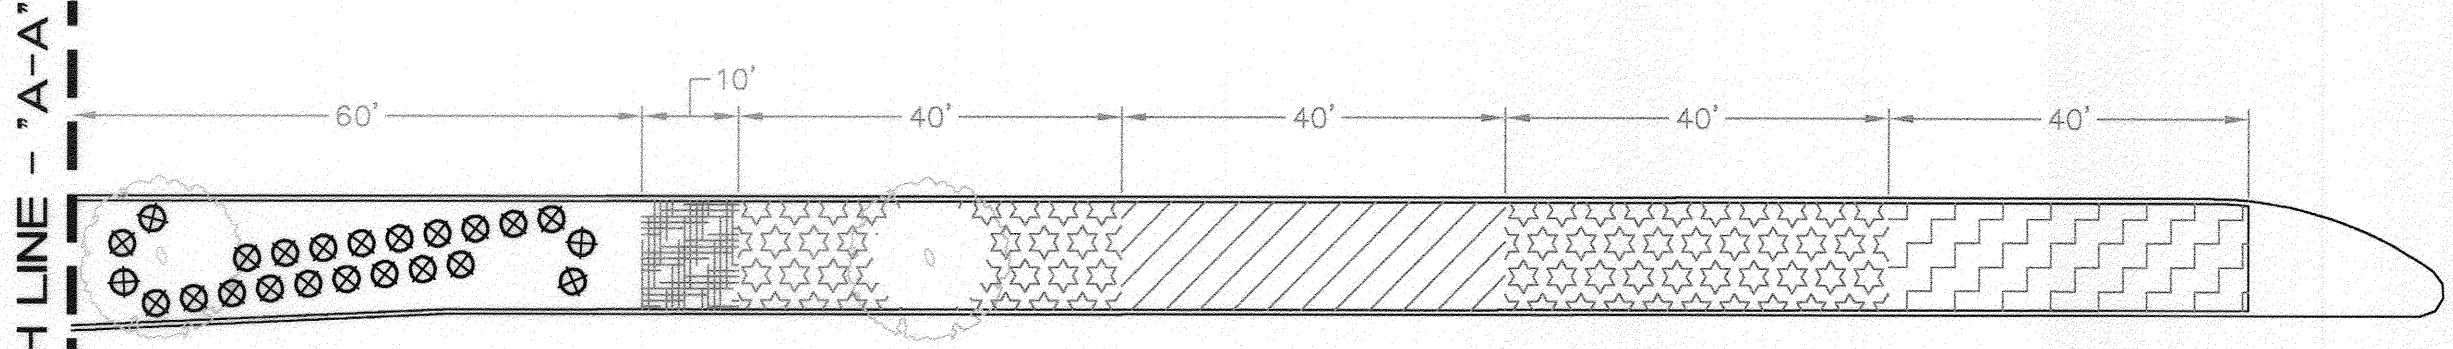


**MEDIAN A-02: (CONT'D)**  
SCALE: 1" = 20'

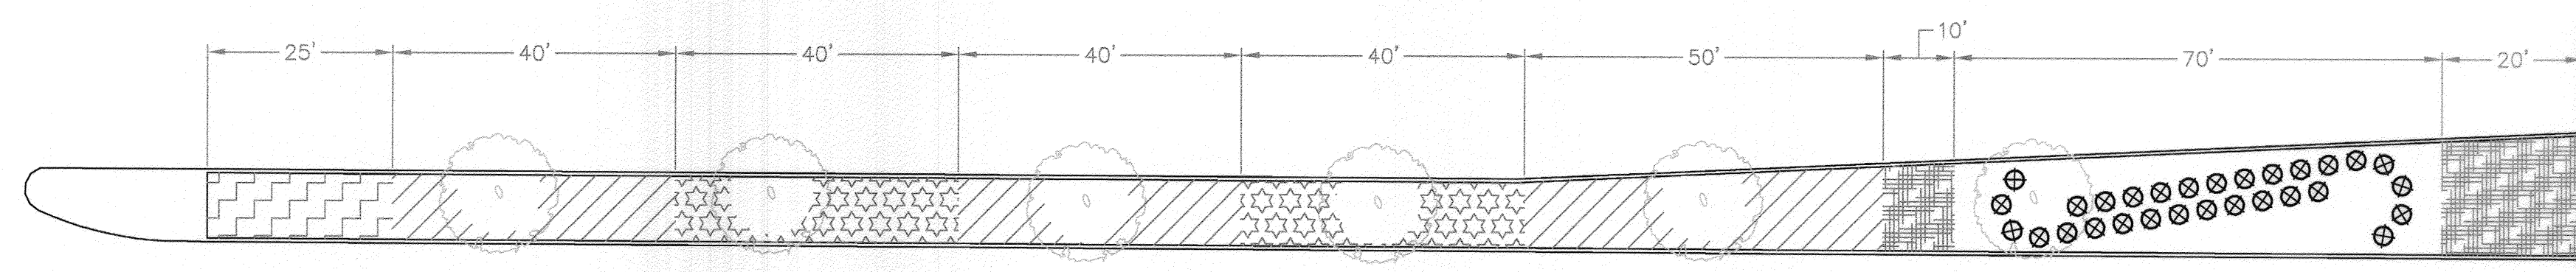


**MEDIAN A-03:**  
SCALE: 1" = 20'

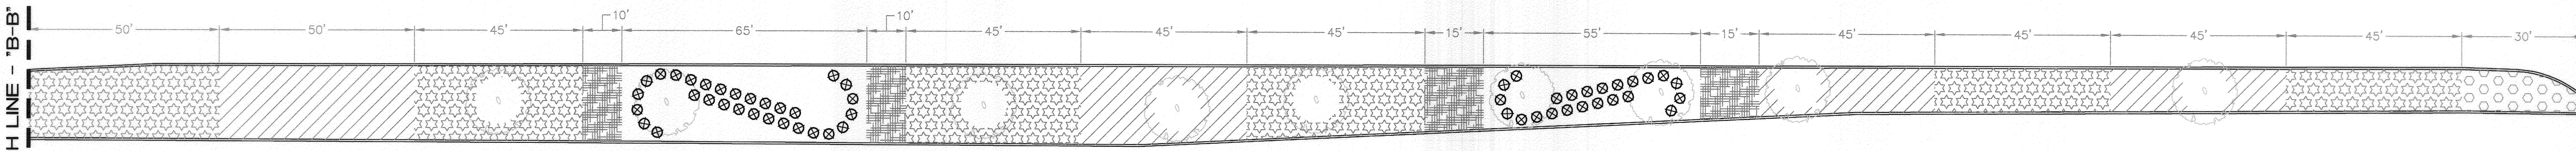


**MEDIAN A-03: (CONT'D)**  
SCALE: 1" = 20'

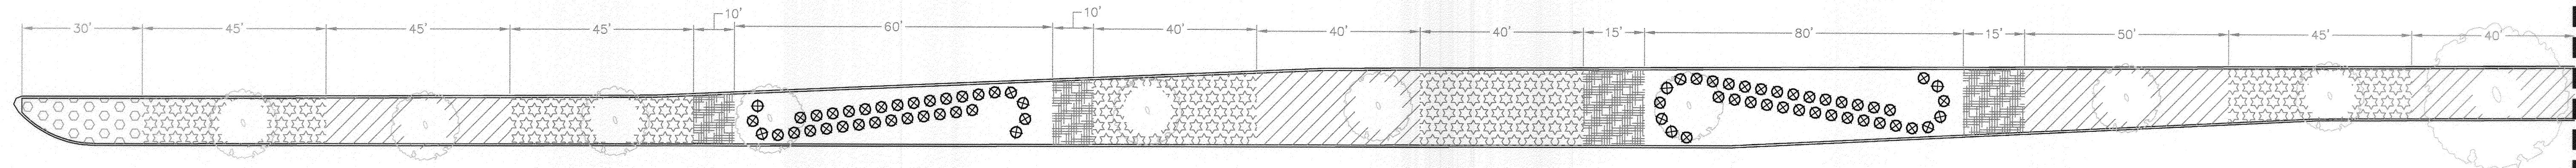



**MEDIAN A-04:**  
SCALE: 1" = 20'

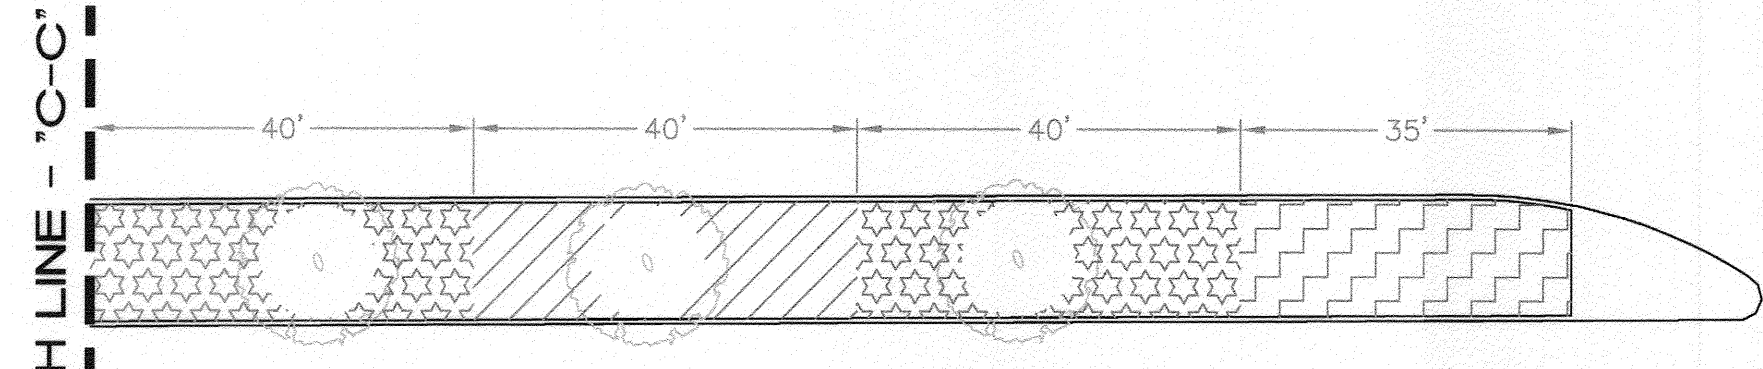


**MEDIAN A-04: (CONT'D)**  
SCALE: 1" = 20'

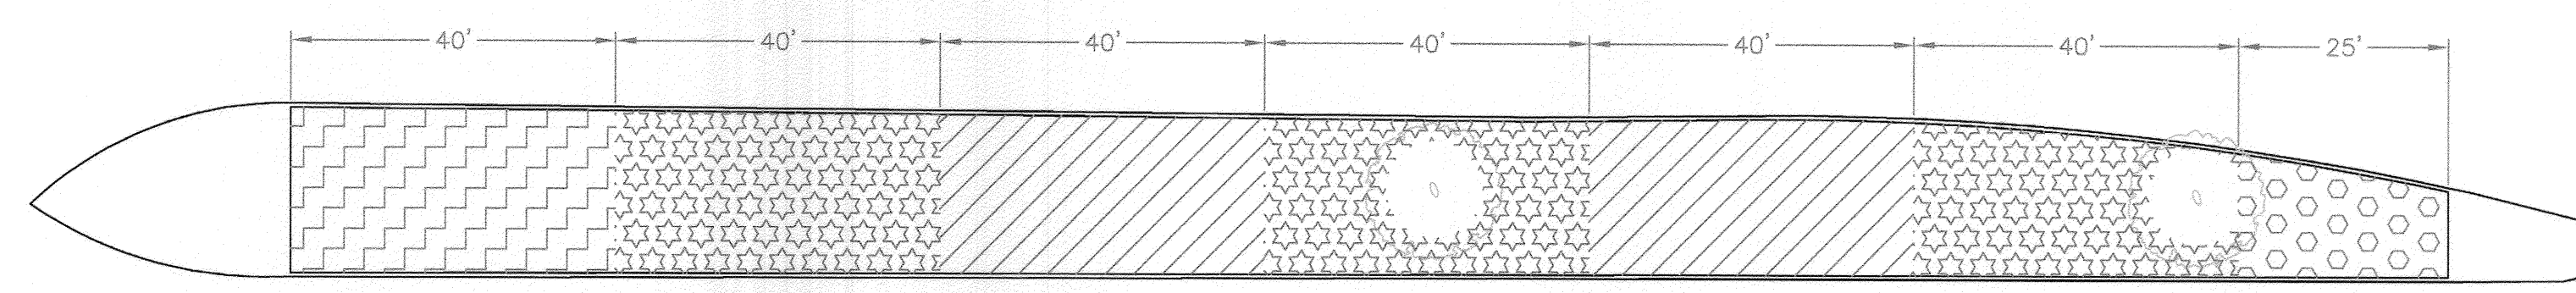


**MEDIAN A-05:**  
SCALE: 1" = 20'

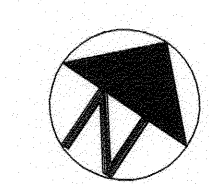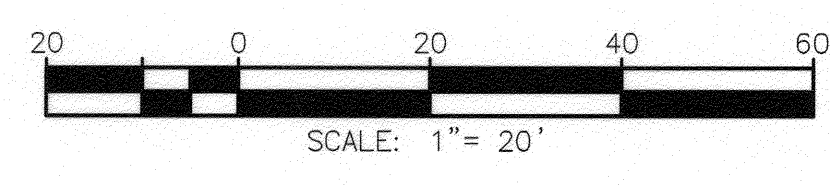

Under Ground Service Alert of Southern California  
Call: TOLL FREE 1-800-227-2600  
TWO WORKING DAYS BEFORE YOU DIG

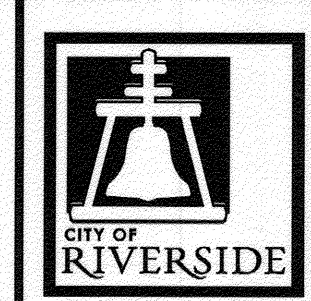

**ENGINEER IN RESPONSIBLE CHARGE**  
Edward Lara  
EDWARD LARA  
R.C.E. No. 63753 EXPIRES: 9-30-16  
DATE February 13, 2015

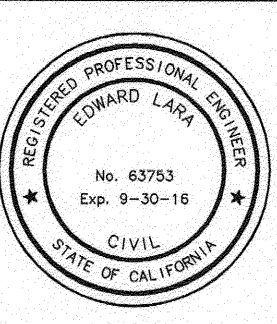


MARK	REVISIONS	APPR.	DATE

CITY OF RIVERSIDE, CALIFORNIA DEPARTMENT OF PUBLIC WORKS			
APPROVED BY	BY	DATE	APPROVED BY
ENGINEERING MANAGER	<i>E. Lara</i>	2/19/15	<i>[Signature]</i>
CONSTRUCTION ADMIN.	<i>DC</i>	2/19/15	CITY ENGINEER
TRAFFIC DIVISION	<i>R.F.</i>	2.19.15	DATE 2/19/2015
STREETS SERVICES	<i>R.F.</i>	2.19.15	


LANDSCAPE MEDIAN IMPROVEMENTS	
MAGNOLIA AVENUE	
MEDIAN TURF REMOVAL PROJECT, PHASE II	

RPW DESIGN WORK ORDER: #1508348 RPW CONSTR. WORK ORDER: #1508353	<b>M-479</b>
SHEET 3 OF 10	FILE NAME: M479-3.DWG


HORIZ. SCALE: 1"=20' VERT. SCALE: N/A

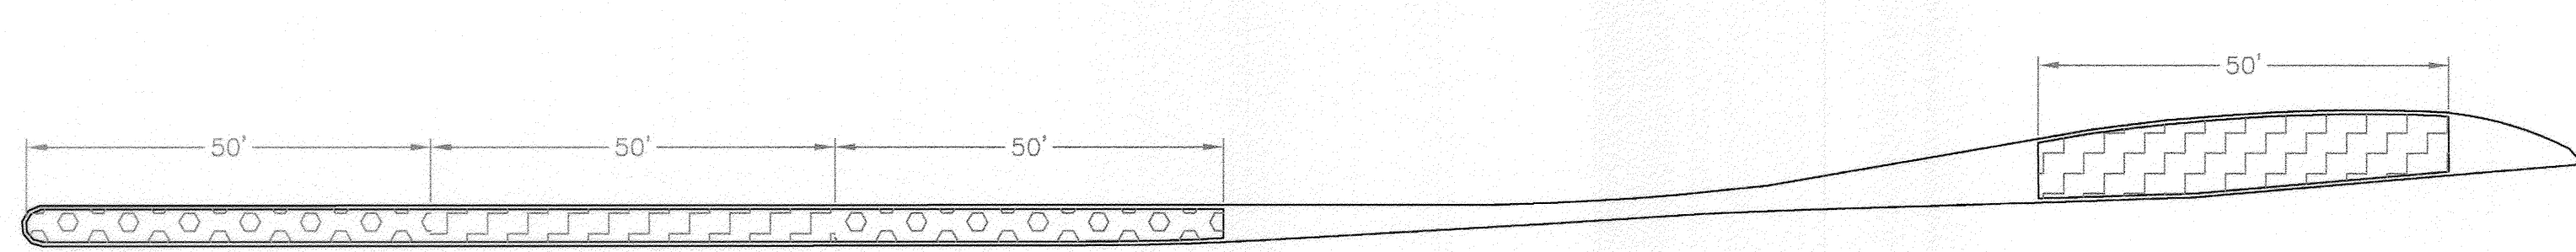


**MEDIAN A-06:**  
SCALE: 1" = 20'

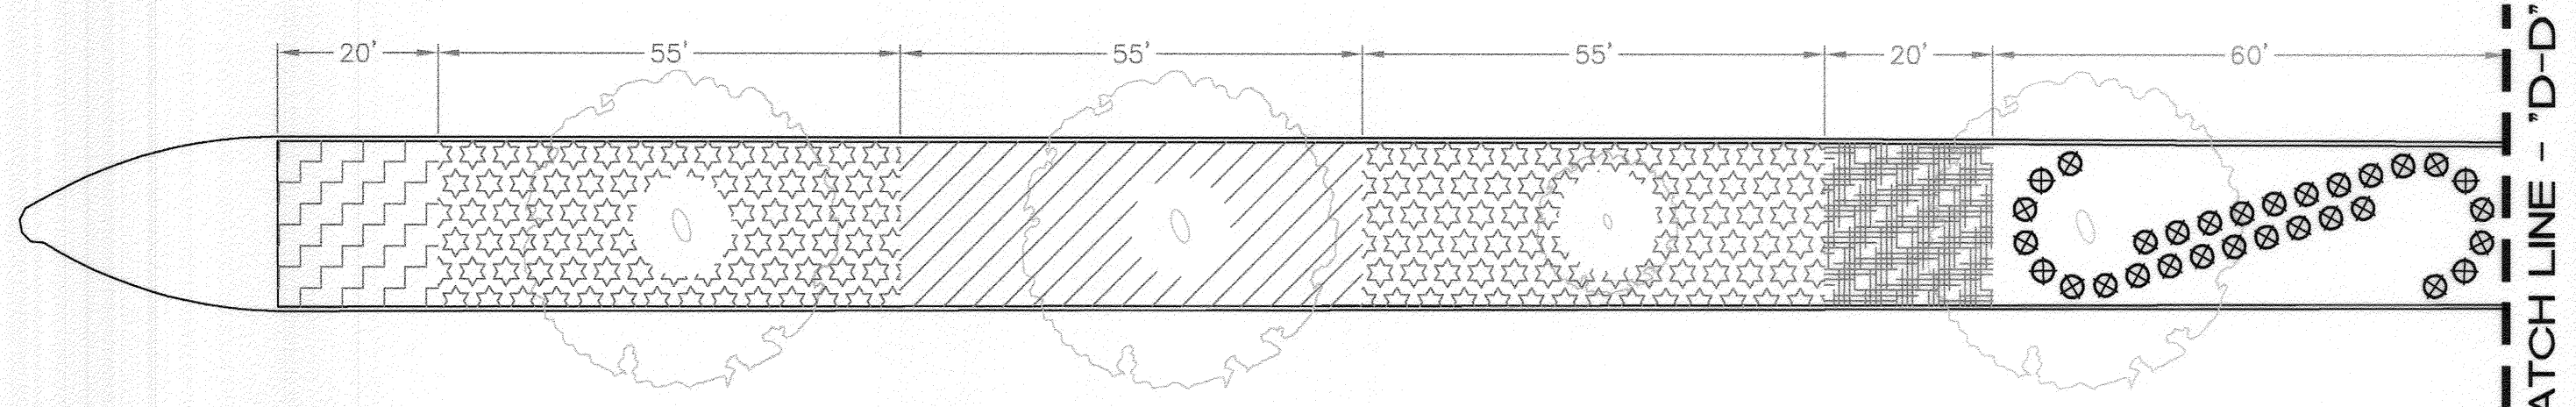

**MEDIAN A-07:**  
SCALE: 1" = 20'

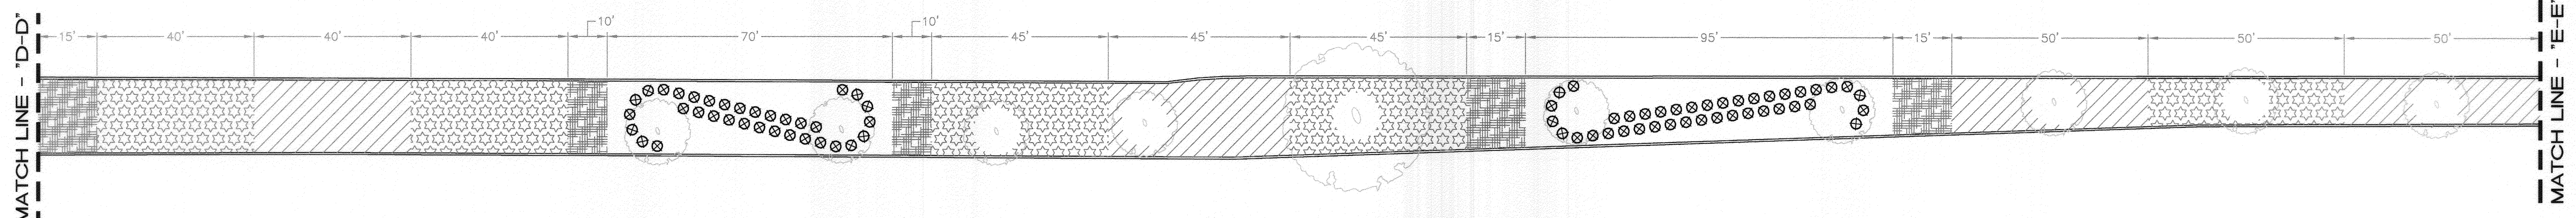


**MEDIAN A-07: (CONT'D)**  
SCALE: 1" = 20'

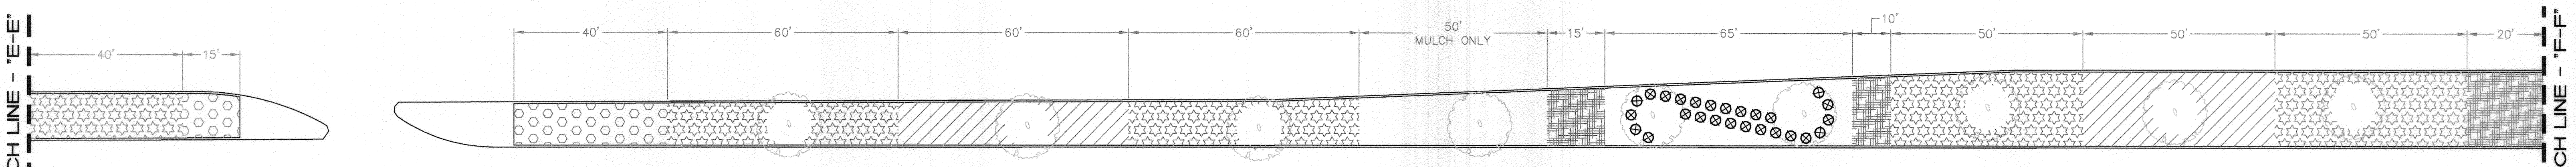


**MEDIAN A-07: (CONT'D)**  
SCALE: 1" = 20'


**MEDIAN A-08:**  
SCALE: 1" = 20'

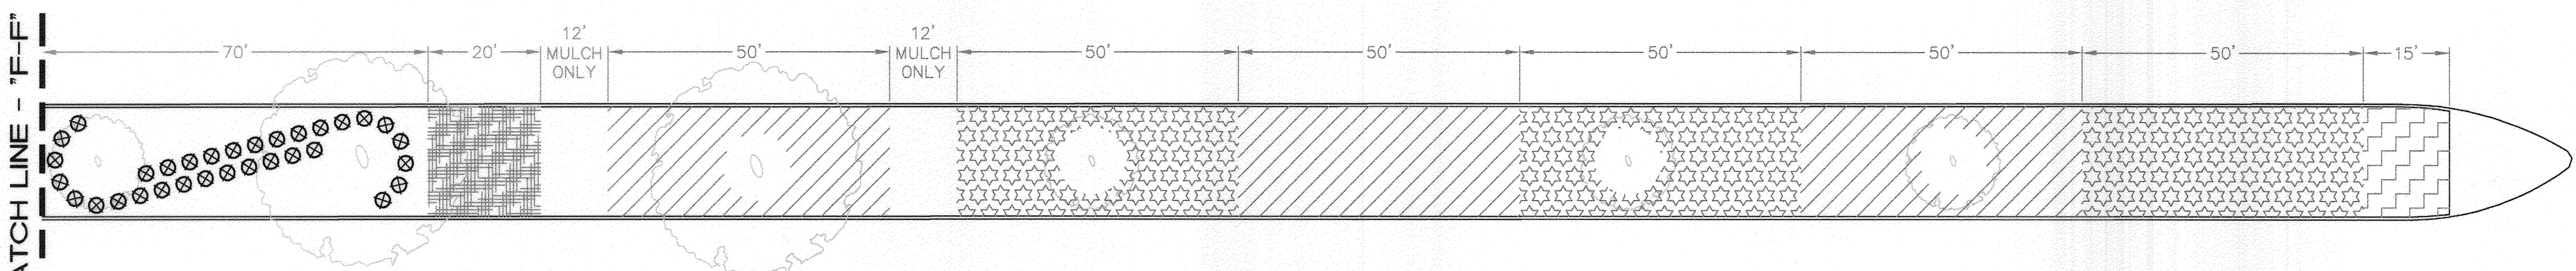


**MEDIAN A-08: (CONT'D)**  
SCALE: 1" = 20'

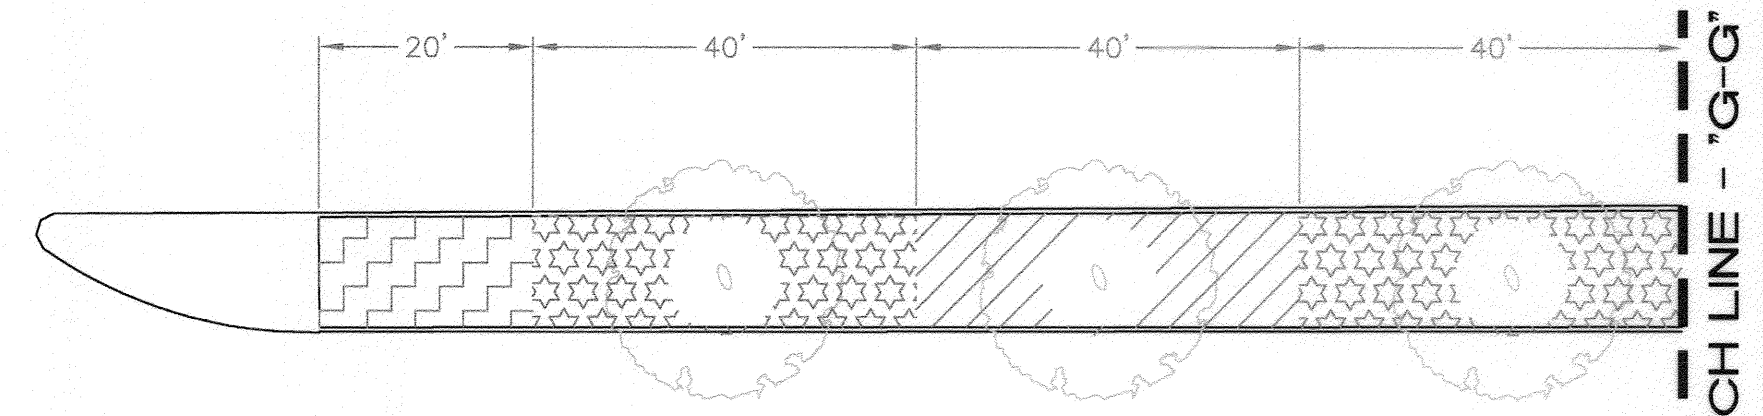



**MEDIAN A-09:**  
SCALE: 1" = 20'

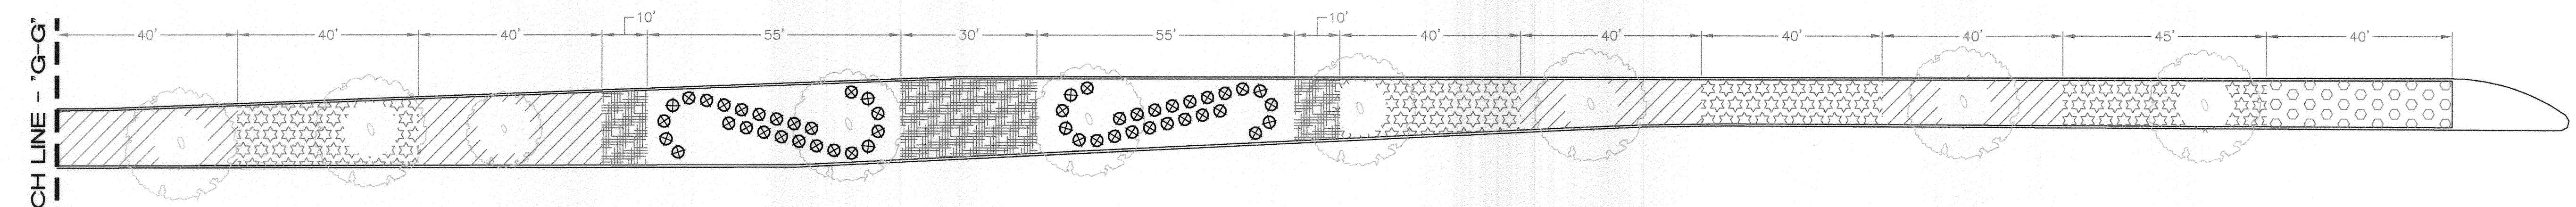


**MEDIAN A-09: (CONT'D)**  
SCALE: 1" = 20'

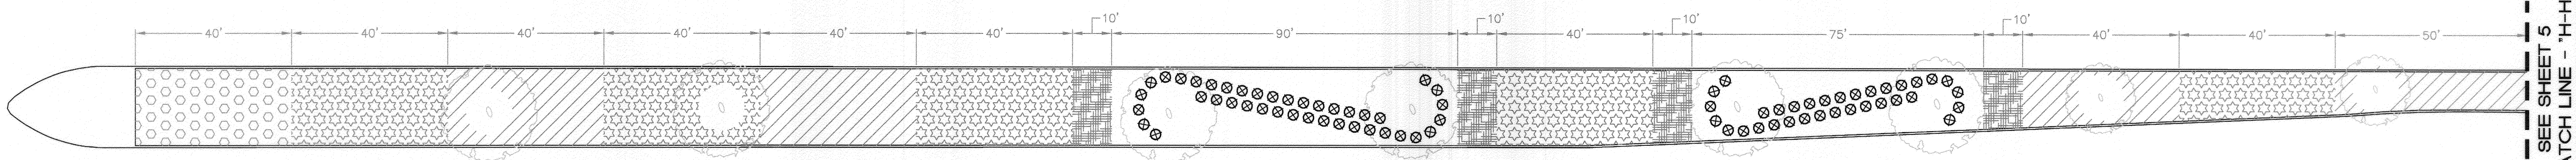


**MEDIAN A-10:**  
SCALE: 1" = 20'

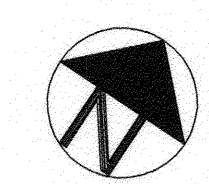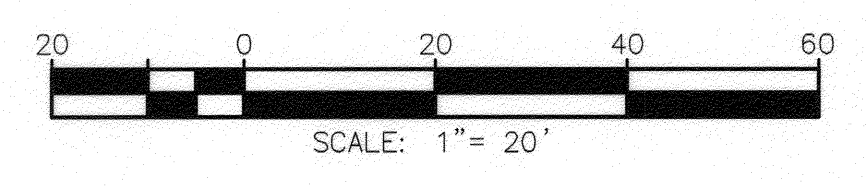

Under Ground Service Alert of Southern California  
Call: TOLL FREE 1-800-227-2600  
TWO WORKING DAYS BEFORE YOU DIG

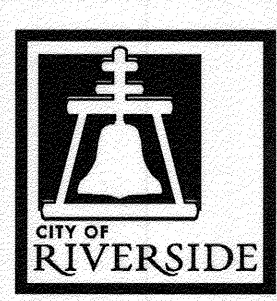

**ENGINEER IN RESPONSIBLE CHARGE**  
EDWARD LARA  
R.C.E. No. 63753 EXPIRES: 9-30-16  
DATE February 13, 2015

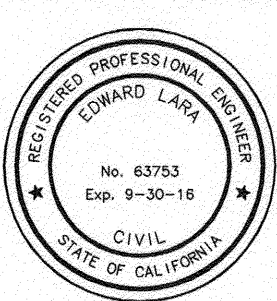

MARK	REVISIONS	APPR.	DATE

DESIGNED BY: DMC DRAWN BY: DMC CHECKED BY: EL

**CITY OF RIVERSIDE, CALIFORNIA**  
**DEPARTMENT OF PUBLIC WORKS**

APPROVED BY	BY	DATE	APPROVED BY
ENGINEERING MANAGER	Ed. Lara	2/19/15	Edward Lara
CONSTRUCTION ADMIN.		2/19/15	
TRAFFIC DIVISION		2-19-15	
STREETS SERVICES	R.F.	2-24-15	

DATE: 2/19/2015

**LANDSCAPE MEDIAN IMPROVEMENTS**

**MEDIAN TURF REMOVAL PROJECT, PHASE II**

**MAGNOLIA AVENUE**

HORIZ. SCALE: 1"=20' VERT. SCALE: N/A

RPU DESIGN WORK ORDER: #1508348  
RPU CONSTR. WORK ORDER: #1508353

**M-479**

SHEET 4 OF 10

FILE NAME: M479-4.DWG




SEE SHEET 5  
MATCH LINE - 'H-H'

MATCH LINE - 'G-G'


MATCH LINE - 'F-F'

MATCH LINE - 'E-E'


MATCH LINE - 'D-D'

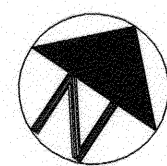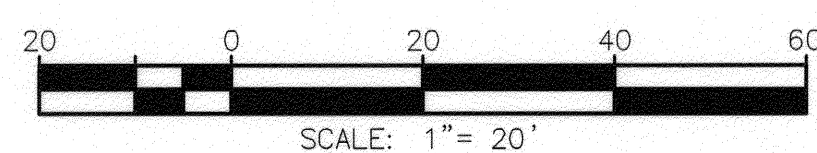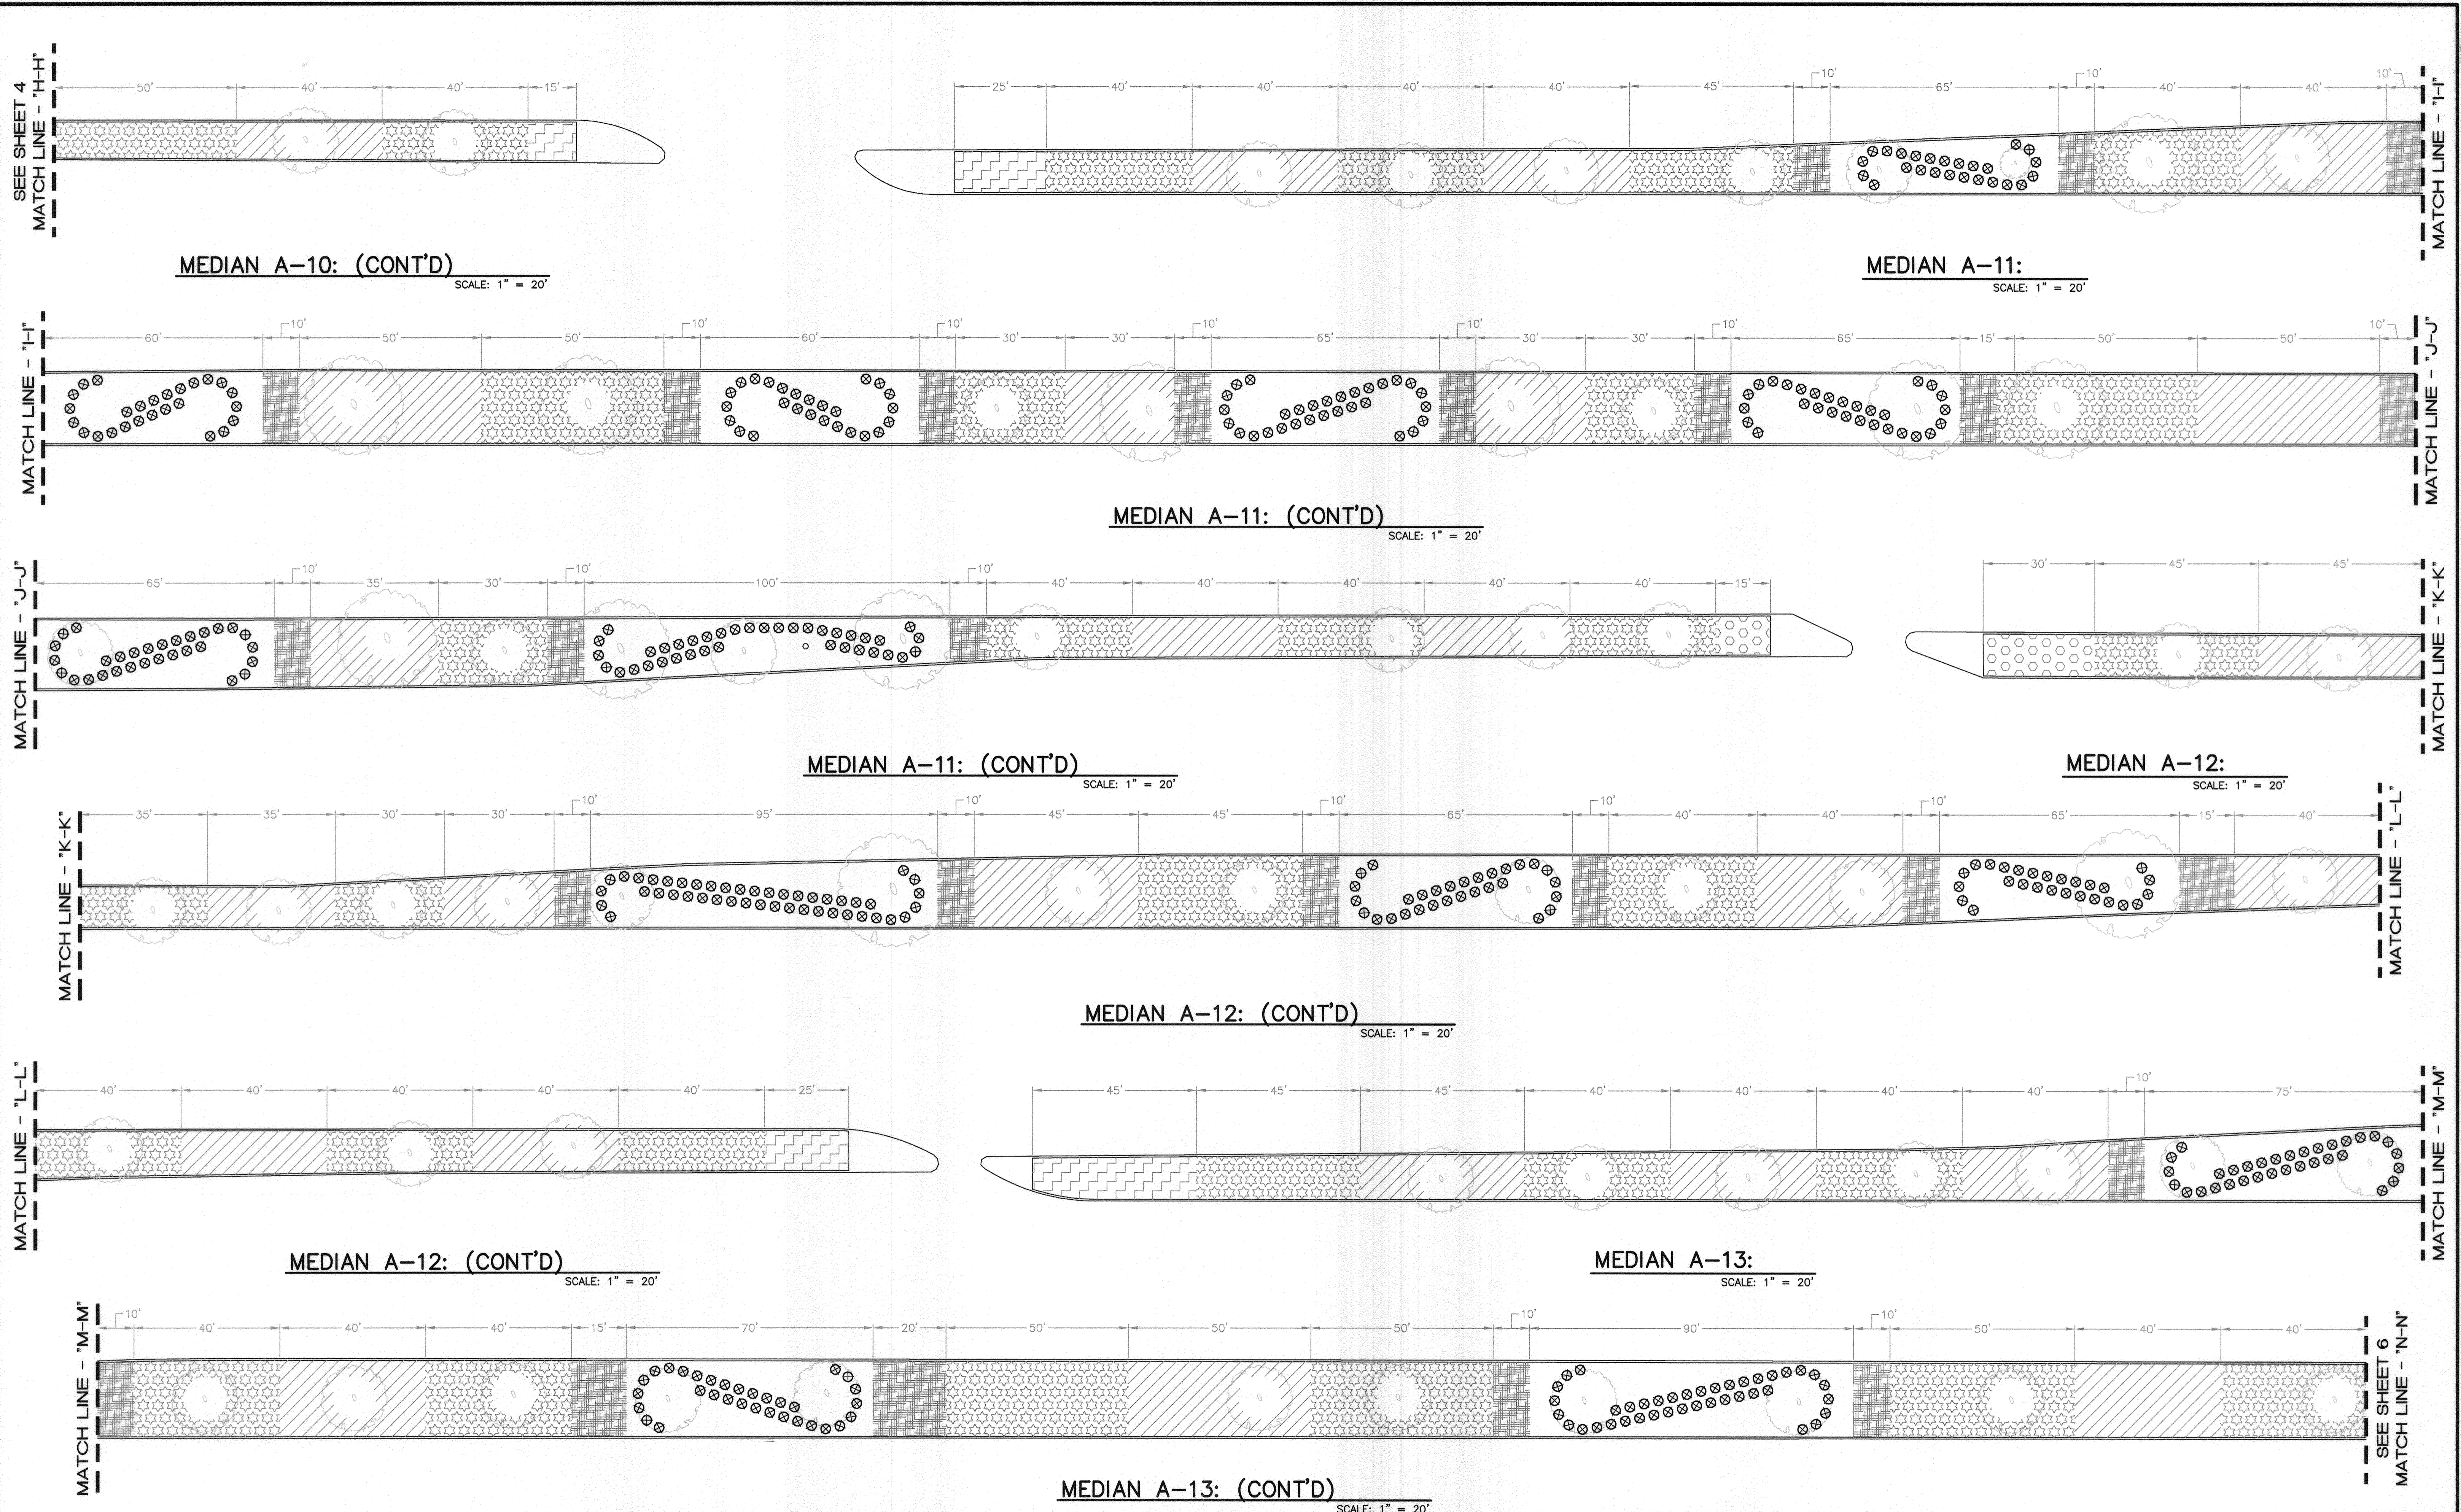

Under Ground Service Alert of Southern California  
Call: TOLL FREE 1-800-227-2600  
**TWO WORKING DAYS BEFORE YOU DIG**

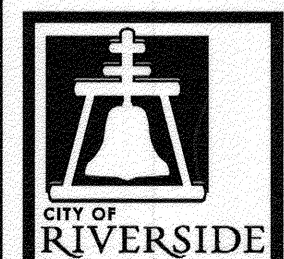

**ENGINEER IN RESPONSIBLE CHARGE**  
*Edward Lara*  
EDWARD LARA  
R.C.E. No. 63753 EXPIRES: 9-30-16  
DATE: February 13, 2015

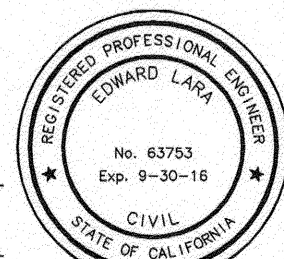


MARK	REVISIONS	APPR.	DATE


DESIGNED BY: DMC DRAWN BY: DMC CHECKED BY: EL

CITY OF RIVERSIDE, CALIFORNIA DEPARTMENT OF PUBLIC WORKS			
APPROVED BY	BY	DATE	APPROVED BY
ENGINEERING MANAGER	<i>E. G. A. P.</i>	2/19/15	<i>[Signature]</i>
CONSTRUCTION ADMIN.	<i>DC</i>	2/19/15	CITY ENGINEER
TRAFFIC DIVISION	<i>R.H.</i>	2-19-15	DATE: 2/19/2015
STREETS SERVICES	<i>R.E.</i>	2-24-15	


LANDSCAPE MEDIAN IMPROVEMENTS		RPU DESIGN WORK ORDER: #1508348
MEDIAN TURF REMOVAL PROJECT, PHASE II		RPU CONSTR. WORK ORDER: #1508353
MAGNOLIA AVENUE		M-479
HORIZ. SCALE: 1"=20'		VERT. SCALE: N/A
SHEET 5 OF 10		FILE NAME: M479-5.DWG

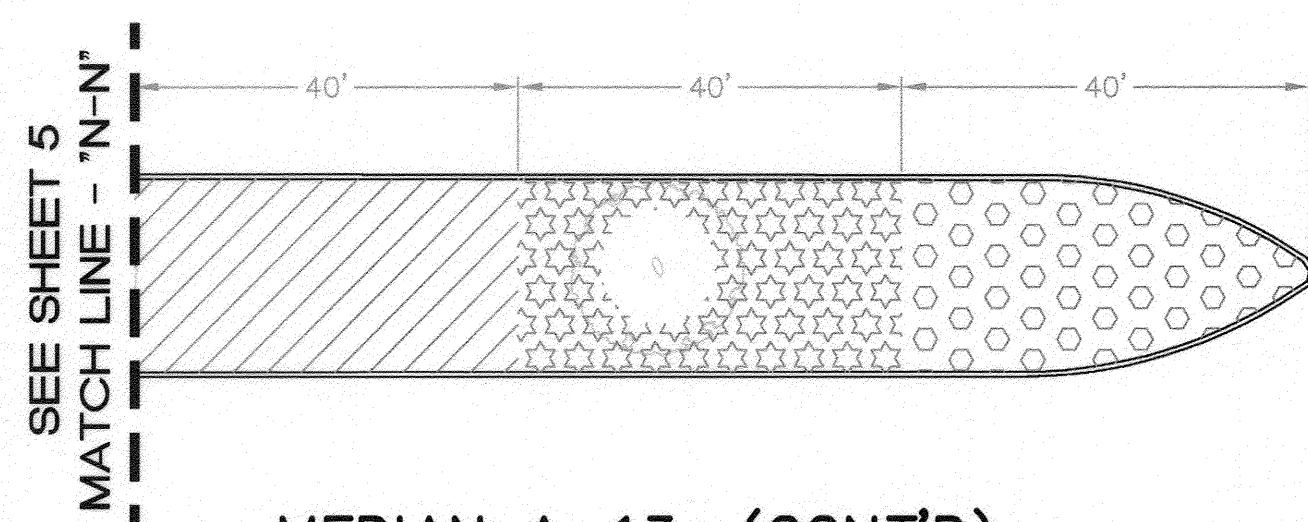


**MEDIAN A-13: (CONT'D)**  
SCALE: 1" = 20'

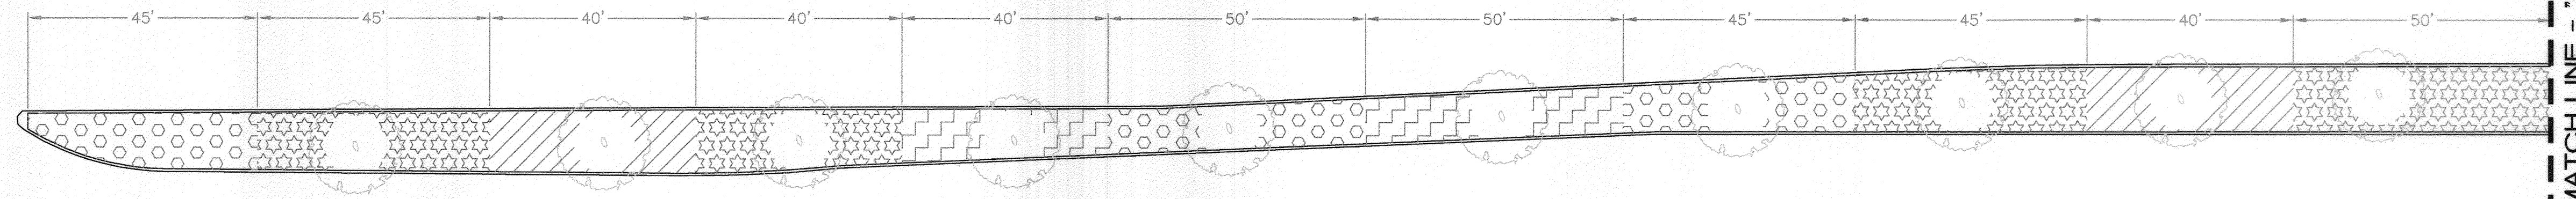


**MEDIAN A-14:**  
SCALE: 1" = 20'

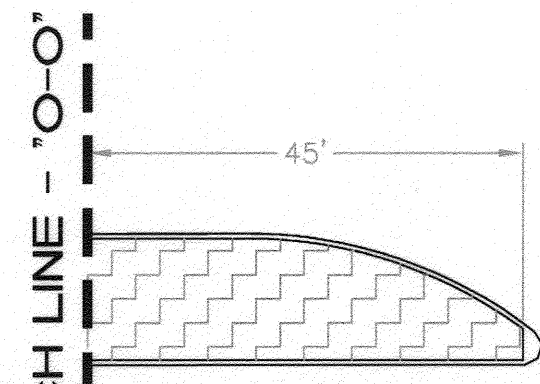


**MEDIAN A-14: (CONT'D)**  
SCALE: 1" = 20'

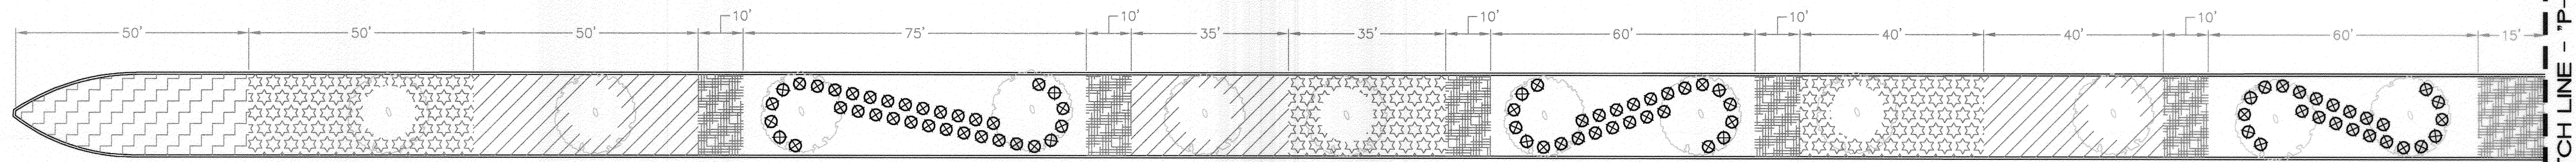

**MEDIAN A-15:**  
SCALE: 1" = 20'

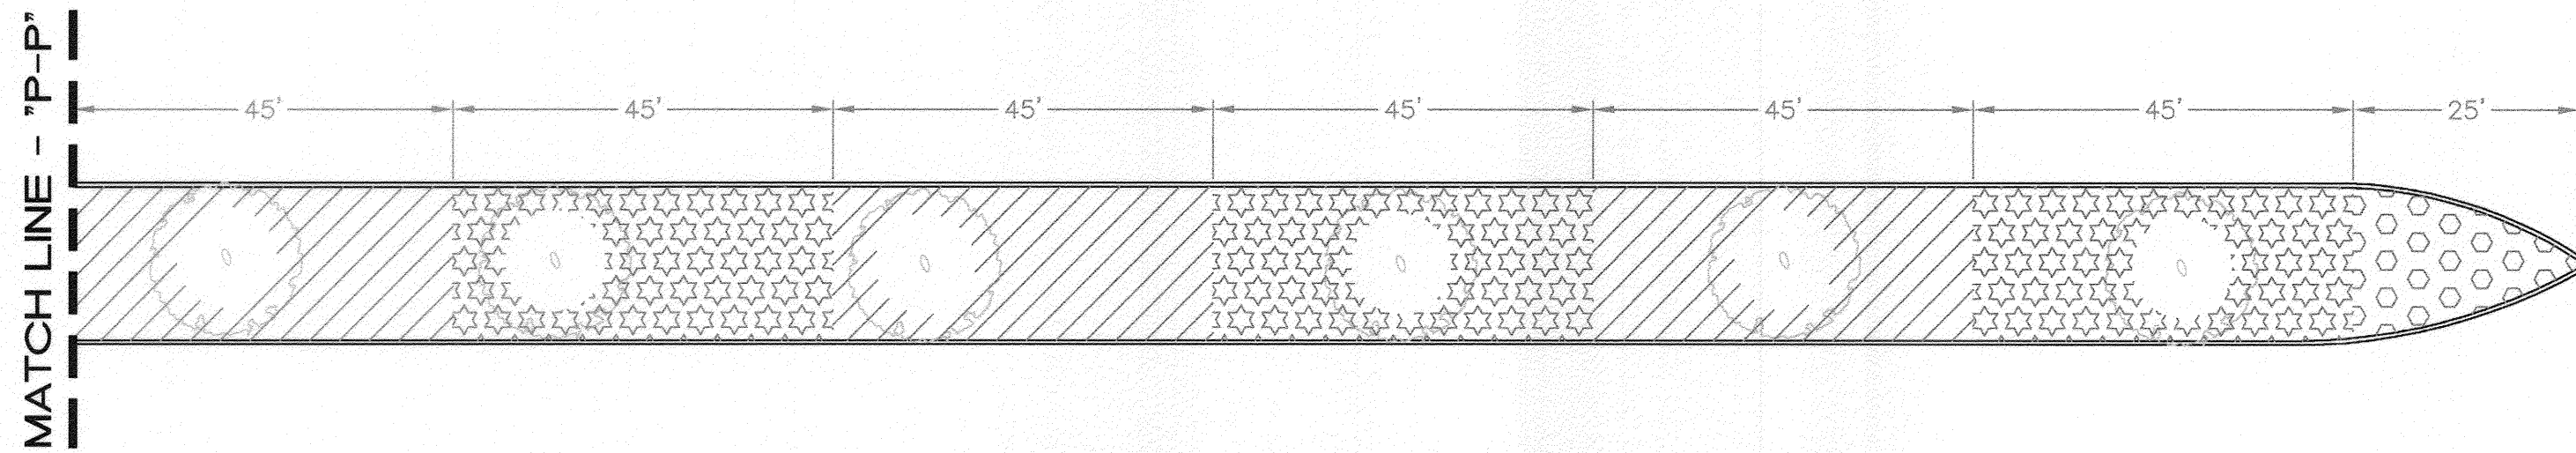

**MEDIAN A-15: (CONT'D)**  
SCALE: 1" = 20'


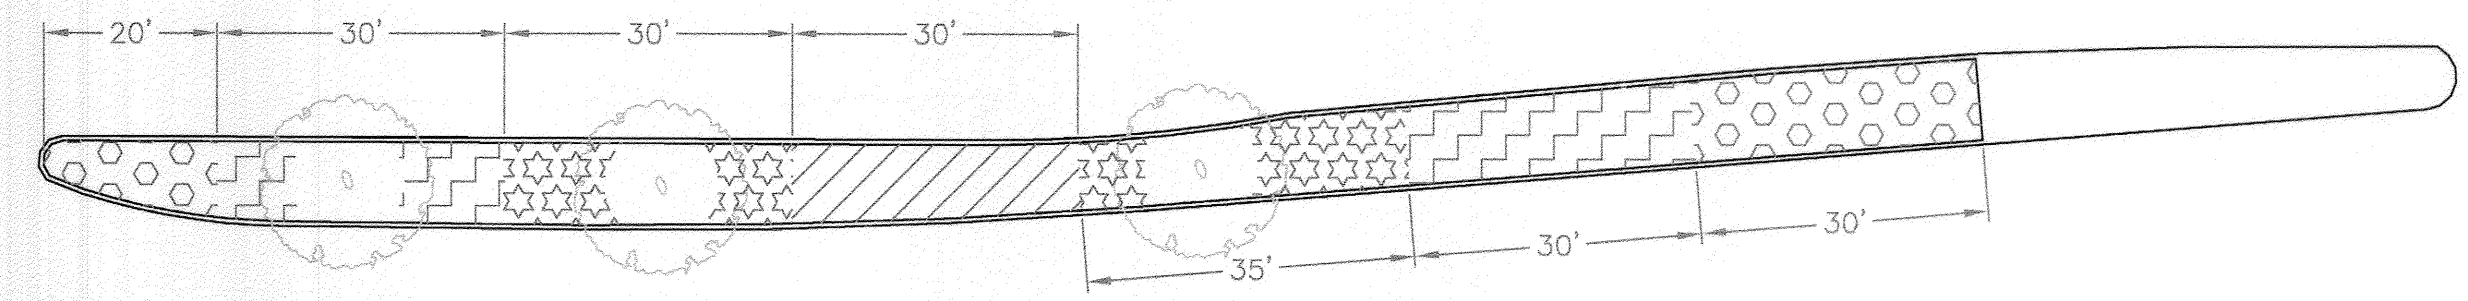


**MEDIAN A-16:**  
SCALE: 1" = 20'


**PLANTING LEGEND - MAGNOLIA AVENUE FROM JACKSON STREET AND ARLINGTON AVENUE**

SYMBOL	COMMON NAME	SIZE	SPACING	QUANTITY
⊗	WHITE ROSE	1 GAL.	4'	1040
▨	BLUE FESCUE	1 GAL.	3'	4438
⊞	STAR JASMINE	FLAT	12"	1000
⊞	PURPLE "ROSEA"	FLAT	12"	135
⊞	GAZANIA "TRAILING" YELLOW	FLAT	12"	130
⊞	SOCIETY GARLIC	1 GAL.	3'	1586


GAL. = GALLON  
FLATS SHALL HAVE 50 PLANTS PER FLAT  
\*\*NOTE: ALL PLANT QUANTITIES ARE APPROX. AND THE CONTRACTOR SHALL VERIFY FINAL NUMBERS BEFORE ORDERING.

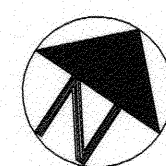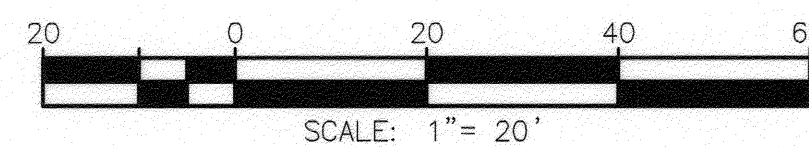

Under Ground Service Alert of Southern California  
Call: TOLL FREE 1-800 227-2600  
TWO WORKING DAYS BEFORE YOU DIG

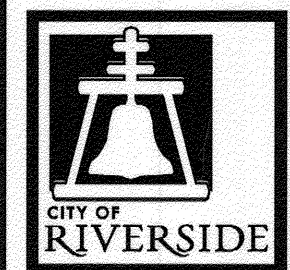

**ENGINEER IN RESPONSIBLE CHARGE**  
*Edward Lara*  
EDWARD LARA  
R.C.E. No. 63753 EXPIRES: 9-30-16  
DATE: February 13, 2015

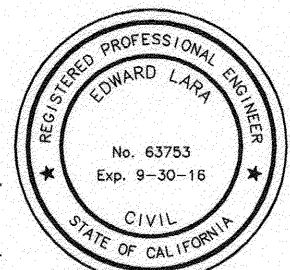

MARK REVISIONS APPR. DATE  
DESIGNED BY: DMC DRAWN BY: DMC CHECKED BY: EL

**CITY OF RIVERSIDE, CALIFORNIA DEPARTMENT OF PUBLIC WORKS**

APPROVED BY	BY	DATE	APPROVED BY
ENGINEERING MANAGER	E.L. Lara	2/19/15	[Signature]
CONSTRUCTION ADMIN.	DG	2/19/15	CITY ENGINEER
TRAFFIC DIVISION	R.W.	2-19-15	
STREETS SERVICES	R.F.	2-19-15	
			DATE: 2/19/2015

**LANDSCAPE MEDIAN IMPROVEMENTS**

MEDIAN TURF REMOVAL PROJECT, PHASE II  
MAGNOLIA AVENUE  
HORIZ. SCALE: 1"=20' VERT. SCALE: N/A

RPU DESIGN WORK ORDER: #1508348  
RPU CONSTR. WORK ORDER: #1508353  
M-479  
SHEET 6 OF 10  
FILE NAME: M479-6.DWG

BERMUDA AVE

SEDGWICK AVE

B-01

OTTAWA AVE


CHICAGO AVE

B-03

MARTIN LUTHER KING BLVD

MATCH LINE - "A"

MATCH LINE - "A"

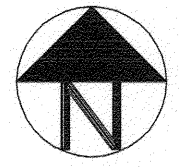

AREA MAP:

SCALE: 1" = 100'

FOURTEENTH ST

B-02

PENNSYLVANIA AVE

KANSAS AVE

MICHAEL ST

ANGELO ST

DOUGLASS AVE


DWIGHT AVE

MARTIN LUTHER KING BLVD

MATCH LINE - "A-A"

90' TYPICAL

45' TYPICAL MULCH ONLY

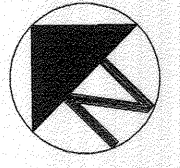


MEDIAN B-02:

SCALE: 1" = 20'


MATCH LINE - "A-A"

MATCH LINE - "B-B" SEE SHEET 6

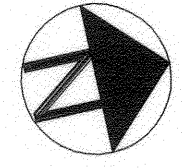


MEDIAN B-01:

SCALE: 1" = 20'

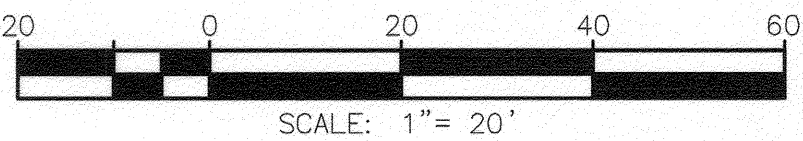


SCALE: 1" = 20'

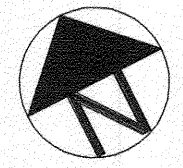


MEDIAN B-02: (CONT'D)

SCALE: 1" = 20'

Under Ground Service Alert of Southern California  
 Call: TOLL FREE 1-800-227-2600  
 TWO WORKING DAYS BEFORE YOU DIG

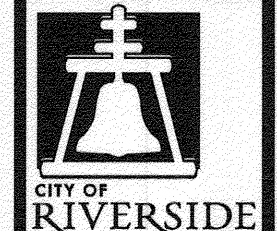

ENGINEER IN RESPONSIBLE CHARGE  
 EDWARD LARA  
 R.C.E. No. 63753 EXPIRES: 9-30-16  
 DATE: February 13, 2015

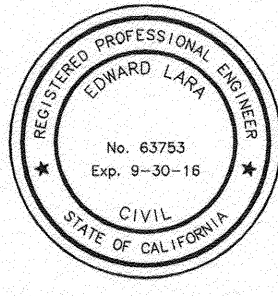


MARK	REVISIONS	APPR.	DATE

CITY OF RIVERSIDE, CALIFORNIA DEPARTMENT OF PUBLIC WORKS			
APPROVED BY	BY	DATE	APPROVED BY
ENGINEERING MANAGER	<i>E.L. Lara</i>	2/19/15	<i>[Signature]</i>
CONSTRUCTION ADMIN.	<i>D.C.</i>	2/19/15	CITY ENGINEER
TRAFFIC DIVISION	<i>R.F.</i>	2-19-15	
STREETS SERVICES	<i>R.F.</i>	2-24-15	DATE: 2/19/2015

LANDSCAPE MEDIAN IMPROVEMENTS	
MEDIAN TURF REMOVAL PROJECT, PHASE II	
MARTIN LUTHER KING BOULEVARD	
HORIZ. SCALE: 1"=20'	VERT. SCALE: N/A

RPU DESIGN WORK ORDER: #1508348 RPU CONSTR. WORK ORDER: #1508353	M-479
SHEET 7 OF 10	FILE NAME: M479-7.DWG

SEE SHEET 8  
MATCH LINE - 'B-B'

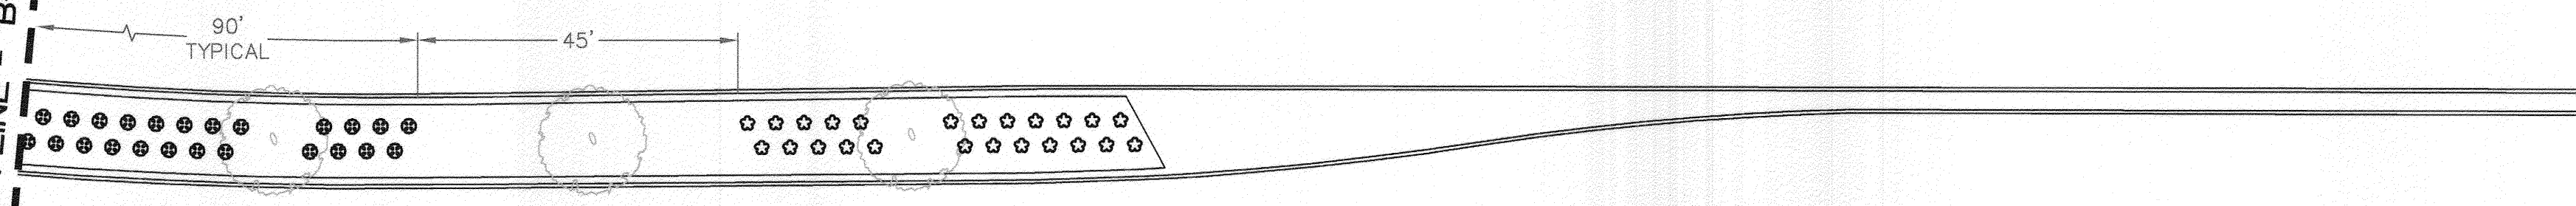

**MEDIAN B-02: (CONT'D)**  
SCALE: 1" = 20'



**MEDIAN B-03:**  
SCALE: 1" = 20'

MATCH LINE - 'C-C'



**MEDIAN B-03: (CONT'D)**  
SCALE: 1" = 20'



MATCH LINE - 'C-C'

PLANTING LEGEND - 14TH STREET/MLK BOULEVARD FROM BERMUDA AVENUE TO CHICAGO AVENUE


TURF REMOVAL: 18,000 SQUARE FEET

SYMBOL	COMMON NAME	SIZE	SPACING	QUANTITY
	PLUMBAGO	1 GAL.	6'	258
	GOLD LANTANA	1 GAL.	5'	217


GAL. = GALLON  
NOTE: ALL TURF REMOVAL AREAS SHALL HAVE MULCH

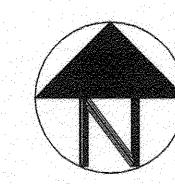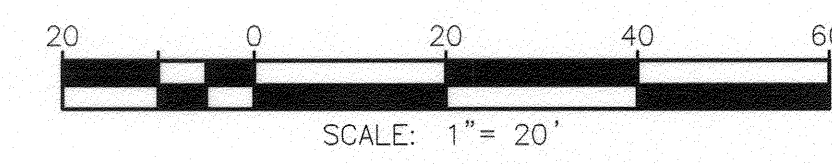

Under Ground Service Alert of Southern California  
Call: TOLL FREE 1-800-227-2600  
TWO WORKING DAYS BEFORE YOU DIG

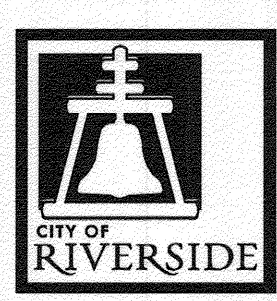

**ENGINEER IN RESPONSIBLE CHARGE**  
Edward Lara  
EDWARD LARA  
R.C.E. No. 62753 EXPIRES: 9-30-16  
DATE February 13, 2015

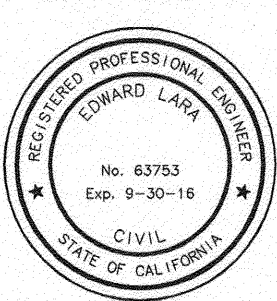

MARK	REVISIONS	APPR.	DATE

DESIGNED BY: DMC DRAWN BY: DMC CHECKED BY: EL

**CITY OF RIVERSIDE, CALIFORNIA**  
**DEPARTMENT OF PUBLIC WORKS**

APPROVED BY	BY	DATE	APPROVED BY
ENGINEERING MANAGER	ELC-EM	2/19/15	<i>Edward Lara</i>
CONSTRUCTION ADMIN.	DC	2/19/15	CITY ENGINEER
TRAFFIC DIVISION	R.H.	2.19.15	
STREETS SERVICES	R.F.	2.20.15	DATE 2/19/2015

**LANDSCAPE MEDIAN IMPROVEMENTS**

**MEDIAN TURF REMOVAL PROJECT, PHASE II**

**MARTIN LUTHER KING BOULEVARD**

HORIZ. SCALE: 1"=20' VERT. SCALE: N/A



RPU DESIGN WORK ORDER: #1508348  
RPU CONSTR. WORK ORDER: #1508353

**M-479**


SHEET 8 OF 10

FILE NAME: M479-8.DWG




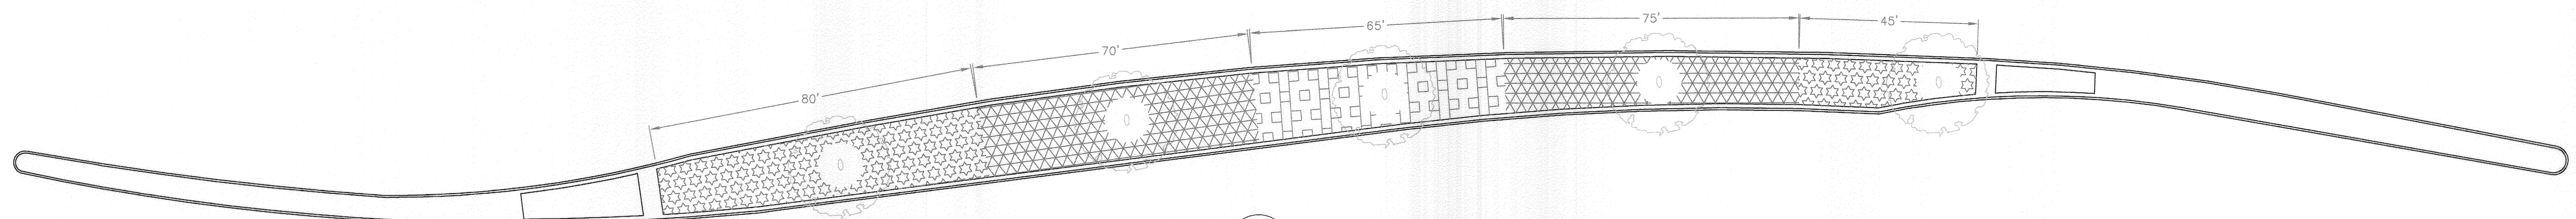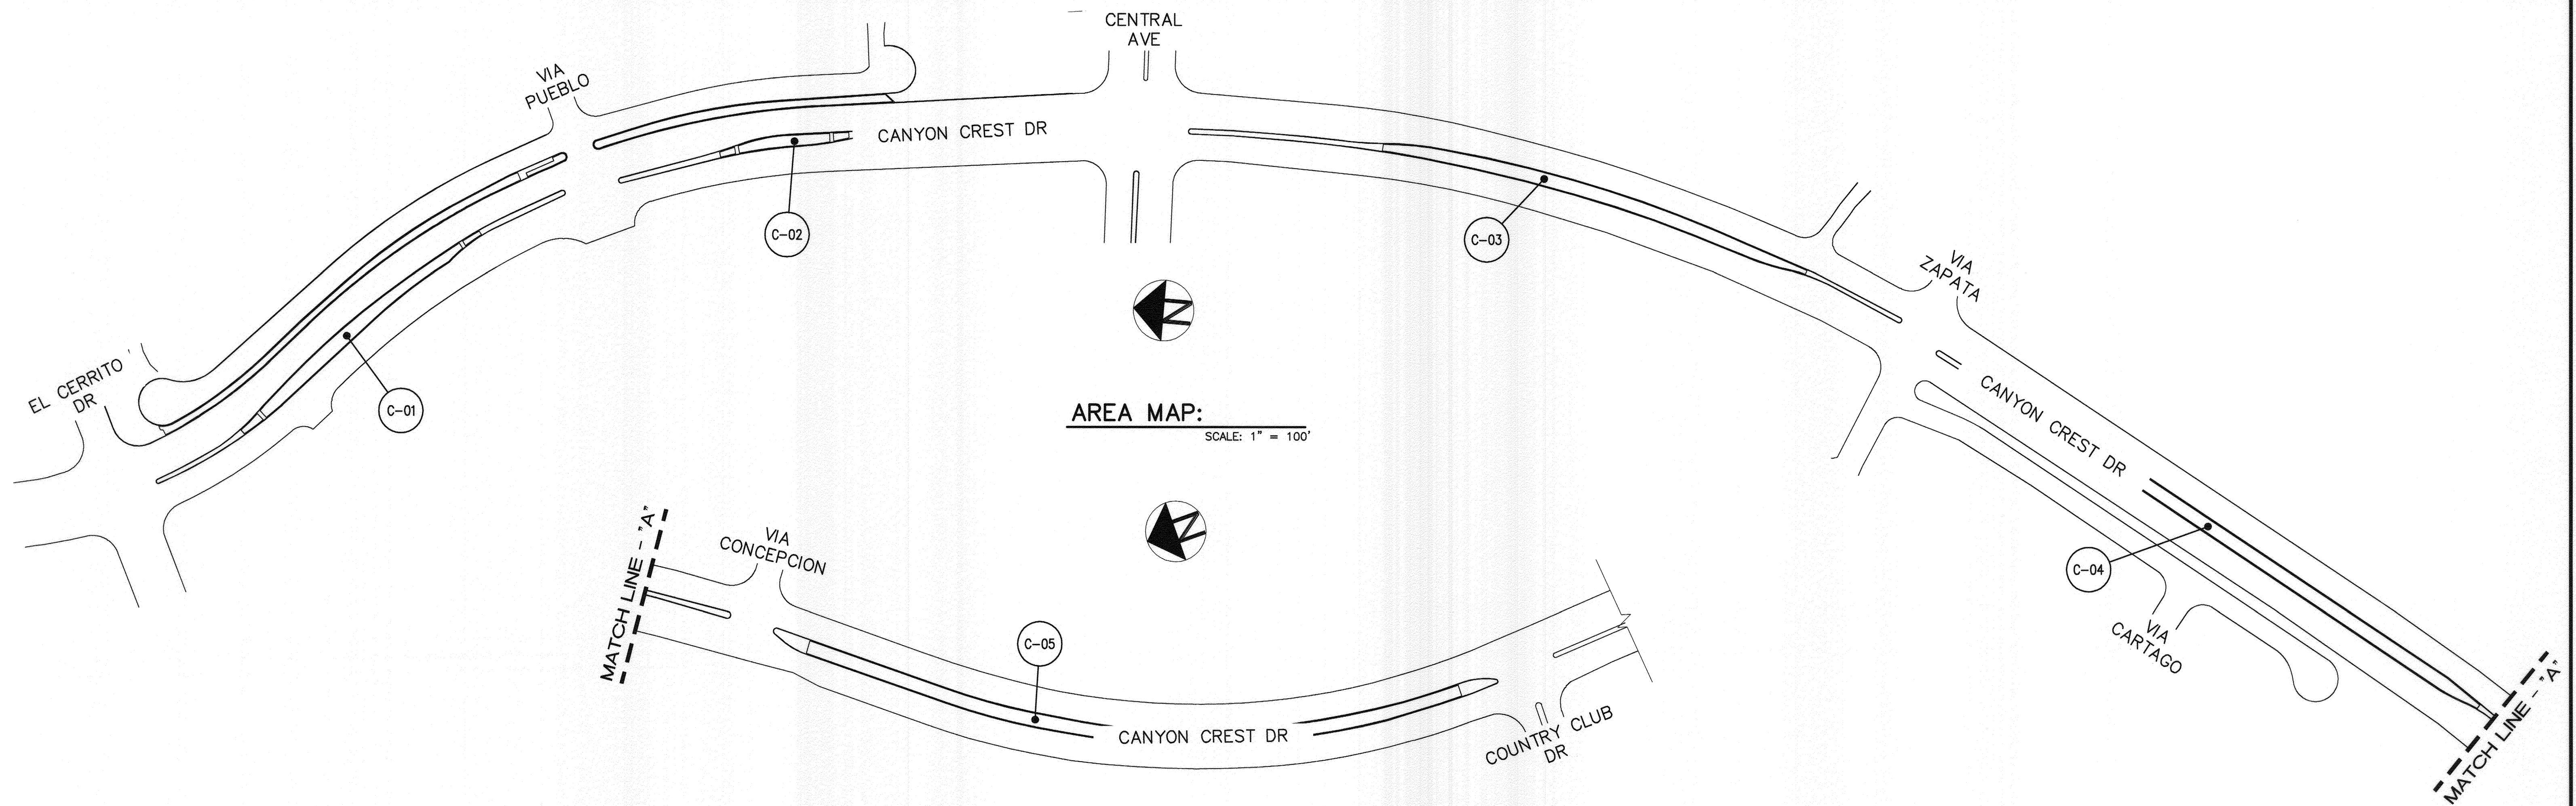

**MEDIAN C-01:**  
SCALE: 1" = 20'

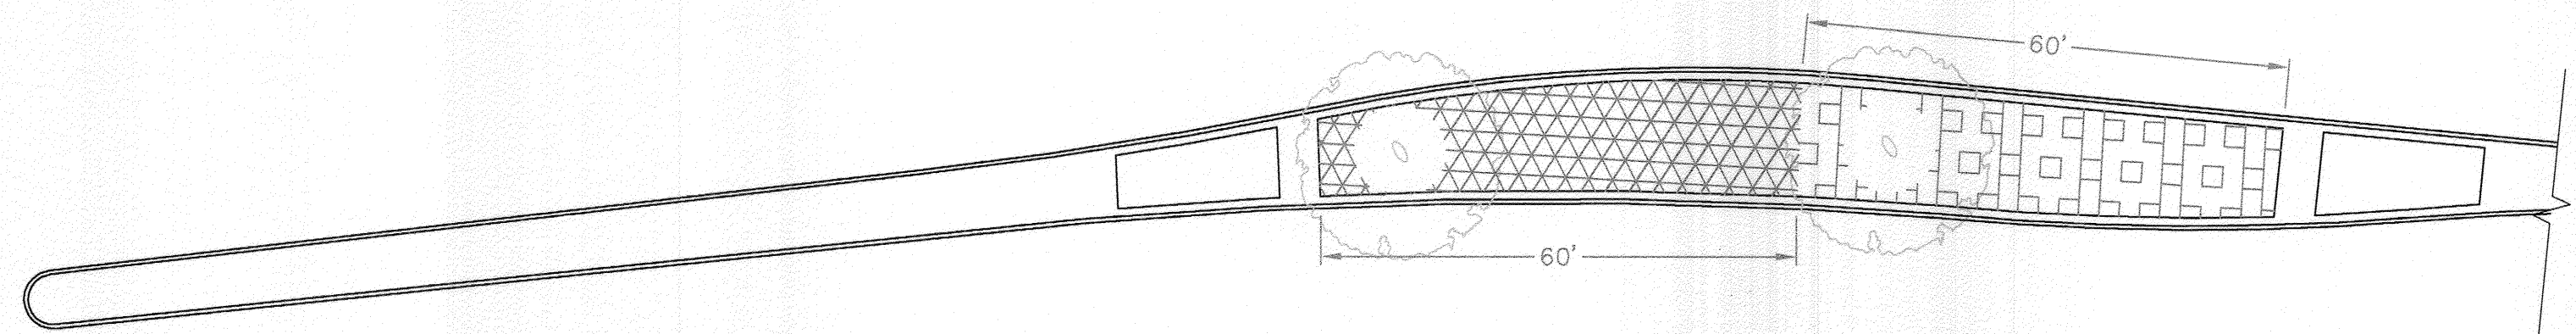

**MEDIAN C-02:**  
SCALE: 1" = 20'

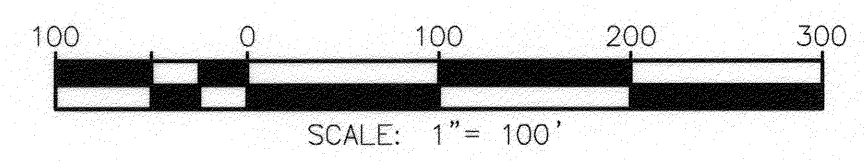

Under Ground Service Alert of Southern California  
Call: TOLL FREE 1-800-227-2600  
TWO WORKING DAYS BEFORE YOU DIG

**ENGINEER IN RESPONSIBLE CHARGE**  
EDWARD LARA  
R.C.E. No. 63753 EXPIRES: 9-30-16  
DATE: February 13, 2015

MARK	REVISIONS	APPR.	DATE

**CITY OF RIVERSIDE, CALIFORNIA**  
**DEPARTMENT OF PUBLIC WORKS**

APPROVED BY	BY	DATE	APPROVED BY
ENGINEERING MANAGER	E.L. Lara	2/19/15	[Signature]
CONSTRUCTION ADMIN.	D.G.	2/19/15	CITY ENGINEER
TRAFFIC DIVISION	[Signature]	2-19-15	
STREETS SERVICES			DATE: 2/19/2015

**LANDSCAPE MEDIAN IMPROVEMENTS**

**MEDIAN TURF REMOVAL PROJECT, PHASE II**

**CANYON CREST DRIVE**

HORIZ. SCALE: 1"=20' VERT. SCALE: N/A

RPU DESIGN WORK ORDER: #1508348  
RPU CONSTR. WORK ORDER: #1508353

**M-479**

SHEET **9** OF **10**

FILE NAME: M479-9.DWG

