


Filed Oct 14 1899
 Bk. 1 pg. 33
 Record Survey

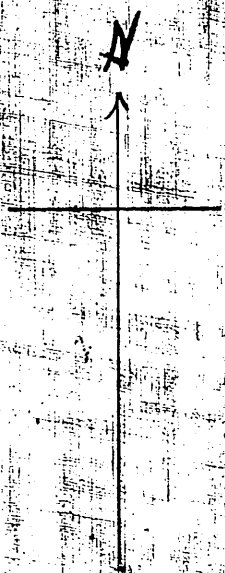

Map of
PRENDA SUBDIVISION
 of the
 S.W 1/4 of S.W 1/4 of SEC. 11 T. 3 S. R. 5 W S.B.M.
 AS SURVEYED BY
 K. Sanborn C.E.
 OCT 1899
 Scale in feet