


181

181

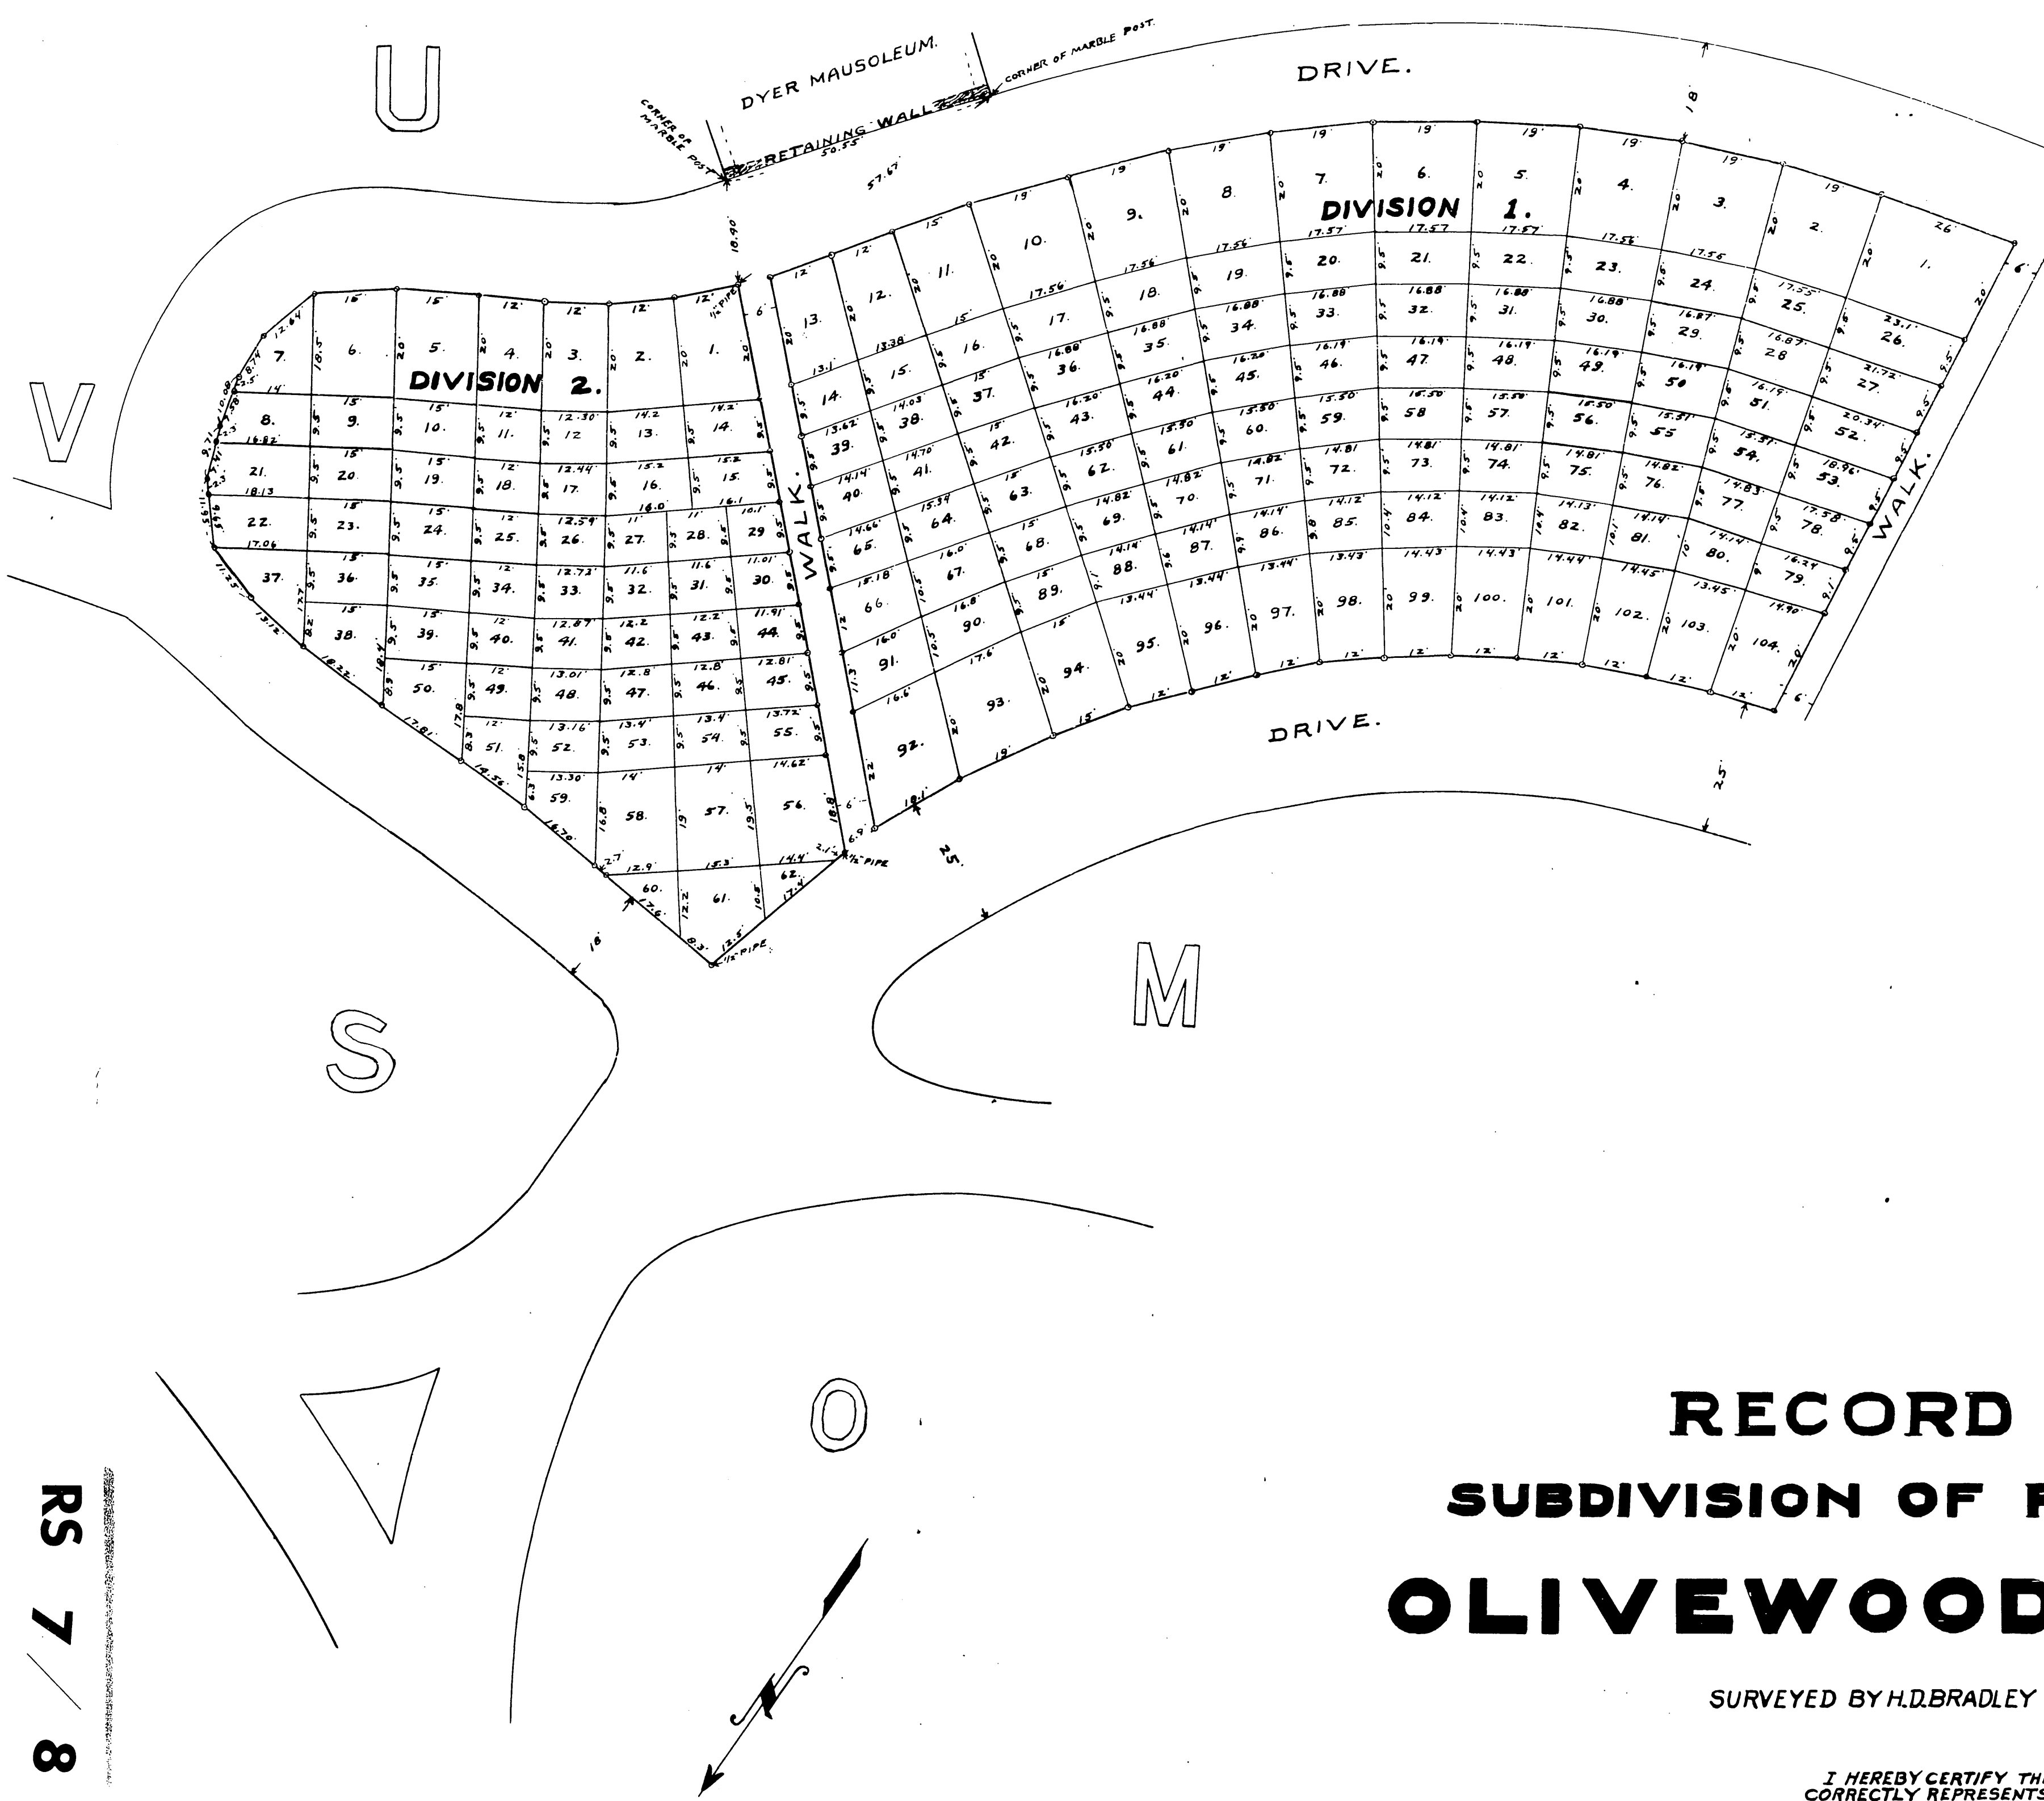

FILED
 JUL 2 1926
Jessie A. Ross
F. B. Row
 By H. D. Bradley

RS 7/81

RECORD SURVEY
SUBDIVISION OF PLATS "T" AND A PART OF "L"
OLIVEWOOD CEMETERY

SURVEYED BY H. D. BRADLEY JUNE, 1926. - SCALE 1 INCH = 20 FEET.

I HEREBY CERTIFY THAT THIS MAP
 CORRECTLY REPRESENTS A SURVEY AS
 MADE BY ME IN JUNE, 1926.
H. D. Bradley
 LICENSED SURVEYOR.

RS 7 / 81

RS 7/81